



**Lee D. Hoffman**  
90 State House Square  
Hartford, CT 06103-3702  
p 860 424 4315  
f 860 424 4370  
lhoffman@pullcom.com  
www.pullcom.com

November 22, 2022

**VIA ELECTRONIC MAIL**

Melanie Bachman  
Executive Director/Staff Attorney  
Connecticut Siting Council  
10 Franklin Square  
New Britain, CT 06051

**Re: Docket No. 497 - Burlington Solar One, LLC – Certificate of Environmental Compatibility and Public Need for the Construction, Maintenance and Operation of a 3.5-Megawatt AC Solar Photovoltaic Generating Facility Located at Lot 33, Prospect Street, Burlington, Connecticut, and Associated Electrical Interconnection.**

**Docket No. 497 – DG Connecticut Solar III, LLC – Certificate of Environmental Compatibility and Public Need for the Construction, Maintenance and Operation of a 3.5-Megawatt AC Solar Photovoltaic Generating Facility Located at Lot 33, Prospect Street, Burlington, Connecticut, and Associated Electrical Interconnection.**

Dear Ms. Bachman:

I am writing to you to inform you that the project that is the subject of this Docket has completed its construction. With one exception, discussed in greater detail below, the project has been completed in accordance with the drawings and specification sheets that have previously been provided to, and approved by, the Council, and therefore, the project does not believe that additional post-construction drawings need to be provided to the Council. If the Council disagrees with this assessment, please contact the undersigned, and further documentation will be provided.

The one area of the project that was subject to change is a minor modification of the project's metering system. The changes are reflected in the customer's metering setup, not Eversource's metering set up.

The changes in metering resulted from the project's need to install pole top metering earlier this year so that the project could meet its PTO requirements. Unfortunately, the pad-mounted metering equipment that was planned for the project was not available during the construction period, and indeed, is still unavailable due to supply chain issues. The manufacturer of this


Page 2

equipment could not provide the project with an estimated date as to when the metering equipment would be made available, thus, the metering was converted to pole top metering to allow for the completion of construction.

Attached to this letter is a drawing showing the markup of the plans that were previously approved by the Council. In addition, two photographs of the project site are included with this letter. The first photo shows the two poles, which are the customer metering poles. These poles are located, as indicated in the drawing provided, approximately 275 feet inside the site border, from the southern property line. The second photo was taken from the street and shows the utility metering poles in the foreground and the customer metering poles are in the background but not visible from this location.

I trust that this notice is sufficient for the Council's purposes, but if it is not, please contact me at your convenience. In addition, I am available to answer any questions concerning this submittal. I certify that copies of this submittal have been made to all parties on the Petition's Service List as of this date.


Sincerely,

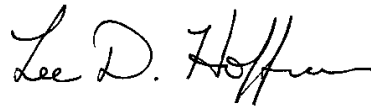A handwritten signature in black ink that reads "Lee D. Hoffman". The signature is written in a cursive style with a large, sweeping "L" and "H".

Lee D. Hoffman

Enclosures

**Pole mounted equipment that we are proposing to become the permanent solution**

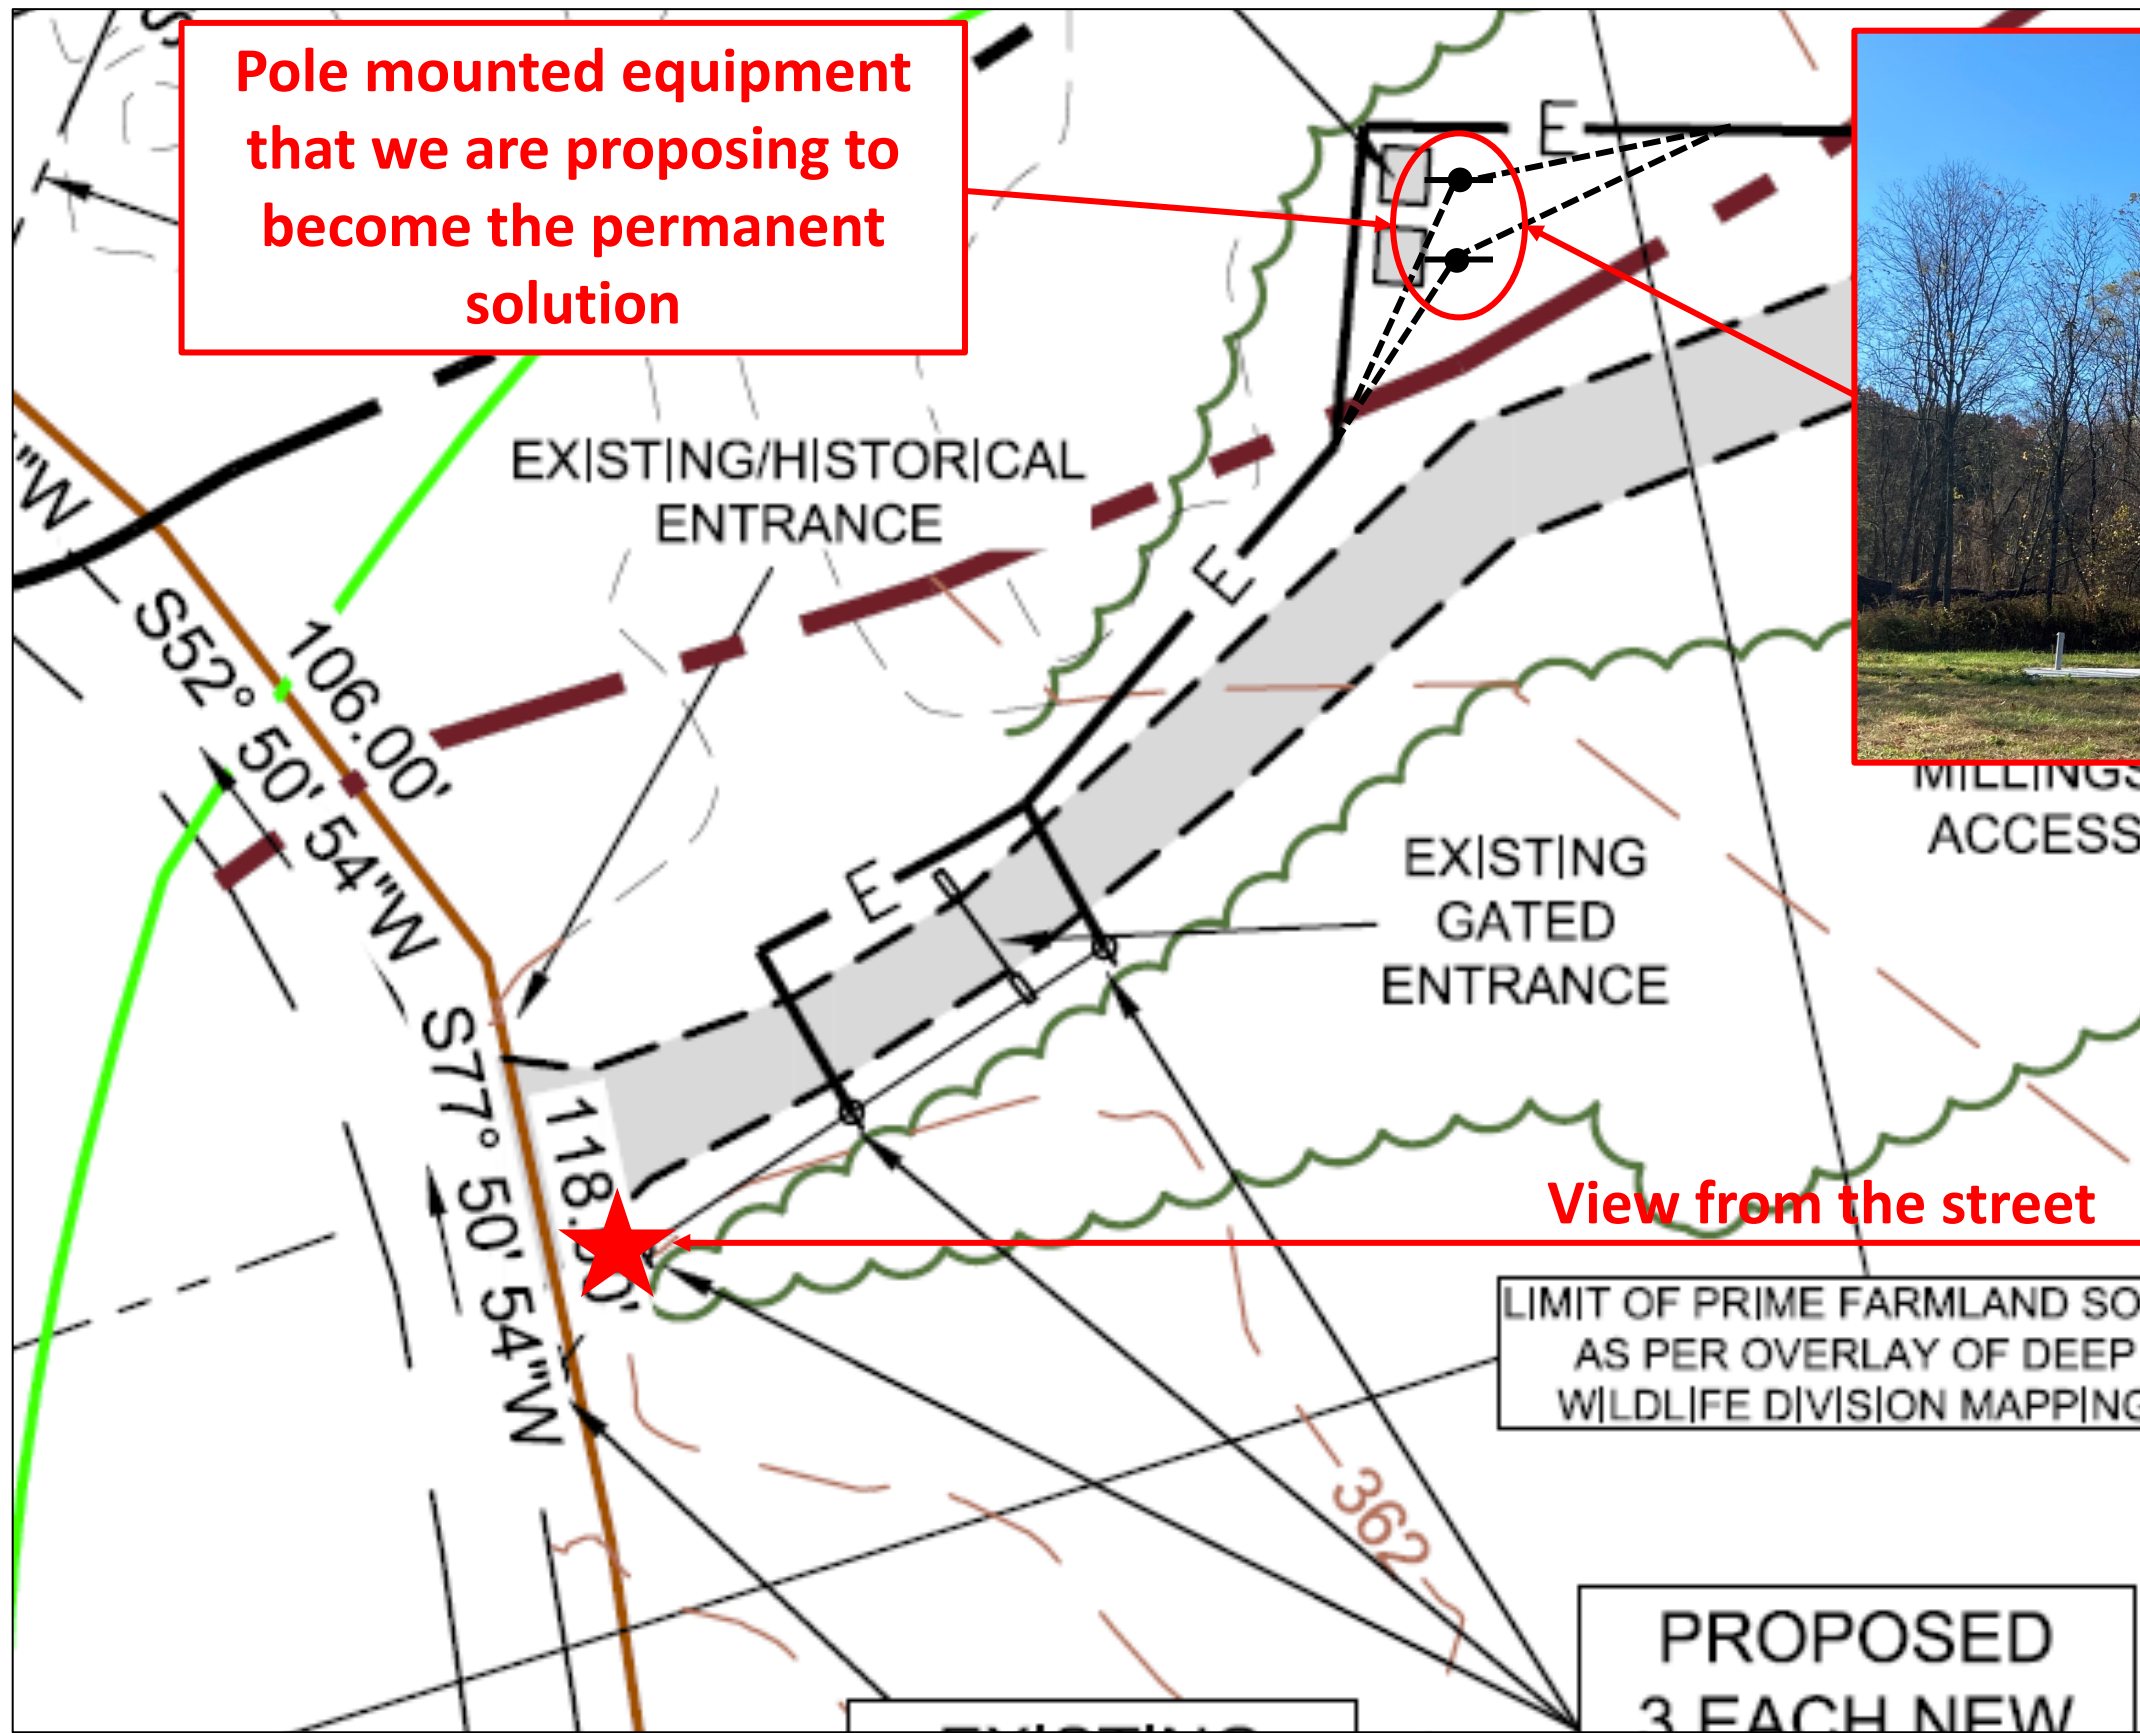

**View from the street**



### Burlington Solar One, LLC

Lot 33 Prospect Street

Burlington, CT

SHEET NAME: SKETCH
DRAWN BY: SD
DATE: 11/9/2022