

July 1, 2014

Melanie Bachman Acting Executive Director Connecticut Siting Council 10 Franklin Square New Britain, CT 06051



RE:

EM# -AT&T- 003-131209B Notice of Completion of Construction & PE Certification

New Cingular Wireless/ AT&T 142 Fitts Road, Ashford, CT

Dear Ms. Bachman:

The purpose of this letter is to notify you that construction activity associated with the above-referenced decision has been completed.

As part of the decision conditions, a PE letter confirming that the construction was in conformity with the structural modification design is attached.

If you have any questions or need any additional information regarding this facility, please do not hesitate to contact me.

Sincerely,

Jonathan McNeal

Zoning Lead

**SAI Communications** 

Agent for New Cingular Wireless/AT&T Mobility, Inc.

27 Northwestern Avenue

Salem, New Hampshire 03079

Cc:

Christine Vergati, Cuddy Feder (via email only)

SAI Construction (via email only)



# Final Report of Special Inspections

Project:

CT5702 Ashford Southeast, AT&T Mobility Telecommunication Facility Upgrade (LTE)

Location:

142 Fitts Road, Ashford, CT 06278

Owner:

AT&T Wireless (New Cingular Wireless)

Engineer of Record:

Daniel P. Hamm, P.E.

Hudson Design Group, LLC.

To the best of my information, knowledge and belief, the Special Inspections required for this project have been performed and all discovered discrepancies have been reported and resolved.

Representatives of Hudson Design Group LLC performed inspections following the construction of the AT&T telecommunications facility at the above-referenced address. The Final Inspection was conducted on September 09, 2013.

Comments: Based on my knowledge, information and belief the completed LTE installation substantially conforms to the approved plans, Connecticut State Building Code, Structural Standards for Steel Antenna Towers and Antenna Supporting Structures (ANSI/TIA/EIA-222-F), the equipment manufacturer's installation guidelines, and the following:

1. Final LTE Construction Drawings dated 10-02-2012, prepared by Hudson Design Group LLC, entitled "Ashford Southeast".

All deviations from the approved plans do not endanger the intended occupancy of the facility and equipment substitutions are approved as equivalent to the original specifications. Construction has been satisfactorily completed.

Respectfully submitted, Special Inspector

Daniel P. Hamm, P.F.

(Type or print name)

9-18-13

Date



# STATE OF CONNECTICUT



# CONNECTICUT SITING COUNCIL

Ten Franklin Square, New Britain, CT 06051
Phone: (860) 827-2935 Fax: (860) 827-2950
E-Mail: siting.council@ct.gov
www.ct.gov/csc

Matt Burke Tower Resource Management, Inc. 16 Chestnut Street, Suite 220 Foxboro, MA 02035

RE: **EM-AT&T-003-131209B** - American Telephone and Telegraph Company (AT&T) notice of intent to modify an existing telecommunications facility located at 142 Fitts Road, Ashford, Connecticut.

Dear Mr. Burke:

The Connecticut Siting Council (Council) hereby acknowledges your notice to modify this existing telecommunications facility, pursuant to Section 16-50j-73 of the Regulations of Connecticut State Agencies with the following conditions:

- Any deviation from the proposed modification as specified in this notice and supporting materials with the Council shall render this acknowledgement invalid;
- Any material changes to this modification as proposed shall require the filing of a new notice with the Council;
- Within 45 days after completion of construction, the Council shall be notified in writing that construction has been completed;
- The validity of this action shall expire one year from the date of this letter; and
- The applicant may file a request for an extension of time beyond the one year deadline provided that such request is submitted to the Council not less than 60 days prior to the expiration.

The proposed modifications including the placement of all necessary equipment and shelters within the tower compound are to be implemented as specified here and in your notice received December 9, 2013. The modifications are in compliance with the exception criteria in Section 16-50j-72 (b) of the Regulations of Connecticut State Agencies as changes to an existing facility site that would not increase tower height, extend the boundaries of the tower site, increase noise levels at the tower site boundary by six decibels, and increase the total radio frequencies electromagnetic radiation power density measured at the tower site boundary to or above the standard adopted by the State Department of Environmental Protection pursuant to General Statutes § 22a-162. This facility has also been carefully modeled to ensure that radio frequency emissions are conservatively below State and federal standards applicable to the frequencies now used on this tower.

This decision is under the exclusive jurisdiction of the Council. Please be advised that the validity of this action shall expire one year from the date of this letter. Any additional change to this facility will require explicit notice to this agency pursuant to Regulations of Connecticut State Agencies Section 16-50j-73. Such notice shall include all relevant information regarding the proposed change with cumulative worst-case modeling of radio frequency exposure at the closest point of uncontrolled access to the tower base, consistent with Federal Communications Commission, Office of Engineering and Technology, Bulletin 65. Thank you for your attention and cooperation.

Very truly yours,

Melanie A. Bachman Acting Executive Director

MAB/CDM/laf

c: The Honorable, Michael J. Zambo, First Selectman, Town of Ashford Michael Gardner, Zoning Enforcement Officer, Town of Ashford Sean Gormley, SBA

S:\EMS\_T\$\AT&T\_CING\ASHFORD\FittsRd\em-at&t-003-131209B\_dcltr\_FittsRd.docx



## Matt Burke

16 Chestnut Street, Suite 220 Foxboro, MA 02035 Tel (508) 930-0974 Fax (774) 215-5423

Melanie Bachman Acting Executive Director Connecticut Siting Council 10 Franklin Square New Britain, CT 06051

Re: Notice of Exempt Modification - Emergency Backup Generator 142 Fitts Road, Ashford, CT 06278 (FA# 10070913)

Dear Ms. Bachman:

American Telephone and Telegraph Company ("AT&T") currently maintains a wireless telecommunications facility at the above referenced address. AT&T's facility consists of antennas at the 167' level of an existing 176' tower and a 200-square-foot lease area. The tower and AT&T's shelter are located within an existing, fenced-in compound area. The shelter houses AT&T's equipment and space for a back-up generator. AT&T does not currently maintain a generator at this cell site.

In an effort to further enhance multiple tenants' network reliability, AT&T intends to modify its facility by installing a new diesel-fueled generator outside in a designated 4' x 8' ground space. The generator incorporates a built-in fuel tank as part of the unit. The diesel fuel tanks are double walled for added safety and will be filled by a licensed fuel filling company. The proposed modification will remain within the existing, fenced-in compound. The new generator and tank with be surrounded by a security fence and gate and will be placed on a 4' x 8' concrete pad. (See Facility Compound Plan attached).

Please accept this letter as notification pursuant to R.C.S.A Section 16-50j-73, for construction that constitutes modification pursuant to R.C.S.A Section 16-50j-72(b)(2). In accordance with R.C.S.A Section 16-50j-73, a copy of this submission is being sent to the Town of Ashford. A copy of this submission is also being sent to Conn Rivers Council, Inc. BSA, the property owner on which the tower is located.

## AT&T's Proposed Wireless Modifications Constitute An "Exempt Modification"

The proposed modification to the above mentioned Facility constitutes an exempt modification of an existing facility provided for in R.C.S.A Section 16-50j-72(b)(2) and Council regulations promulgated pursuant thereto.

- 1) The proposed modification will not result in an increase in the height of the existing tower.
- 2) The generator and attached fuel tank will remain entirely within the limits of the leased area. The modifications therefore, will not require the extension of the boundary.
- 3) The proposed modification does not increase the noise levels at the boundary by six (6) decibels or more under normal conditions. Proposed modification is only used during emergency power failure.
- 4) The installation of a new generator and attached fuel tank will not change, in any way, radio frequency (RF) emissions at the facility.
- 5) The facility has received all municipal zoning approvals and building permits. (Regs., Conn. State Agencies Section 16-50j-72))

For all the foregoing reasons, American Telephone and Telegraph Company respectfully submits that the proposed modifications to the above-referenced telecommunications facility constitutes an exempt modification under R.C.S.A Section 16-50j-72(b)(2)

Respectfully submitted,

# Matt Burke 508.930.0974

On behalf of AT&T


c/o Tower Resource Management, Inc. 16 Chestnut Street, Suite 220 Foxboro, MA 02035

cc: Town of Ashford, CT

Conn Rivers Council, Inc. BSA

Exhibit 1

Site Plan

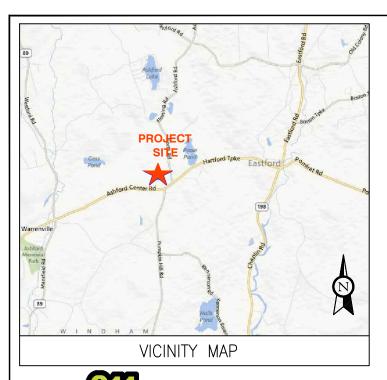



# BACKUP POWER PROJECT

# SITE IDENTIFICATION:

SITE NUMBER: 10070913
SITE NAME: ASHFORD SOUTHEAST

SITE ADDRESS: 142 FITTS ROAD
ASHFORD, CT 06278



CONTRACTOR TO VERIFY EXISTING MUX LOCATION. IF MUX LOCATION IS OUTSIDE OF AT&T EQUIPMENT AREA, CONTRACTOR IS TO FIELD VERIFY THE PRESENCE OF EMERGENCY BACK-UP SERVICE TO THE MUX. IF EMERGENCY BACK-UP SERVICE IS NOT PRESENT, CONTRACTOR IS TO ROUTE NEW SERVICE FROM AT&T EQUIPMENT AREA.

# Know what's below. Call before you dig.

THIS FACILITY SHALL MEET OR EXCEED ALL FAA AND FCC REGULATORY REQUIREMENTS.

# PROJECT DESCRIPTION:

THE PROPOSED PROJECT INCLUDES PLACING A 50 KW GENERATOR
IN AN EXISTING CELLULAR TOWER COMPOUND

Can before you dig.	IN AN EXISTIN	IG CELLULAR TOWER COMPOUND					
PROJECT TEAM	PROJECT SUMMARY	PROJECT NOTES		SHEET INDEX			
ENGINEER ADVANCED ENGINEERING GROUP, P.C.	GEOGRAPHIC COORDINATES:  LATITUDE: 41° 52' 50" N	1. THE FACILITY IS UNMANNED.	SHT NO:	DESCRIPTION:	REV:	DATE:	<u>BY:</u>
500 NORTH BROADWAY EAST PROVIDENCE, RI 02914 TEL: 401-354-2403	LONGITUDE: 72° 07' 43" W	A TECHNICIAN WILL VISIT THE SITE APPROXIMATELY ONCE     A MONTH FOR ROUTINE INSPECTION AND MAINTENANCE.	T-1	TITLE SHEET, VICINITY MAP AND GENERAL INFORMATION	1	11-26-2013	JG
CUSTOMER REPRESENTATIVE:	CODE BLOCK:	THE PROJECT WILL NOT RESULT IN ANY SIGNIFICANT LAND DISTURBANCE OR EFFECT OF STORM WATER	A-1	COMPOUND PLAN	1	11-26-2013	JG
SABRE INDUSTRIES PEGGY POOR	BUILDING CODE: 2009 INTERNATIONAL BUILDING CODE	DRAINAGE.	A-2	CONCRETE PAD DETAILS	1	11-26-2013	JG
MARKET LEAD — AT&T NE GENERATOR PROGRAM 13010 MORRIS ROAD, 6TH FLOOR, BLDG 1		NO SANITARY SEWER, POTABLE WATER OR TRASH DISPOSAL AS REQUIRED.	E-1	WIRING DIAGRAM & SIZING CHARTS	1	11-26-2013	JG
ALPHARETTA, GA 30004 CELL 770-990-0137		5. HANDICAP ACCESS IS NOT REQUIRED.	E-2	ELECTRICAL & ATS MOUNTING DETAILS	1	11-26-2013	JG
LANDLORD:		or invision respective field field field	G-1	GROUNDING DETAILS	1	11-26-2013	JG
		PROJECT LOCATION DIRECTIONS	<b></b>				
SBA 5900 BROKEN SOUND PARKWAY NW, 2ND FLOOR BOCA RATON, FL 33487  UTILITIES: POWER COMPANY: NORTHEAST UTILITIES (NU) P.O. BOX 270 HARTFORD, CT 06141-0270 PHONE: 1-800-286-5000		DEPART RT-30 W / COCHITUATE RD TOWARD BURR ST TURN BACK ON RT-30 E / COCHITUATE RD TAKE RAMP RIGHT FOR I-90 WEST TOWARD WORCESTER / SPRINGFIELD AT EXIT 9, TAKE RAMP RIGHT FOR I-84 TOWARD NEW YORK CITY / HARTFORD AT EXIT 72, TAKE RAMP RIGHT FOR CT-89 TOWARD WESTFORD / ASHFORD TURN LEFT ONTO CT-89  TURN RIGHT TO STAY ON CT-89 / FERRENCE RD TURN RIGHT TO STAY ON CT-89 / TURNPIKE RD TURN RIGHT TO STAY ON CT-89 / WESTFORD RD TURN LEFT ONTO US-44 / ASHFORD CENTER RD TURN LEFT ONTO FITTS RD ARRIVE AT 142 FITTS RD, ASHFORD, CT 06278					



Civil Engineering - Site Development Surveying - Telecommunications 500 NORTH BROADWAY EAST PROVIDENCE, RI 02914 PH: 401-354-2403 FAX: 401-633-6354



TOWER RESOURCE MANAGEMENT 16 CHESTNUT STREET, SUITE 220 FOXBORO, MA 02035 WWW.TRMCOM.COM



550 COCHITUATE ROAD, SUITE 13 & 14 FRAMINGHAM, MA 01701-4681



SITE NUMBER:

10070913

ASHFORD SOUTHEAST

> SITE ADDRESS: 142 FITTS ROAD ASHFORD, CT 06278

THESE DORNINGS AND/OR THE ACCOMPANING SPECIFICATION AS INSTRIMANTS OF SERVICE AND THE EXCLUSIVE PROPERTY OF ATC TOWER SERVICES, INC. THEIR USE AND PUBLICATION SHALL BE RESTRICTED TO THE OBGONAL SITE FOR WHICH THEY APE PREPARED. ANY USE OR DISCLOSURE OTHER THAN THAT WHICH RELATES TO ACCOUNT OF THE SERVICES, INC OR THE SEPCIFED CARRER IS STRICTLY THAN TOWER SERVICES, INC OR THE SEPCIFED CARRER IS STRICTLY THAN TO THESE DOCUMENTS SHALL REMAIN THE PROHIBITED, PROPERTY OF ACT TOWER SERVICES, INC WHITTEN OR NOT THE PROHIBIT IS DECLUTED. NETHER THE ARCHITECT NOT THE PROHIBITED FOR THIS CONTRACTOR(S) MUST VERIFY ALL DIMENSIONS AND ADVISE PROJECT, ATC TOWER SERVICES, INC OF ANY DISCREPANCIES. ANY PROR DISCREPANCE OF THIS CONTRACTOR OF THIS DAMING OF THIS SERVICES, INC. OF ANY DISCREPANCIES. ANY PROR SISSIANCE OF THIS DAMING IS SUPPRISEDED BY THE LATEST VERSION ON FILE WITH COUNTY THE CONTRACTOR OF THE SERVICES, INC.

STAMP HERE:

DRAWN BY: JTG

CHECKED BY: SNA


DATE DRAWN: 11-26-13

JOB NO: 10070913

SHEET TITLE:

TITLE SHEET, VICINITY MAP AND GENERAL INFORMATION

SHEET NUMBER:	REV. #
T-1	1

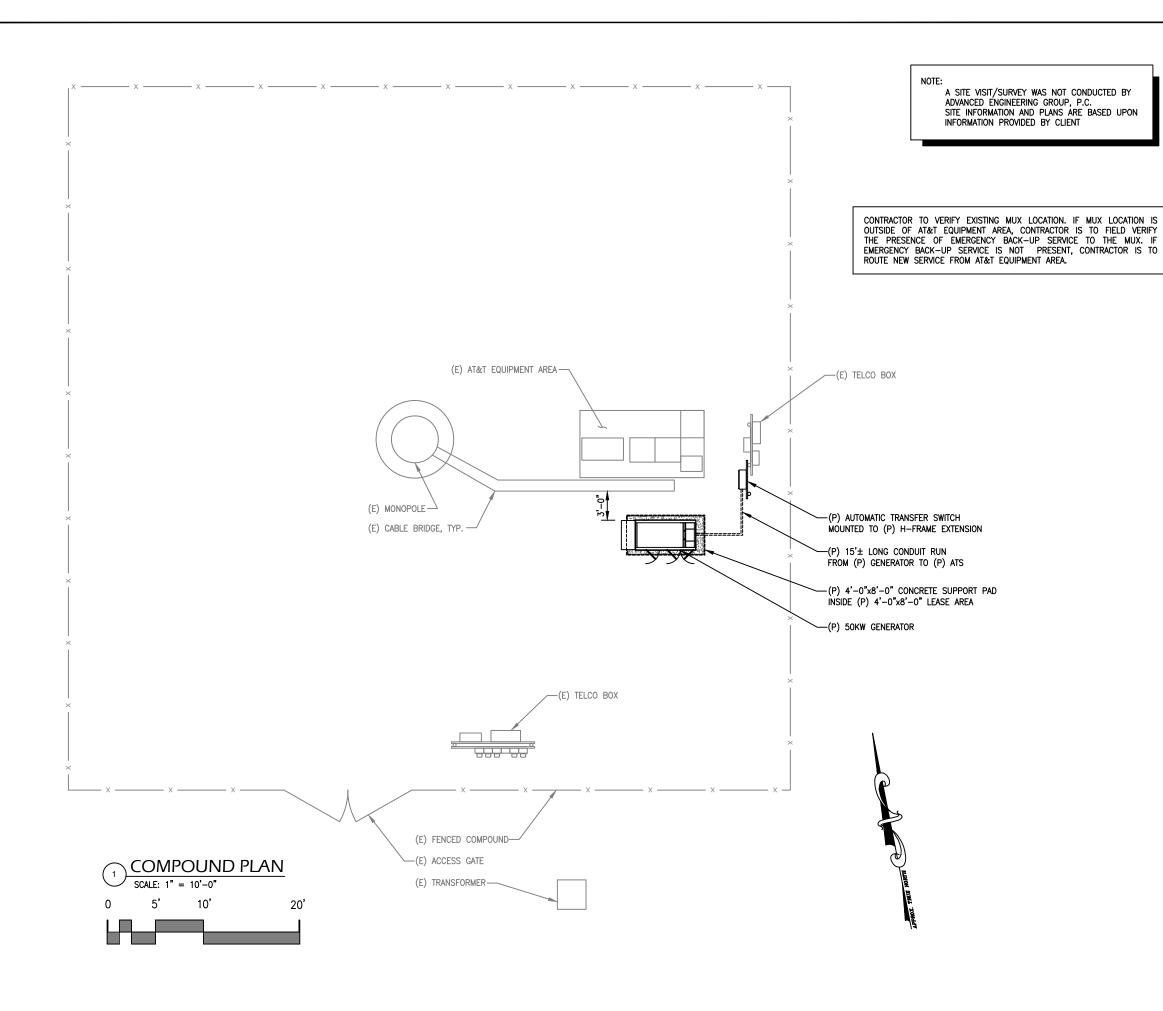



Civil Engineering - Site Development Surveying - Telecommunications 500 NORTH BROADWAY EAST PROVIDENCE, RI 02914 PH: 401-354-2403 FAX: 401-633-6354



TOWER RESOURCE MANAGEMENT 16 CHESTNUT STREET, SUITE 220 FOXBORO, MA 02035 WWW.TRMCOM.COM



550 COCHITUATE ROAD, SUITE 13 & 14 FRAMINGHAM, MA 01701-4681



13010 MORRIS ROAD, 6TH FLOOR, BLDG 1 ALPHARETTA, GA 30004

SITE NUMBER:

10070913

ASHFORD SOUTHEAST

> SITE ADDRESS: 142 FITTS ROAD ASHFORD, CT 06278

THESE DRAWINGS AND/OR THE ACCOMPANYING SPECIFICATION AS INSTRUMENTS OF SERVICE ARE THE EXCLUSIVE PROPERTY OF AIR TOWER SERVICES, INC. THER USE AND PUBLICATION SHALL BE RESTRICTED TO THE ORIGINAL SITE FOR WHICH THEY ARE PREPARED. ANY USE OR DISCLOSURE OTHER THAN THAT WHICH RELIES TO AIR TOWER SERVICES, INC OR THE SPECIFED CARRIER IS STRICTLY TITLE TO THESE DOCUMENTS SHALL REMAIN THE PROHIBITION. PROPERTY OF AIR TOWER SERVICES, INC WHETHER OR NOT THE PROJECT IS DECEVITED. NEITHER THE ARCHITECT NOR THE DIRINIER WILL BE PROVIDING ON-SITE CONSTRUCTION REVIEW OF THIS CONTRACTOR(S) MUST VERFIY ALL DIMENSIONS WID AVISE PROJECT. AIR TOWER SERVICES, INC OF ANY DISCREPANCIES. ANY PRIOR ISSUANCE OF THIS DRAWING IS SUPERSECIED BY THE LATEST VERSION ON FILE WITH AIR TOWER SERVICES, INC.


STAMP HERE:

	0.7	
	DRAWN BY:	JTG
	CHECKED BY:	SNA
	DATE DRAWN:	11-26-13
	JOB NO:	10070913

SHEET TITLE:

COMPOUND PLAN

SHEET NUMBER: REV. #

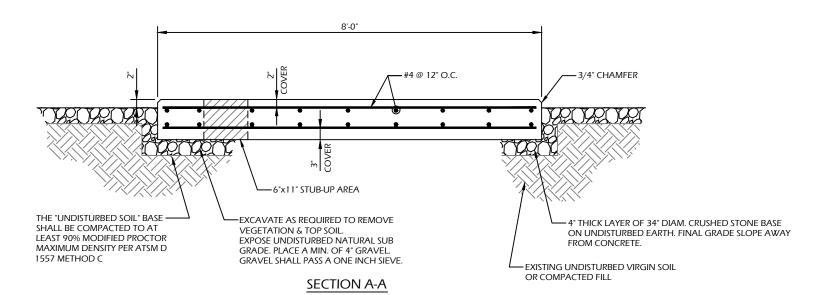

8'-0"

- AC LOAD LEAD CONDUIT

CONNECTION POINTS FOR CONTROL WIRES

PLAN VIEW

-OVERHANG


ANCHOR BOLT

(TYP) (4) PER SIDE

OUTLINE OF GENERATOR

11 1/2"

11"

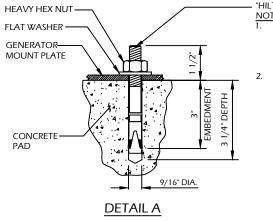

"HILTI" KWIK BOLT 3 EXPANSION ANCHOR
NOTE:

- BOLTS CAN BE INSTALLED 2 DAYS AFTER POURING CONCRETE PROVIDED THE KWIK BOLTS ARE ONLY TIGHTENED TO A SNUG TIGHT CONDITION.
- APPLY "HILTI" HIT-RE 500-SD EPOXY TO ALL GAPS TO PREVENT WATER/MOISTURE BUILD-UP.



ENGINEERING GROUP, P. Civil Engineering - Site Development

Surveying - Telecommunications

500 NORTH BROADWAY

401-633-6354

EAST PROVIDENCE, RI 02914 PH: 401-354-2403 FAX

> TOWER RESOURCE MANAGEMENT 16 CHESTNUT STREET, SUITE 220 FOXBORO, MA 02035 WWW.TRMCOM.COM



550 COCHITUATE ROAD, SUITE 13 & 14 FRAMINGHAM MA 01701-4681



SITE NUMBER:

10070913

ASHFORD

SOUTHEAST

SITE ADDRESS: 142 FITTS ROAD ASHFORD, CT 06278

THESE DRAWINGS AND/OR THE ACCOMPANYING SPECIFICATION AS INSTRUMENTS OF SERVICE ARE THE EXCLUSIVE PROPERTY OF ATC. TOWER SERVICES, INC. THEIR USE AND PUBLICATION SYALL BE RESTRICTED TO THE ORIGINAL SITE FOR WHICH THEY ARE PREPARED. ANY USE OR DISCLOSURE OTHER THAN THAT WHICH RELIES TO ATC. TOWER SERVICES, INC. OR THE SPECIFED CARRIER IS STRICTLY THE TO THESE DOCUMENTS SHALL REMAIN THE PROHIBITED, PROPERTY OF ATC TOWER SERVICES, INC WHETHER OR NOT THE PROLECT IS DECEVITED. NEITHER THE ARCHITECT NOT THE BENINEER WILL BE PROVIDING ON-SITE CONSTRUCTION REVIEW OF THIS CONTRACTORY, MIST VERFY ALL DIMENSIONS AND DAVISE PROJECT. ATC TOWER SERVICES, INC OF ANY DISCREPANCIES. ANY PRIOR ISSUANCE OF THIS DRAWING IS SUPERSECRED BY THE LATEST VERSION ON FILE WITH ATC TOWER SERVICES, INC.

CONTRACTOR TO VERIFY EXISTING MUX LOCATION. IF MUX LOCATION IS OUTSIDE OF AT&T EQUIPMENT AREA, CONTRACTOR IS TO FIELD VERIFY THE PRESENCE OF EMERGENCY BACK-UP SERVICE TO THE MUX. IF EMERGENCY BACK-UP SERVICE IS NOT PRESENT, CONTRACTOR IS TO ROUTE NEW SERVICE FROM AT&T EQUIPMENT AREA.



- 1. ALL REBAR (HORIZONTAL & VERTICAL) SHALL BE SECURELY WIRE TIED TO PREVENT DISPLACEMENT DURING POURING OF CONCRETE.
- 2. CONCRETE TO HAVE A MINIMUM COMPRESSIVE STRENGTH OF 4000 PSI.
- 3. REINFORCED CONCRETE CONSTRUCTION AND MATERIALS SHALL BE IN ACCORDANCE WITH ACI STANDARDS 318.
- 4. MINIMUM CONCRETE COVER OVER REBAR IS 2 1/2".
- 5. REINFORCING MATERIAL SHALL BE IN ACCORDANCE WITH ASTM SPECIFICATION A615-85.

## CONCRETE PAD AND EMBEDMENT TOLERANCES

- 1. CONCRETE DIMENSIONS: PLUS OR MINUS 1/4".
- 2. REINFORCING STEEL PLACEMENT: PLUS OR MINUS 1/4" INCLUDING CONCRETE COVER.

## **NOTES**

- 1. FOUNDATION WAS DESIGNED BY ASSUMING ALLOWABLE SOIL BEARING CAPACITY OF 1000 PSI. THE SOIL BEARING CAPACITY FOR EACH SITE MUST BE VERIFIED USING THE SITE SPECIFIC GEOTECH REPORT. IF SHALLOW GROUNDWATER (≤3 FT.) WAS REPORTED, A FURTHER REVIEW OF THE DESIGN OR SPECIAL DESIGN MAY BE REQUIRED.
- 2. THE SOIL UNDERNEATH THE CONCRETE PAD MUST BE FREE OF ORGANIC MATTER OR OTHER DELETERIOUS SUBSTANCES, AND SHOULD BE COMPACTED AND LEVELED BEFORE PLACING THE FOUNDATION.
- 3. CONCRETE SLUMPS: 1"~3".
- 4. CONCRETE VOLUME: 2.4 CUBIC YARDS.

### DESIGN

1. MAXIMUM DESIGN BASIC WIND SPEED (3-SECOND GUST): 155 MPH FOR GENERATOR MODELS SD050 AND SD080.

STAMP HERE:

 DRAWN BY:
 JTG

 CHECKED BY:
 SNA

 DATE DRAWN:
 11-26-13


 JOB NO:
 10070913

SHEET TITLE:

CONCRETE PAD DETAILS

SHEET NUMBER: REV. #

PRE-CAST GENERATOR PAD

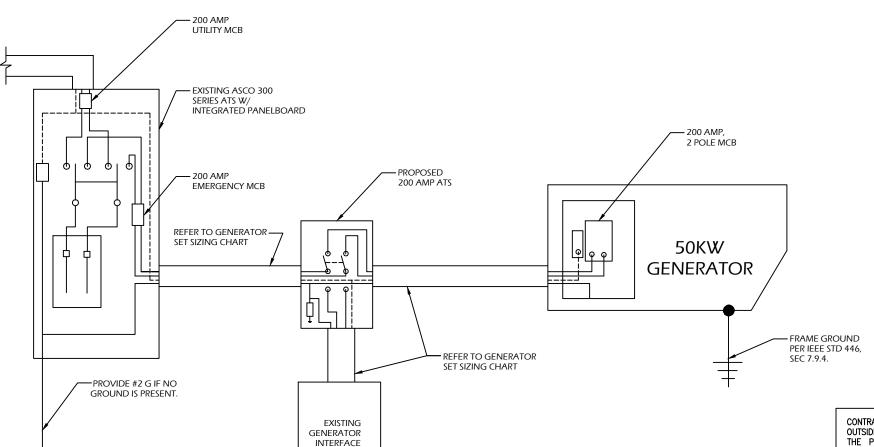

### NOTES:

- ALL UNDERGROUND CABLE TO BE BURIED AT 36" MIN. SHIELD TAPED AT 12" AND STUBBED OUT OF GROUND IN SCH 40 PVC
- 2. LOW VOLTAGE CONTROL WIRE PROVIDED BY MONITORING PROVIDER IN SEPARATE 1/2" CONDUIT FROM ATS TO GENERATOR.
- 3. BTS SITES: THE TENANT CONTRACTOR TO COMPLETE CUSTOMER ELECTRICAL CONDUIT TO CUSTOMER METER PER STANDARD COLLOCATION INSTALL.
- TENANT CONTRACTOR HAS NOTHING TO INSTALL OR COMPLETE FOR ATC SHARED GEN DURING CUSTOMER COLLOCATION ON ATC
- 5. ATC SHARED GEN INSTALL IS COMPLETED AFTER CUSTOMER TOWER COLLOCATION IS COMPLETE WITH LOAD ON CUSTOMER METER.
- ALL CONDUCTORS ARE SIZED FOR COPPER, BUT ALUMINUM CONDUCTORS ARE ALLOWED FOR FEEDERS PROVIDED THEY ARE LIPSIZED PER NEC TABLE 310 16
- 7. ALL ELECTRICAL WORK SHALL BE PER THE NATIONAL ELECTRICAL CODE (NFPA 70) AND ALL APPLICABLE LOCAL CODES.
- MAINTAIN 36" CLEAR WORKSPACE IN FRONT OF METER, TRANSFER SWITCH, GENERATOR, PANELS, ETC.
- 800A PANEL HAS A COMMON NEUTRAL BUS. NEUTRALS BACK TO EACH CARRIER METER ARE SIZED ACCORDING TO THE DISTRIBUTION PANEL BRANCH BREAKER RATING. NEUTRAL IS BONDED AT THE PRIMARY SERVICE MAIN BONDING JUMPER ONLY.
- 10. GENERATOR CONTROLS AND SENSORS SHALL HAVE GFCI SENSING CAPABILITY PER NEC 700-6(D).

CONTRACTOR TO VERIFY EXISTING MUX LOCATION. IF MUX LOCATION IS OUTSIDE OF AT&T EQUIPMENT AREA, CONTRACTOR IS TO FIELD VERIFY THE PRESENCE OF EMERGENCY BACK-UP SERVICE TO THE MUX. IF EMERGENCY BACK-UP SERVICE IS NOT PRESENT, CONTRACTOR IS TO ROUTE NEW SERVICE FROM AT&T EQUIPMENT AREA.

SINGLE CARRIER WIRING DIAGRAM

PANEL (TO

BE REUSED)

		FEEDER S	SIZING CH	IART FOR GENERAT	FOR
GEN SET SIZE	VOLTS - PHASE	PRIME RATING KW - AMPS	SIZE OF INLINE BREAKER (AT GENERATOR)	MAIN BREAKER SIZE SERVING ANCHOR TENANT:	FEEDER SIZES FROM GEN SET BREAKER TO DISTRIBUTION PANEL / ATS.
50KW	120/240V - 1-PH	48KW - 200A	200A	200A 2-P C/B INTEGRAL TO GEN SET	3#3/0, 1#6G, IN 2°C

# NOTES:

- 1. SERVICE VOLTAGE FOR EACH CARRIER IS 120/240 1-PHASE, AND SERVICE SIZES ARE TYPICAL 200A PER CARRIER.
- 2. DISTRIBUTION PANEL IS 800A, 120/240V 1-PHASE, WITH 200A C/B FOR THE LISTED CARRIER OUTPUT. PANEL HAS (3) 200A BREAKER SPACES FOR FUTURE CARRIERS.
- 3. AUTOMATIC TRANSFER SWITCH (ATS) ARE 200A 2-POLES, 120/240V 1-PHASE WITH SOLID NEUTRAL PER CARRIER.
- 4. ALL ELECTRICAL EQUIPMENT IS NEMA 3R RATED.
- 5. THE GENERATOR ELECTRICAL LOADS ARE ADEQUATE FOR THE CONNECTED LOADS.
- 6. ALL EQUIPMENT FURNISHED SHALL BE PROVIDED WITH EQUIPMENT RATED TO WITHSTAND FAULT CURRENT AVAILABLE AT PROJECT SITE.

  7. ALL WIRE AND PANEL BUSSING SHALL BE COPPER UNLESS ALLOWED ELSEWHERE IN THIS DOCUMENT SET, WIRE SIZES ARE BASED ON COPPER.
- 8. A NEW SET OF PLANS WILL BE PROVIDED AND SUBMITTED FOR ADDITIONAL CARRIERS.
- 9. ALL WORK SHALL CONFORM WITH THE CURRENT VERSION OF THE NEC AND ALL OTHER APPLICABLE CODES.
- 10. FIRST OVER-CURRENT PROTECTION DEVICE IS INTEGRAL TO GENERATOR. FEEDER SIZES INDICATED IN TABLE ABOVE ARE DOWNSTREAM OF THE FIRST OVER-CURRENT PROTECTION DEVICE.
- 11. INLINE BREAKER AT GENERATOR IS FACTORY INSTALLED, AND IS THE MANUFACTURER'S RECOMMENDED SIZE.





Civil Engineering - Site Development Surveying - Telecommunications 500 NORTH BROADWAY EAST PROVIDENCE, RI 02914 PH: 401-354-2403 FAX 401-633-6354



TOWER RESOURCE MANAGEMENT 16 CHESTNUT STREET, SUITE 220 FOXBORO, MA 02035 WWW.TRMCOM.COM



550 COCHITUATE ROAD, SUITE 13 & 14 FRAMINGHAM MA 01701-4681



13010 MORRIS ROAD, 6TH FLOOR, BLDG 1 ALPHARETTA, GA 30004

SITE NUMBER:

10070913

# **ASHFORD** SOUTHEAST

SITE ADDRESS: 142 FITTS ROAD ASHFORD, CT 06278

THESE DRAWINGS AND/OR THE ACCOMPANYING SPECIFICATION AS INSTRUMENTS OF SERVICE ARE THE EXCLUSIVE PROPERTY OF ATC. TOWER SERVICES, INC. THEIR USE AND PUBLICATION SYALL BE RESTRICTED TO THE ORIGINAL SITE FOR WHICH THEY ARE PREPARED. ANY USE OR DISCLOSURE OTHER THAN THAT WHICH RELIES TO ATC. TOWER SERVICES, INC. OR THE SPECIFED CARRIER IS STRICTLY THE TO THESE DOCUMENTS SHALL REMAIN THE PROHIBITED, PROPERTY OF ATC TOWER SERVICES, INC WHETHER OR NOT THE PROLECT IS DECEVITED. NEITHER THE ARCHITECT NOT THE BENINEER WILL BE PROVIDING ON-SITE CONSTRUCTION REVIEW OF THIS CONTRACTORY, MIST VERFY ALL DIMENSIONS AND DAVISE PROJECT. ATC TOWER SERVICES, INC OF ANY DISCREPANCIES. ANY PRIOR ISSUANCE OF THIS DRAWING IS SUPERSECRED BY THE LATEST VERSION ON FILE WITH ATC TOWER SERVICES, INC.


STAMP HERE

0174111 1121121	
DRAWN BY:	JTG
CHECKED BY:	SNA
DATE DRAWN:	11-26-13
JOB NO:	10070913

SHEET TITLE:


WIRING DIAGRAM & SIZING CHARTS

SHEET NUMBER: REV. # NOTE: UTILITY POWER FEEDS SHALL BE CONNECTED TO THE TRANSFER SWITCH FROM THE LOAD SIDE OF THE EXISTING SERVICE DISCONNECT. NO MODIFICATIONS SHALL BE MADE ON THE LINE SIDE OF THE EXISTING SERVICE DISCONNECT.

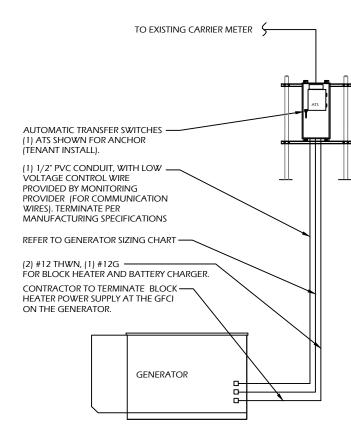

DISCONNECT POWER FEED FROM EXISTING METER TO EXISTING SHELTER. ROUTE NEW FEEDERS (SIZED BELOW) FROM METER TO NEW TRANSFER SWITCH AND BACK. RECONNECT NEW RETURN FEED FROM TRANSFER SWITCH TO SUPPLY POWER (UTILITY AND BACK-UP POWER) TO EXISTING SHELTER.



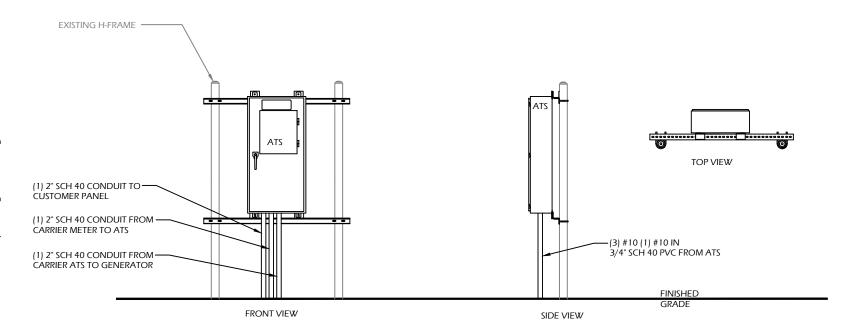



CONTRACTOR TO VERIFY EXISTING MUX LOCATION. IF MUX LOCATION IS OUTSIDE OF AT&T EQUIPMENT AREA, CONTRACTOR IS TO FIELD VERIFY THE PRESENCE OF EMERGENCY BACK—UP SERVICE TO THE MUX. IF EMERGENCY BACK—UP SERVICE IS NOT PRESENT, CONTRACTOR IS TO ROUTE NEW SERVICE FROM AT&T EQUIPMENT AREA.



Civil Engineering - Site Development Surveying - Telecommunications 500 NORTH BROADWAY EAST PROVIDENCE, RI 02914 PH: 401-354-2403 FAX: 401-633-6354



TOWER RESOURCE MANAGEMENT 16 CHESTNUT STREET, SUITE 220 FOXBORO, MA 02035 WWW.TRMCOM.COM



550 COCHITUATE ROAD, SUITE 13 & 14 FRAMINGHAM, MA 01701-4681



13010 MORRIS ROAD, 6TH FLOOR, BLDG 1 ALPHARETTA, GA 30004

SITE NUMBER:

10070913

ASHFORD SOUTHEAST

> SITE ADDRESS: 142 FITTS ROAD ASHFORD, CT 06278

THESE DRAWINGS AND/OR THE ACCOMPANYING SPECIFICATION AS INSTRUMENTS OF SERVICE ARE THE EXCLUSING PROPERTY OF ATC TOWER SERVICES, INC. THEIR USE AND PUBLICATION SHALL BE RESTRICTED TO THE ORIGINAL SITE FOR WHICH THEY ARE PREPARED. ANY USE OR DISCLOSURE OTHER THAN THAT WHICH RELIES TO ATC TOWER SERVICES, INC OR THE SPECIFIED CARRIER IS STRICTLY THE TO THESE DOCUMENTS SHALL REMAIN THE PROHIBITED, PROPERTY OF ATC TOWER SERVICES, INC WHETHER OR NOT THE PROJECT IS DECEUTED. NEITHER THE ARCHITECT NOR THE BOINGER WILL BE PROVIDING ON-SITE CONSTRUCTION REVIEW OF THIS CONTRACTOR'S WILL TURNEY ALL DIMENSIONS AND DAVISE PROJECT. ATC TOWER SERVICES, INC OF ANY DISCREPANCIES. ANY PRIOR ISSUANCE OF THIS DRAWING IS SUPERSEDED BY THE LATEST VERSION ON FILE WITH ATC TOWER SERVICES, INC.


STAMP HERE:

DRAWN BY:	JTG
CHECKED BY:	SNA
DATE DRAWN:	11-26-13
JOB NO:	10070913

SHEET TITLE:

ELECTRICAL & ATS MOUNTING DETAILS

SHEET NUMBER: REV. #

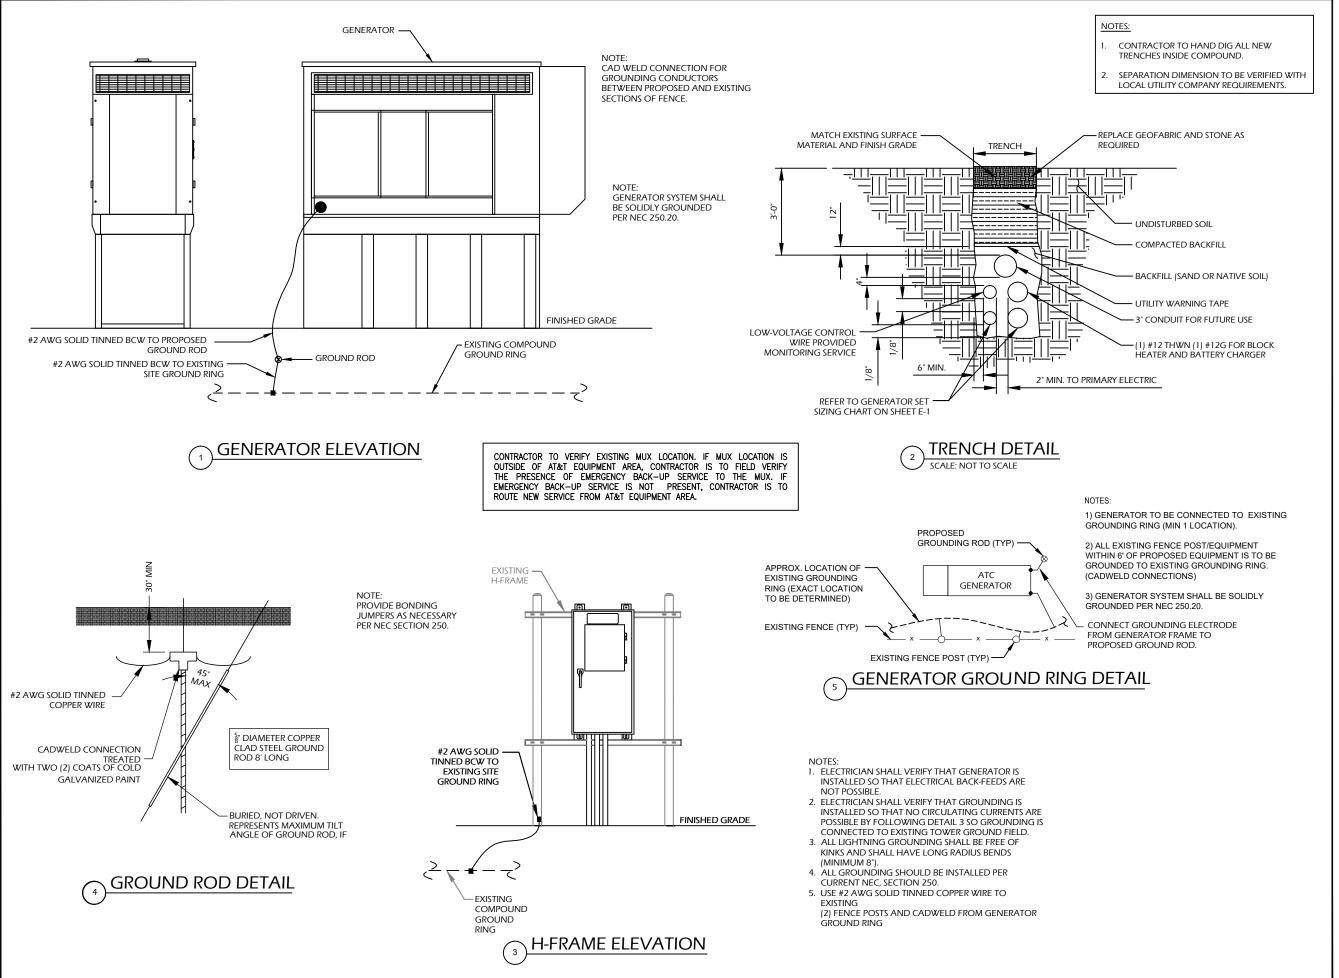

ENGINEERING GROUP, P.

Civil Engineering - Site Development Surveying - Telecommunications 500 NORTH BROADWAY EAST PROVIDENCE, RI 02914 PH: 401-354-2403 FAX 401-633-6354



TOWER RESOURCE MANAGEMENT 16 CHESTNUT STREET, SUITE 220 FOXBORO, MA 02035 WWW.TRMCOM.COM



550 COCHITUATE ROAD, SUITE 13 & 14 FRAMINGHAM MA 01701-4681



13010 MORRIS ROAD, 6TH FLOOR, BLDG 1 ALPHARETTA, GA 30004

SITE NUMBER:

10070913

SITE NAME:

# **ASHFORD** SOUTHEAST

SITE ADDRESS: 142 FITTS ROAD ASHFORD, CT 06278

THESE DRAWINGS AND/OR THE ACCOMPANYING SPECIFICATION AS INSTRUMENTS OF SERVICE ARE THE EXCLUSIVE PROPERTY OF ATC. TOWER SERVICES, INC. THEIR USE AND PUBLICATION SYALL BE RESTRICTED TO THE ORIGINAL SITE FOR WHICH THEY ARE PREPARED. ANY USE OR DISCLOSURE OTHER THAN THAT WHICH RELIES TO ATC. TOWER SERVICES, INC. OR THE SPECIFED CARRIER IS STRICTLY THE TO THESE DOCUMENTS SHALL REMAIN THE PROHIBITED, PROPERTY OF ATC TOWER SERVICES, INC WHETHER OR NOT THE PROLECT IS DECEVITED. NEITHER THE ARCHITECT NOT THE BENINEER WILL BE PROVIDING ON-SITE CONSTRUCTION REVIEW OF THIS CONTRACTORY, MIST VERFY ALL DIMENSIONS AND DAVISE PROJECT. ATC TOWER SERVICES, INC OF ANY DISCREPANCIES. ANY PRIOR ISSUANCE OF THIS DRAWING IS SUPERSECRED BY THE LATEST VERSION ON FILE WITH ATC TOWER SERVICES, INC.

STAMP HERE:

DRAWN BY:	JTG
CHECKED BY:	SNA
DATE DRAWN:	11-26-13
JOB NO:	10070913
CHEET TITLE	

**GROUNDING DETAILS** 

SHEET NUMBER:	REV. #
G-1	1

# STATE OF CONNECTICUT

## CONNECTICUT SITING COUNCIL

Ten Franklin Square, New Britain, CT 06051
Phone: (860) 827-2935 Fax: (860) 827-2950
E-Mail: siting.council@ct.gov
www.ct.gov/csc

November 3, 2015

Daniel M. Laub, Esq. Cuddy & Feder LLP 445 Hamilton Avenue, 14th Floor White Plains, NY 10601

RE: Request for Extension of Time for Construction for Previously Approved Exempt Modifications. Fixed Generator Deployments.

Dear Attorney Laub:

The Connecticut Siting Council (Council) is in receipt of the request from New Cingular Wireless, PCS, LLC (AT&T) for an extension of construction time for the attached exempt modifications requesting fixed generator deployments, dated October 29, 2015. Pusuant to the Council's decision letters for the attached list of previously approved exempt modifications, I have considered your request for an extension of construction time for these exempt modifications and grant an extension of time until June 30, 2016, to complete the construction of these projects.

This extension is granted with the understanding that the Council will be notified should New Cingular Wireless PCS, LLC (AT&T) decide not to proceed with construction of any of the exempt modifications on the attached list.

Sincerely,

Melanie A. Bachman Acting Executive Director

MAB/cm

EM-AT&T-001-140131	104 Bunker Hill	Andover
EM-AT&T-003-131209B	142 Fitts Road	Ashford
EM-AT&T-003-131209A	99 Knowlton Hill Road	Ashford
EM-AT&T-003-140127	36 Janoski Road	Ashford
EM-AT&T-004-131230	277 Huckleberry Hill Road	Avon
EM-AT&T-005-140131	127 New Hartford Road	Barkhamsted
EM-AT&T-006-140117	10 Terese Road (aka Rice Lane)	Beacon Falls
EM-AT&T-008-140131	179 Amity Road	Bethany
EM-AT&T-011-140227	28 Brewer Drive	Bloomfield
EM-AT&T-012-140131	49 South Road	Bolton
EM-AT&T-012-131223	130 Vernon Road	Bolton
EM-AT&T-020-140114	719 George Washington Tumpike	Burlington
EM-AT&T-020-140203	12 Nepaug Road	Burlington
EM-AT&T-027-131213	46 Meadow Road	Clinton
EM-AT&T-028-140127	Chestnut Hill Road	Colchester
EM-AT&T-028-140303	856 (812) Middletown Road	Colchester
EM-AT&T-029-140121	382 Colebrook River Road	Colebrook
EM-AT&T-032-140102	400 Riley Mountain Road	Coventry
EM-AT&T-069-140127	43 Connecticut Mills Road	Danielson
EM-AT&T-069-140114	79 Putnam Pike	Dayville
EM-AT&T-036-140127	15 Pent Road	Deep River
EM-AT&T-042-140207	94/96 East High Street	East Hampton
EM-AT&T-065-140303	350 Hartland Boulevard	East Hartland
EM-AT&T-039-140203	35 Old Route 44	Eastford
EM-AT&T-049-140114	188 Moody Road	Enfield
EM-AT&T-050-140203	10 Main Street	Essex
EM-AT&T-052-131209	130 Birdseye Road	Farmington
EM-AT&T-054-131230	2577 Main Street	Glastonbury
EM-AT&T-054-140127	577 Bell Street	Glastonbury
EM-AT&T-057-140130	36 Ritch Avenue West	Greenwich
EM-AT&T-060-140127	360 Rockland Road	Guilford
EM-AT&T-060-140303	145 Manor Road	Guilford
EM-AT&T-061-131209	285 Chamberlain Hill Road	Haddam
EM-AT&T-061-140131	525 Plains Road	Haddam
EM-AT&T-067-131230	107 Buck Road	Hebron
EM-AT&T-067-140106	66 Wall Street	Hebron
EM-AT&T-058-140224	181 A Norman Road	Jewett City
EM-AT&T-077-140117	60 Adams Street	Manchester
EM-AT&T-079-131209	175 South Main Street	Marlborough
EM-AT&T-080-140210	478 West Main Street	Meriden
EM-AT&T-081-140127	1021 Straits Turnpike	Middlebur <del>y</del>
EM-AT&T-082-131213	484 Meriden Road	Middlefield
EM-AT&T-082-140102	393 Jackson Hill Road	Middlefield
EM-AT&T-083-131216	1825 South Street	Middletown
EM-AT&T-083-140114	290 Preston Avenue	Middletown
EM-AT&T-083-140203	90 Industrial Park Road	Middletown
EM-AT&T-083-140207	1967 Saybrook Road	Middletown

EM-AT&T-085-140121	1428 Monroe Turnpike	Monroe
EM-AT&T-089-131205A		New Britain
EM-AT&T-089-140121	One Hartford Square	New Britain
EM-AT&T-089-131205B	178 Lester Street	New Britan
EM-AT&T-094-131216	123 Costello Road	Newington
EM-AT&T-094-140127	99 Cedarwood Lane	Newington
EM-AT&T-097-140121	3 Edmond Road	Newtown
EM-AT&T-099-140127	108 Foxon Road	North Branford
EM-AT&T-104-140303	300 Plain Hill Road	Norwich
EM-AT&T-107-140303	525 Orange Center Road	Orange
EM-AT&T-108-140206	338 Oxford Road	Oxford
EM-AT&T-112-140114	62 Babbitt Hill Road	Pomfret
EM-AT&T-113-131209	213 High Street	Portland
EM-AT&T-116-131209	152 Sayle Avenue	Putnam
EM-AT&T-117-140303	22 Wayside Lane	Redding
EM-AT&T-119-131230	47 Inwood Road	Rocky Hill
EM-AT&T-119-140210	699 Old Main Street	Rocky Hill
EM-AT&T-124-140203	6 Progress Avenue	Seymour
EM-AT&T-128-131213	Grist Mill Road	Simsbury
EM-AT&T-132-131230	151 Sand Hill Road	South Windsor
EM-AT&T-134-140110	157 Chestnut Mountain Road	Stafford Springs
EM-AT&T-139-131230	44 Ffyler Place	Suffield
EM-AT&T-146-140203	47 Main Street	Talcottville (Vernon)
EM-AT&T-142-140127	130 Bald Hill Road	Tolland
EM-AT&T-143-140117	350 Burr Mountain Road	Torrington
EM-AT&T-143-140130	1925 East Main Street	Torrington
EM-AT&T-144-140210	307 Indian Park Ledge Road	Trumbull
EM-AT&T-086-140210	57 Cook Drive	Uncasville
EM-AT&T-146-140114	60 Industrial Park Road	Vernon Rockville
EM-AT&T-155-140131	491 South Quaker Lane	West Hartford
EM-AT&T-163-131209	10 North Ridge Drive	Windham
EM-AT&T-164-131213	482 Pigeon Hill Road	Windsor
EM-AT&T-164-131216	50 Pine Lane	Windsor
EM-AT&T-167-140227	1116 Johnson Road	Woodbridge
EM-AT&T-168-140127	103 Great Hollow Road	Woodbury
EM-AT&T-168-140203	478 Good Hill Road	Woodbury
EM-AT&T-169-140109	215 Coatney Hill Road	Woodstock



445 Hamilton Avenue, 14th Floor White Plains, New York 10601 Tel 914.761.1300 Fax 914.761.5372 www.cuddyfeder.com

October 29, 2015

# **VIA EMAIL & FIRST CLASS MAIL**

Melanie Bachman, Esq. Executive Director Connecticut Siting Council 10 Franklin Square New Britain, CT 06051

Re:

New Cingular Wireless PCS, LLC (AT&T)

**Exempt Modification Approvals** 

Extension Request

Dear Executive Director Bachman:

We are writing on behalf of our client, New Cingular Wireless PCS, LLC ("AT&T"), to request another one-year extension of various exempt modification acknowledgements (EM's) issued by the Siting Council in response to AT&T filings during the period of December 2013 through March 2014, which were previously extended to December 31, 2015. These filings all relate to fixed generator deployments by AT&T at tower sites in Connecticut which have largely been deferred until 2016. The list of EM sites is the attachment to your letter dated November 20, 2014. Accordingly, we respectfully request that all of the EM's listed be extended for one-year to the end of 2016.

Thank you in advance for your consideration of this request.

Very truly yours,

Daniel M. Laub

**Enclosures** 

cc: Michele Briggs, AT&T

Richard Detch, AT&T

# STATE OF CONNECTICUT

# . CONNECTICUT SITING COUNCIL

Ten Franklin Square, New Britain, CT 06051 Phone: (860) 827-2935 Fax: (860) 827-2950 E-Mail: siting.council@ct.gov www.ct.gov/csc

November 20, 2014

Christopher B. Fisher, Esq. Cuddy & Feder LLP 445 Hamilton Avenue, 14th Floor White Plains, NY 10601

RE:

Request for Extension of Time for Construction for Previously Approved Exempt Modifications. Fixed Generator Deployments.

Dear Attorney Fisher:

The Connecticut Siting Council (Council) is in receipt of the request from New Cingular Wireless, PCS, LLC (AT&T) for an extension of construction time for the attached exempt modifications requesting fixed generator deployments, dated November 18, 2014. Pusuant to the Council's decision letters for the attached list of previously approved exempt modifications, I have considered your request for an extension of construction time for these exempt modifications and grant an extension of time until December 31, 2015, to complete the construction of these projects.

This extension is granted with the understanding that the Council will be notified should New Cingular Wireless PCS, LLC (AT&T) decide not to proceed with construction of any of the exempt modifications on the attached list.

Sincerely,

Melanie A. Bachman Acting Executive Director

MAB/CDM/cm



	•		
EM-AT&T-001-140131	104 Bunker Hill	Andover	•
ЕМ-AT&T-003-131209В	142 Fitts Road	Ashford	
EM-AT&T-003-131209A	99 Knowlton Hill Road	Ashford	
EM-AT&T-003-140127	36 Janoski Road	Ashford	
EM-AT&T-004-131230	277 Huckleberry Hill Road	Avon	
EM-AT&T-005-140131	127 New Hartford Road	Barkhamsted	•
EM-AT&T-006-140117	10 Terese Road (aka Rice Lane)	Beacon Falls	•
EM-AT&T-008-140131	179 Amity Road	Bethany	
EM-AT&T-011-140227	28 Brewer Drive	Bloomfield	
EM-AT&T-012-140131	49 South Road	Bolton	
EM-AT&T-012-131223	130 Vernon Road	Bolton	
EM-AT&T-020-140114	719 George Washington Turnpike	Burlington	
EM-AT&T-020-140203	12 Nepaug Road	Burlington	
EM-AT&T-027-131213	46 Meadow Road	Clinton	
EM-AT&T-028-140127	Chestnut Hill-Road	Colchester	
EM-AT&T-028-140303	856 (812) Middletown Road	Colchester	
EM-AT&T-029-140121	382 Colebrook River Road	Colebrook	<del></del>
EM-AT&T-032-140102	400 Riley Mountain Road	Coventry	
EM-AT&T-069-140127	43 Connecticut Mills Road	Danielson	
EM-AT&T-069-140114	79 Putnam Pike	Dayville	
EM-AT&T-036-140127	15 Pent Road	-	
EM-AT&T-042-140207	94/96 East High Street	Deep River	
EM-AT&T-065-140303	350 Hartland Boulevard	East Hampton East Hartland	•
EM-AT&T-003-140203	35 Old Route 44	Eastford	
EM-AT&T-049-140114		Enfield	
EM-AT&T-050-140203	188 Moody Road 10 Main Street	Essex	
EM-AT&T-050-140203 EM-AT&T-052-131209			
EM-AT&T-054-131230	130 Birdseye Road 2577 Main Street	Farmington	
EM-AT&T-054-140127	577 Bell Street	Glastonbury	
EM-AT&T-057-140130	36 Ritch Avenue West	Glastonbury Greenwich	·
EM-AT&T-060-140127	360 Rockland Road	Guilford	
EM-AT&T-060-140303	145 Manor Road	Guilford	
EM-AT&T-000-140303 EM-AT&T-061-131209	285 Chamberlain Hill Road	Haddam	
EM-AT&T-061-140131	525 Plains Road		
EM-AT&T-067-131230	107 Buck Road	Haddam	
EM-AT&T-067-140106	66 Wall Street	Hebron	,
	·	Hebron	q = 1 - 2
EM-AT&T-058-140224	181 A Norman Road	Jewett City	
EM-AT&T-077-140117	60 Adams Street	Manchester	
EM-AT&T-079-131209	175 South Main Street	Marlborough	•
EM-AT&T-080-140210	478 West Main Street	Meriden	
EM-AT&T-081-140127	1021 Straits Turnpike	Middlebury	
EM-AT&T-082-131213	484 Meriden Road	Middlefield	
EM-AT&T-082-140102	393 Jackson Hill Road	Middlefield	
EM-AT&T-083-131216	1825 South Street	Middletown	
EM-AT&T-083-140114	290 Preston Avenue	Middletown	
EM-AT&T-083-140203	90 Industrial Park Road	Middletown	
EM-AT&T-083-140207	1967 Saybrook Road	Middletown	•

.

EM-AT&T-085-140121 1	1428 Monroe Turnpike	Monroe		
EM-AT&T-089-131205A	<del></del>	New Britain		
	One Hartford Square	New Britain		
EM-AT&T-089-131205B	-	New Britan		
	123 Costello Road	Newington		
	99 Cedarwood Lane	Newington		
	3 Edmond Road	Newtown	•	
	108 Foxon Road	North Branford		
	300 Plain Hill Road	Norwich		
	525 Orange Center Road	Orange		
	338 Oxford Road	Oxford		
	62 Babbitt Hill Road	Pomfret		
	213 High Street	Portland		
	152 Sayle Avenue	Putnam	•	
	22 Wayside Lane	Redding		
	47 Inwood Road	Rocky Hill		
	699 Old Main Street	Rocky Hill		
	6 Progress Avenue	Seymour		
	Grist Mill Road	Simsbury		
	151 Sand Hill Road	South Windsor		
	157 Chestnut Mountain Road	Stafford Springs		
	44 Ffyler Place	Suffield		
	47 Main Street	Talcottville (Vernon)		
	130 Bald Hill Road	Tolland		
EM-AT&T-143-140117	350 Burr Mountain Road	Torrington		
EM-AT&T-143-140130	1925 East Main Street	Torrington		
EM-AT&T-144-140210	307 Indian Park Ledge Road	Trumbull		
EM-AT&T-086-140210	57 Cook Drive	Uncasville		
EM-AT&T-146-140114	60 Industrial Park Road	Vernon Rockville		
EM-AT&T-155-140131	491 South Quaker Lane	West Hartford		
EM-AT&T-163-131209	10 North Ridge Drive	Windham	· · · · · · · · · · · · · · · · · · ·	
EM-AT&T-164-131213	482 Pigeon Hill Road	Windsor		
EM-AT&T-164-131216	50 Pine Lane	Windsor		
EM-AT&T-167-140227	1116 Johnson Road	Woodbridge		
EM-AT&T-168-140127	103 Great Hollow Road	Woodbury		
EM-AT&T-168-140203	478 Good Hill Road	Woodbury		
EM-AT&T-169-140109	215 Coatney Hill Road	Woodstock	•	



November 18, 2014

445 Hamilton Avenue, 14th Floor White Plains, New York 10601 Tel 914.761.1300 Fax 914.761.5372 www.cuddyfeder.com

# VIA EMAIL & FIRST CLASS MAIL


Melanie Bachman, Esq. Executive Director Connecticut Siting Council 10 Franklin Square New Britain, CT 06051

Re:

New Cingular Wireless PCS, LLC (AT&T)

Exempt Modification Approvals

Extension Request\_

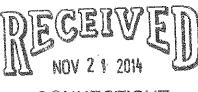

CONNECTICUT SITING COUNCIL

Dear Executive Director Bachman:

On behalf of our client, New Cingular Wireless PCS, LLC ("AT&T"), we are writing to request a one-year extension of various exempt modification acknowledgements (EM's) issued by the Siting Council in response to AT&T filings during the period of December 2013 through March 2014. These filings all relate to fixed generator deployments by AT&T at tower sites in Connecticut. Attached is a list of the EM sites with their respective acknowledgement dates. We respectfully request that all of the EM's listed be extended for one-year to the end of 2015.

Thank you in advance for your consideration of this request.

Very truly yours,

Christopher B. Fisher

Enclosures

cc:

Michele Briggs, AT&T

Richard Detch, AT&T

			CSC Zoning	
	C'I	CSC Zoning Submit	Approved	<u>EM#</u>
Address	City	1/23/2014	2/18/2014	028-140127
CHESTNUT HILL ROAD	COLCHESTER	1/23/2014	12/27/2013	113-131209
213 HIGH STREET	PORTLAND	12/17/2013	1/10/2014	012-131223
130 VERNON ROAD	BOLTON	2/26/2014	3/24/2014	060-140303
145 MANOR ROAD	GUILFORD	1/28/2014	2/18/2014	061-140131
525 PLAINS ROAD	HADDAM	1/28/2014	2/19/2014	008-140131
719 AMITY ROAD	BETHANY	1/28/2014	2/21/2014	050-140203
10 MAIN STREET	ESSEX	1/8/2014	2/6/2014	083-140114
290 PRESTON AVENUE	MIDDLETOWN	1/31/2014	2/21/2014	146-140203
47 MAIN STREET	TALCOTTVILLE	• •	2/19/2014	094-140127
99 CEDARWOOD LANE	NEWINGTON	1/23/2014	3/4/2014	086-140210
57 COOK DRIVE	UNCASVILLE	2/6/2014	3/19/2014	011-140227
28 BREWER DRIVE (CEMETARY)	BLOOMFIELD	2/24/2014	3/21/2014	107-140303
525 ORANGE CENTER ROAD	ORANGE	2/27/2014	2/24/2014	083-140203
90 INDUSTRIAL PARK ROAD	MIDDLETOWN	1/29/2014	•	077-140117
60 ADAMS STREET	MANCHESTER	1/14/2014	2/7/2014	081-140127
1021 STRAITS TURNPIKE	MIDDLEBURY	1/23/2014	2/18/2014	139-131230
FFYLER ROAD	SUFFIELD	12/27/2013	1/22/2014	164-131213
482 PIGEON HILL ROAD	WINDSOR	12/19/2013	1/2/2014	128-131213
GRIST MILL ROAD	SIMSBURY	12/11/2013	1/2/2014	003-140127
36 JANOSKI ROAD	ASHFORD	1/23/2014	2/18/2014	083-140207
1967 SAYBROOK ROAD	MIDDLETOWN	2/4/2014	2/24/2014	104-140303
300 PLAIN HILL ROAD	NORWICH	2/25/2014	3/21/2014	005-140131
127 NEW HARTFORD ROAD	BARKHAMSTED	1/28/2014	2/18/2014	
338 OXFORD ROAD	OXFORD	2/3/2014	2/24/2014	108-140206
104 BUNKER HILL ROAD	ANDOVER	1/28/2014	2/18/2014	001-140131
151 SAND HILL ROAD DUP 1	SOUTH WINDSOR	12/27/2013	1/23/2014	132-131230
BURR MOUNTAIN ROAD	TORRINGTON	1/14/2014	2/7/2014	143-140117
154 SAYLE AVENUE	PUTNAM	12/6/2013	12/27/2013	116-131209
307 INDIAN PARK LEDGE ROAD	TRUMBULL	2/6/2014	3/4/2014	144-140210
1116 JOHNSON ROAD	WOODBRIDGE	2/24/2014	3/19/2014	167-140227 042-140207
94 EAST HIGH STREET	EAST HAMPTON	2/4/2014	2/21/2014	=
400 RILEY MOUNTAIN ROAD	COVENTRY	12/30/2013	1/23/2014	032-140102
103 GREAT HOLLOW ROAD	WOODBURY	1/23/2014	2/18/2014	168-140127
719 GEORGE WASHINGTON TU	R BURLINGTON	1/8/2014	2/6/2014	020-140114
175 SOUTH MAIN STREET	MARLBOROUGH	12/6/2013	12/27/2013	079-131209
1825 SOUTH MAIN STREET	MIDDLETOWN	12/13/2013	1/6/2014	083-131216
123 COSTELLO ROAD	NEWINGTON	12/13/2013	1/6/2014	094-131216
1925 EAST MAIN STREET	TORRINGTON	1/27/2014	2/18/2014	143-140130
50 PINE LANE	WINDSOR	12/13/2013	1/6/2014	164-131216
46 MEADOW ROAD	CLINTON	12/9/2013	2/24/2014	027-131213
856 MIDDLETOWN ROAD	COLCHESTER	2/27/2014	3/21/2014	028-140303
62 BABBITT HILL ROAD	POMFRET	1/8/2014	2/7/2014	112-140114
577 BELL STREET	GLASTONBURY	1/23/2014	2/18/2014	054-140127
215 COATNEY HILL ROAD	WOODSTOCK	1/6/2014	2/7/2014	169-140109
10 NORTH RIDGE DRIVE	WINDHAM	12/6/2013	12/27/2013	163-131209
142 FITTS ROAD	ASHFORD	12/6/2013	12/27/2013	003-131209B
60 RICE LANE	BEACON FALLS	1/14/2014	2/7/2014	006-140117
49 SOUTH ROAD	BOLTON	1/28/2014	2/19/2014	012-140131
47 INWOOD ROAD	ROCKY HILL	12/27/2013	1/22/2014	119-131230
10 PENT ROAD	DEEP RIVER	1/23/2014	2/19/2014	036-140127
130 BIRDSEYE ROAD	FARMINGTON	12/6/2013	12/27/2013	052-131209
2577 MAIN STREET	GLASTONBURY	12/27/2013	1/22/2014	054-131230
36 RITCH AVENUE WEST	GREENWICH	1/27/2014	2/18/2014	057-140130

4 O4 A NODRAANI DOAD	JEWETT CITY	2/19/2014	3/19/2014	058-140224
181 A NORMAN ROAD	HEBRON	12/27/2013	1/23/2014	067-131230
107 BUCK ROAD	DAYVILLE	1/9/2014	2/6/2014	069-140114
79 PUTnam PIKE	DANIELSON	1/24/2014	2/19/2014	069-140127
43 CONNECTICUT MILLS ROAD	MERIDEN	2/7/2014	3/4/2014	080-140210
450-478 WEST MAIN STREET	MIDDLEFIELD	12/30/2013	1/23/2014	082-140102
393 JACKSON HILL ROAD	MIDDLEFIELD	12/9/2013	1/2/2014	082-131213
484 MERIDEN ROAD	MONROE	1/16/2014	2/7/2014	085-140121
1428 MONROE TURNPIKE	NORTH BRANFORD	1/23/2014	2/19/2014	099-140127
108 FOXON ROAD	NEW BRITAIN	1/16/2014	1/22/2014	089-140121
ONE HARTFORD SQUARE	TOLLAND	1/23/2014	2/19/2014	142-140127
130 BALD HILL ROAD	VERNON ROCKVILLE	1/8/2014	2/10/2014	146-140114
60 INDUSTRIAL PARK ROAD	WOODBURY	1/29/2014	2/21/2014	168-140203
478 GOOD HILL ROAD	WEST HARTFORD	1/28/2014	2/18/2014	155-140131
491 SOUTH QUAKER LANE	ASHFORD	12/6/2013	12/27/2013	003-131209A
99 KNOWLTON HILL ROAD	BURLINGTON	1/29/2014	2/24/2014	020-140203
12 NEPAUG ROAD	HEBRON	1/2/2014	1/28/2014	067-140106
66 WALL STREET	ENFIELD	1/9/2014	2/7/2014	049-140114
188 MOODY ROAD	NEWTOWN	1/16/2014	2/7/2014	097-140121
3 EDMOND ROAD	NEW IOWN	12/5/2013	12/20/2013	089-131205A
200 STANLEY STREET	NEW BRITAIN	12/5/2013	12/27/2013	089-131205B
178 LESTER STREET	GUILFORD	1/23/2014	2/19/2014	060-140127
370 ROCKLAND ROAD	SEYMOUR	1/29/2014	2/24/2014	124-140203
6 PROGRESS AVENUE	AVON	12/27/2013	1/23/2014	004-131230
277 HUCKLEBERRY HILL ROAD	AVON EAST HARTLAND	2/26/2014	3/24/2014	065-140303
350 HARTLAND BOULEVARD	REDDING	2/26/2014	3/24/2014	117-140303
22 WAYSIDE LANE		12/6/2013	2/24/2014	061-131209
285 CHAMBERLAIN HILL ROAD	HADDAM COLEBROOK	1/16/2014	2/7/2014	029-140121
382 COLEBROOK RIVER ROAD	= = :	1/7/2014	2/7/2014	134-140110
157 CHESTNUT MOUNTAIN RO		1/29/2014	2/24/2014	039-140203
35 OLD ROUTE 44	EASTFORD	2/6/2014	2/28/2014	119-140210
699 OLD MAIN STREET	ROCKY HILL	2/0/2014	2,20,2014	115 1.7-10