



James M. Yeske, Jr., Manager,  
Electric Capital Line Projects

VIA FEDEX AND ELECTRONIC MAIL

March 5, 2019

James J. Murphy, Jr.  
Vice Chairman  
The Connecticut Siting Council  
Ten Franklin Square  
New Britain, CT 06051

Re: **The United Illuminating Company's Notice of Exempt Modification Pursuant to R.C.S.A. § 16-50j-58 to Existing Energy Facility Site between Pequonnock Substation in Bridgeport and Sasco Creek Substation in Westport ("Notice of Exempt Modification")**

Dear Vice Chairman Murphy:


Pursuant to Regulations of Connecticut State Agencies ("R.C.S.A.") §16-50j-58, The United Illuminating Company ("UI") hereby notifies the Connecticut Siting Council (the "Council") of its intent to make exempt modifications (the "Project") to its transmission line along the Metro-North Railroad corridor ("Railroad Corridor") from Pequonnock Substation in Bridgeport to Ash Creek Substation in Fairfield interconnecting with The Connecticut Light and Power Company d/b/a Eversource Energy's ("Eversource") Sasco Creek Substation in Westport ("Facility" or "Energy Facility"). The \$625 filing fees, along with 2 copies of this Notice of Exempt Modification, are enclosed herewith.

#### Existing Energy Facility


The Facility begins at Pequonnock Substation in the City of Bridgeport at 41°10'20"N and  $\Lambda$  73°11'06"W and proceeds in a westerly direction approximately 3.75 miles along the Railroad Corridor to Ash Creek Substation at 41°09'23"N and  $\Lambda$  73°14'03"W continuing westerly an additional 5.27 miles interconnecting with Eversource's Sasco Creek Substation at 41°07'27"N and  $\Lambda$  73°18'29"W:

The existing Facility consists of a FOCAS Skylite 12 fiber Optical Ground Wire (OPGW) completed in 1994. This Facility provides communications and lightning protection for UI's and Eversource's 115 kV transmission lines and are installed on bonnet extensions on top of the Metro-North catenary system from Pequonnock Substation to Metro-North Catenary # 737 (41°10'20.58"N and  $\Lambda$  73°11'6.62"W). At this point the Facility is erected on single circuit monopole structures installed within the Railroad Corridor continuing westerly to Eversource's Sasco Creek Substation.

### Aerial Photos of the Facilities

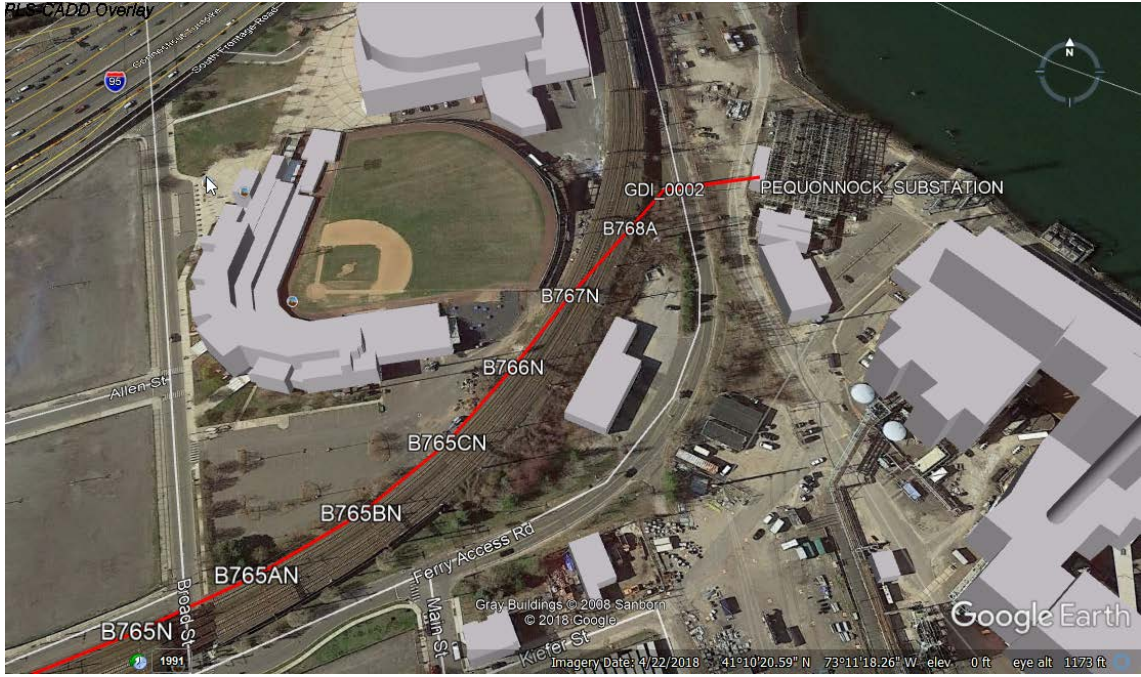

UI's Pequonnock Substation - Google Earth 2/23/19

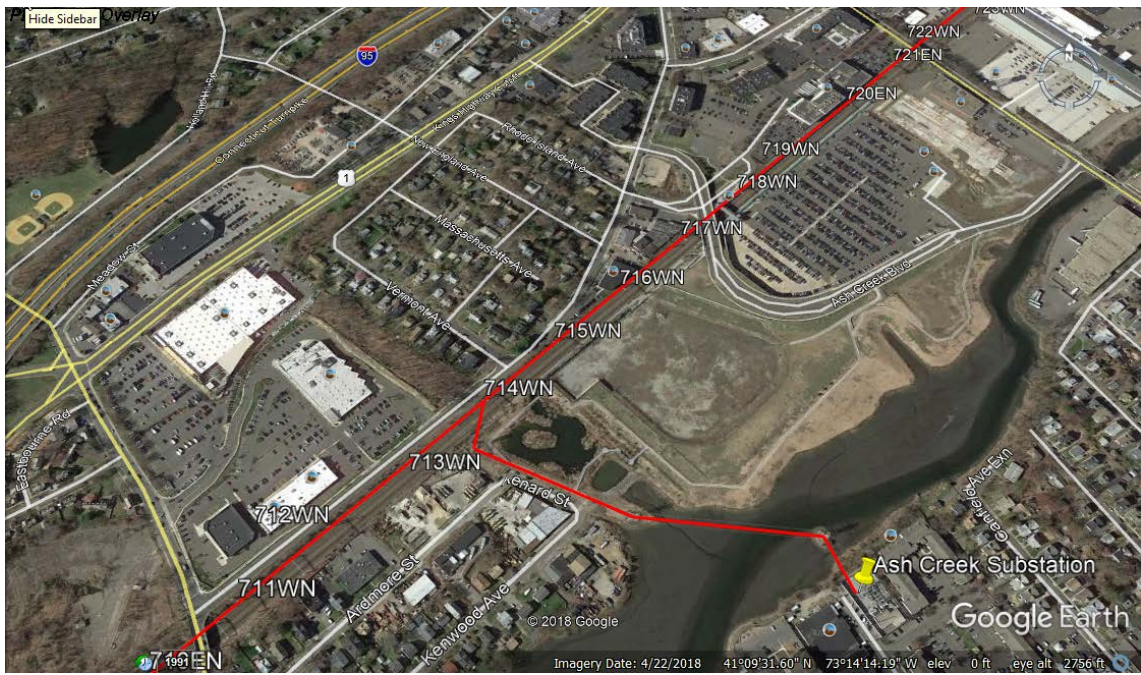


UI's Ash Creek Substation - Google Earth 2/23/19




Eversource's Sasco Creek Substation - Google Earth 2/23/19

GIS Photo of the Facility

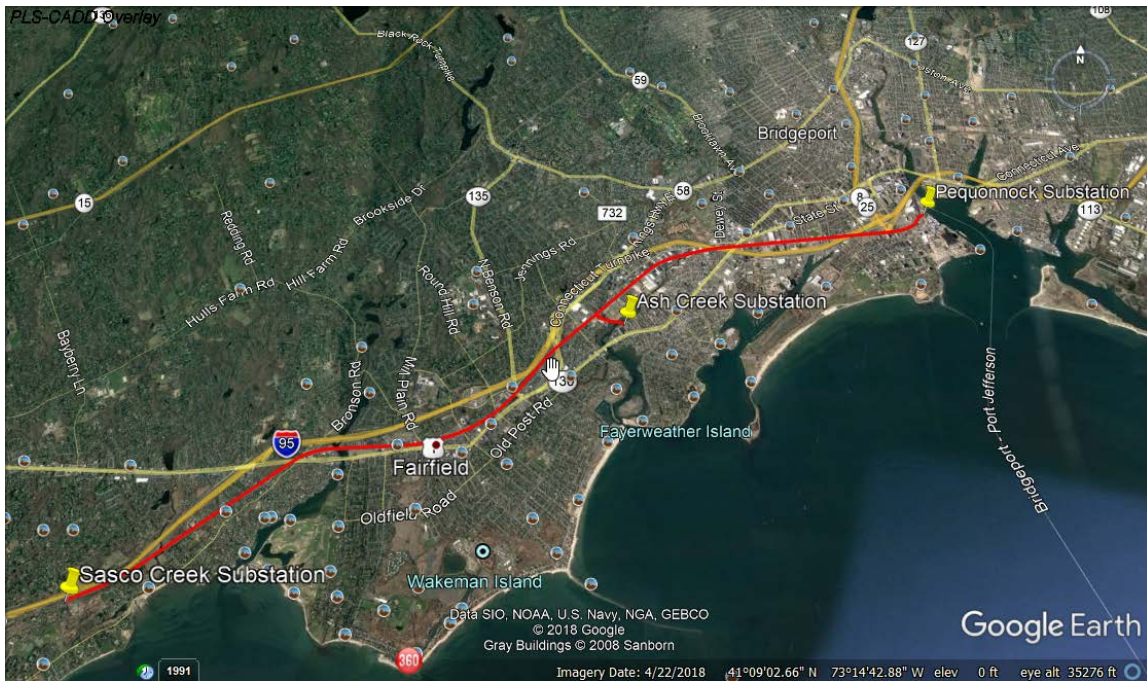

1130/1430 Fiber Route Pequonnock-Ash Creek-Sasco Creek - Google Earth 2/23/19


## Existing Site and Equipment

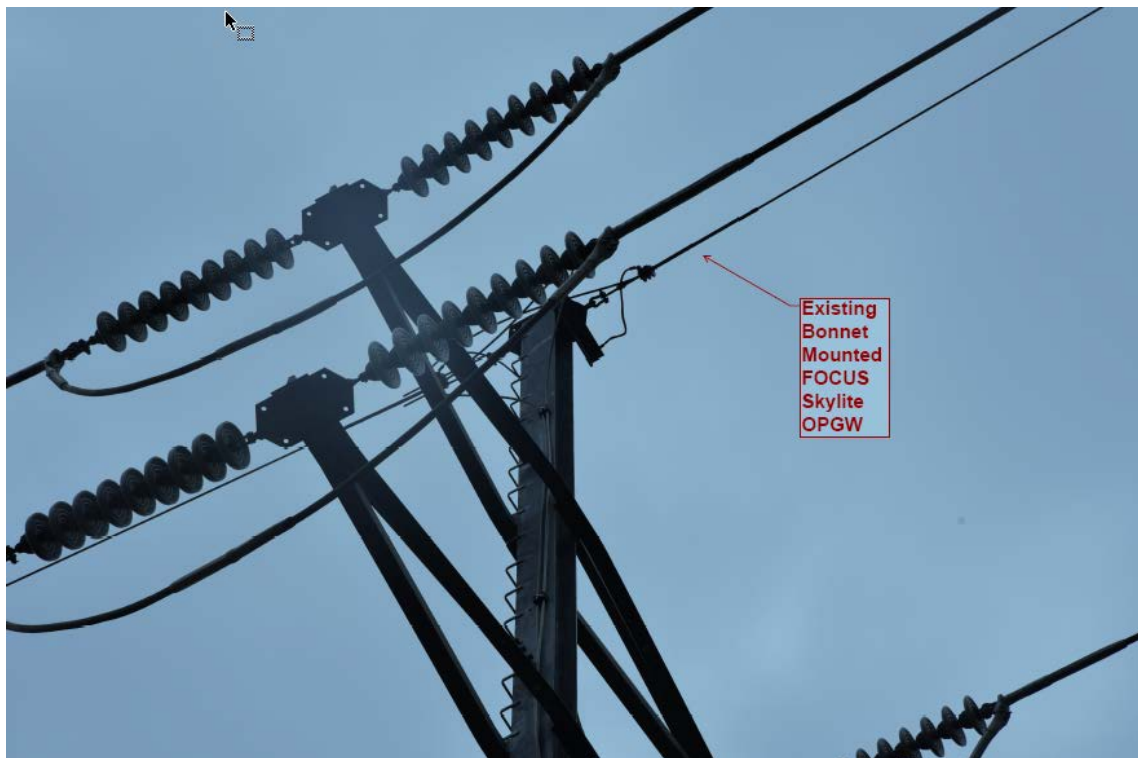

Typical Bonnet Mounted OPGW & Splice Can L753 – August 5, 2019 Inspection




Typical Bonnet Mounted OPGW & Splice Can L753 – August 5, 2019 Inspection

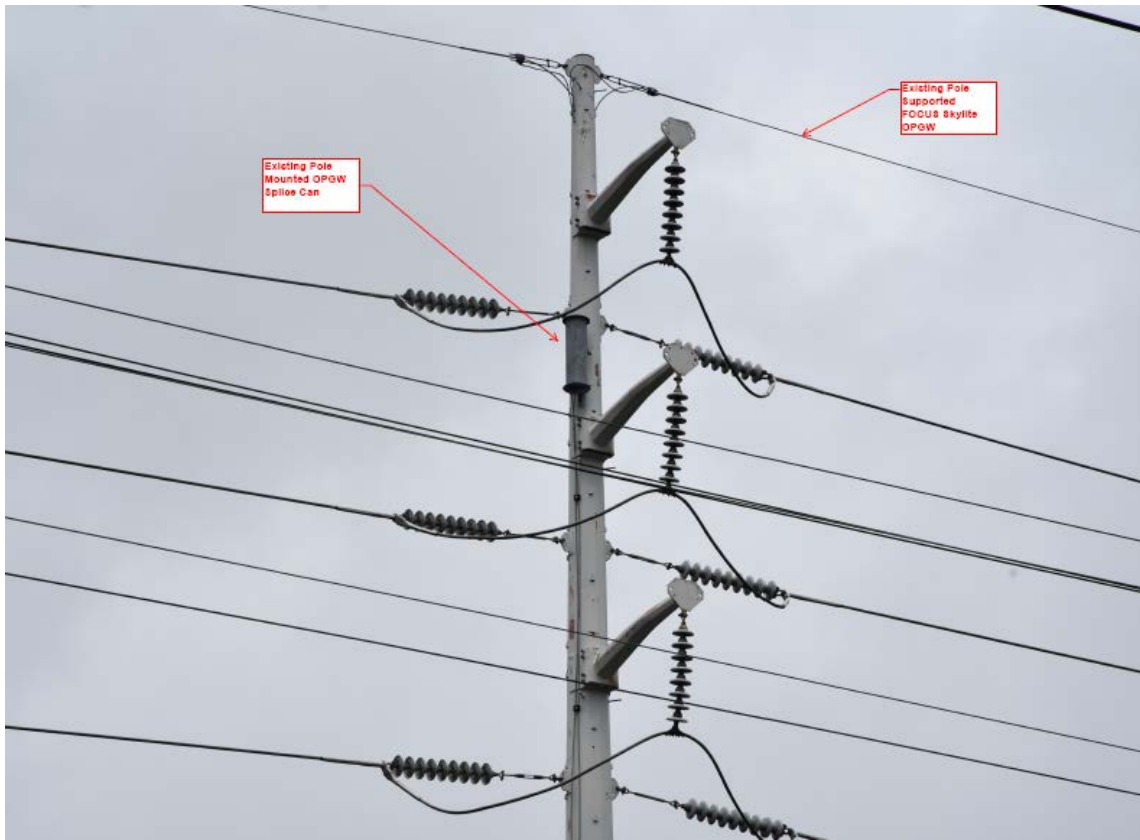

Typical Pole Mounted OPGW & Splice Can L704N – August 5, 2018 Inspection

### Proposed Modifications

UI is proposing to replace the existing FOCAS Skylite 12 OPGW (See Attachment B for existing OPGW Cut Sheet) with a new Prysmian 64K78s 48 fiber OPGW (See Attachment C for proposed OPGW Cut Sheet). This replacement is due to fiber communication issues associated with loss of signal, fiber breaks, lack of spare fibers and intermittent signal failure. This OPGW is critical for the reliable operation of UI's and Eversource's transmission system. These fibers are used to monitor and control the 1130, 1430, and 91001 Lines primary relaying, UI's and Eversource's Jungle MUX, UI's Corporate Network, UI's Supervisory Control and Data Acquisition Network, Advanced Metering Infrastructure communications, and Ash Creek Substation's telecommunications system. As the Project relates solely to improving system maintenance, the modifications will not impact the existing Facility's structural capability or impact electric and magnetic fields or noise levels.

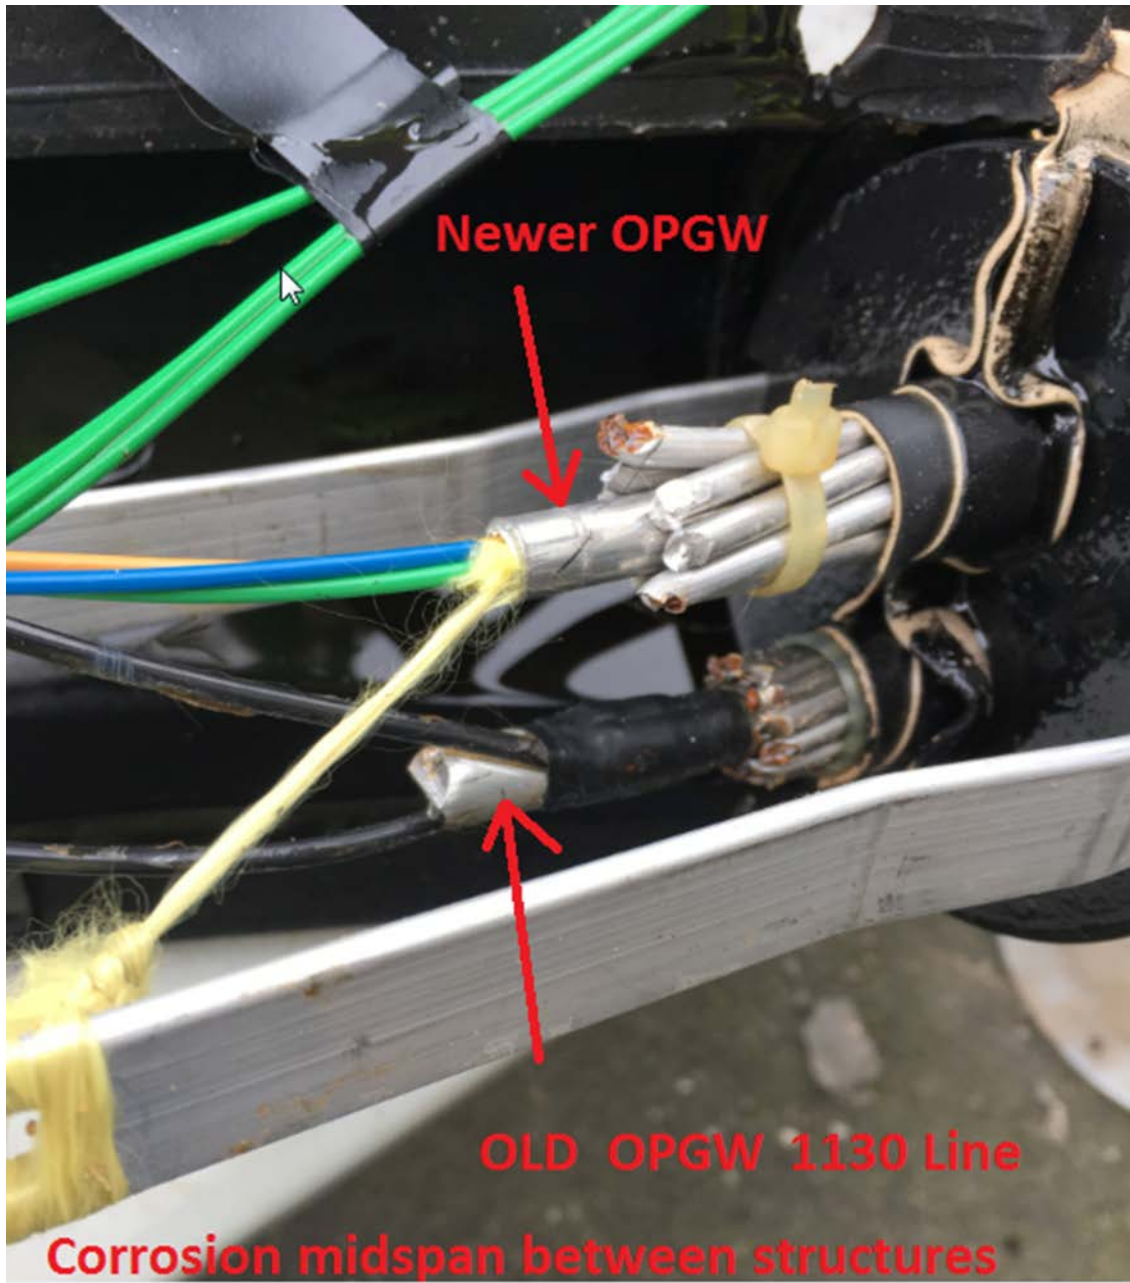

OPGW Inspection – December 8, 2018

Compliance with R.C.S.A. § 16-50j-57(b)

Pursuant to R.C.S.A. § 16-50j-57(b), the Project does not constitute a modification to an existing facility that may have a substantial adverse environmental effect and are exempt from the requirement to obtain a certificate pursuant to Section 16-50k of the Connecticut General Statutes. Specifically, consistent with R.C.S.A. § 16-50j-57(b), the proposed changes to the existing site do not:

- (A) Extend the boundaries of the site beyond the existing right-of-way;
- (B) Increase the height of existing associated equipment;
- (C) Increase noise levels along the right-of-way by six decibels or more, or to levels that exceed state and local criteria;
- (D) Impact electric and magnetic field levels along the right-of-way in a manner that is inconsistent with the Council's Best Management practices for Electric and Magnetic Fields;
- (E) Cause a significant adverse change or alteration in the physical or environmental characteristics of the right-of-way; or
- (F) Impair the structural integrity of the facility, as determined in a certification provided by a professional engineer licensed in Connecticut, where applicable.


The Project would not have a substantial adverse environmental effect or cause a significant adverse change or alteration in the physical or environmental characteristics because:

- (A) The Project would be located within the transmission line's existing right-of-way; the right-of-way area would not be expanded;
- (B) The equipment would be no taller than existing equipment within the right-of-way;
- (C) There would be no change to the existing television or radio interference resulting from the modifications of the transmission line;
- (D) Sound-pressure levels at all points along properties lines would continue to meet state regulations set out in R.C.S.A. §§ 22a-69-1 et seq.;
- (E) The project work would not affect water resource areas.
- (F) UI's review of the Connecticut Department of Energy and Environmental Protection's Natural Diversity Data Base did not identify any state-listed endangered, threatened, or special concern species in the vicinity of the Project; and
- (G) Electric and Magnetic field levels along the transmission line will not change as a result of the Project.

UI intends to initiate the Project on or after the Council's acknowledgement that the proposed activities are exempt.

Please do not hesitate to contact me at 203-988-9746 should you have any questions regarding this notice.

Very truly yours,

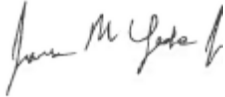

James M. Yeske Jr.  
Manager – Electric Capital Line Projects  
The United Illuminating Company

cc: The Honorable Joseph P. Ganim Mayor, City of Bridgeport  
The Honorable Mike Tetreau, First Selectman, Town of Fairfield  
The Honorable Jim Marpe, First Selectman, Town of Westport  
Kathleen M. Shanley, Manager – Transmission Siting, Eversource Energy  
Christopher Soderman, Engineering Manager, Eversource Energy  
Amy Hicks, The United Illuminating Company, Public Outreach

Enclosures

Attachment A – Design Drawings


Attachment B – Existing FOCUS Skylite OPGW Cut Sheet

Attachment C – Proposed Prysmian OPGW Cut Sheet


Attachment D - Structure Load Comparison




**Attachment A**

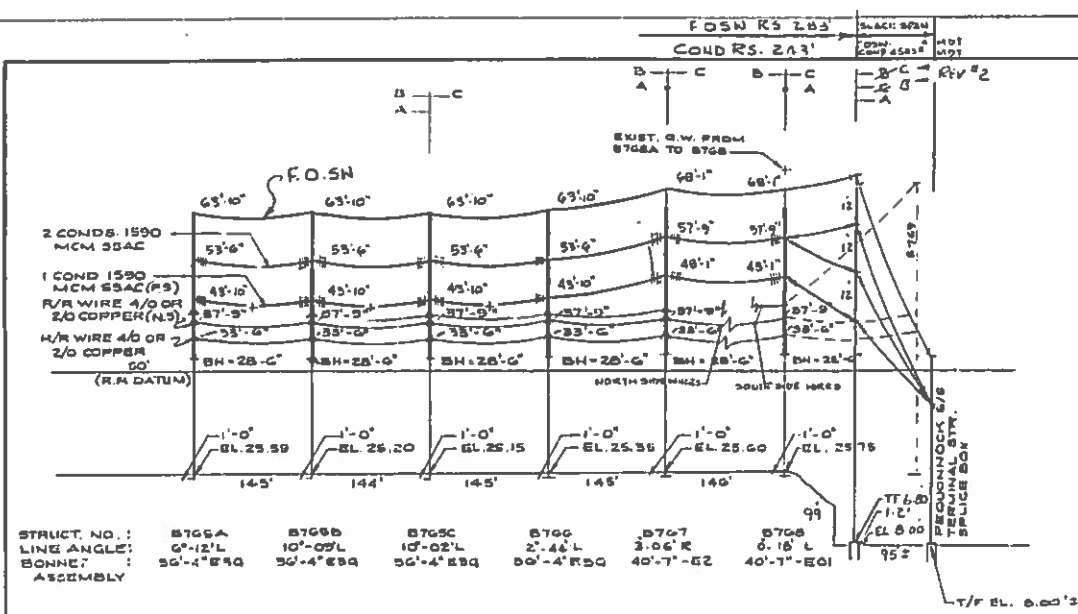

**NORTH PROFILE**  
SCALE: HORIZ: 1"=100'  
VERT: 1"=20'

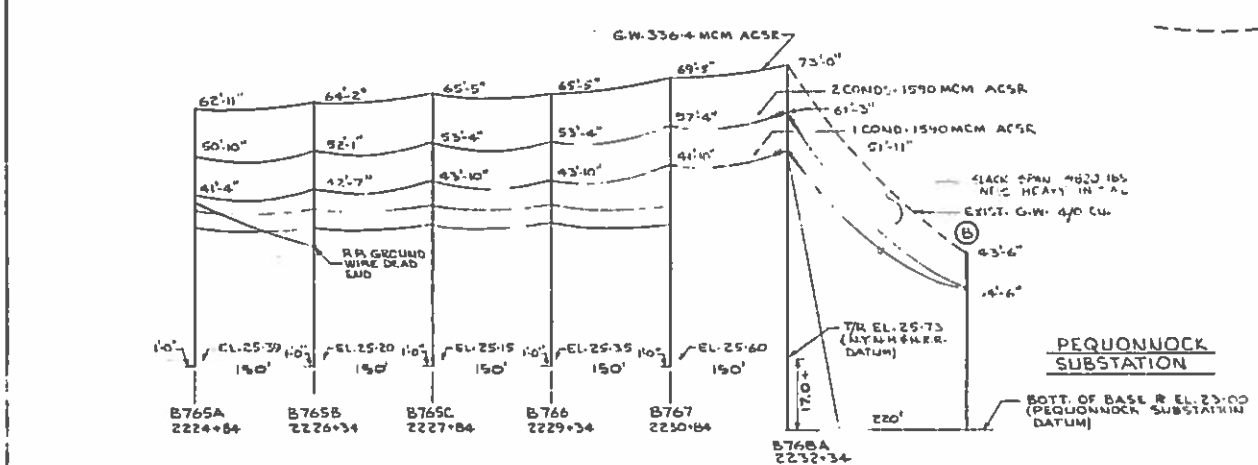

**SOUTH PROFILE**  
SCALE: HORIZ: 1"=100'  
VERT: 1"=20'

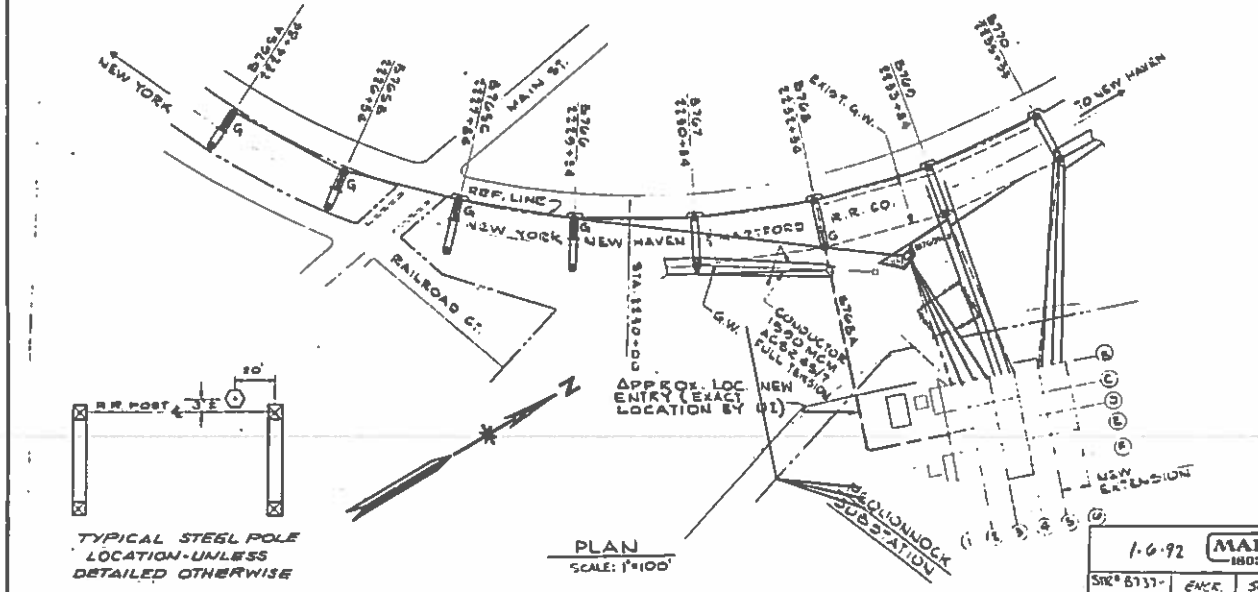

**PLAN**  
SCALE: 1"=100'

- UI LEGEND (SHEETS 17-29):**
- INTERCONNECTED CENTERLINE OF NORTH CIRCUIT TRANSMISSION LINE BARNETS AND SUPPORT STRUCTURE
  - RAILROAD PROPERTY LINE
  - RAILROAD CATERARY SUPPORT BRIDGE STRUCTURE
  - LATTICE TOWER
  - STEEL-POLE STRUCTURE
  - LACED CHANNEL STRUCTURE
  - SHIELD WIRE STRAIN ASSEMBLY GMA - (OTHERWISE SUSPENSION GMA)
  - CONDUCTOR STRAIN ASSEMBLY GMA - (OTHER SUSPENSION GMA)
  - RAILROAD WIRE STRAIN ASSEMBLY - (OTHERWISE PIN INSULATOR)
  - RAILROAD CATERARY SUPPORT BRIDGE STRUCTURE WITH NORTH CIRCUIT BRIDGE CUT
  - RAILROAD WIRE NOT ATTACHED TO BONNET/STEEL POLE
  - ELEVATION OF TOP OF RAILROAD BRIDGE FOUNDATION AT SAME ELEVATION AS TOP OF RAIL
  - ELEVATION OF TOP OF RAILROAD BRIDGE FOUNDATION 6" BELOW ELEVATION OF TOP OF RAIL
  - ELEVATION OF TOP OF RAILROAD BRIDGE FOUNDATION 6" ABOVE ELEVATION OF TOP OF RAIL
  - INDICATES PHASING OF CONDUCTORS FACING INCREASING STRUCTURE NUMBERS
  - POSITION FOR RAILROAD ARMS AND WIRE(S) CONSIDERED IN DESIGN, NOT INSTALLED DURING 1993 CONSTRUCTION.

**UI SECTION GENERAL DATA (SHEETS 17-29)**

**SOUTH CIRCUIT**

SHIELD WIRE: 336.4 MCM ACSR  
CONDUCTOR: 1590 MCM ACSR

WIRE TENSIONS FOR 300 FT. RULING SPAN AT HSC HEAVY INITIAL:

SHIELD WIRE: 2750 LBS  
CONDUCTOR: 8943 LBS  
RAILROAD WIRES: 270 COPPER - 2540 LBS  
470 COPPER - 3467 LBS

CONDUCTOR SHOWN FOR FINAL SAG AT 284°F  
SHIELD WIRE SHOWN FOR FINAL SAG AT 60°F  
RAILROAD WIRE SHOWN FOR FINAL SAG AT 60°F

**NORTH CIRCUIT**

SHIELD WIRE: 12 NO. 8 ALUMINUM 12 OPTICAL FIBER CORD (NON-DISPERSED BLENDED)  
CONDUCTOR: 1590 MCM 45/7 SSAC

WIRE TENSIONS FOR 300 FT. RULING SPAN AT HSC HEAVY INITIAL:

SHIELD WIRE: 3800 LBS  
CONDUCTOR: 8440 LBS  
RAILROAD WIRES: 270 COPPER - 2540 LBS  
470 COPPER - 3467 LBS


CONDUCTOR SHOWN FOR FINAL SAG AT 60°F; 284°F SHOWN BY (+)  
SHIELD WIRE SHOWN FOR FINAL SAG AT 60°F  
RAILROAD WIRE SHOWN FOR FINAL SAG AT 60°F

- UI SECTION NORTH PROFILE GENERAL NOTES**  
(APPLY TO UI SECTION SHEETS 17-29; SEE SHEET 1 FOR NOTES APPLYING TO CLAP SECTION SHEETS 1-16)
- ALL ELEVATIONS REFER TO NEW YORK, NEW HAVEN AND HARTFORD RAILROAD ELECTRIFICATION DATUM.
  - USCSAS DATUM EQUAL RAILROAD DATUM PLUS 1.76 FEET.
  - ALL STATIONING REFERS TO RAILROAD HORIZONTAL CENTERLINE; SPAN LENGTHS ON PROFILES ARE SURVEY ESTABLISHED POST-TO-POST DIMENSIONS OR CALCULATED POST-TO-BARNET AND STEEL POLE TO STEEL POLE DIMENSIONS AND MAY NOT CORRESPOND TO RAILROAD STATIONING.
  - LINE ANGLES ARE RIGHT OR LEFT FACING EAST TO NEW HAVEN AND REFER TO THE ALIGNMENT OF THE NORTH CIRCUIT BARNETS AND STRUCTURES AS ESTABLISHED BY SURVEY OR CALCULATION.
  - STRUCTURE NOMENCLATURE:  
BESS RAILROAD CATERARY SUPPORT BRIDGE STRUCTURE  
EPXEX (( ON W) (N OR S) LATTICE TOWER, ON LACED CHANNEL; EAST OR WEST OF BRIDGE STRUCTURE BASE ON NORTH OR SOUTH OF RAILROAD.  
RZ (( ON W) R).
  - DIMENSIONS SHOWN AT OVERHEAD SHIELD WIRE, TRANSMISSION LINE CONDUCTORS AND RAILROAD FEEDER WIRE ARE HEIGHTS ABOVE TOP OF RAIL.
  - B/L/C/M/LTH DESIGNATES DISTANCE FROM TOP OF RAIL TO TOP OF RAILROAD CATERARY SUPPORT BRIDGE/LACED CHANNEL/LATTICE TOWER.
  - ELEVATION OF TOP OF RAIL AND FOUNDATION FOR EXISTING RAILROAD STRUCTURES IS TAKEN FROM NEW YORK, NEW HAVEN AND HARTFORD RAILROAD DRAWINGS 721 TO 729.
  - HEIGHTS OF RAILROAD WIRES ATTACHED TO NEW BONNETS ARE 5'-0" AND 6'-3" ABOVE TOP OF BRIDGE FOR RAILROAD CATERARY SUPPORT STRUCTURES.
  - HEIGHTS OF RAILROAD WIRES NOT ATTACHED TO NEW BONNETS ARE BASED ON FIELD SURVEY DATA AND TOP OF FOUNDATION AS DETERMINED IN NOTE 11.
  - LINE CONSTRUCTION PER USCSA SPECIFICATION NO. 191-10.
  - PROJECT DRAWINGS - UI PORTION:

**UI NUMBER NUMBER**

01191-10000 1-2	REF MAP
01191-10001 17-29	PLAN & PROFILE
01191-13000	DEVELOPMENT & MANAGEMENT PLAN
01191-40002	FOUNDATION DRAWINGS-UI
01191-50002	STEEL POLE DIMS-UI
01191-70000 2	BENNET...SCHED 1P514EH
01191-44000 3	BENNET ASSEMB A3-E4
01191-44001 3	BENNET BASE
01191-44002 3	BENNET COLUMNS
01191-44003 3	CROSSARMS
01191-44004	CLY STRAND ICE 1
01191-44010	LACED CHANNEL TP645E-TP707H
01191-44020	MOUF ENDS RETAINING WALL
01191-17035-21-3	TOWER EXT 754H-756H

- SURVEY ANGLES NOTED AT THE TRANSMISSION STRUCTURES WERE MEASURED FROM THE CENTER OF THE STRUCTURES STAKED FOR CONSTRUCTION. CONDUCTOR ANGLES MAY BE GREATER OR LESS DEPENDING UPON HOW THEIR POSITIONS CHANGE FROM STRUCTURE TO STRUCTURE.

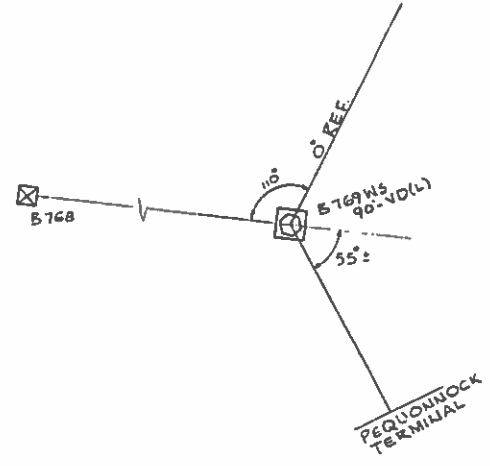

CONTAINS CRITICAL ENERGY INFRASTRUCTURE INFORMATION SUBJECT TO NON-DISCLOSURE PROVISIONS OF 160 N.E. SCHEDULE 22 AND NEW ENGLAND POLICES PERTAINING TO CONFIDENTIAL INFORMATION (CEI) DO NOT DISTRIBUTE DATE OF REVIEW: 11/18/2011 BY: JLR

FORMERLY 01191-10001 - SH. 30 OF 30

1-6-92	MAIN	1803
SHE# 8737-8768	ENGR.	SWDY.
WHI	DEC	
NO	Date	Revision

5/7/75/97	MINOR REVISIONS PER BILL FAORO	ST	BE	BT
4/27/96	RENUMBER DRAWING	LST		
3/31/78	AS BUILT	TVG	NTS	DEH
2/11/73	REVISED PHASING AT STR# 769 WS	TVG		KAW
1/26/92	ISSUED FOR CONSTRUCTION	TVG		DR
0/15/09	ISSUED FOR BID	WPK	TVG	DR
		By	Chkd	Engr./Supv

**UI United Illuminating**  
an investor-owned electric light and power company


Drawn By: W.M.B.K.  
Checked By: TVG

Design Engr. App: JZH  
Design Supv. App:


WESTPORT TO PEQUONNOCK 115KV LINE	
PLAN AND PROFILE STRUCTURE B765A TO B768	
Date: 10/1/02	Drawing Number: 24213-101
Scale: AS SHOWN	




COND R5 317

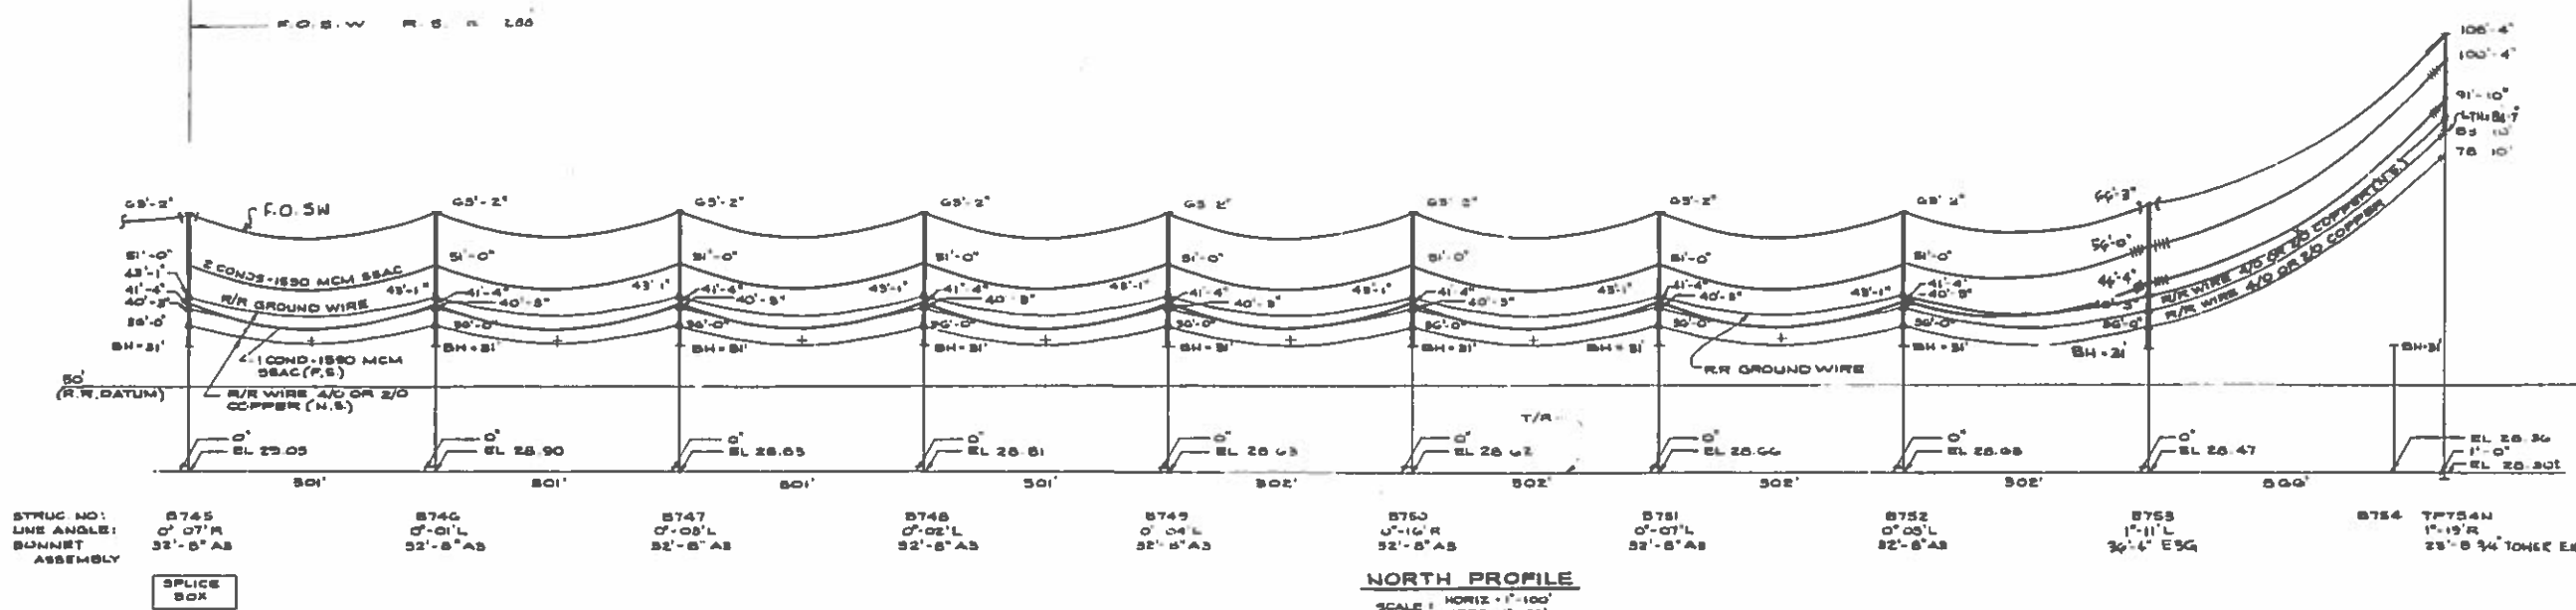

NORTH PROFILE  
HORIZ. 1"=100'  
SCALE: VERT. 1"=20'

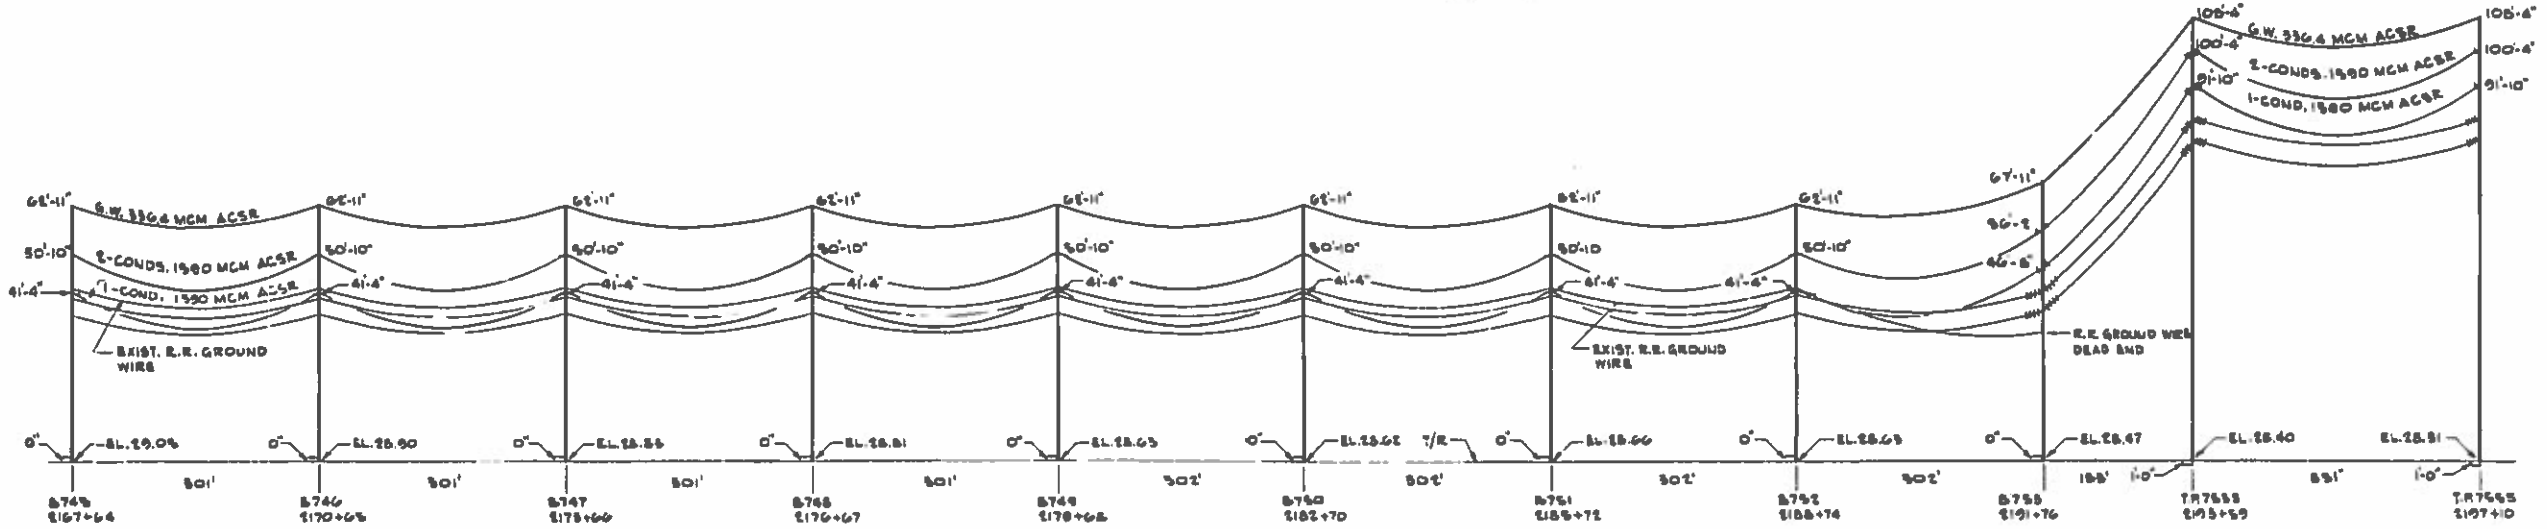

SOUTH PROFILE  
HORIZ. 1"=100'  
SCALE: VERT. 1"=20'

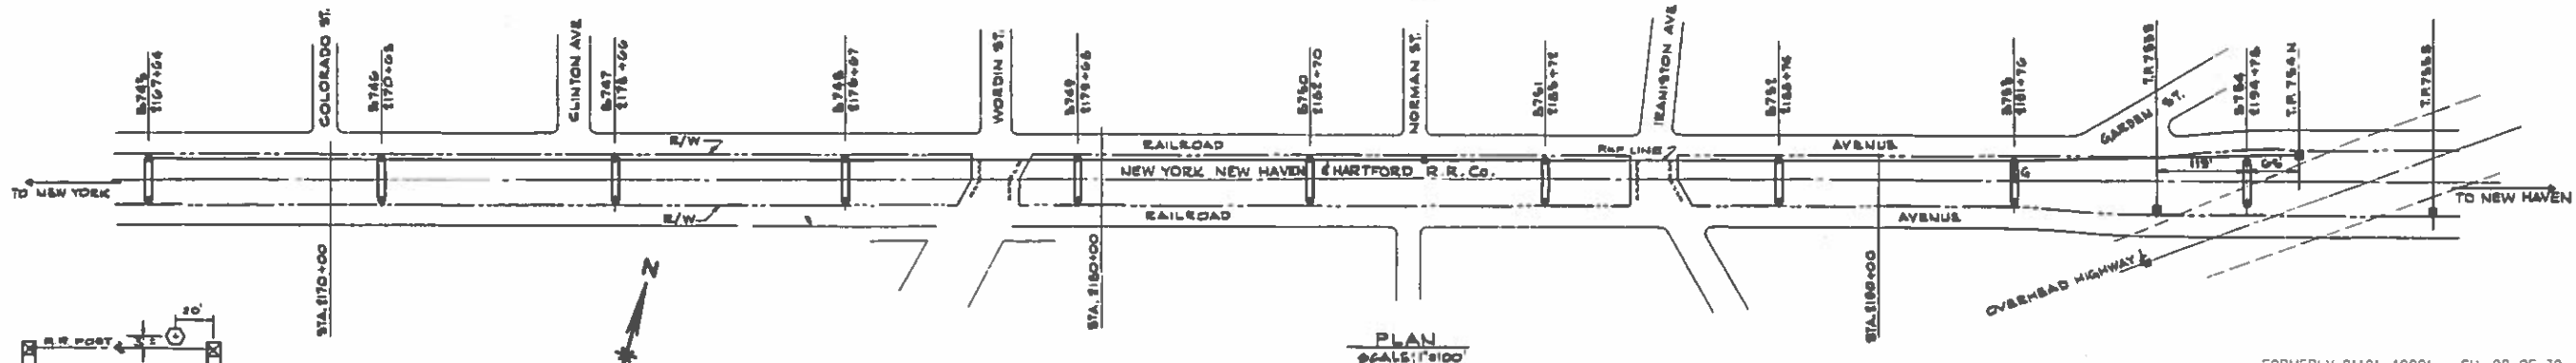

PLAN  
SCALE: 1"=100'




CONTAINS CRITICAL ENERGY INFRASTRUCTURE INFORMATION  
SUBJECT TO NON-DISCLOSURE PROVISIONS OF 150-ME SCHEDULE 72 AND NEW ENGLAND POLICES PERTAINING TO CONFIDENTIAL INFORMATION (CEI)  
DO NOT DISTRIBUTE  
DATE OF REVIEW: 11/18/2011 BY: JLR

1-4-92	MAIN	1-2/1/93	RENUMBER DRAWING	1-2/1/94	AS BUILT	1-2/1/92	ISSUED FOR CONSTRUCTION	1-10/30/91	ISSUED FOR BID
STR# B137	ENGR	SUPV.							
B746	NMJ	PER							

**UI United Illuminating**  
an investor-owned electric light and power company  
Drawn By: LMK Design Engr. App: JEL  
Checked By: TVG Design Supv. App:

WESTPORT TO PEQUONNOCK 115KV LINE  
**PLAN AND PROFILE**  
STRUCTURE B745 TO B754  
Date: 10/1/01 Drawing Number: 24213-103  
Scale: AS NOTED

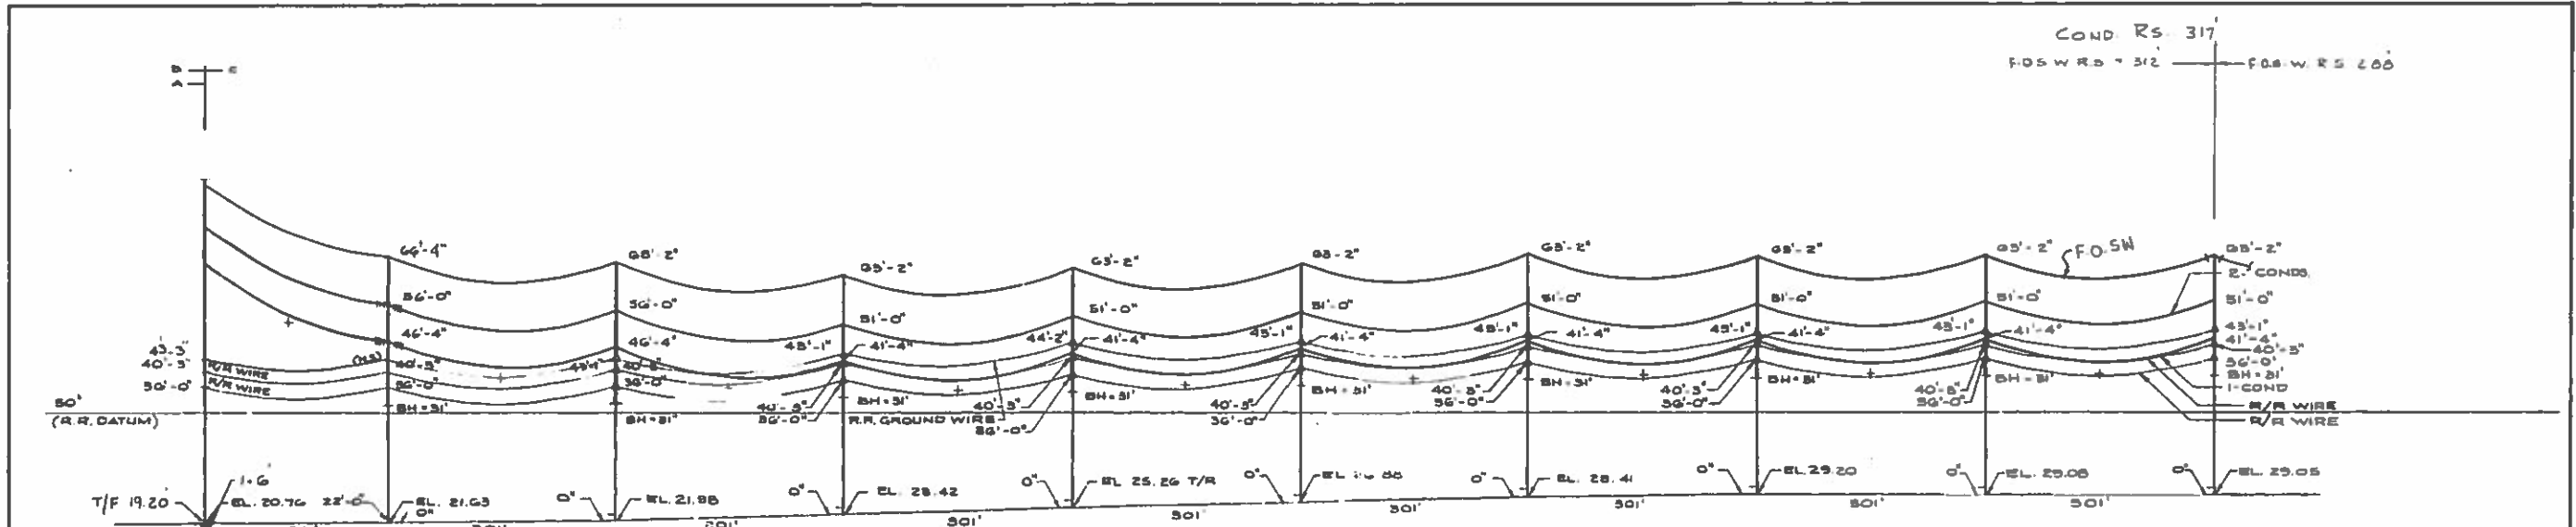


STRUC. NO. 1  
LINE ANGLE:  
BOHNET  
ASSEMBLY:


T/F 19.20  
T/F 19.20  
EL. 20.76  
EL. 21.63  
EL. 21.98  
EL. 22.42  
EL. 25.26 T/R  
EL. 26.41  
EL. 28.41  
EL. 29.20  
EL. 29.08  
EL. 29.05

**NORTH PROFILE**  
HORIZ. 1"=100'  
SCALE: VERT. 1"=20'

R.O.S.W.  
SPLICE BOX

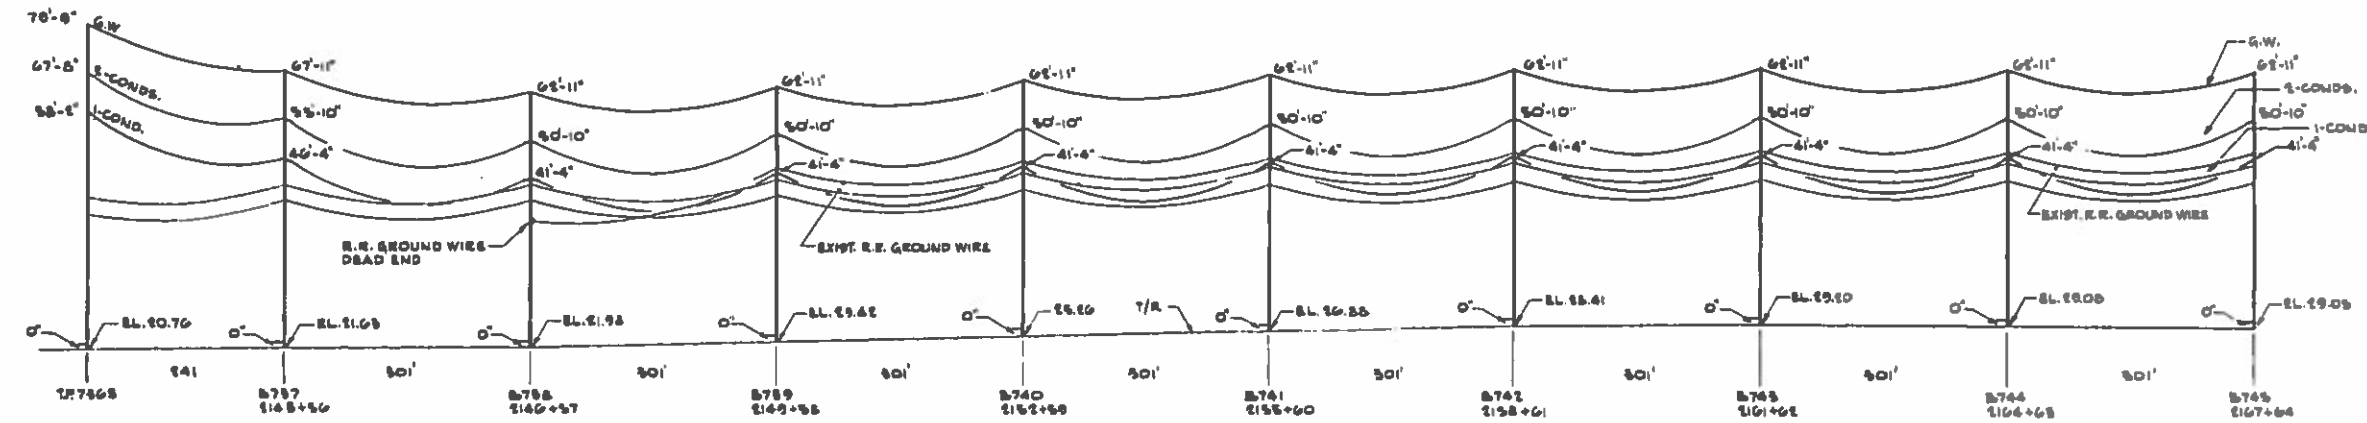


**SOUTH PROFILE**  
HORIZ. 1"=100'  
SCALE: VERT. 1"=20'

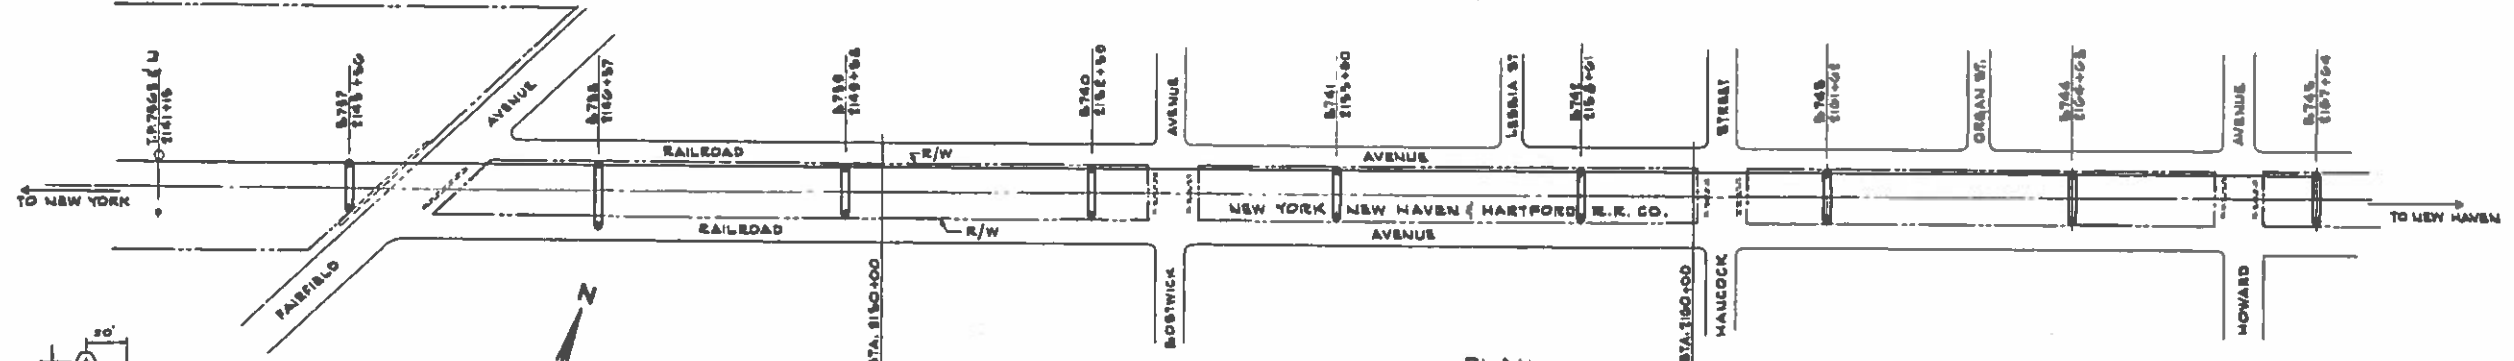

**PLAN**  
SCALE: 1"=100'

FORMERLY 01191-10001 - SH. 27 OF 30

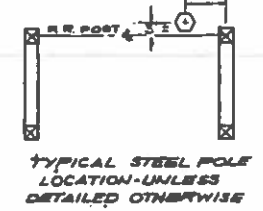

CONTAINS CRITICAL ENERGY  
INFRASTRUCTURE INFORMATION  
SUBJECT TO NON-DISCLOSURE PROVISIONS OF ISO-NE  
SCHEMATIC 72 AND NEW ENGLAND POLICES PERTAINING TO  
CONFIDENTIAL INFORMATION (CBI)  
DO NOT DISTRIBUTE  
DATE OF REVIEW: 11/18/2011 BY: J.R.





16-92  
MAIN  
16-92  
EUGR. SUPV.  
WHU P.C.R.

1	2/1/98	REMEMBER DRAWING	LEV
2	3/1/98	AS BUILT	T.V.G. M.K. W.H.
3	2/6/92	ISSUED FOR CONSTRUCTION	T.V.G. M.K. W.H.
4	10/20/01	ISSUED FOR B.I.D.	M.K. T.V.G. W.H.
No	Date	Revision	By Chkd/Engr. Supv.

**UI United Illuminating**  
an investor-owned electric light and power company  
Drawn By: M.K. Design Engr. App. Y.H.  
Checked By: T.V.G. Design Engr. App. W.H.

**WESTPORT TO PEBUONNOCK  
115KV LINE**  
**PLAN AND PROFILE  
STRUCTURE B737 TO B747**  
Date: 10/1/98 Drawing Number: 24213-104  
Scale: AS NOTED

56719

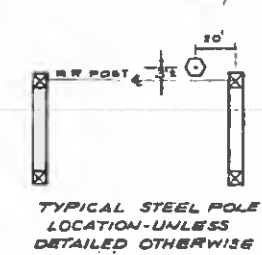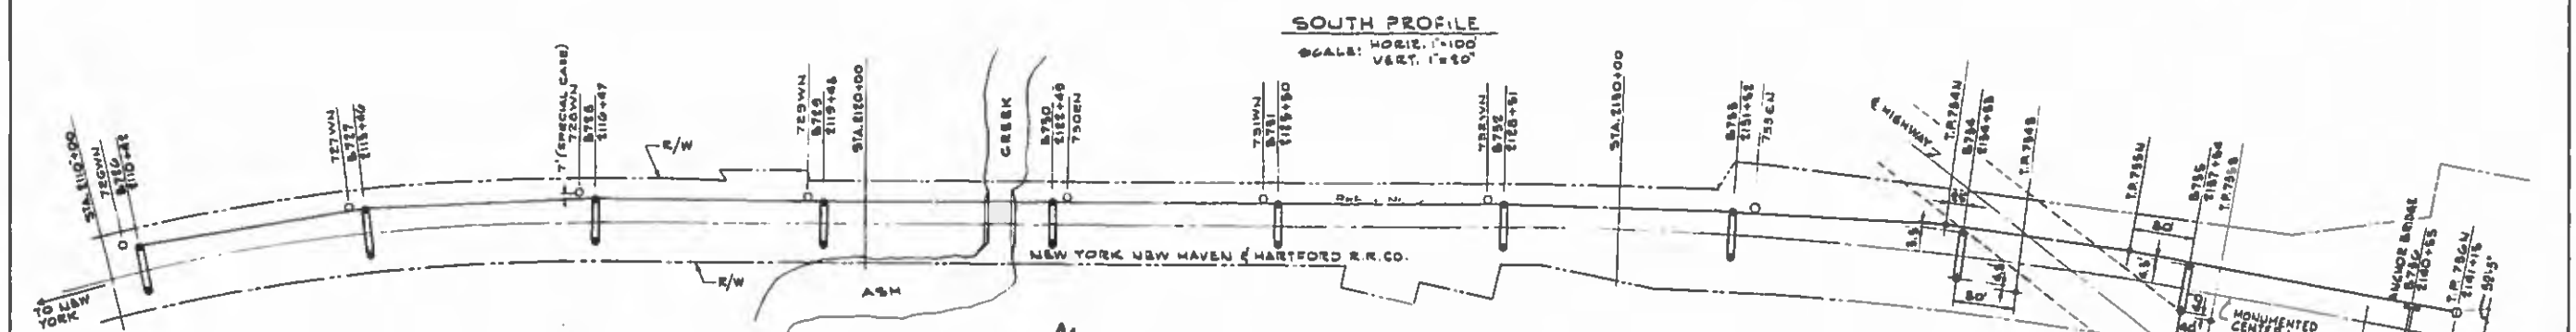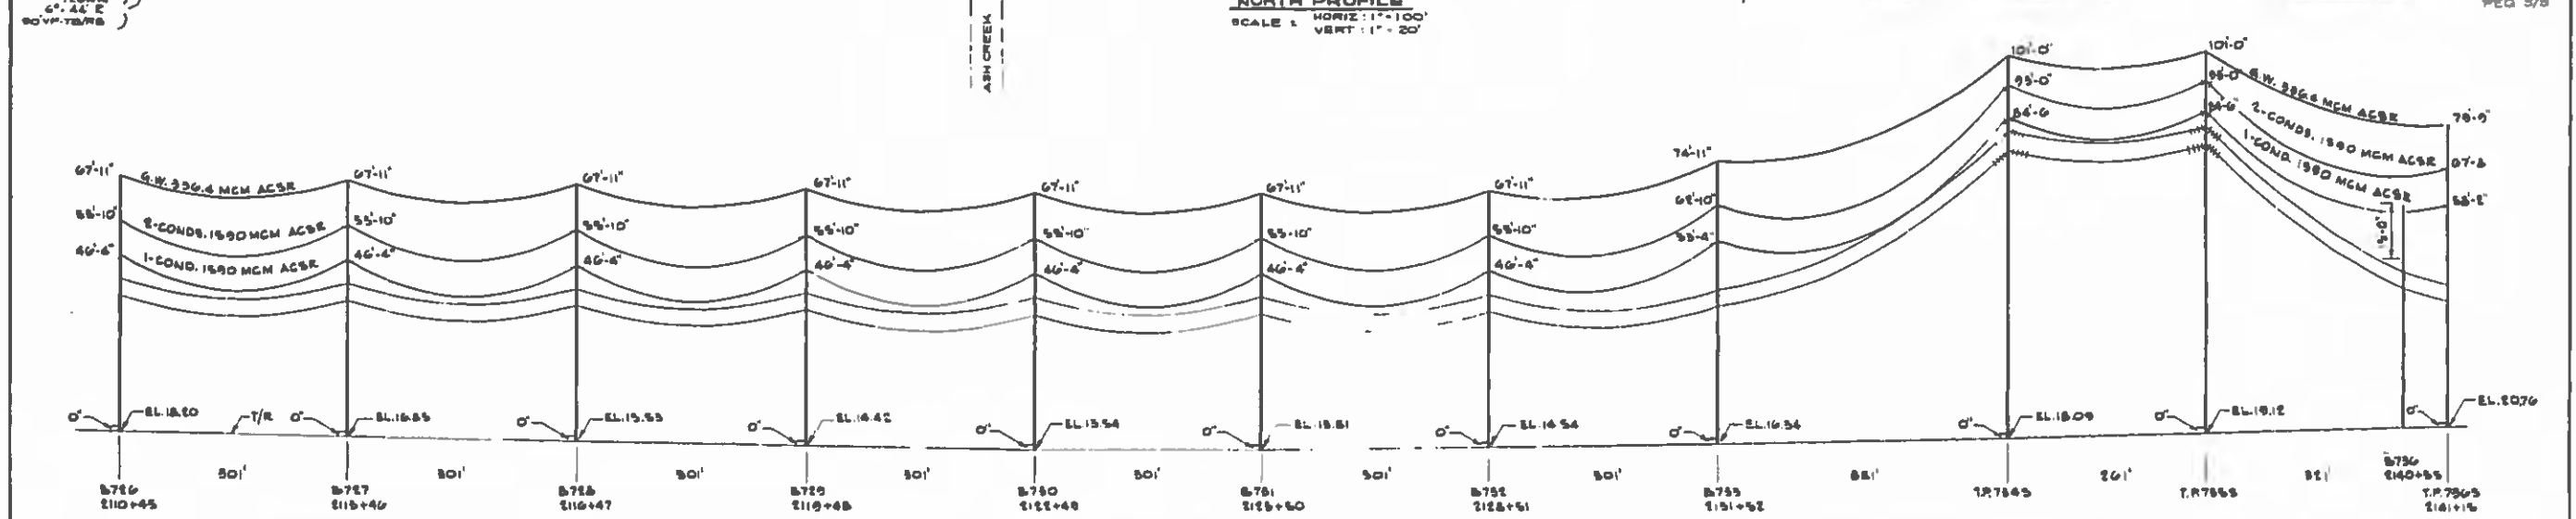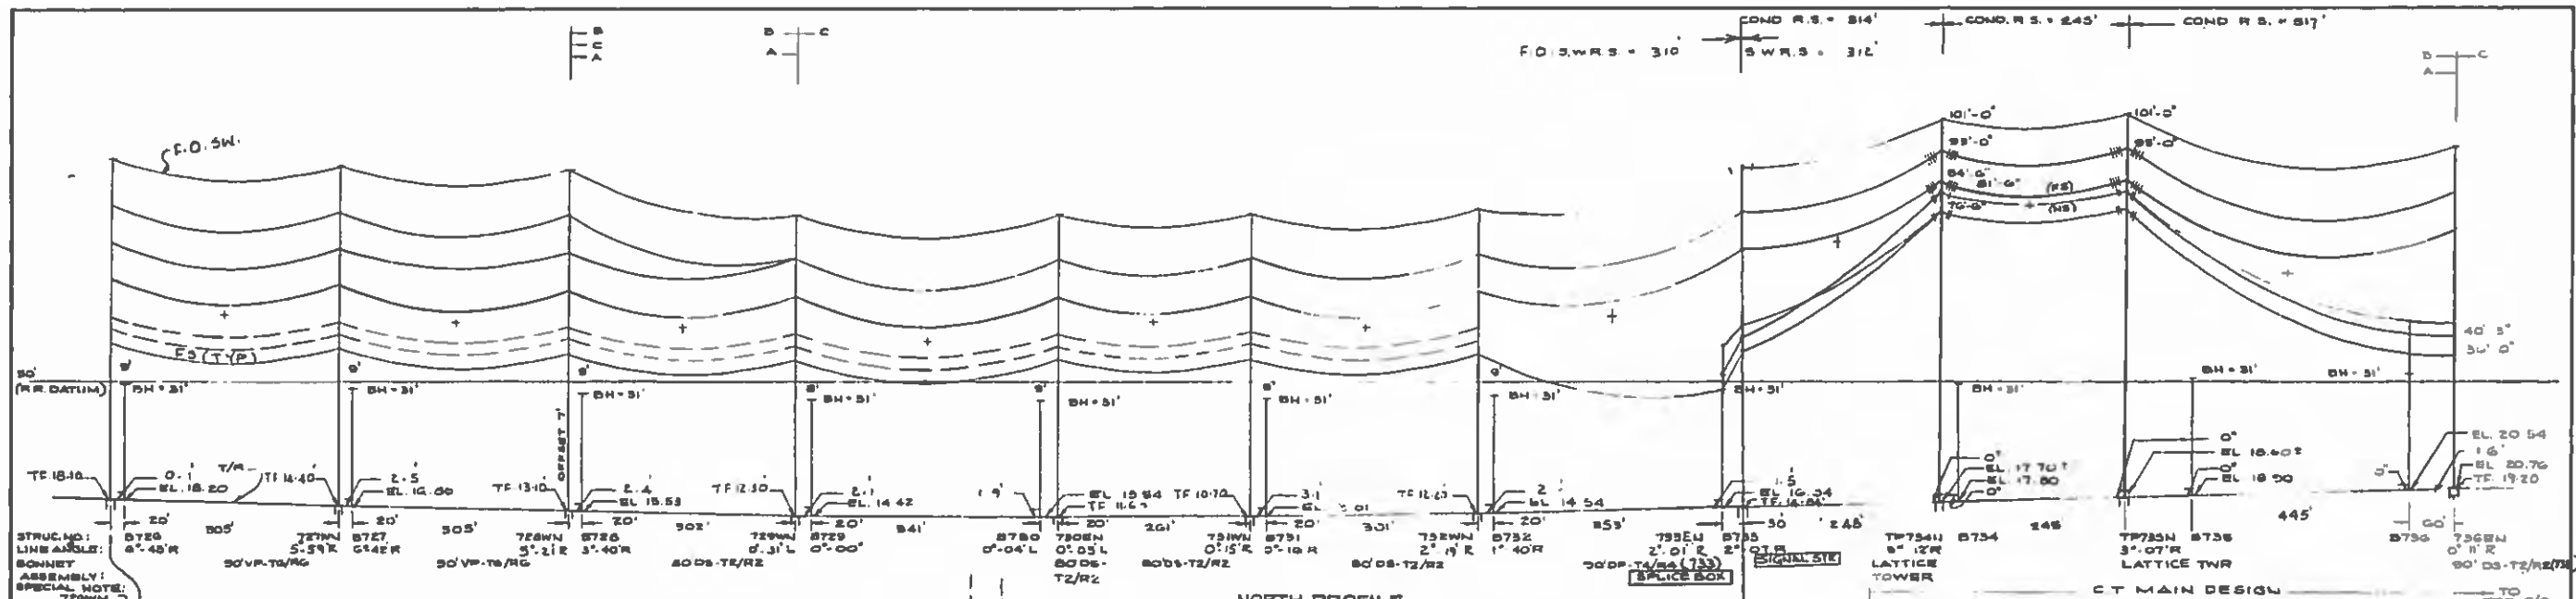

CONTAINS CRITICAL ENERGY INFRASTRUCTURE INFORMATION SUBJECT TO NON-DISCLOSURE PROVISIONS OF ISO-NE SCHEDULE 72 AND NEW ENGLAND POLICES PERTAINING TO CONFIDENTIAL INFORMATION (CEI) DO NOT DISTRIBUTE DATE OF REVIEW: 11/18/2011 BY: JR

FORMERLY 01191-10001 - SH 26 OF 30

1-6-92	MAIN	3 7/27/94	RENAME DRAWING	L.S.T.
		2 3/17/94	AS BUILT	T.V.G./M.S./D.H.
		1 2/6/93	ISSUED FOR CONSTRUCTION	T.V.G./M.S./D.H.
		0 10/30/91	ISSUED FOR BID	M.R.K./T.V.G./D.H.
			Revision	By: Chkd/Engr./Supv.




**UI United Illuminating**  
an investor-owned electric light and power company

Drawn By: L.W.R.K. Design Engr. App. D.H.H.  
Checked By: T.V.G. Design Supv. App.

**WESTPORT TO PEQUONNOCK 115KV LINE**

**PLAN AND PROFILE STRUCTURE 8720 TO 8780**

Date: 10/15/01 Drawing Number: 24213-105  
Scale: AS SHOWN

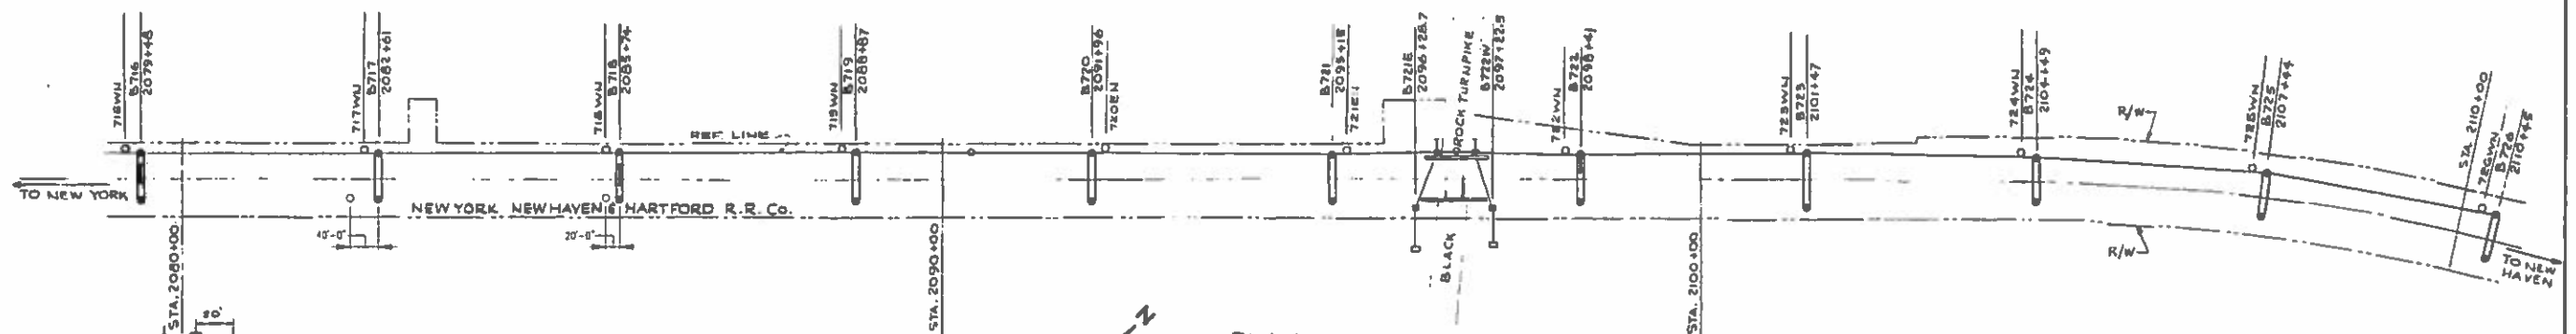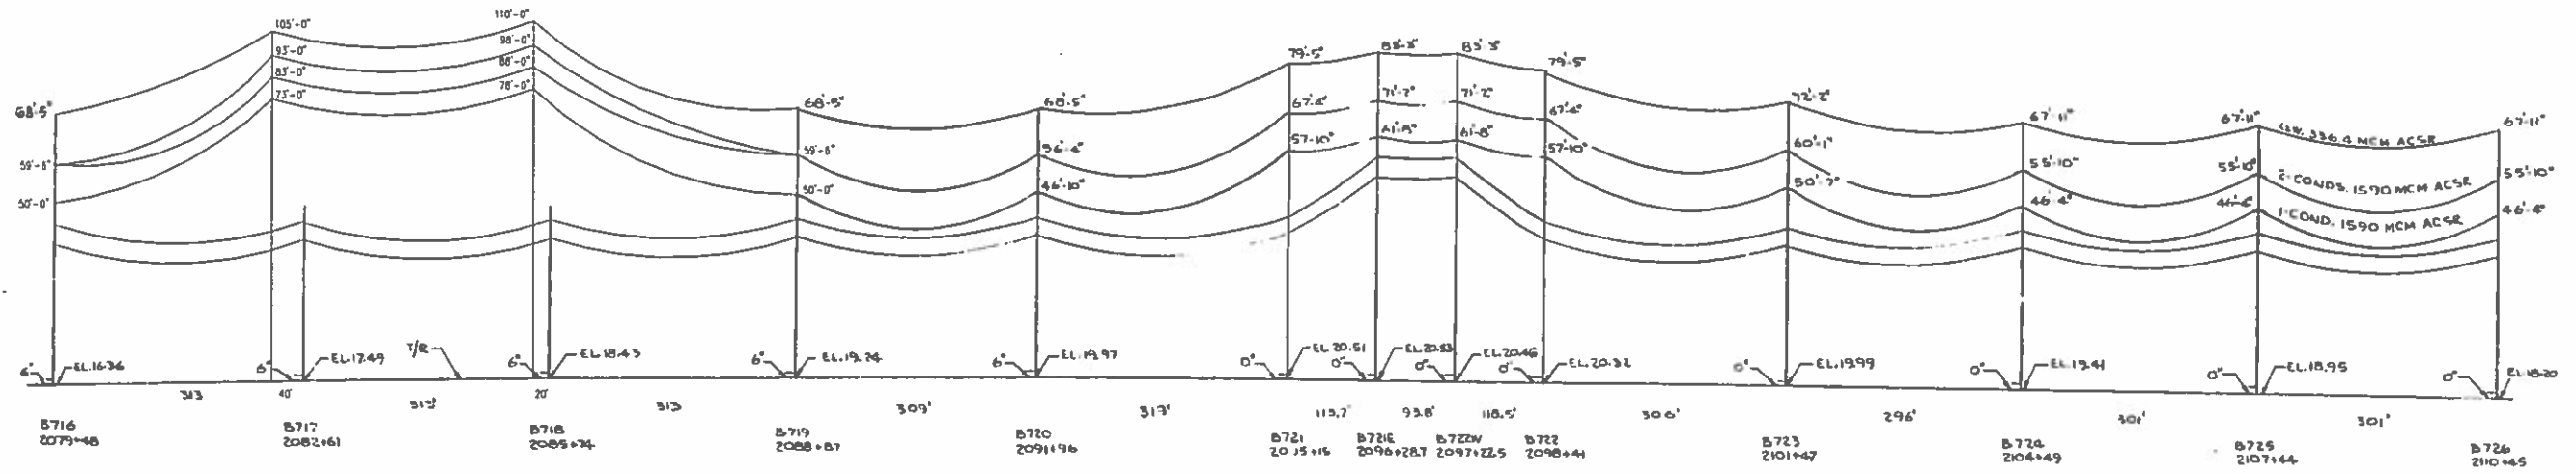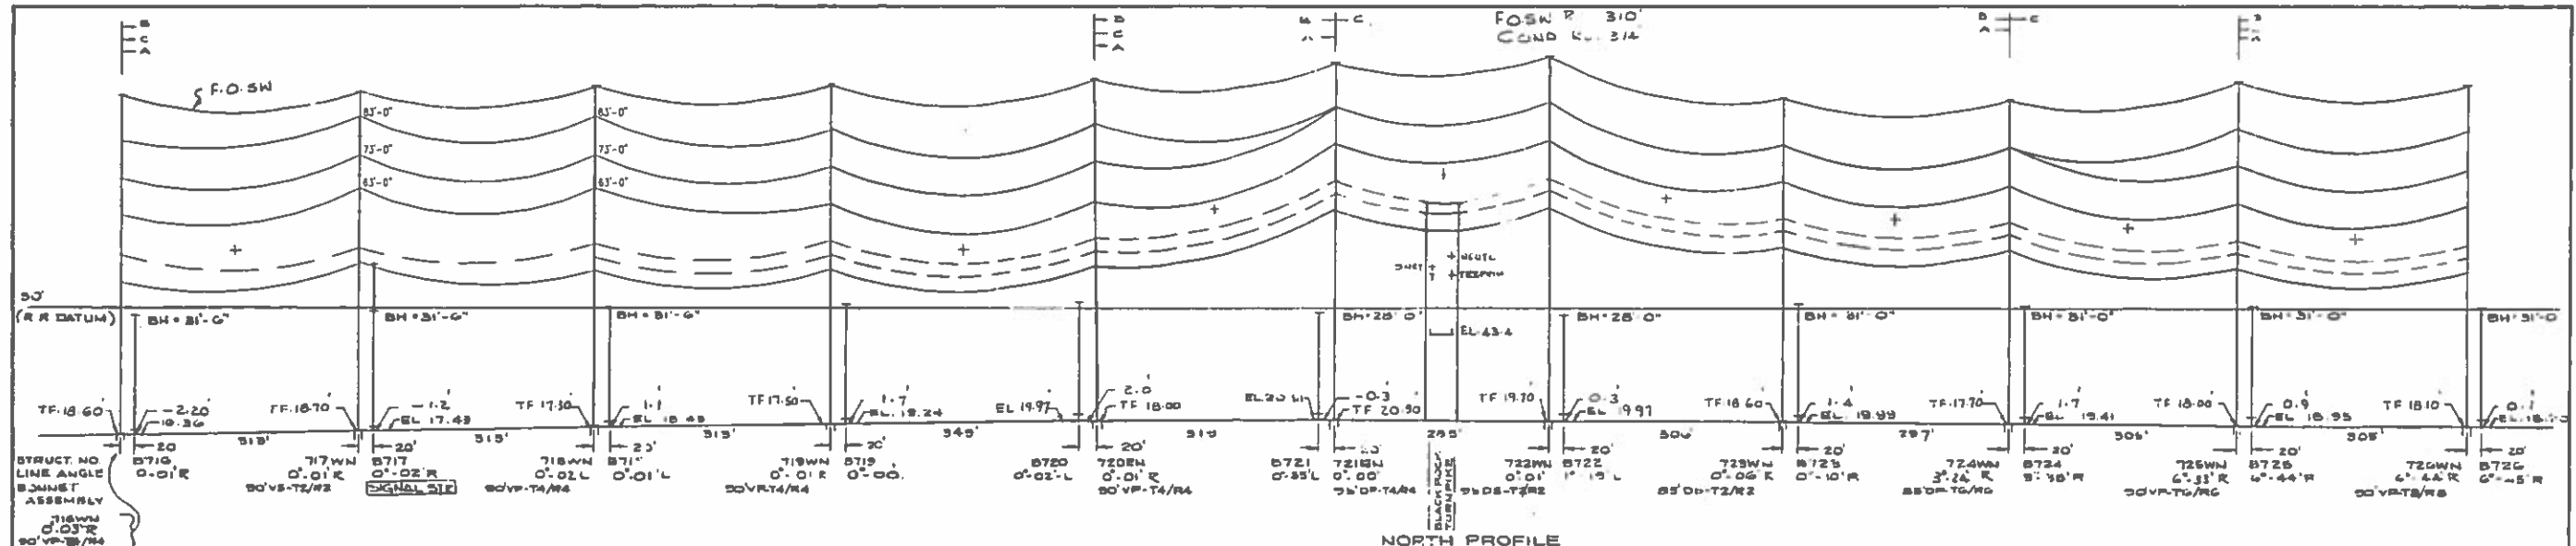

TYPICAL STEEL POLE LOCATION - UNLESS DETAILED OTHERWISE

CONTAINS CRITICAL ENERGY INFRASTRUCTURE INFORMATION SUBJECT TO NON-DISCLOSURE PROVISIONS OF ISO-NE SCHEDULE 22 AND NEW ENGLAND POLICES PERTAINING TO CONFIDENTIAL INFORMATION (CMI) DO NOT DISTRIBUTE DATE OF REVISION: 11/18/2011 BY: AR

No.	Date	Revision	By	Chkd/Engr/Supv
7	9/24/07	AS BUILT REVISION	CS	SMR
8	11/21/08	CONFORMED TO CONSTRUCTION RECORDS	ASF	ICC
9	10/09/08	CONSTRUCTION ISSUE	ASF	ICC
1	7/25/05	FARFIELD RAILROAD STATION ADDITION	CC	BS
3	7/7/96	RENUMBER DRAWING	LS	T
2	3/17/94	AS BUILT	TVG	AKH
1	2/16/92	ISSUED FOR CONSTRUCTION	TVG	AKH
0	10/30/88	ISSUED FOR CONSTRUCTION	LMR	TVG

**UI United Illuminating**  
 an investor-owned electric light and power company


Drawn By: LMRK Design Engr. App: JPH  
 Checked By: TVG Design Supv. App: JPH

FORMERLY 01191-10001 - SH 25 OF 30

**WESTPORT TO PEQUONNOCK 115KV LINE**

**PLAN AND PROFILE STRUCTURE B716 TO B726**

Date: 10/15/08 Drawing Number: 24213-106  
 Scale: AS SHOWN

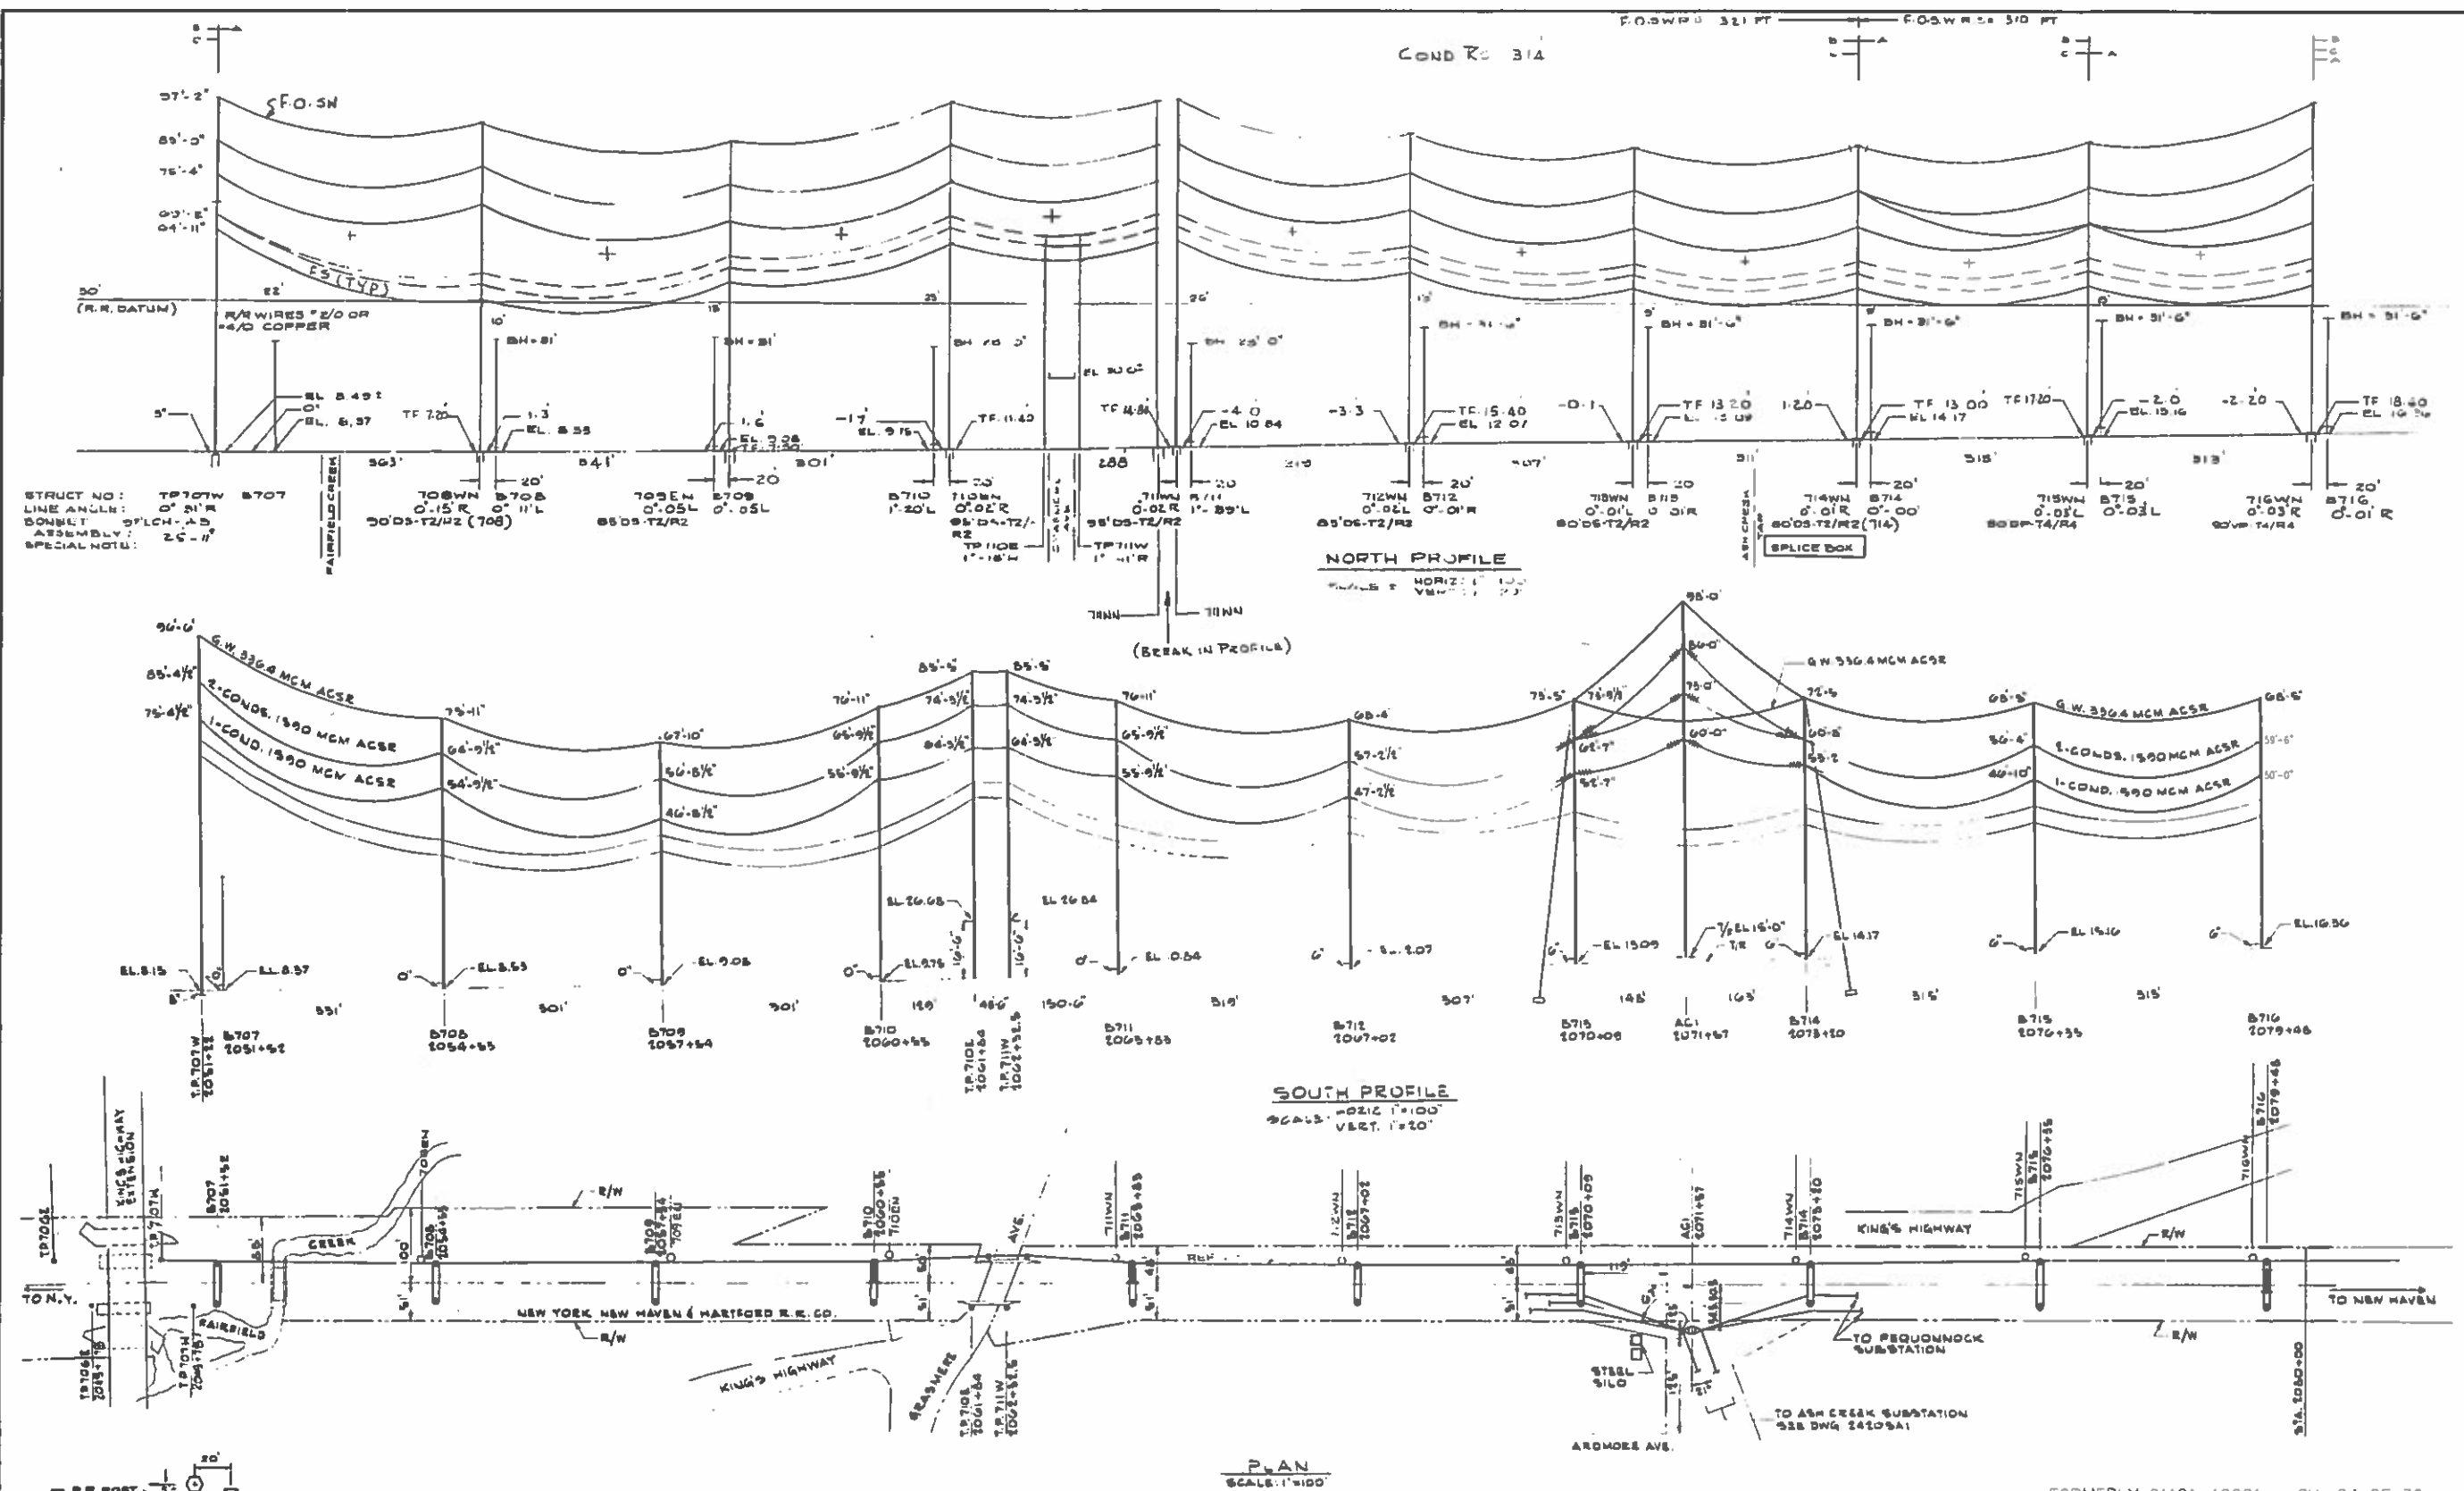


STRUCT NO: TP707W B707  
 LINE ANGLE: 0° 31' R  
 SLOPE: 0' 11" R  
 ASSEMBLY: 25'-H  
 SPECIAL NOTE: 25'-H

**NORTH PROFILE**  
 HORIZ: 1"=100'  
 VERT: 1"=20'

**SOUTH PROFILE**  
 HORIZ: 1"=100'  
 VERT: 1"=20'

**PLAN**  
 SCALE: 1"=100'

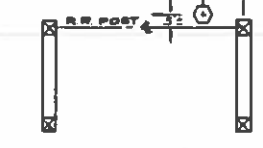

TYPICAL STEEL POLE LOCATION UNLESS DETAILED OTHERWISE

CONTAINS CRITICAL ENERGY INFRASTRUCTURE INFORMATION SUBJECT TO NON-DISCLOSURE PROVISIONS OF ISO-NE SCHEDULE 72 AND NEW ENGLAND POLICES PERTAINING TO CONFIDENTIAL INFORMATION (CII) DO NOT DISTRIBUTE DATE OF REVIEW: 11/18/2011 BY: AR

No	Date	Description	By	Chkd	Engr	Supv
5	11/27/06	CONFORMED TO CONSTRUCTION RECORDS	JF	TCC	TCC	DK
4	10/02/06	CONSTRUCTION ISSUE	JF	TCC	TCC	DK
3	7/1/96	RENUMBER DRAWING	LST			
2	3/17/94	A: S.L.T.	TVG	WJS	DKH	
1	2/6/92	ISSUED FOR CONSTRUCTION	L.M.K.	T.V.G.	DKH	
0	10/01/81	ISSUED FOR BID	L.M.K.	T.V.G.	DKH	

**UI United Illuminating**  
 an investor-owned electric light and power company

Drawn By: L.M.K. Design Engr. App. 12/14  
 Checked By: T.V.G. Design Supv. App. 12/14

WESTPORT TO PEQUONNOCK  
 115 KV LINE




PLAN AND PROFILE  
 STRUCTURE B707 TO B716

Date: 10/1/06 Drawing Number: 24213-107  
 Scale: AS NOTED

FORMERLY 01191-10001 - SH. 24 OF 30

SEON 56716



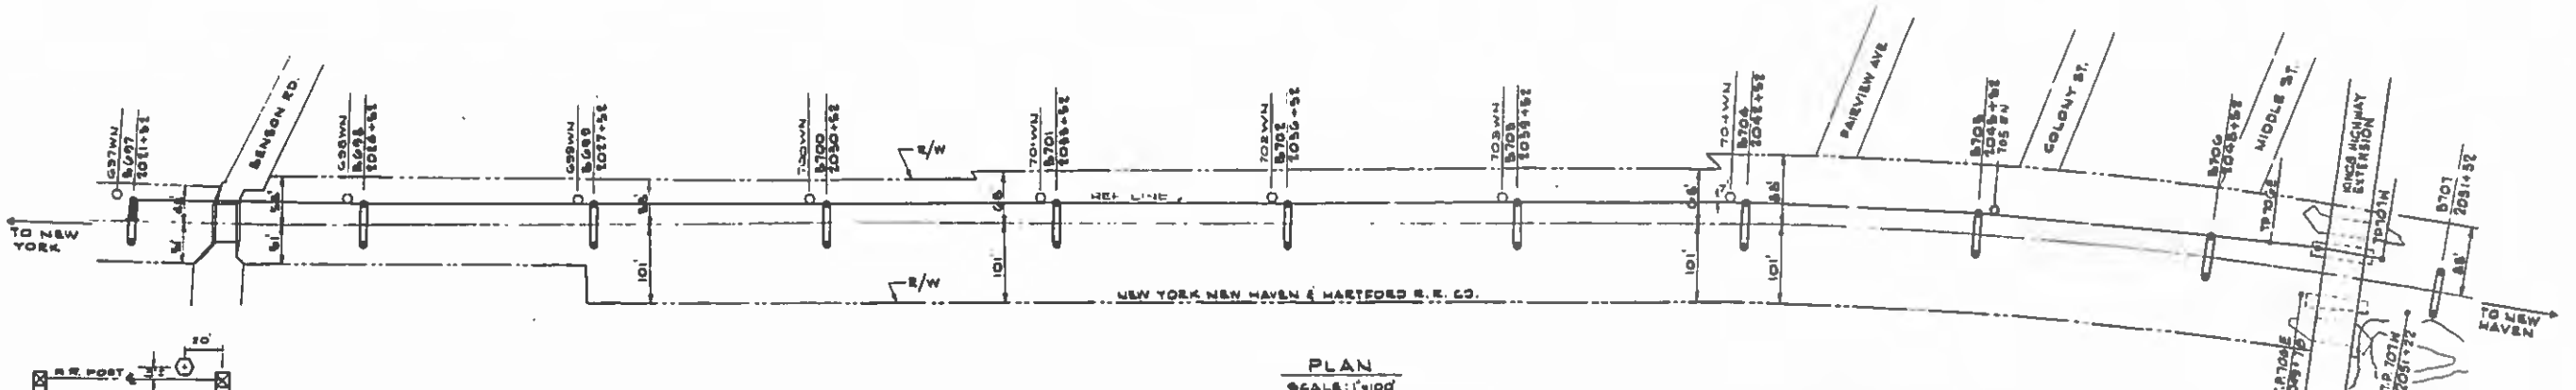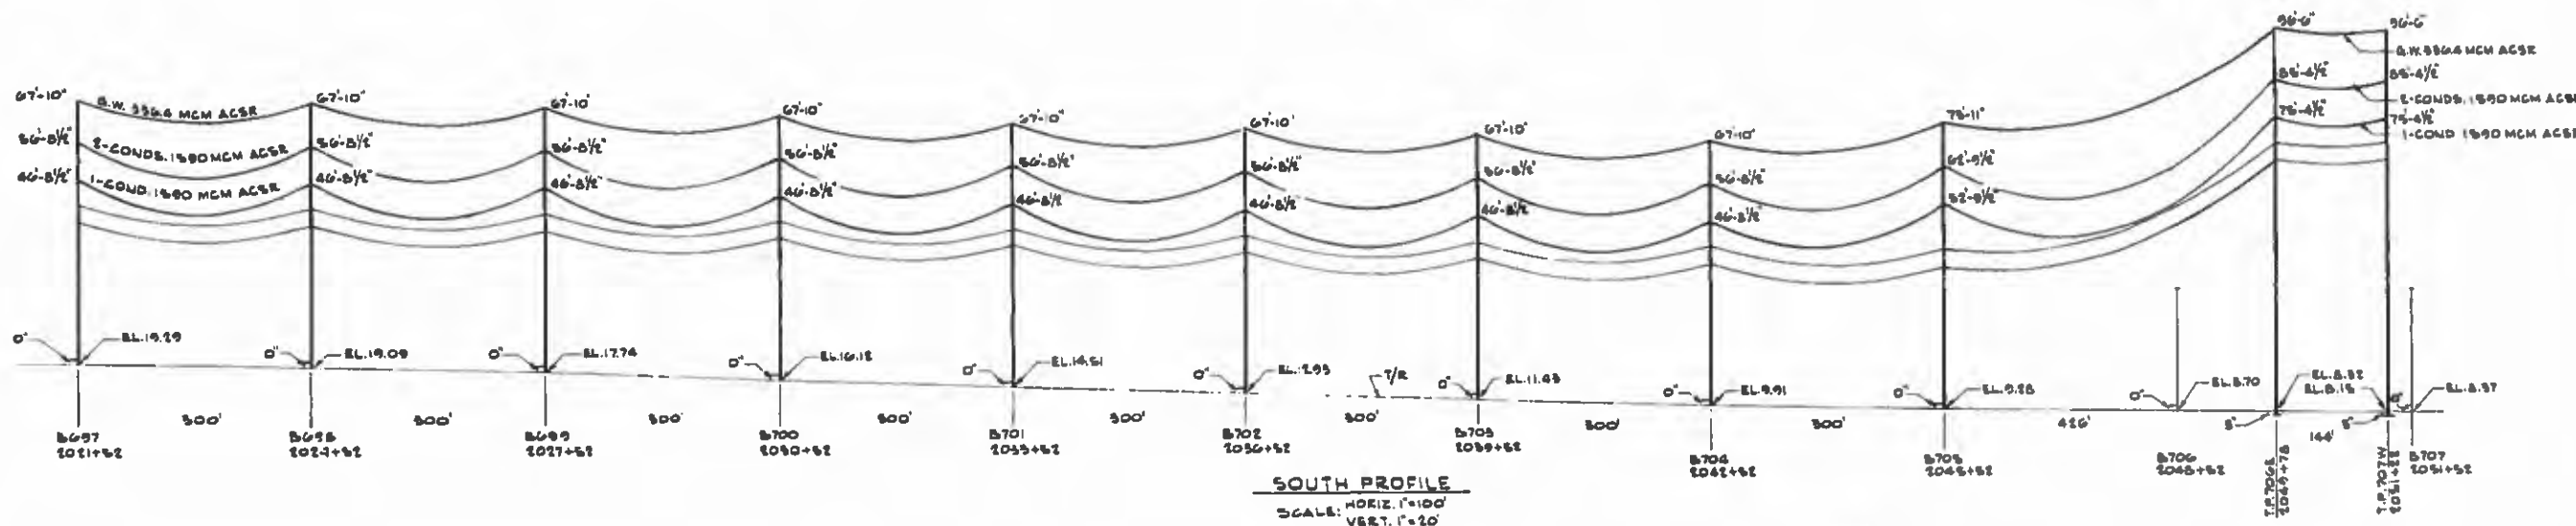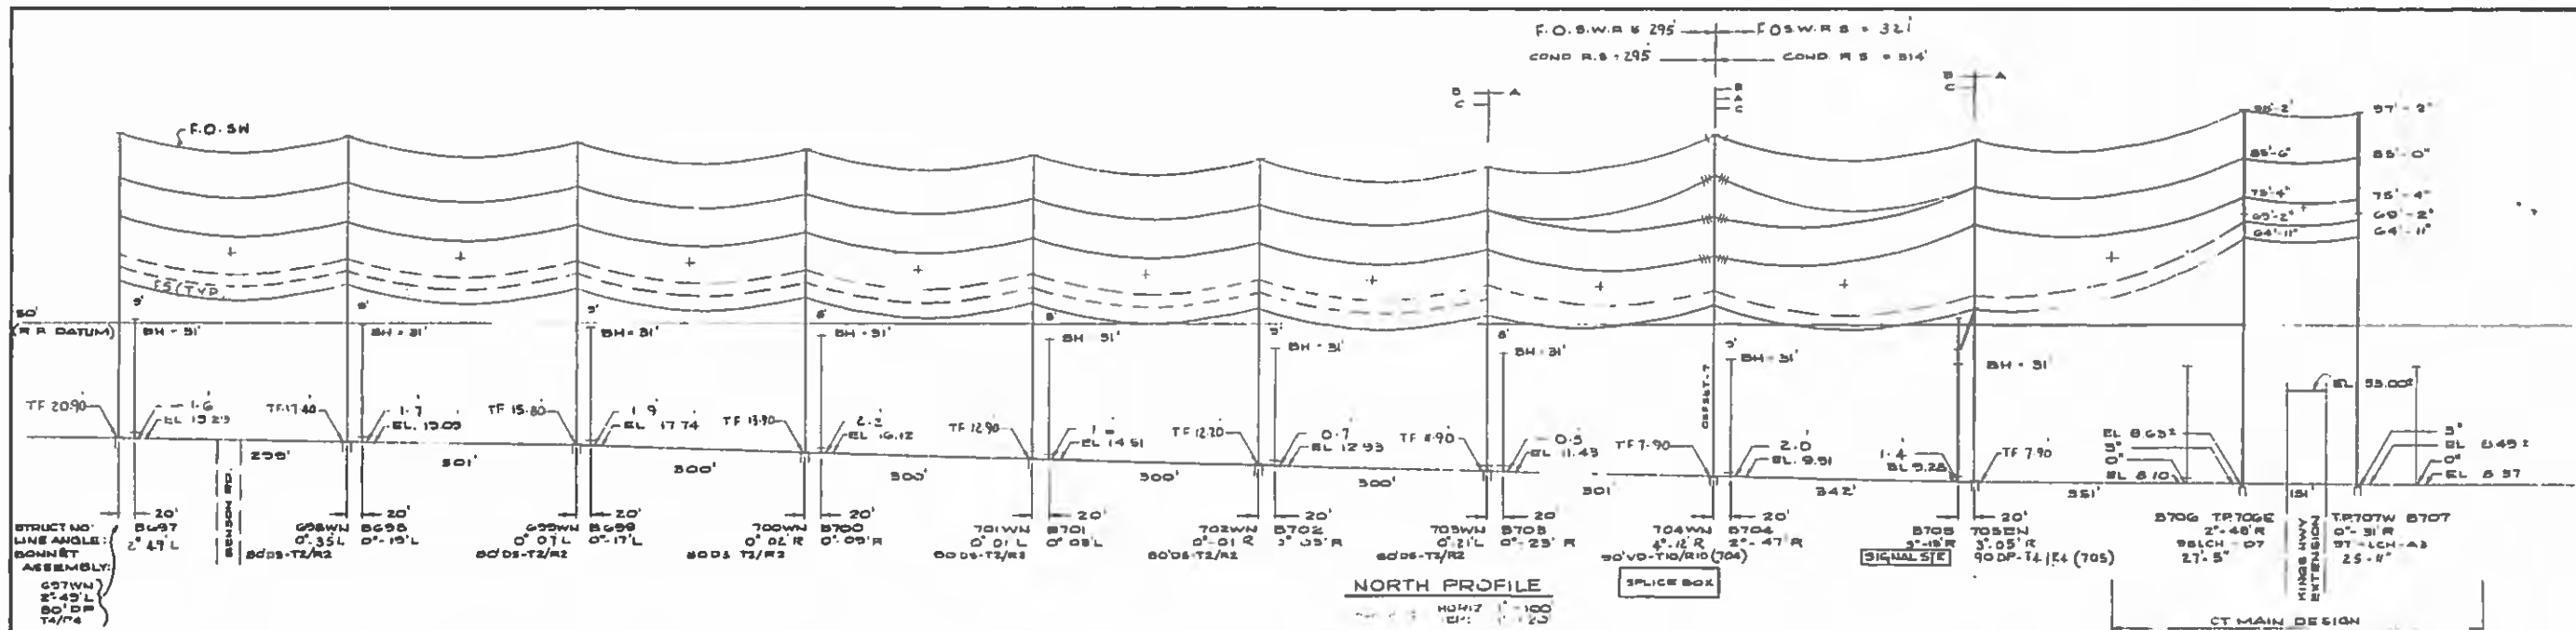

TYPICAL STEEL POLE LOCATION - UNLESS DETAILED OTHERWISE




CONTAINS CRITICAL ENERGY INFRASTRUCTURE INFORMATION  
 SUBJECT TO NON-DISCLOSURE PROVISIONS OF ISO-NE SCHEDULE 72 AND NEW ENGLAND POLICES PERTAINING TO CONFIDENTIAL INFORMATION (CEI)  
 DO NOT DISTRIBUTE  
 DATE OF REVIEW: 11/19/2011 BY: JLR

3/27/98	FINAL DRAWING	LSJ
2/17/99	AS BUILT	TVG/LNS/WH
1/2/92	FOR CONSTRUCTION	TVG/WH
01/03/91	FOR CONSTRUCTION	LNR/TVG/WH
No.	Date	Revision
		By: Chkd/Engr. Supv.

**UI United Illuminating**  
 an investor-owned electric light and power company  
 Drawn By: LMRK Design Engr. App. JSH  
 Checked By: TVG Design Supv. App. JSH

WESTPORT TO PEQUONNOCK 115KV LINE  
**PLAN AND PROFILE**  
 STRUCTURE B697 TO B707  
 Date: 10/1/99 Drawing Number: 24213-108  
 Scale: AS NOTED

FOSW NO. 295  
COND P. 295

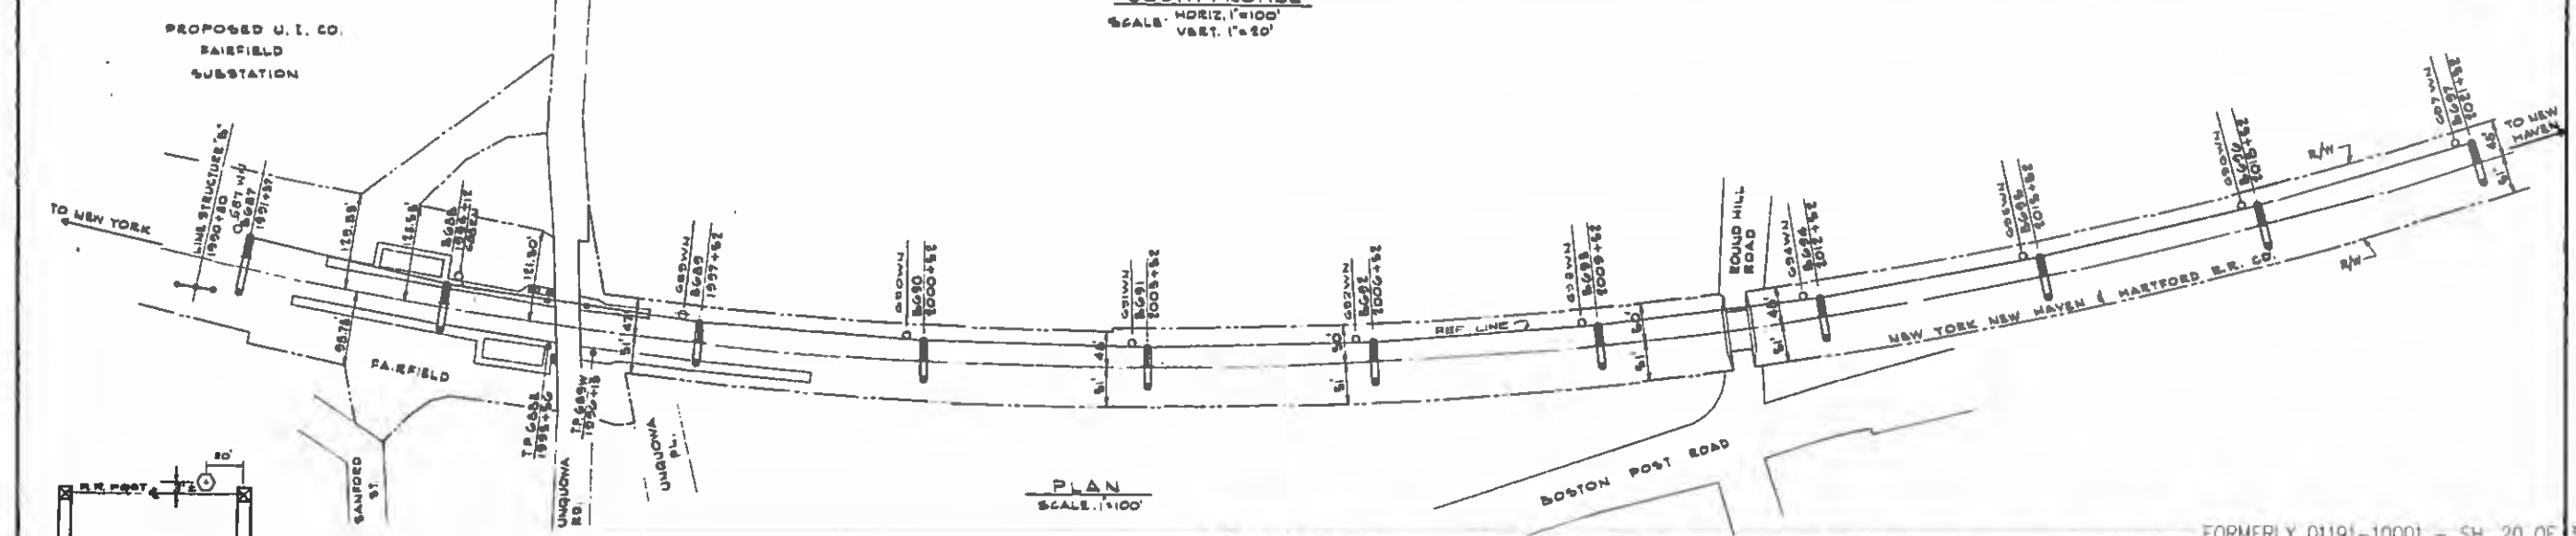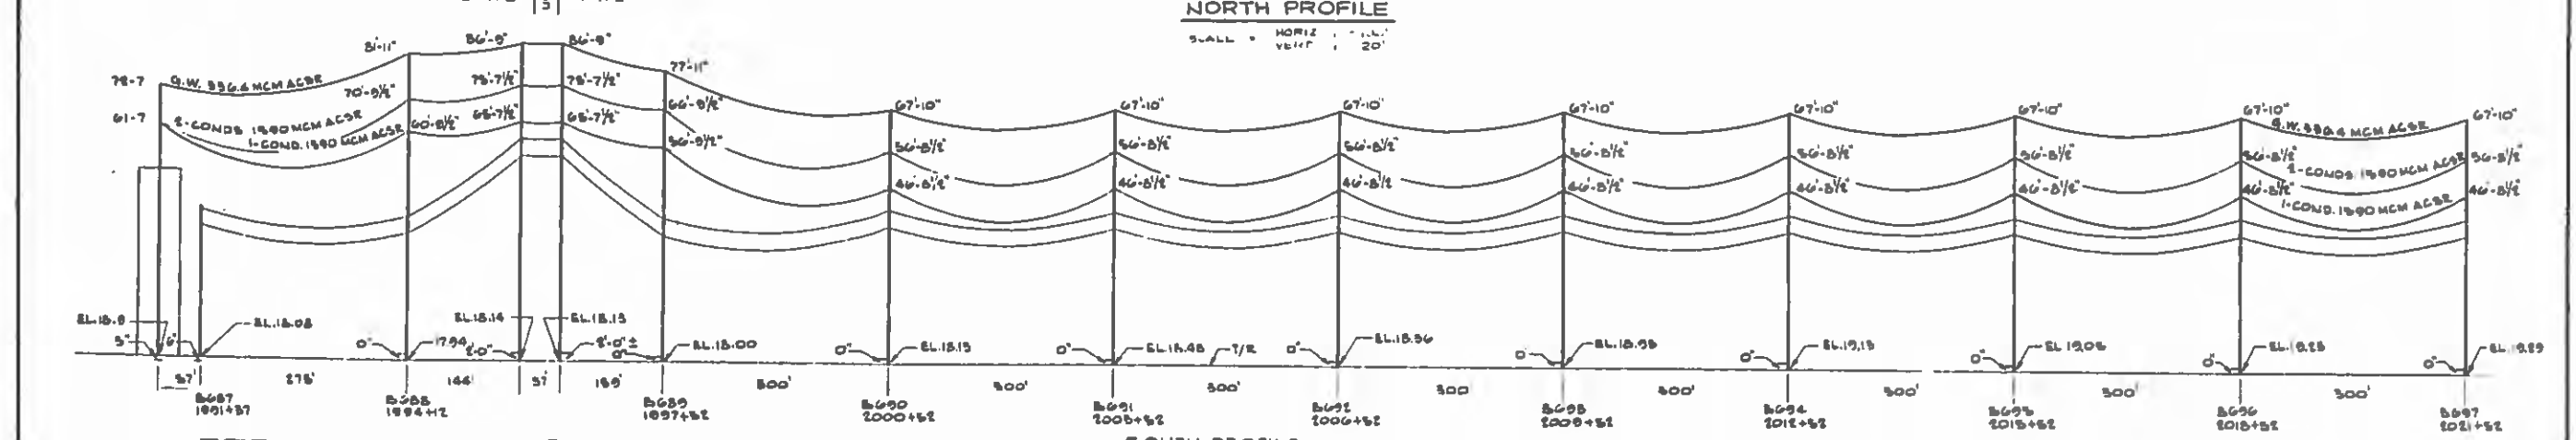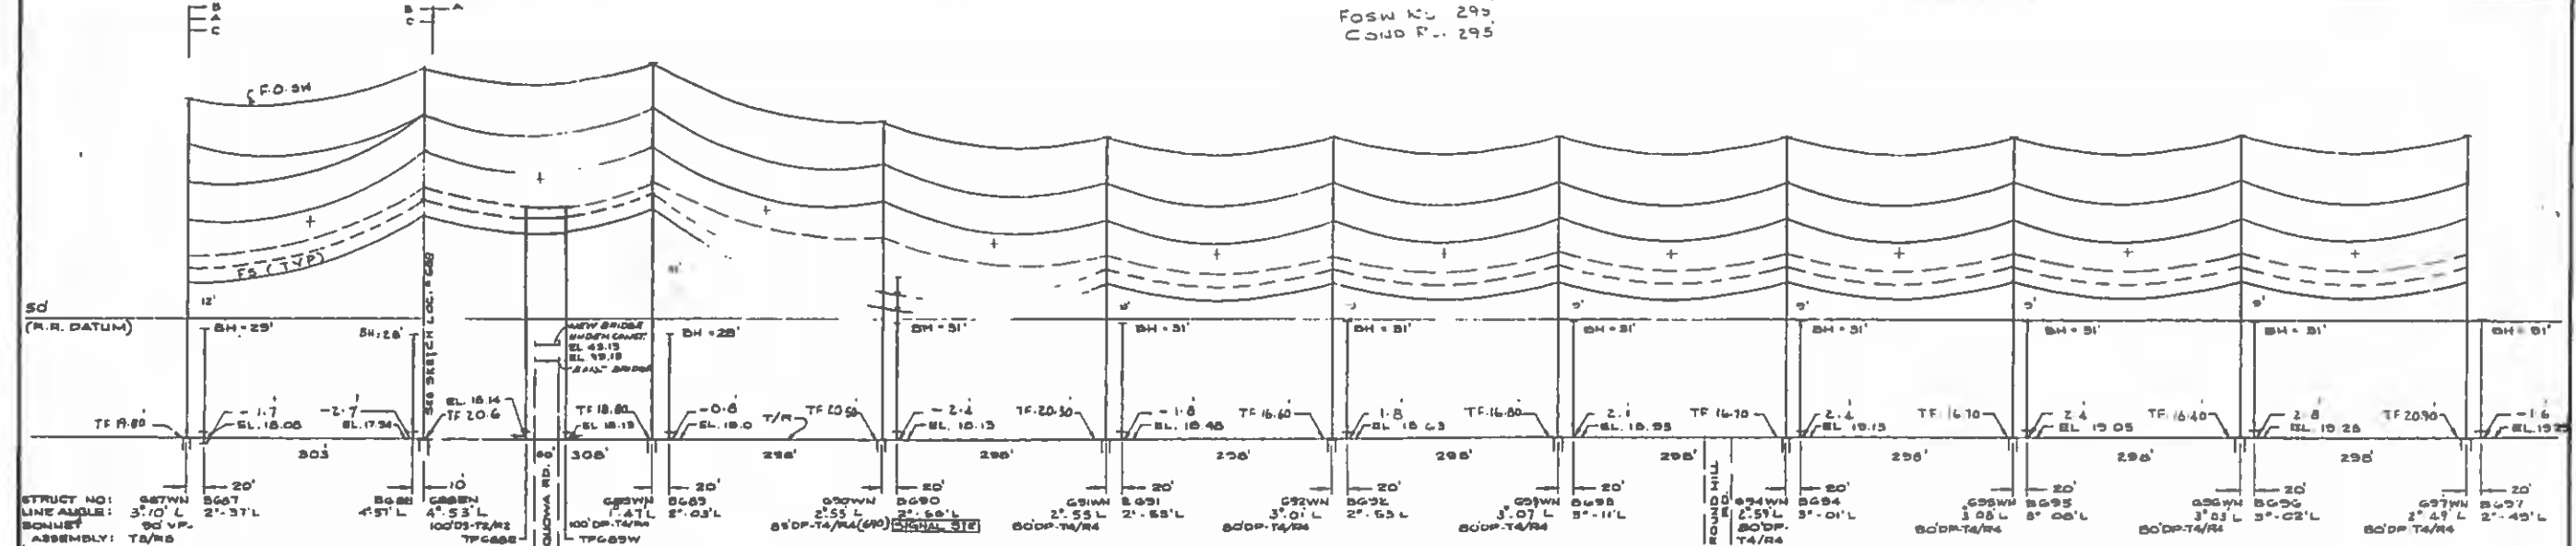

TYPICAL STEEL POLE LOCATION-UNLESS DETAILED OTHERWISE

CONTAINS CRITICAL ENERGY INFRASTRUCTURE INFORMATION SUBJECT TO NON-DISCLOSURE PROVISIONS OF FEDERAL 33 AND NEW ENGLAND POLICES REGULATORY INFORMATION (CER) DO NOT DISTRIBUTE DATE OF REVIEW: 11/18/2011


<p><b>U</b> <b>minating</b></p> <p>and power company</p>		<p>WESTPORT TO PEQUONNOCK 115KV LINE TO PEQUONNOCK 115 KV LINE PLAN AND PROFILE STRUCTURE 8667 TO 8697 STRUCTURE 8667 TO 8697</p>	
<p>DATE: 11/18/2011</p> <p>BY: [Signature]</p> <p>NO. DATE</p>		<p>DATE: 11/18/2011</p> <p>BY: [Signature]</p> <p>NO. DATE</p>	

FORMERLY 01191-10001 - SH 20 OF 30


01191-10001

109



58714

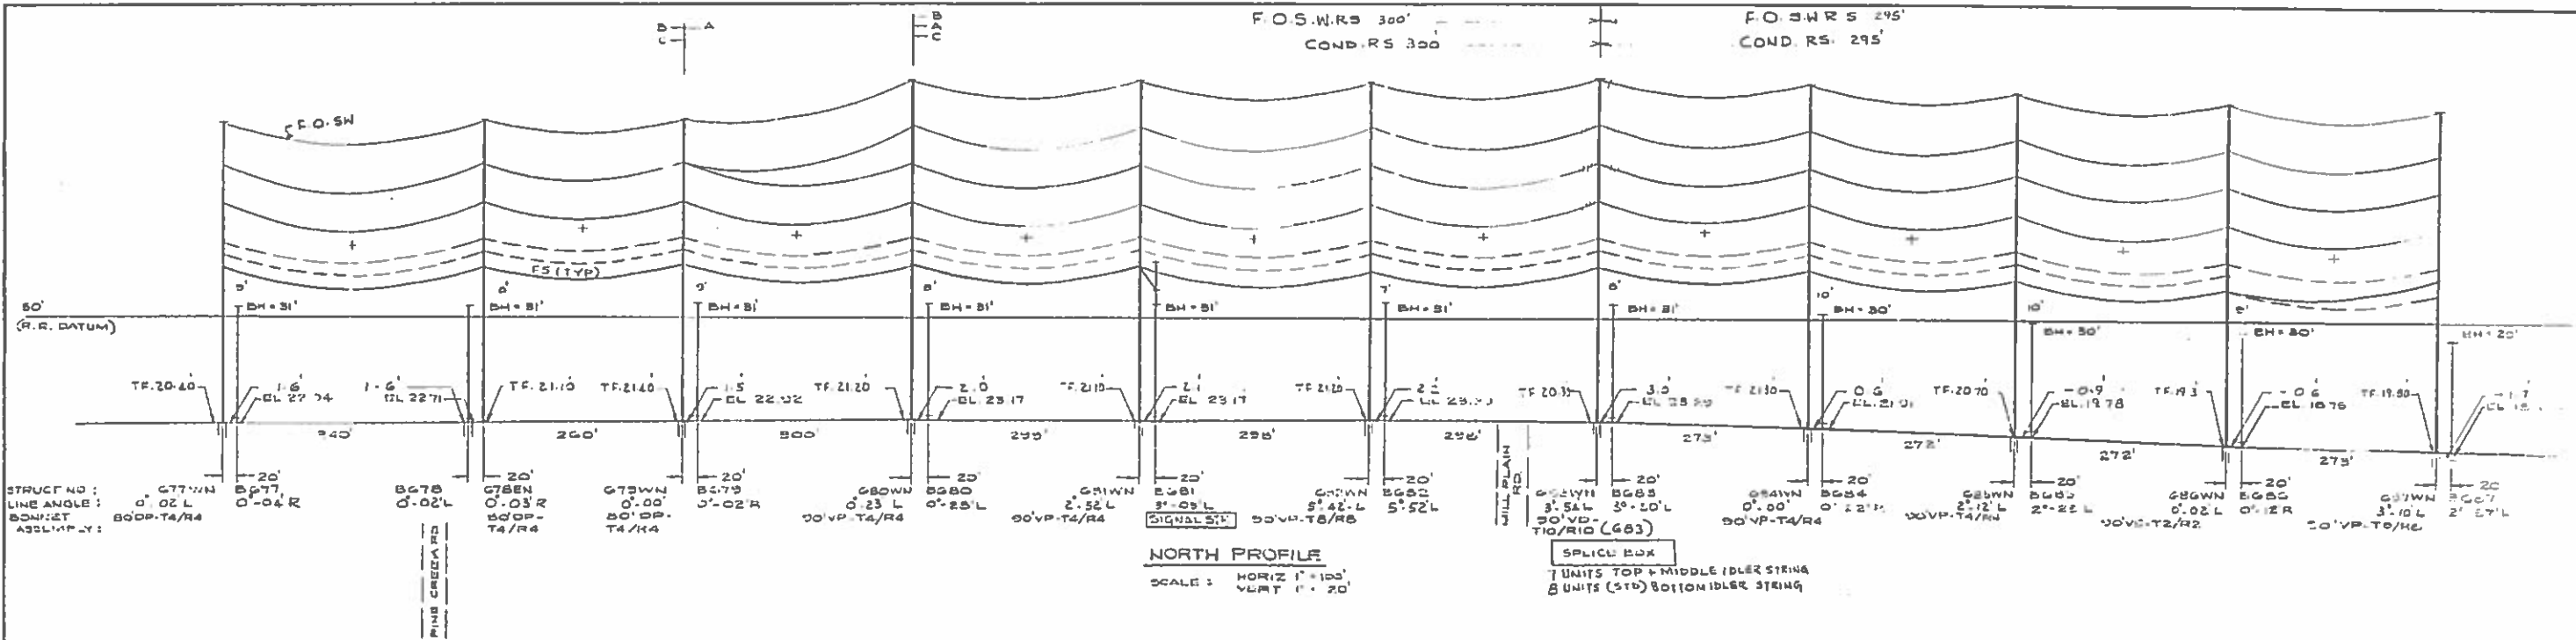

**NORTH PROFILE**  
SCALE: HORIZ 1"=100'  
VERT 1"=20'

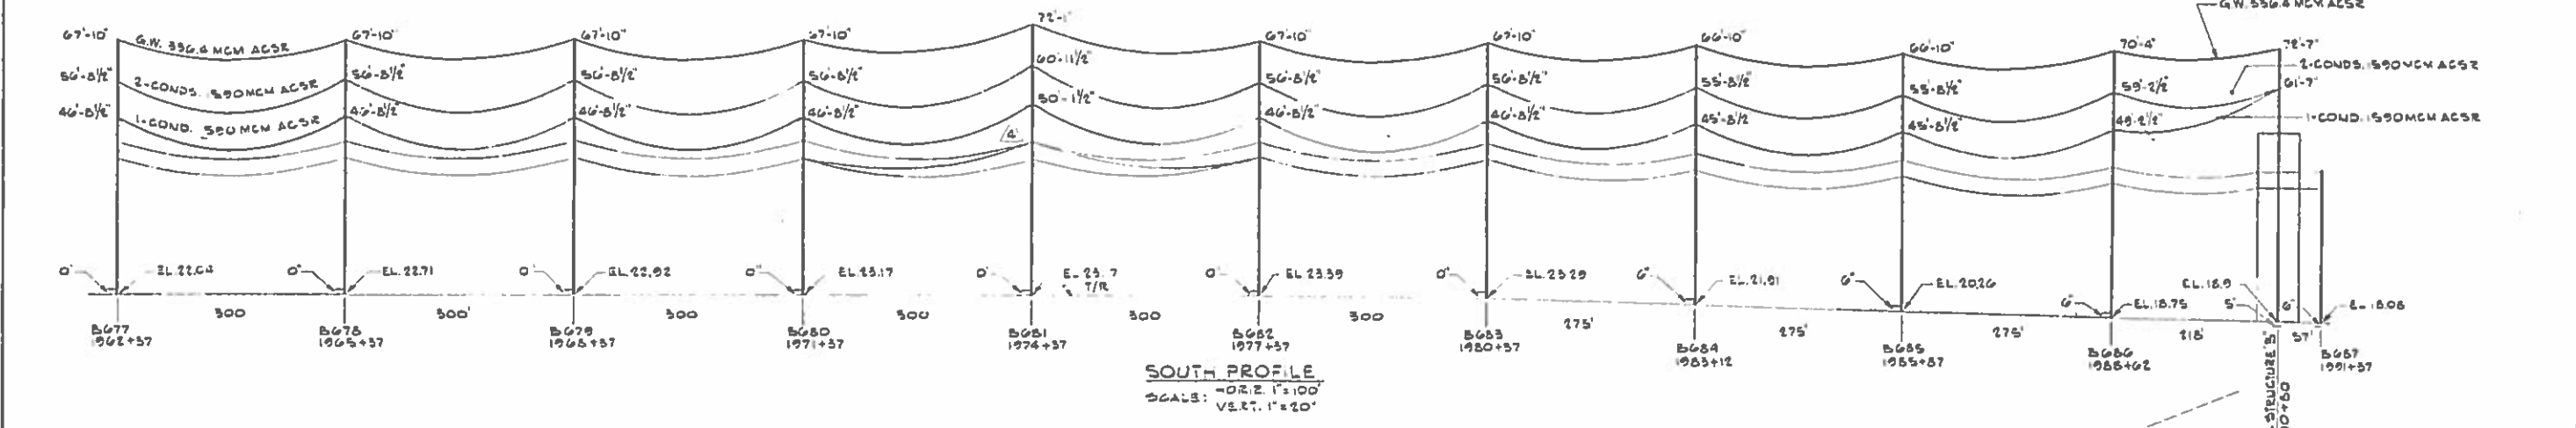

**SOUTH PROFILE**  
SCALE: HORIZ 1"=100'  
VERT 1"=20'

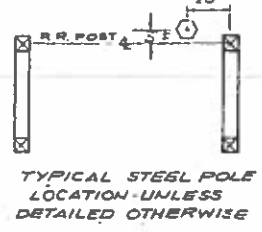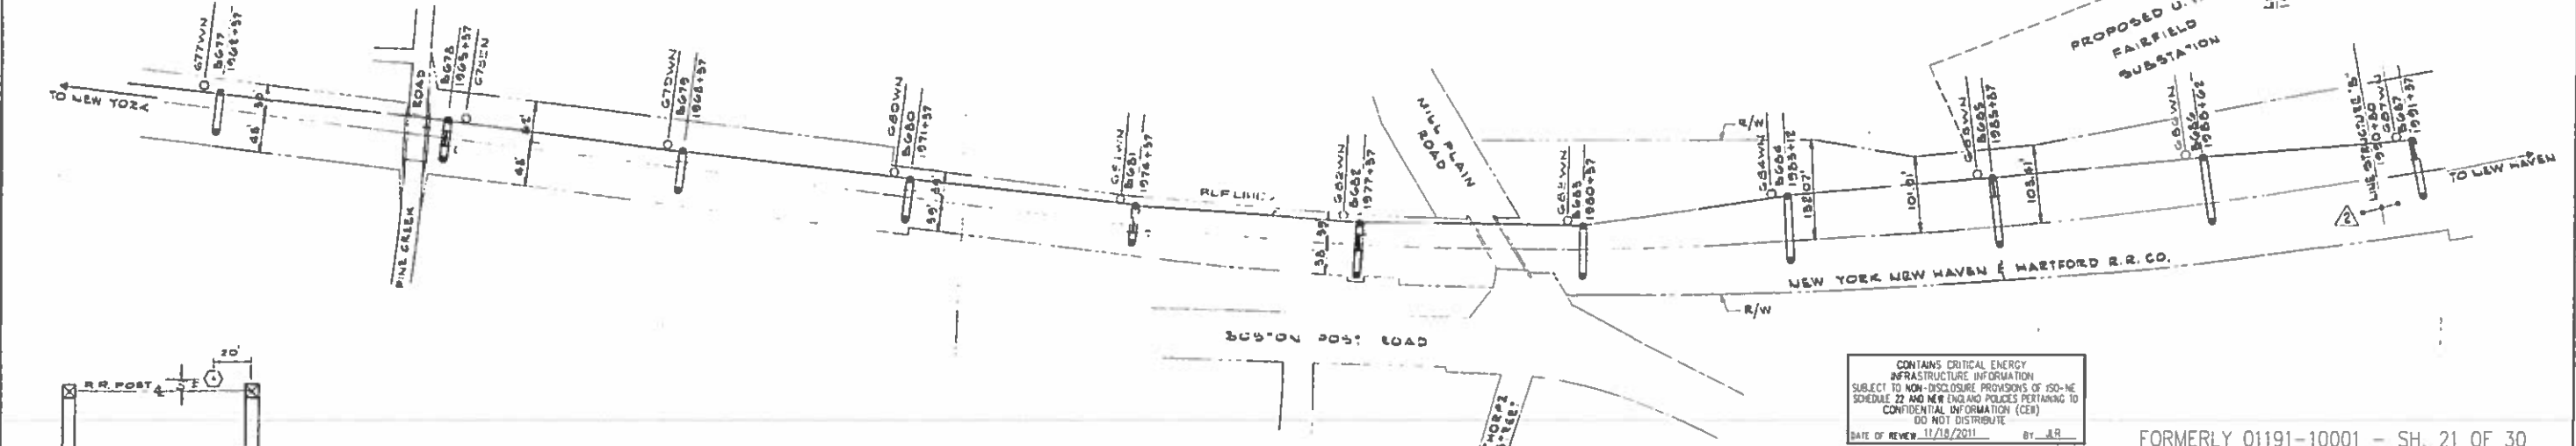

**PLAN**  
SCALE: 1"=100'

CONTAINS CRITICAL ENERGY INFRASTRUCTURE INFORMATION SUBJECT TO NON-DISCLOSURE PROVISIONS OF 160-N.E. SCHEDULE 22 AND NEW ENGLAND POLICES PERTAINING TO CONFIDENTIAL INFORMATION (CEI) DO NOT DISTRIBUTE DATE OF REVIEW 11/18/2011 BY JR

FORMERLY 01191-10001 - SH. 21 OF 30




No	Date	Revision	By	Chkd	Engr	Supv
1	2/1/98	RENUMBER DRAWING				
2	3/17/94	AS BUILT	TVG	JVS	DH	
3	2/6/92	ISSUED FOR CONSTRUCTION	TVG		DH	
4	10/30/91	ISSUED FOR BID	LMR	TVG	DH	

**UI United Illuminating**  
an investor-owned electric light and power company


Drawn By **J.M.R.K.** Design Engr. App. **J.F.S.**  
Checked By **J.V.G.** Design Supv. App. **J.F.S.**

<b>WESTPORT TO PEQUONNOCK 115KV LINE</b>	
<b>PLAN AND PROFILE STRUCTURE B677 TO B687</b>	
Date 10/11/01	Drawing Number 24213-110
Scale AS NOTED	

F.O.SN  
 COND. RS. 300

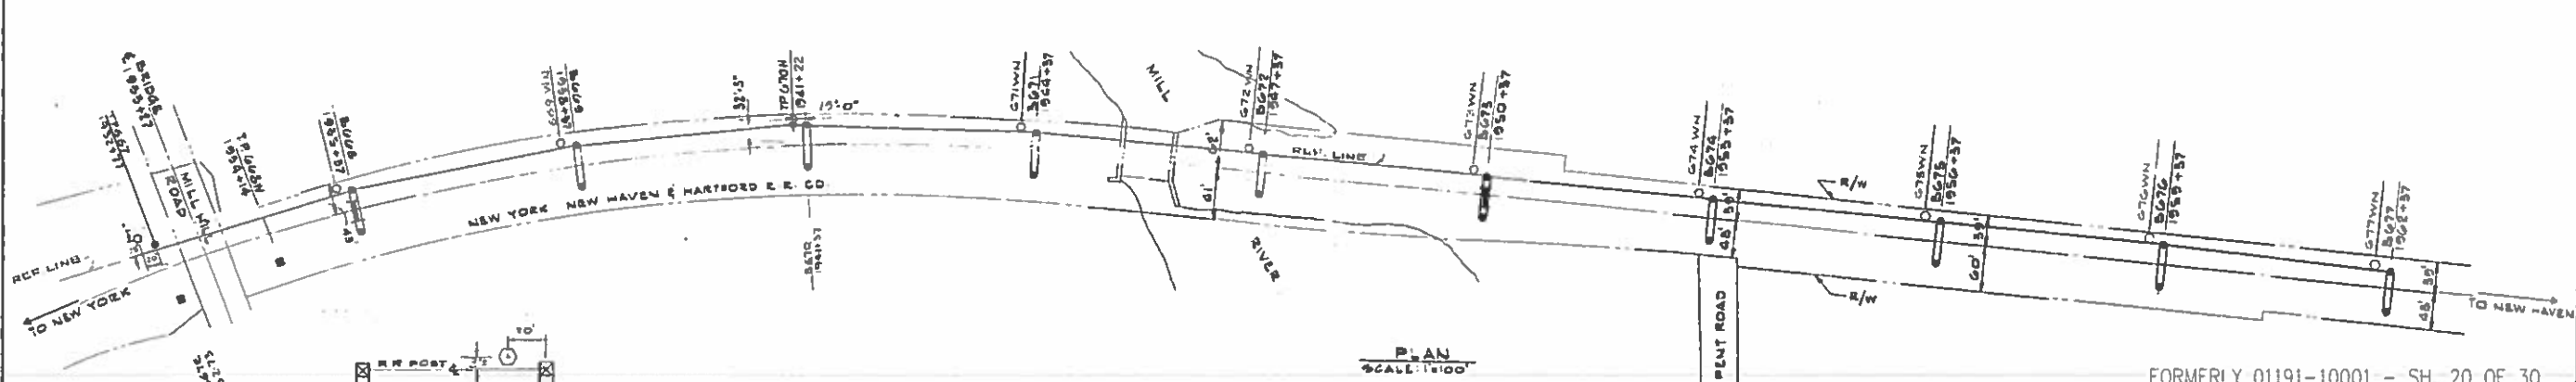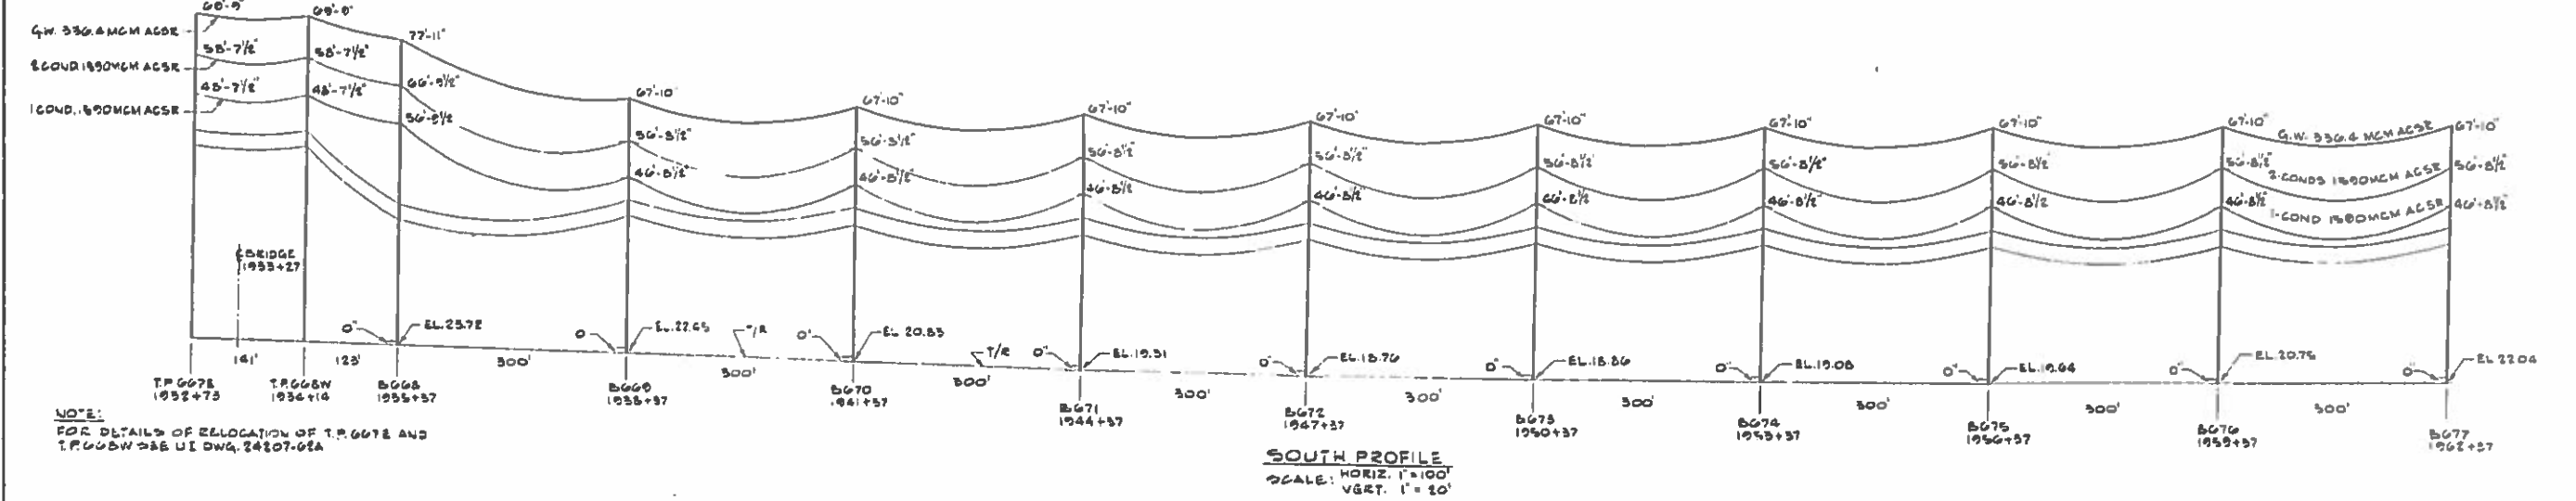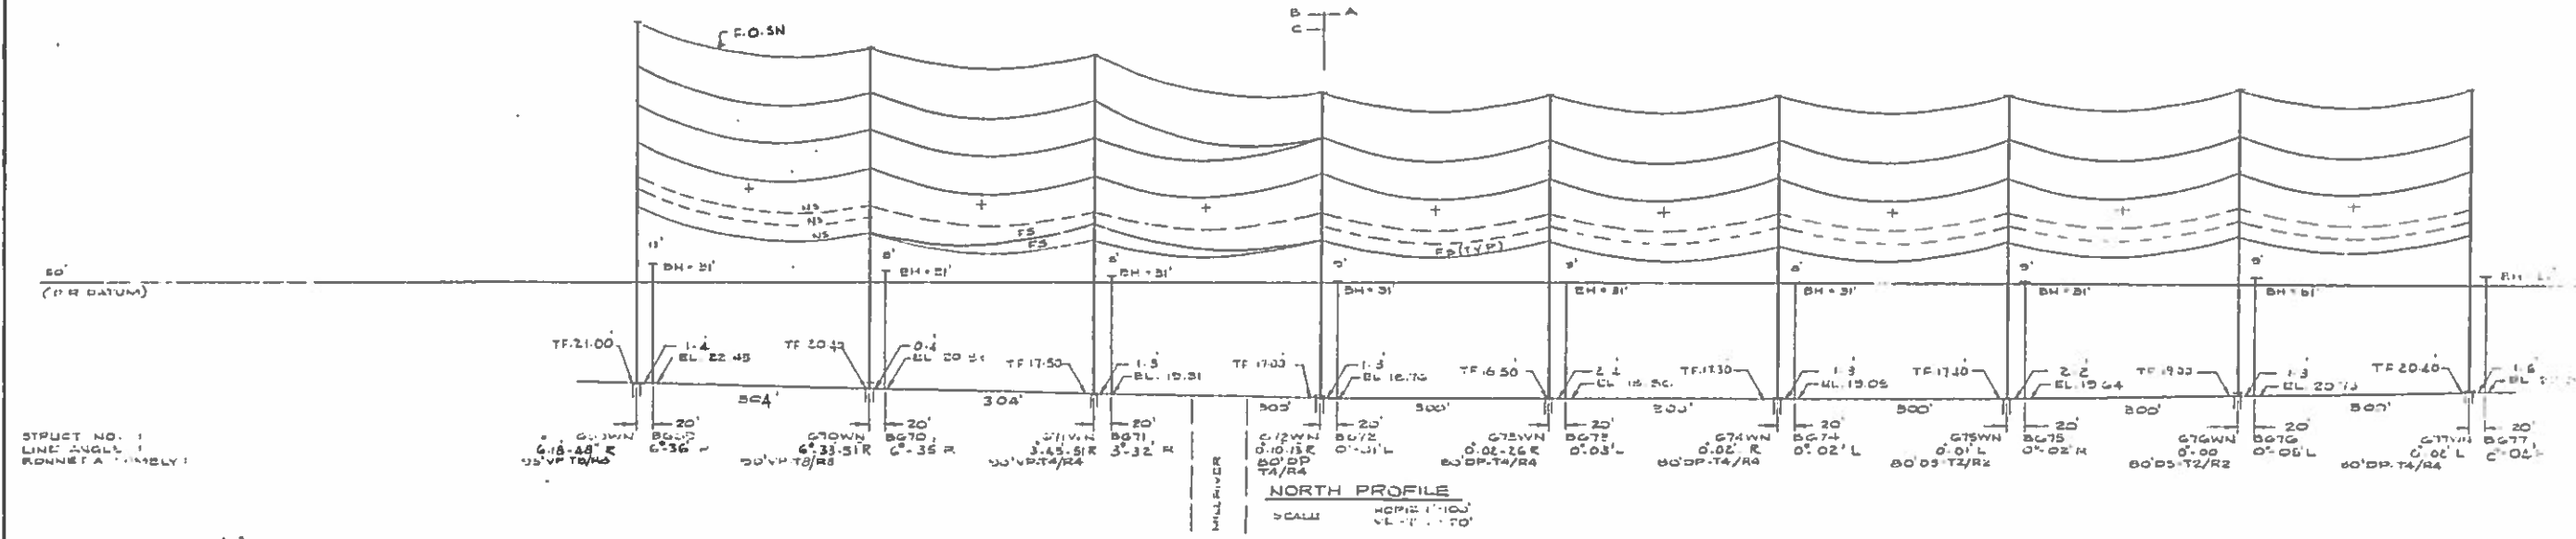

NOTE:  
 FOR DETAILS OF RELOCATION OF T.P. 6672 AND  
 T.P. 6674 SEE UI DWG. 24207-02A

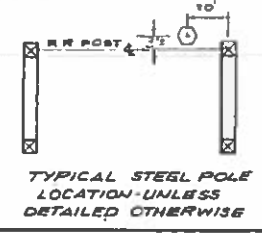


CONTAINS CRITICAL ENERGY  
 INFRASTRUCTURE INFORMATION  
 SUBJECT TO NON-DISCLOSURE PROVISIONS OF ISO-9000  
 SCHEDULE 22 AND NEW ENGLAND POLICES PERTAINING TO  
 CONFIDENTIAL INFORMATION (CCI)  
 DO NOT DISTRIBUTE  
 DATE OF REVIEW: 11/19/2011 BY: JLR


1	2/7/90	RENUMBER DRAWING	LSJ
2	3/17/94	AS BUILT	TVG NJS MH
3	12/16/98	ISSUED FOR CONSTRUCTION	TVG DJR
4	01/01/99	ISSUED FOR BID	LMR TVG DJR
No.	Date	Revision	By
			Chkd/Engr. Supv.

**UI United Illuminating**  
 an investor-owned electric light and power company  
 Drawn By: J.L.M.K. Design Engr. App. DJE  
 Checked By: T.V.G. Design Supv. App.

WESTPORT TO PEQUONNOCK  
 115KV LINE  
 PLAN AND PROFILE  
 STRUCTURE B669 TO B677  
 Date: 10/1/01 Drawing Number: 24213-111  
 Scale: AS NOTED

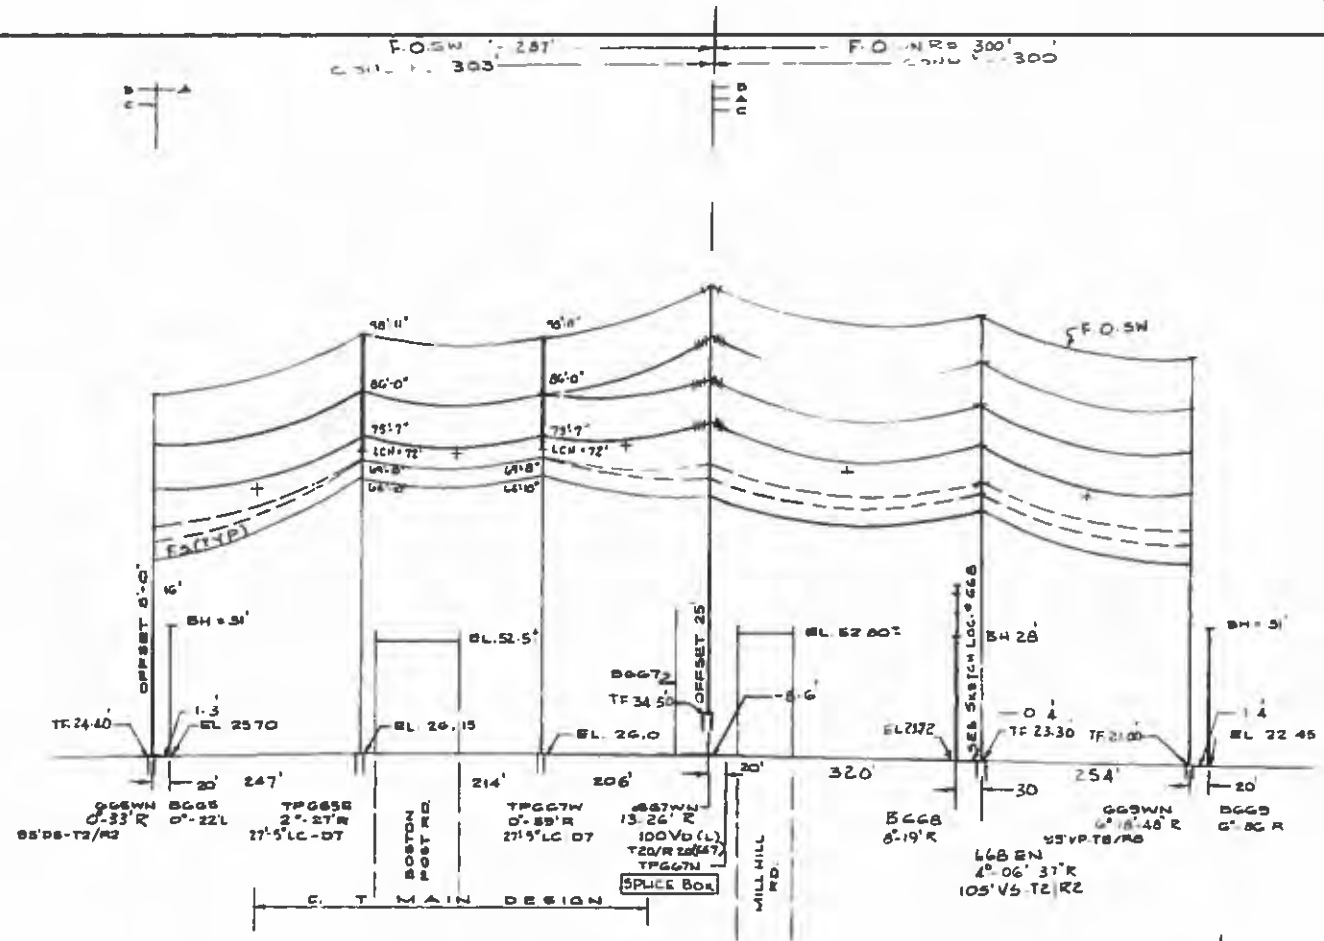


**NORTH PROFILE**  
SCALE = HORIZ 1" = 100'  
VERT 1" = 20'

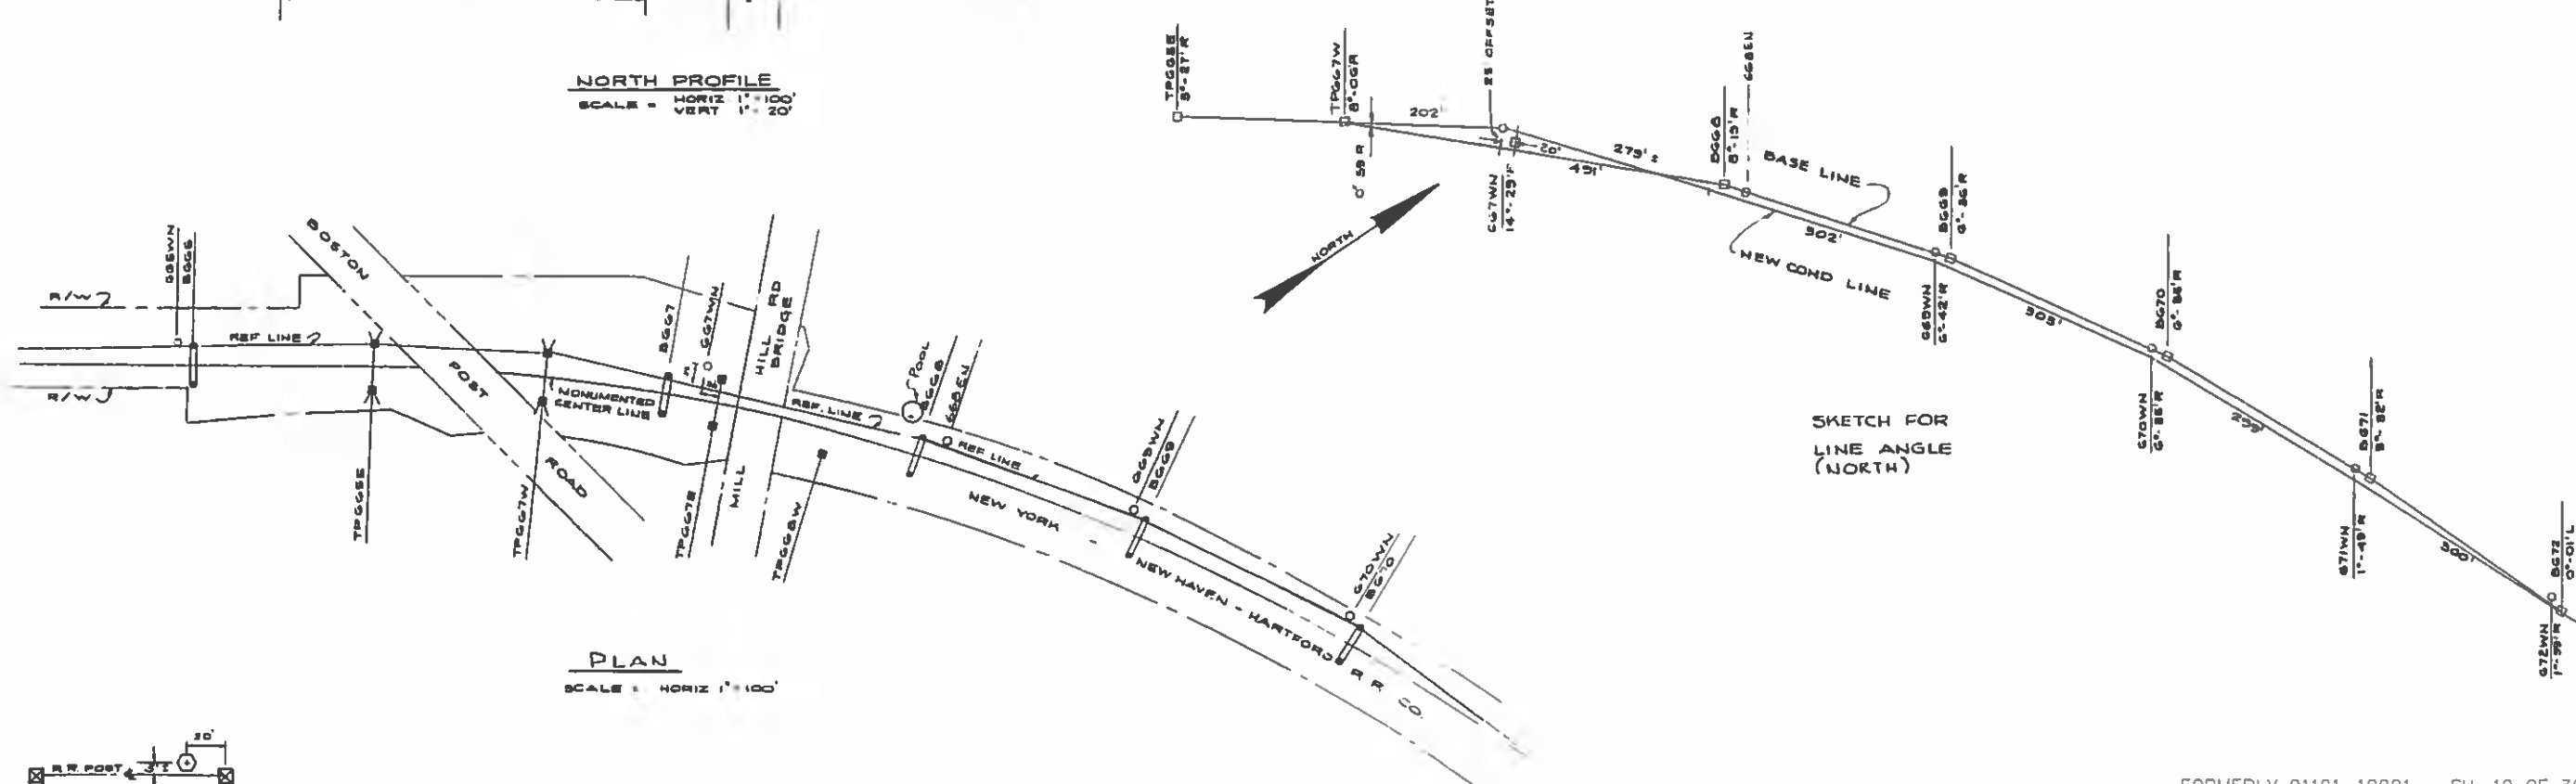

**PLAN**  
SCALE = HORIZ 1" = 100'

SKETCH FOR  
LINE ANGLE  
(NORTH)

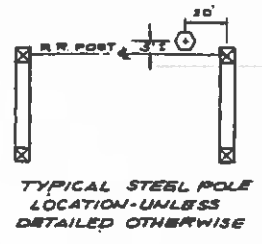

DOES NOT CONTAIN  
CRITICAL ENERGY INFRASTRUCTURE INFORMATION  
DATE OF REVIEW 11/28/2011 BY J.R.

1-6-92	MAIN	1883
ENGR	SUPV.	
WAJ	PEB	





No	Date	Revision	By	Chkd/Engr/Supv.
1	2/1/98	REVISION DRAWING	TVG	WJH
2	3/17/98	AS BUILT	TVG	WJH
3	2/20/02	REVISED LOCATION	TVG	WJH
4	12/6/98	ISSUED FOR CONSTRUCTION	TVG	WJH
5	05/30/01	ISSUED FOR BID	LMB	TVG

**UI United Illuminating**  
an investor-owned electric light and power company

Drawn By L.M.R.K. Design Engr. App. J.T.H.  
Checked By TVG Design Supv. App. J.T.H.

WESTPORT TO PEQUONNOCK 115KV LINE	
PLAN AND PROFILE STRUCTURE B665 TO B669	
Date: 10/1/01	Drawing Number: 24213-112
Scale: AS NOTED	

FORMERLY 01191-10001 - SH. 19 OF 30

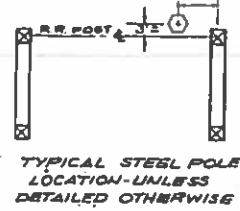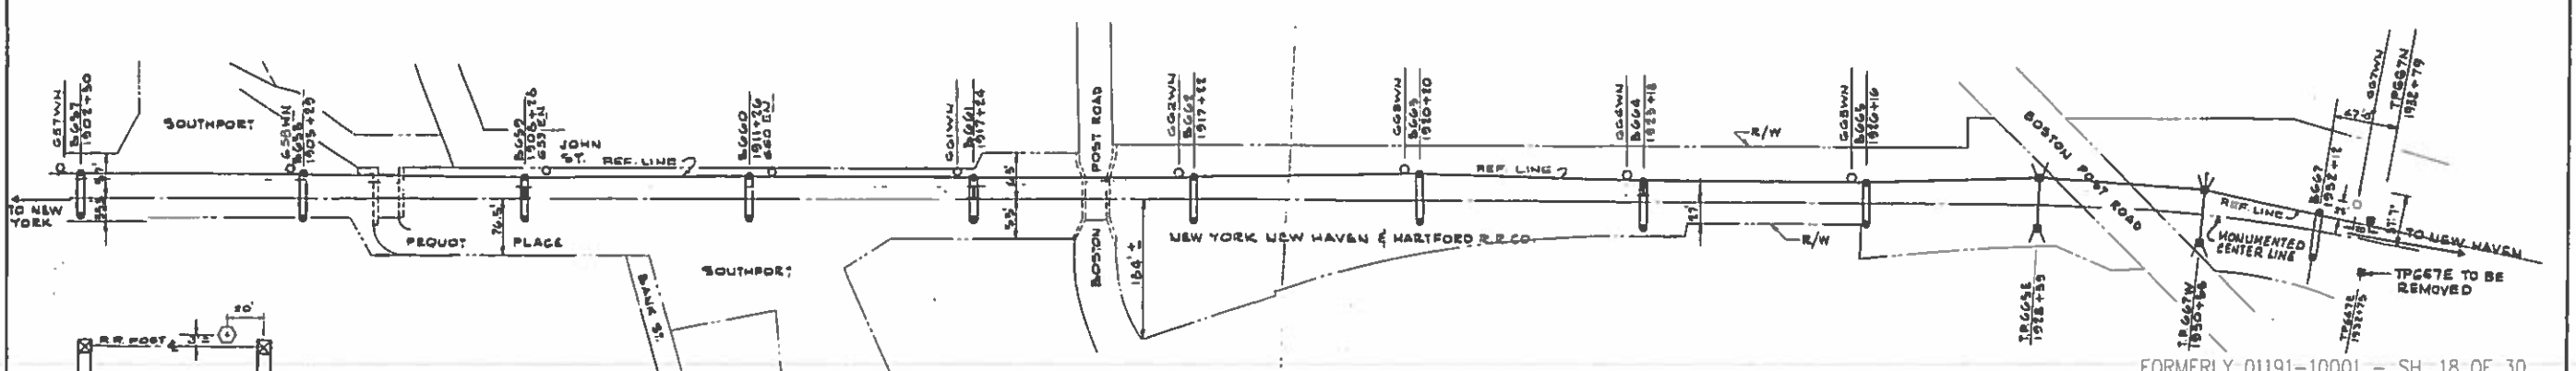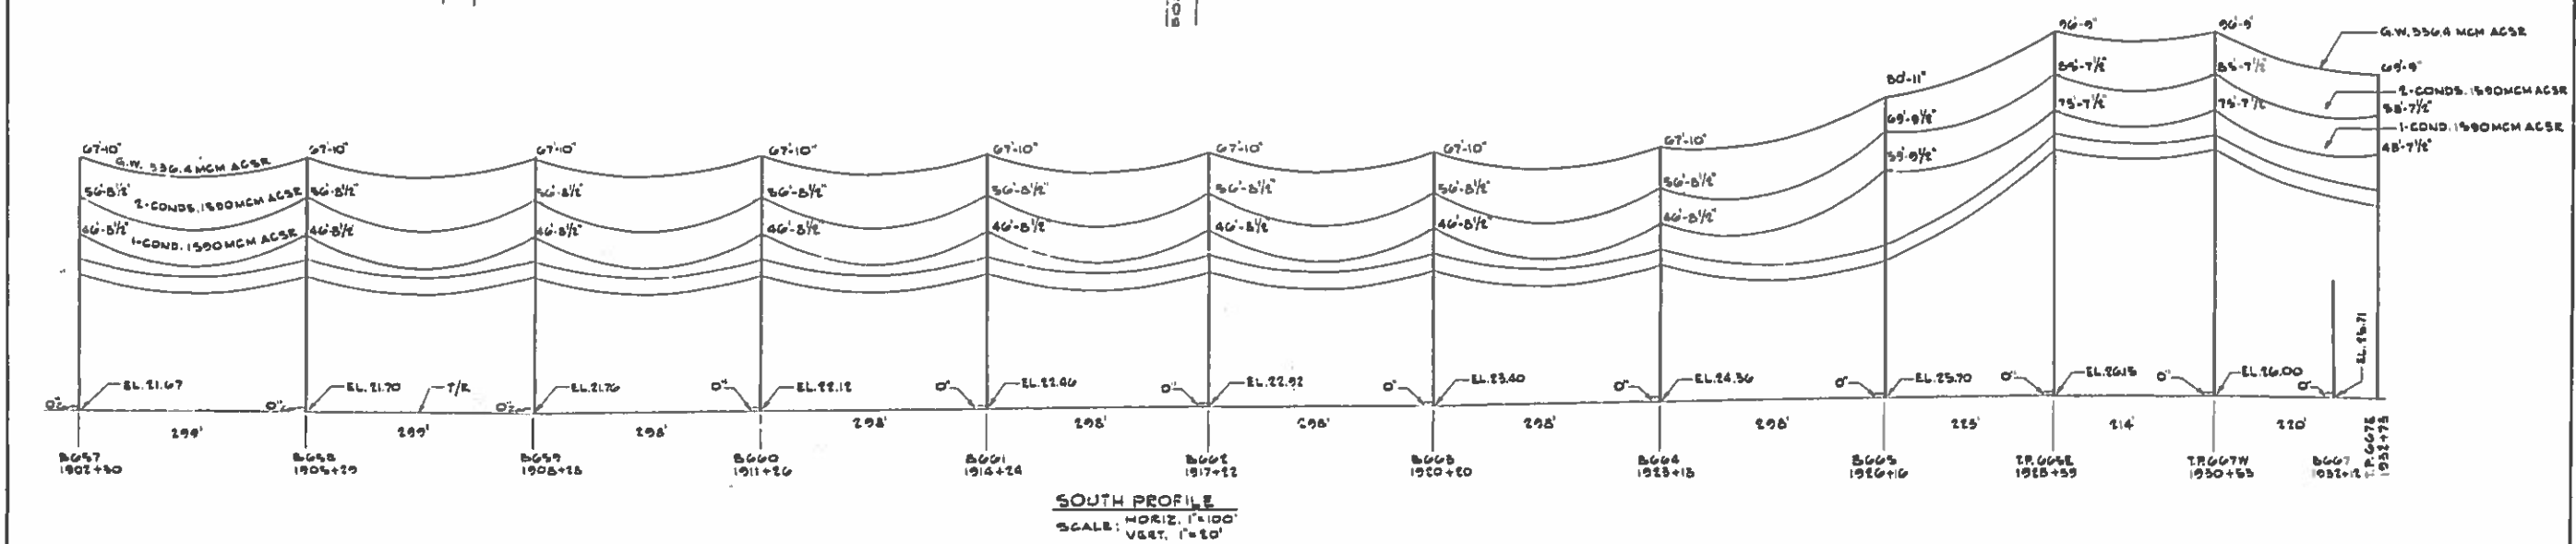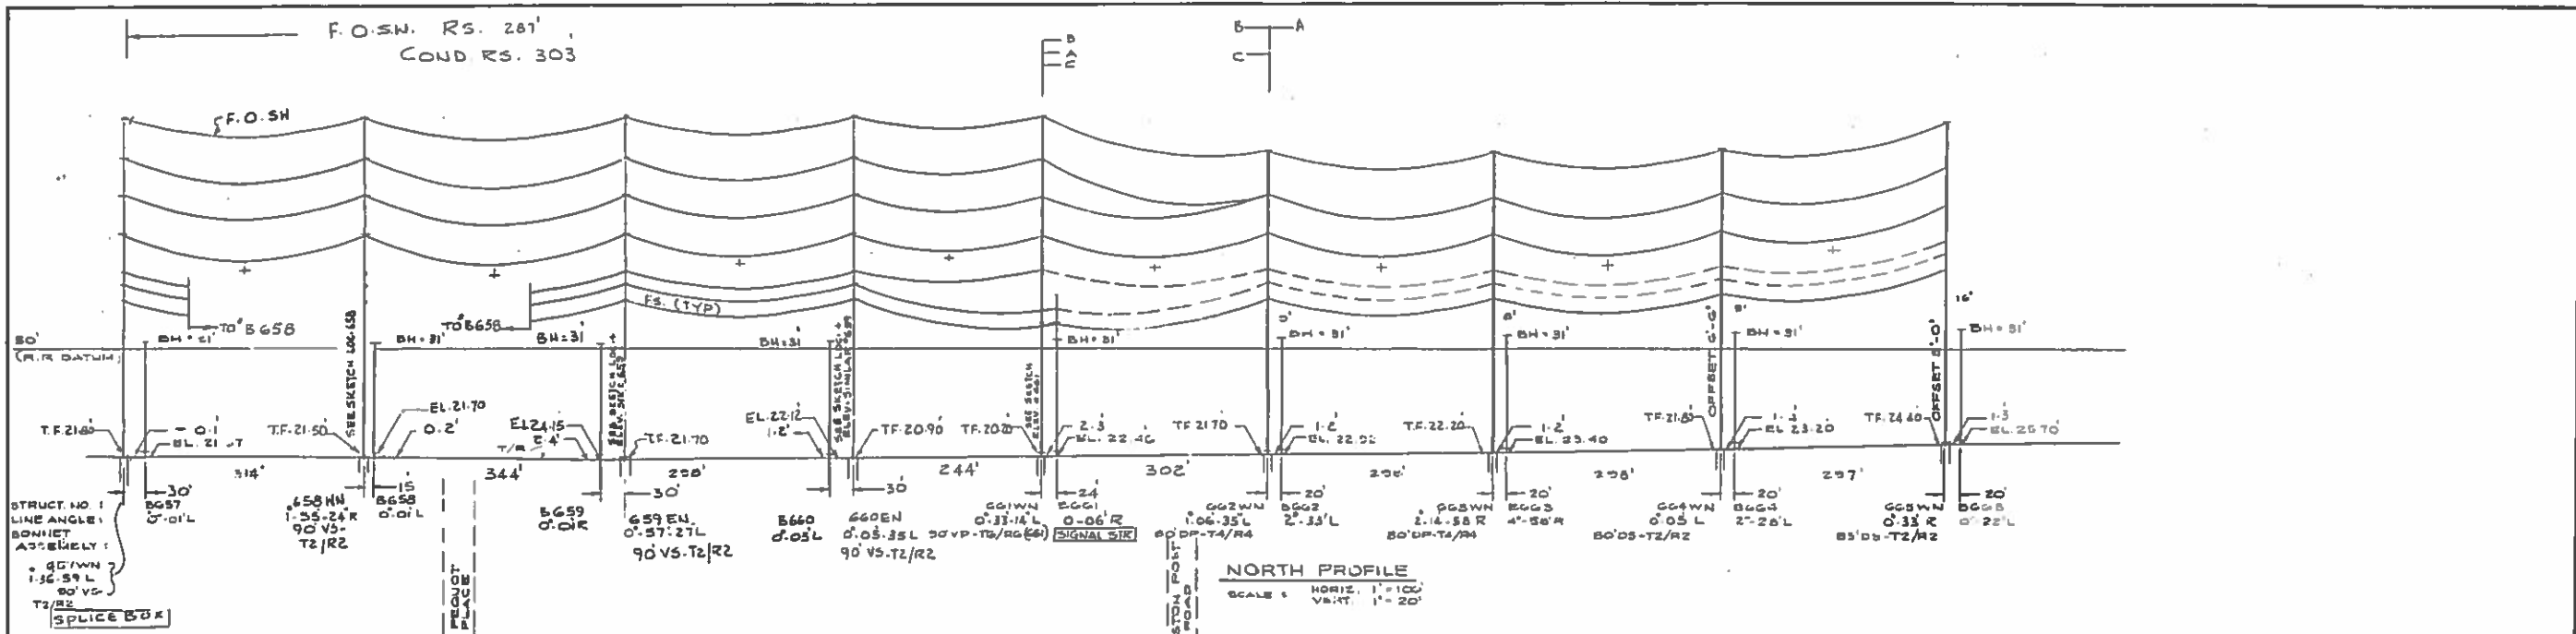

CONTAINS CRITICAL ENERGY INFRASTRUCTURE INFORMATION SUBJECT TO NON-DISCLOSURE PROVISIONS OF ISO-9000 SCHEDULE 22 AND NEW ENGLAND POLICE PROHIBITION TO CONFIDENTIAL INFORMATION (CIS) DO NOT DISTRIBUTE DATE OF REVIEW 11/18/2011 BY [Signature]

PLAN SCALE: 1"=100'

1	7/1/98	REVISION DRAWING	L.S.T.
2	3/17/99	AS BUILT	T.V.G. APP. D.M.
3	10/09/2012	REVISION - 661WN - REVISED LOCATIONS	T.V.G. D.M.
4	11/26/12	ISSUED FOR CONSTRUCTION	T.V.G. D.M.
5	10/30/13	ISSUED FOR BID	L.M.R. T.V.G. D.M.
No.	Date	Revision	By Chkd Engr. Supv.

**UI United Illuminating**  
an investor-owned electric light and power company


Drawn By: L.M.R.K. Design Engr. App. [Signature]  
Checked By: T.V.G. Design Supv. App. [Signature]

WESTPORT TO PEQUONNOCK 115KV LINE


PLAN AND PROFILE STRUCTURE 6657 TO 6655

Date: 10/1/13 Drawing Number: 24213-113  
Scale: AS NOTED


FORMERLY 01191-10001 - SH. 18 OF 30

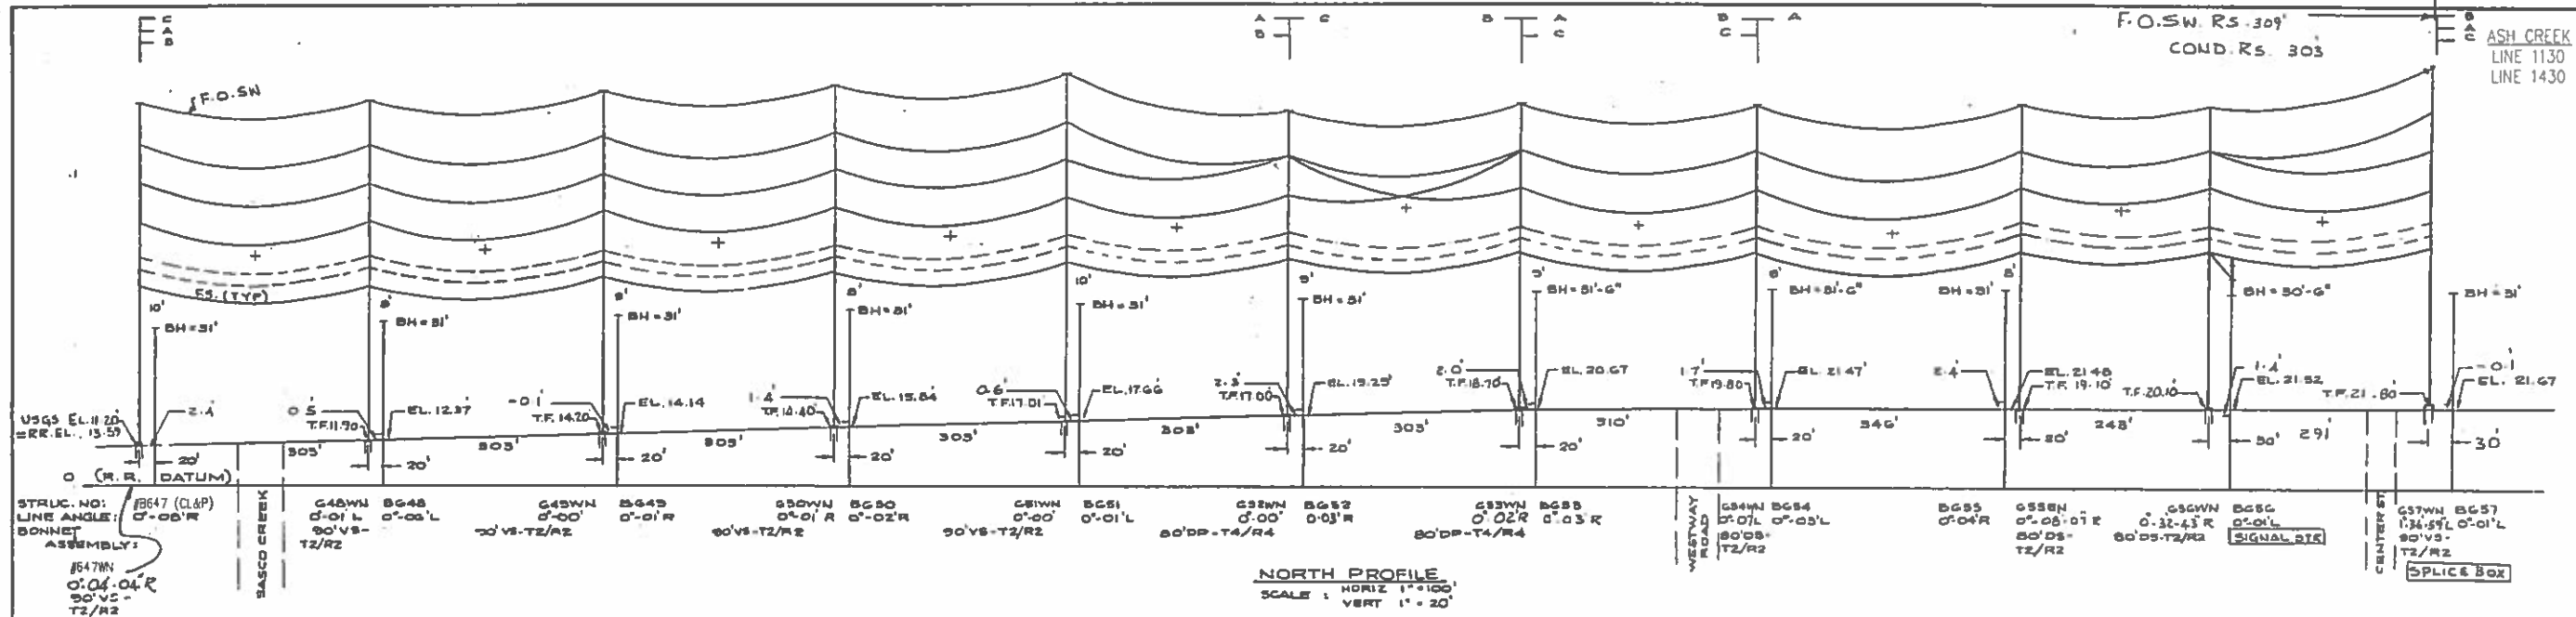

NORTH PROFILE  
HORIZ. 1"=100'  
SCALE: VERT. 1"=20'

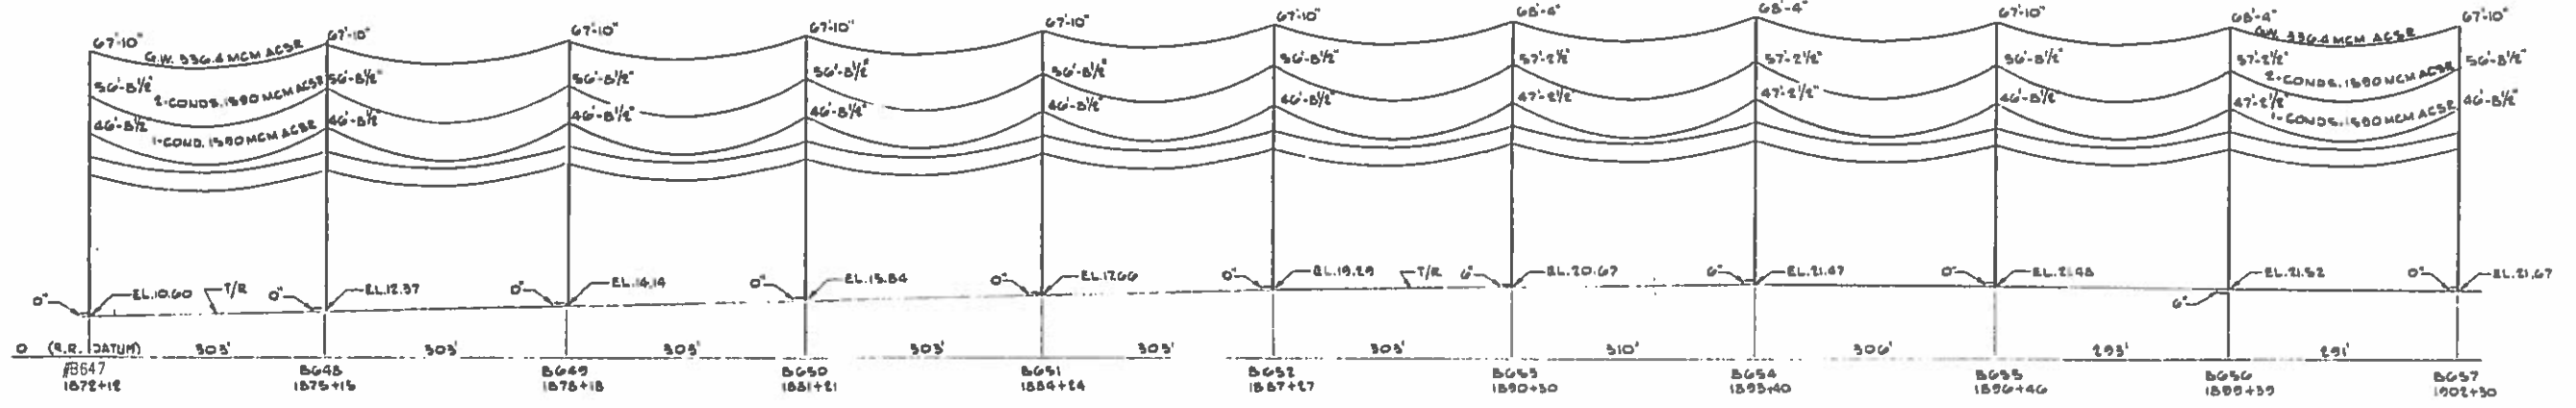


SOUTH PROFILE  
HORIZ. 1"=100'  
SCALE: VERT. 1"=20'

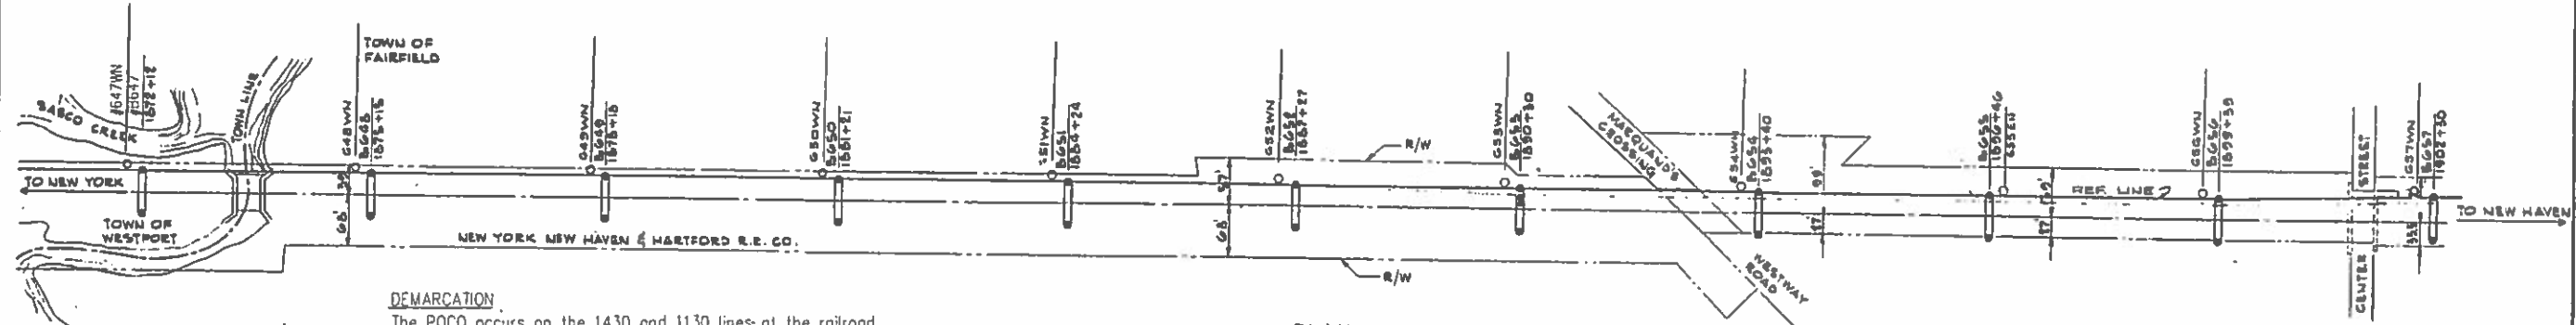

PLAN  
SCALE: 1"=100'

**DEMARCATION**  
The POCO occurs on the 1430 and 1130 lines at the railroad overbuild structure #B647 and the Structure #647WN respectively which are located near the Westport/Fairfield town line. CL&P owns structures and insulators on the structures.

UI owns the conductor line attached to both structures and the rest of the conductor and structures toward UI Ash Creek Substation.

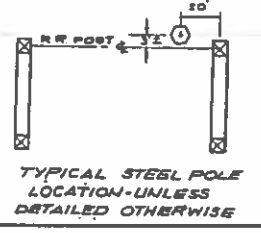


CONTAINS CRITICAL ENERGY INFRASTRUCTURE INFORMATION  
SUBJECT TO NON-DISCLOSURE PROVISIONS OF ISO-NE SCHEDULE 22 AND NEW ENGLAND POLICES PERTAINING TO CONFIDENTIAL INFORMATION (CIN)  
DO NOT DISTRIBUTE  
DATE OF REVIEW: 11/3/2014 BY: SR

No.	Date	Revision	By	Chkd/Engr/Supv.
3	10/31/14	ADD NUIS DEMARCATION NOTE	VP	SR
4	2/1/16	RENUMBER DRAWING	LST	SR
5	3/17/18	AS BUILT	TVG	MZ/DH
6	10/30/22	STR. # 657 WN - REVISED LOCATION	TVG	MZ/DH
7	12/6/22	ISSUED FOR CONSTRUCTION	TVG	MZ/DH
8	10/30/22	ISSUED FOR BID	LMENTVG	MZ/DH

**UI United Illuminating**  
an investor-owned electric light and power company  
Drawn By: L.M.R.K. Design Engr. App: P.H.  
Checked By: T.V.G. Design Supv. App:

WESTPORT TO PEQUONNOCK  
115 KV LINE  
PLAN AND PROFILE  
STRUCTURE #647 TO #657  
Date: 10/11/21 Drawing Number: 24213-114  
Scale: AS NOTED

SEQ# 56709 FORMERLY 01191-10001 - SH. 17 OF 30

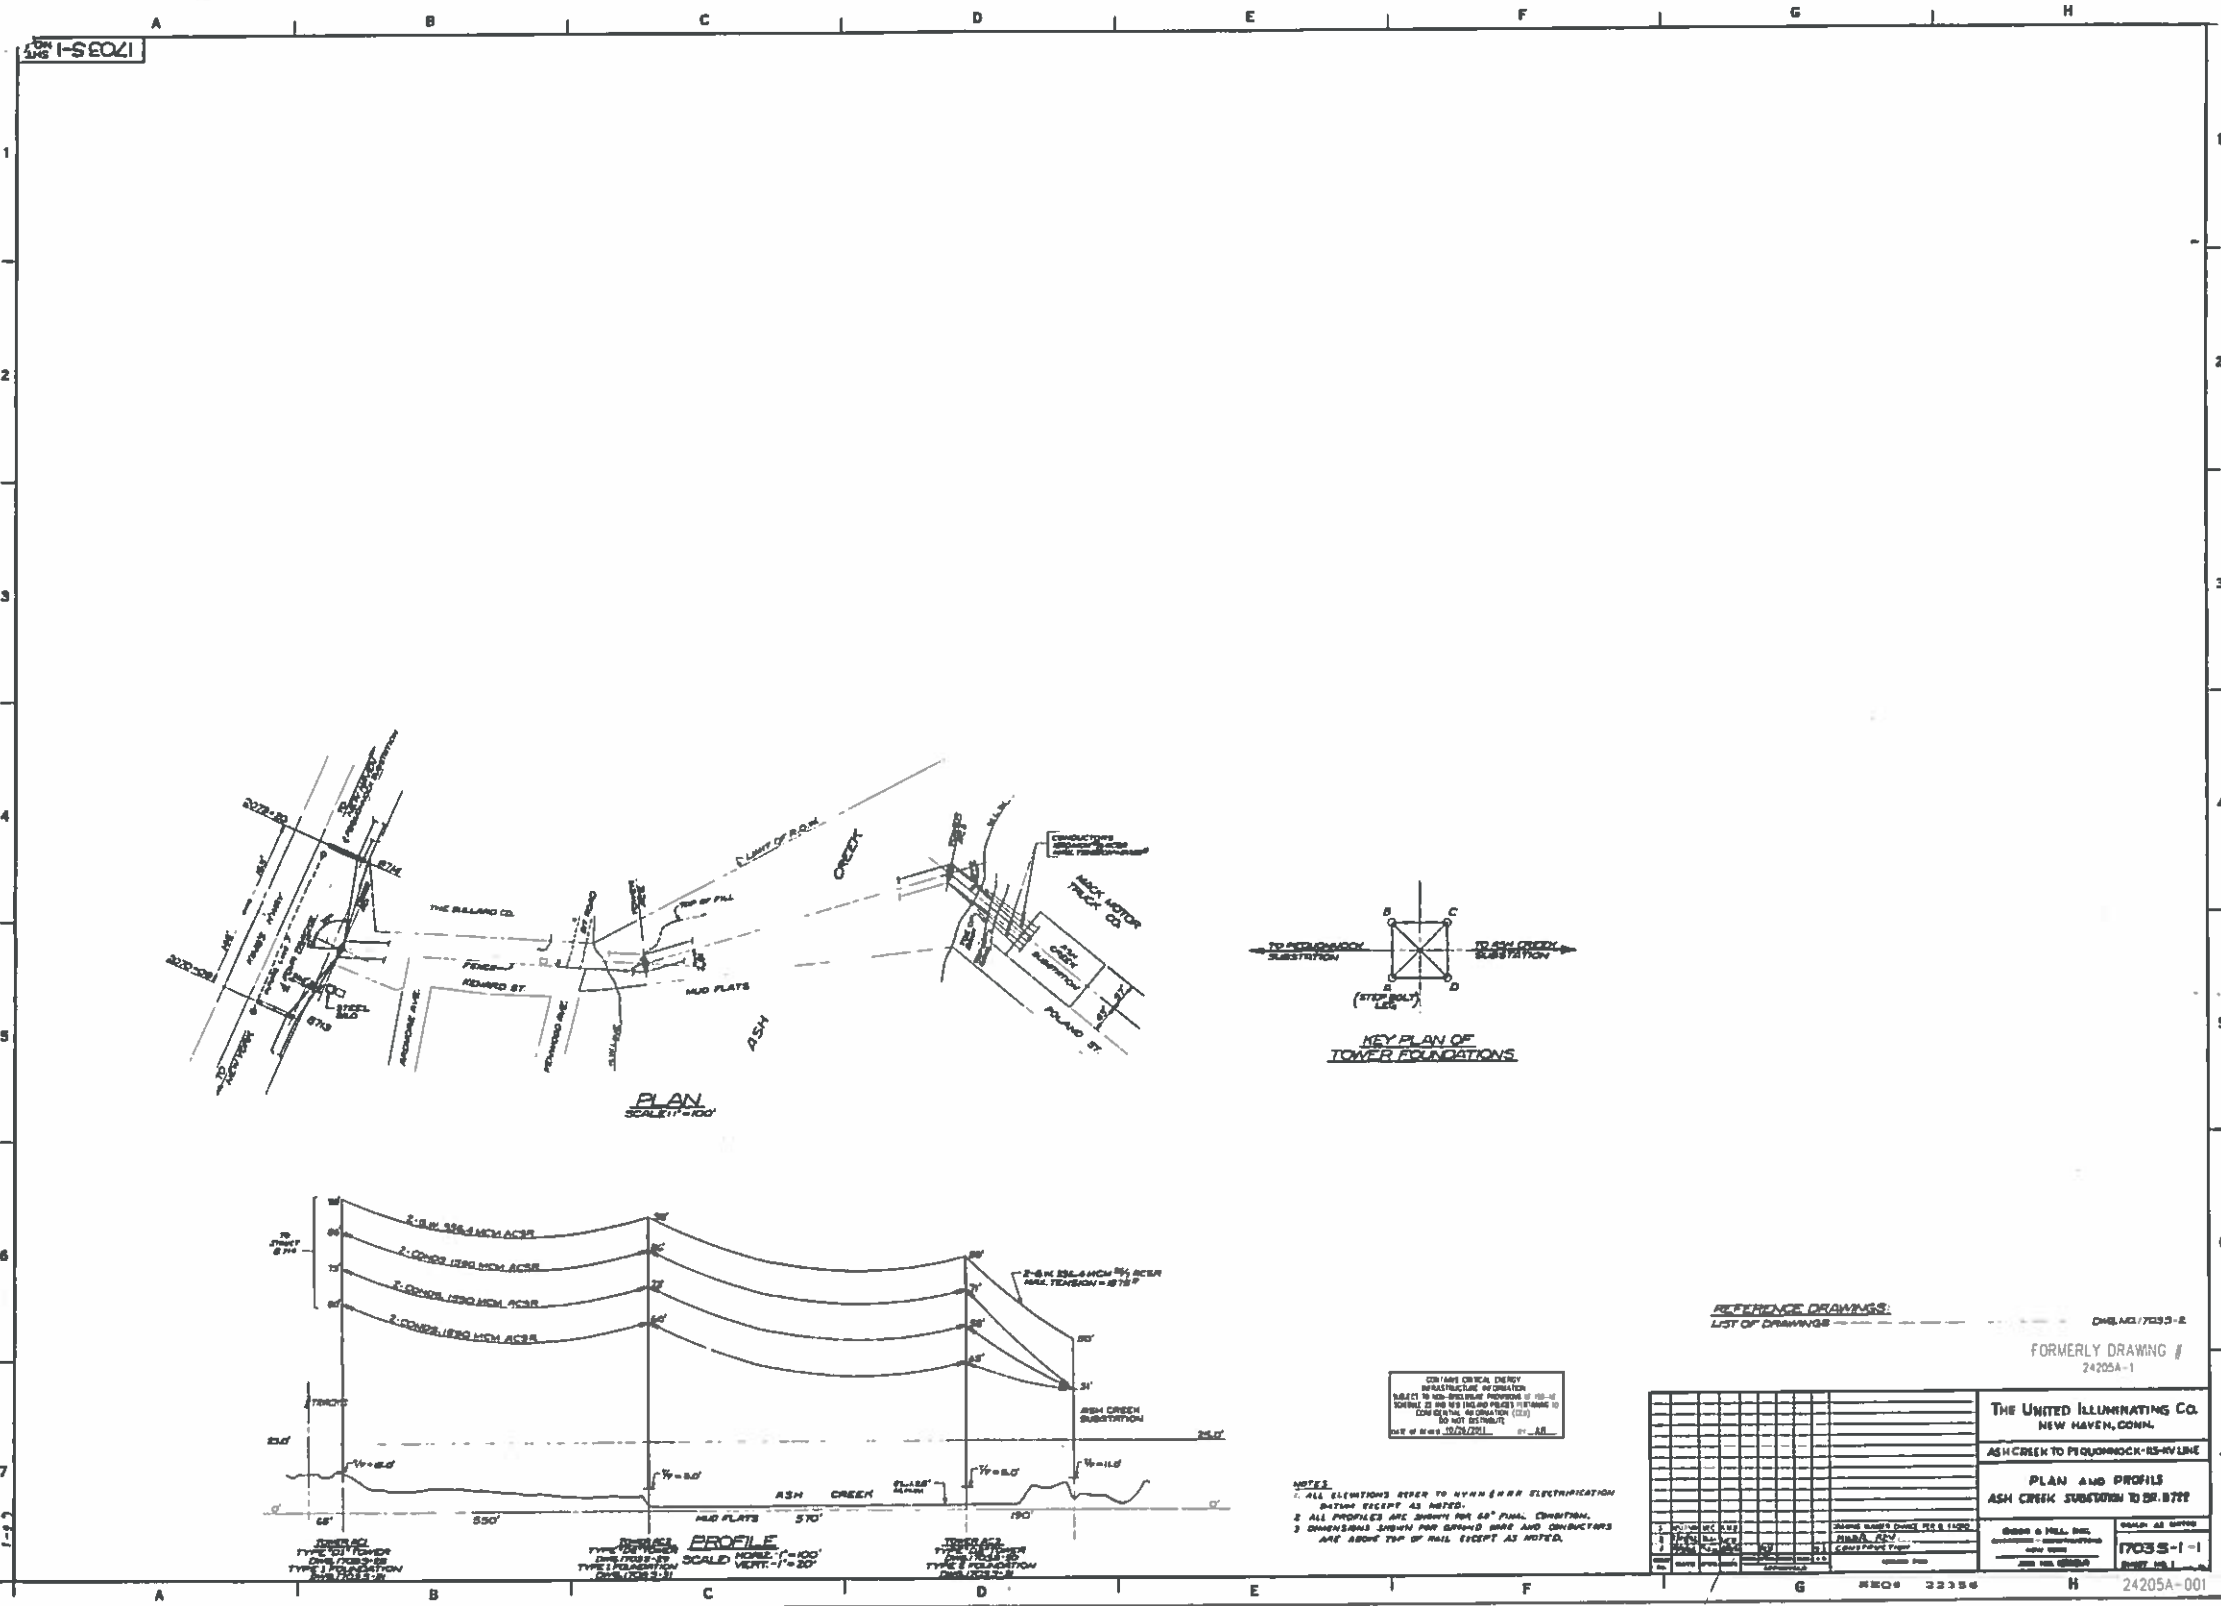

Ash Creek



1704S-26

**CONDUCTOR  
SAG AND TENSION DATA**

1,590,000 CM ACSR 45/7 STRANDING  
RATED BREAKING STRENGTH 42,700#, WEIGHT PER FT 1.799#

**HEAVY LOADING DISTRICT (NESC)**

TENSIONS WORKED TO THE FOLLOWING LIMITS  
AT MAX VLM LOAD 0°F, 1/2" ICE, 8"/SQ FT WIND 94.4% (22.5% OF ULTIMATE)  
FINAL (AFTER MAXIMUM LOAD) 50°F, NO ICE, NO WIND 41.5% (9.5% OF ULTIMATE)

SAGS BASED ON 5'-0" SAG IN 300 FEET

TEMP °F	SPAN LENGTH										TENSION LBS
	200	210	240	260	280	300	320	340	400	480	
0	1.4	1.7	1.11	2.3	2.7	3.0	3.5	3.10	5.4	7.8	2760
20	1.7	2.1	1.4	2.8	3.2	3.6	4.1	4.7	6.8	9.3	5610
40	1.1	1.4	2.1	3.3	3.7	4.4	4.11	5.6	7.6	11.1	4670
60	2.3	2.8	3.3	3.9	4.5	5.8	5.8	6.5	8.11	12.10	4050
80	2.6	3.0	3.5	4.1	4.10	5.7	6.4	7.2	9.11	14.4	3620
100	2.9	3.4	3.11	4.7	5.4	6.2	7.0	7.10	10.11	15.8	3280
120	3.0	3.7	4.4	5.0	5.10	6.8	7.8	8.7	11.11	17.2	3020

**GROUND WIRE  
SAG AND TENSION DATA**

336,400 CM ACSR 26/7 STRANDING  
RATED BREAKING STRENGTH 14,050#, WEIGHT PER FT 0.463#

**HEAVY LOADING DISTRICT (NESC)**

TENSIONS WORKED TO FOLLOWING LIMITS  
AT MAXIMUM LOAD 0°F, 1/2" ICE, 8"/SQ FT WIND 3,750 (26.7% OF ULTIMATE)  
FINAL (AFTER MAXIMUM LOAD) 50°F, NO ICE, NO WIND 1,930 (14.0% OF ULTIMATE)

SAGS BASED ON 4'-6" SAG IN 300 FEET

TEMP °F	SPAN LENGTH										TENSION LBS
	200	220	240	260	280	300	320	340	400	480	
0	1.2	1.5	1.8	2.0	2.4	2.8	3.0	3.5	4.8	6.9	1370
20	1.5	1.9	2.1	2.5	2.10	3.3	3.8	4.2	5.9	8.5	1210
40	1.9	2.1	2.6	2.11	3.5	3.11	4.5	5.0	6.11	9.11	1345
60	2.0	2.5	2.11	3.5	3.11	4.6	5.1	5.9	8.0	11.6	1160
80	2.3	2.9	3.3	3.10	4.5	5.1	5.10	5.8	9.1	13.1	1020
100	2.6	3.1	3.7	4.3	4.11	5.8	6.9	7.3	10.1	14.6	920
120	2.9	3.4	4.0	4.8	5.5	6.5	7.1	8.0	11.0	15.11	840

**INITIAL (STRINGING) SAGS**

TEMP °F	SPAN LENGTH										TENSION LBS
	200	210	240	260	280	300	320	340	400	480	
0	1.1	1.4	1.8	1.10	2.2	2.5	2.9	3.2	4.4	6.3	6300
20	1.4	1.7	1.10	2.2	2.7	2.11	3.4	3.9	5.2	7.6	7080
40	1.6	1.10	2.5	2.7	3.0	3.5	3.11	4.5	6.1	8.9	7830
60	1.9	2.2	2.7	3.0	3.6	4.0	4.7	5.2	7.2	10.3	5075
80	2.0	2.5	2.10	3.4	3.11	4.6	5.1	5.9	8.0	11.6	4575
100	2.2	2.8	3.2	3.9	4.4	5.0	5.7	6.4	8.10	12.8	4085
120	2.4	3.0	3.7	4.2	4.11	5.7	6.4	7.2	10.0	14.4	3670

**INITIAL (STRINGING) SAGS**

TEMP °F	SPAN LENGTH										TENSION LBS
	200	220	240	260	280	300	320	340	400	480	
0	1.0	1.2	1.5	1.7	1.10	2.2	2.5	2.9	3.10	5.6	4425
20	1.2	1.5	1.8	1.11	2.3	2.7	3.0	3.4	4.8	6.8	2710
40	1.5	1.8	2.0	2.4	2.9	3.2	3.7	4.0	5.6	8.0	1570
60	1.8	2.0	2.4	2.10	3.5	3.7	4.3	4.9	6.7	9.6	1400
80	1.11	2.3	2.9	3.5	3.9	4.5	4.10	5.6	7.7	11.0	1215
100	2.2	2.7	3.1	3.8	4.3	4.10	5.4	6.3	8.8	12.8	1070
120	2.5	3.1	3.6	4.1	4.9	5.5	6.2	7.0	9.8	15.11	960

FORMERLY 24207-86

DOES NOT CONTAIN  
CRITICAL ENERGY INFRASTRUCTURE INFORMATION  
DATE OF REVIEW 10/28/2011 BY JR

THE UNITED ILLUMINATING CO  
NEW HAVEN CONN.

WESTPORT TO ASH CREEK-115KV LINE

SAG AND TENSION DATA  
336,400 CM ACSR 26/7 GROUND WIRE  
1,590,000 CM ACSR 45/7 CONDUCTOR

GIBBS & HILL, INC.  
CONSULTING ENGINEERS  
NEW YORK

SCALE NONE  
1704S-26

JOB NO 1704A  
24213-115



SZ-SEQ21

**CONDUCTOR SAG AND TENSION DATA**  
 1,590,000 CM ACSR 45/7 STRANDING  
 RATED BREAKING STRENGTH 42,700<sup>0</sup>, WEIGHT PER FT 1.799<sup>0</sup>  
**HEAVY LOADING DISTRICT (NESC)**  
 TENSIONS WORKED TO THE FOLLOWING LIMITS  
 AT MAXIMUM LOAD, 0°F, 1/2" ICE, 8"/SQ FT WIND - 9640 (22% OF ULTIMATE)  
 FINAL (AFTER MAXIMUM LOAD) 60°F, NO ICE, NO WIND - 4050 (35% OF ULTIMATE)

SAGS BASED ON 2'-0" SAG IN 300 FEET

TEMP °F	FINAL SAGS										TENSION LBS
	SPAN LENGTH										
	200	220	240	260	280	300	320	340	400	480	
0	1'-4"	1'-7"	1'-11"	2'-3"	2'-7"	3'-0"	3'-5"	3'-10"	5'-4"	7'-8"	6760
20	1'-7"	1'-11"	2'-4"	2'-8"	3'-2"	3'-8"	4'-1"	4'-7"	6'-5"	9'-3"	5610
40	1'-11"	2'-4"	2'-9"	3'-3"	3'-9"	4'-4"	4'-11"	5'-6"	7'-8"	11'-1"	4670
60	2'-3"	2'-8"	3'-1"	3'-9"	4'-5"	5'-0"	5'-8"	6'-5"	8'-11"	12'-10"	4050
80	2'-6"	3'-0"	3'-7"	4'-2"	4'-10"	5'-7"	6'-4"	7'-2"	9'-11"	14'-4"	3620
100	2'-9"	3'-4"	3'-1"	4'-7"	5'-4"	6'-2"	7'-0"	7'-10"	10'-11"	15'-8"	3280
120	3'-0"	3'-7"	4'-4"	5'-0"	5'-10"	6'-8"	7'-8"	8'-7"	11'-11"	17'-2"	3020

INITIAL (STRINGING) SAGS

TEMP °F	INITIAL (STRINGING) SAGS										TENSION LBS
	SPAN LENGTH										
	200	220	240	260	280	300	320	340	400	480	
0	1'-1"	1'-4"	1'-8"	1'-10"	2'-2"	2'-5"	2'-9"	3'-2"	4'-4"	6'-3"	8300
20	1'-4"	1'-7"	1'-10"	2'-2"	2'-7"	2'-11"	3'-4"	3'-9"	5'-2"	7'-6"	7000
40	1'-6"	1'-10"	2'-2"	2'-7"	3'-0"	3'-5"	3'-11"	4'-5"	6'-1"	8'-9"	5890
60	1'-9"	2'-2"	2'-7"	3'-0"	3'-6"	4'-0"	4'-7"	5'-2"	7'-2"	10'-3"	5075
80	2'-0"	2'-5"	2'-10"	3'-4"	3'-11"	4'-6"	5'-1"	5'-9"	8'-0"	11'-6"	4575
100	2'-2"	2'-8"	3'-2"	3'-9"	4'-4"	5'-0"	5'-7"	6'-4"	8'-10"	12'-8"	4085
120	2'-6"	3'-0"	3'-7"	4'-2"	4'-11"	5'-7"	6'-4"	7'-2"	10'-0"	14'-4"	3620

**GROUND WIRE SAG AND TENSION DATA**  
 336,400 CM ACSR 26/7 STRANDING  
 RATED BREAKING STRENGTH 14,050<sup>0</sup> WEIGHT PER FT 0.463<sup>0</sup>  
**HEAVY LOADING DISTRICT (NESC)**  
 TENSIONS WORKED TO FOLLOWING LIMITS  
 AT MAXIMUM LOAD, 0°F, 1/2" ICE, 8"/SQ FT WIND - 3750 (27% OF ULTIMATE)  
 FINAL (AFTER MAX LOAD) 60°F, NO ICE, NO WIND - 1970 (14.0% OF ULTIMATE)

SAGS BASED ON 4'-6" SAG IN 300 FEET

TEMP °F	FINAL SAGS										TENSION LBS
	SPAN LENGTH										
	200	220	240	260	280	300	320	340	400	480	
0	1'-2"	1'-5"	1'-8"	2'-0"	2'-4"	2'-8"	3'-0"	3'-5"	4'-8"	6'-9"	1970
20	1'-5"	1'-8"	2'-1"	2'-5"	2'-10"	3'-3"	3'-8"	4'-2"	5'-9"	8'-5"	1610
40	1'-9"	2'-1"	2'-6"	2'-11"	3'-5"	3'-11"	4'-5"	5'-0"	6'-11"	9'-11"	1345
60	2'-0"	2'-5"	2'-11"	3'-5"	3'-11"	4'-6"	5'-1"	5'-9"	8'-0"	11'-6"	1100
80	2'-3"	2'-9"	3'-3"	3'-10"	4'-5"	5'-1"	5'-10"	6'-8"	9'-1"	13'-1"	1020
100	2'-6"	3'-1"	3'-7"	4'-3"	4'-11"	5'-8"	6'-5"	7'-3"	10'-1"	14'-6"	920
120	2'-9"	3'-4"	4'-0"	4'-8"	5'-5"	6'-3"	7'-1"	8'-0"	11'-0"	15'-11"	810

INITIAL (STRINGING) SAGS

TEMP °F	INITIAL (STRINGING) SAGS										TENSION LBS
	SPAN LENGTH										
	200	220	240	260	280	300	320	340	400	480	
0	1'-0"	1'-2"	1'-5"	1'-7"	1'-10"	2'-2"	2'-5"	2'-9"	3'-10"	5'-6"	2425
20	1'-2"	1'-5"	1'-8"	1'-11"	2'-3"	2'-7"	3'-0"	3'-4"	4'-8"	6'-8"	2010
40	1'-5"	1'-8"	2'-0"	2'-4"	2'-9"	3'-2"	3'-7"	4'-0"	5'-6"	8'-0"	1670
60	1'-8"	2'-0"	2'-4"	2'-10"	3'-3"	3'-7"	4'-3"	4'-9"	6'-7"	9'-6"	1410
80	1'-11"	2'-3"	2'-9"	3'-3"	3'-9"	4'-3"	4'-10"	5'-6"	7'-7"	11'-0"	1215
100	2'-2"	2'-7"	3'-1"	3'-8"	4'-3"	4'-10"	5'-6"	6'-8"	8'-8"	12'-8"	1070
120	2'-5"	2'-11"	3'-5"	4'-1"	4'-9"	5'-5"	6'-2"	7'-0"	9'-8"	13'-11"	960

**CONDUCTOR SAG AND TENSION DATA**  
 1,590,000 CM ACSR 45/7 STRANDING  
 RATED BREAKING STRENGTH 42,700<sup>0</sup>, WEIGHT PER FT 1.799<sup>0</sup>  
**HEAVY LOADING DISTRICT (NESC)**  
 TENSIONS WORKED TO THE FOLLOWING LIMITS  
 AT MAXIMUM LOAD, 0°F, 1/2" ICE, 8"/SQ FT WIND - 4870 (11.3% OF ULTIMATE)  
 FINAL (AFTER MAXIMUM LOAD) 60°F, NO ICE, NO WIND - 2025 (4.8% OF ULTIMATE)

SAGS BASED ON 10'-0" SAG IN 300 FEET

TEMP °F	FINAL SAGS			TENSION LBS
	SPAN LENGTH			
	SPAN 2A	SPAN 2B	SPAN 2C	
0	2'-8"	3'-3"	3'-10"	3580
20	3'-3"	3'-11"	4'-8"	2805
40	3'-10"	4'-8"	5'-7"	2335
60	4'-5"	5'-5"	6'-8"	2025
80	5'-0"	6'-0"	7'-2"	1810
100	5'-5"	6'-7"	7'-10"	1640
120	6'-0"	7'-3"	8'-7"	1510

TEMP °F	INITIAL (STRINGING) SAGS			TENSION LBS
	SPAN LENGTH			
	SPAN 2A	SPAN 2B	SPAN 2C	
0	2'-2"	2'-8"	3'-2"	4150
20	2'-7"	3'-1"	3'-9"	3600
40	3'-1"	3'-9"	4'-6"	2915
60	3'-7"	4'-4"	5'-2"	2540
80	4'-0"	4'-9"	6'-0"	2290
100	4'-5"	5'-4"	6'-5"	2045
120	5'-0"	6'-0"	7'-2"	1810

SPAN 'A' - PEQUONNOCK SUB. TO STRUCT BT29 (NORTH CIRCUIT) - LINE 8000A CRT 'B'  
 1/2 TENSIONS (SAG) SPAN 'B' - PEQUONNOCK SUB. TO STRUCT BT70 (SOUTH CIRCUIT) - LINE 8000B CRT 'B'  
 SPAN 'C' - PEQUONNOCK SUB. TO STRUCT BT68A (PEQUONNOCK TO AGHCREEK) - CRT 'H'  
 NOTE: FOR PLAN OF SPANS AT PEQUONNOCK SUBSTA REFER TO Dwg 17035-1 SH. 3

FORMERLY 24201A-27 SH. 2 OF 2

THE UNITED ILLUMINATING CO.  
 NEW HAVEN, CONN.

ASH CREEK TO PEQUONNOCK-15KV LINE

**SAG AND TENSION DATA**  
 336,400 CM ACSR, 26/7 GROUND WIRE  
 1,590,000 CM ACSR, 45/7 CONDUCTOR

GIBBS & HILL, INC.  
 CONSULTING ENGINEERS  
 NEW YORK  
 JOB NO. 1703A

SCALE NONE

17035-25-2


DOES NOT CONTAIN  
 CRITICAL ENERGY INFRASTRUCTURE INFORMATION  
 DATE OF REVIEW: 10/26/2011 BY: AR

NO.	DATE	BY	CHKD	APP	REVISION
3	7/1/06	LS	MB	JE	REMARKS DRAWING
2	7/1/04	RM	DL	JE	REVISIONS TO BE MADE FOR APPROVED
1	9/16/04	MB	DL	JE	CONSTRUCTION

## **Attachment B**

*PEA*

**Skylite**

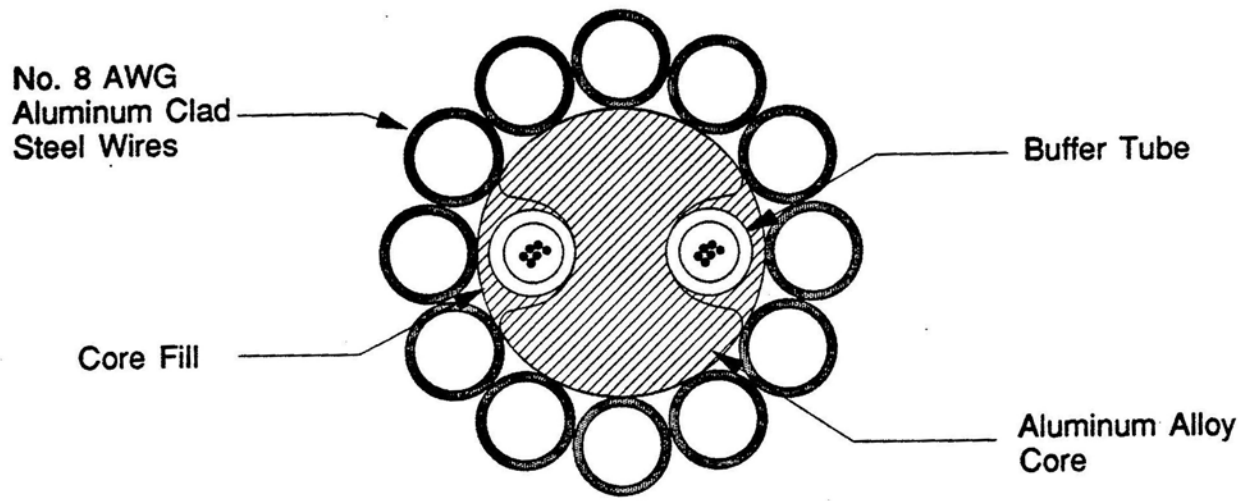

**SPECIFICATIONS:**

Overall Diameter:	0.635"
Stranding:	12 No. 8 AWG (0.1285") A.C.S. Wires
Rated Breaking Strength:	27,300 lbs
Rated Fault Current:	160 (Ka) sq - sec
Weight:	0.563 lb/ft
Modulus of Elasticity:	18.99 E 6 psi
Coefficient of Linear Expansion:	8.18 E -6 /deg F
Cross Sectional Area:	0.234 sq in
Nominal D.C. Resistance:	0.12 ohm/Kft @ 20 deg C
Fiber Count:	2 - 24

PROPOSAL FORM

(Each Bidder to supply following information)

Nominal Size of OPGW		0.635"
<hr/>		
Construction of OPGW		
Aluminum clad steel strands number/guage no dia. <u>12</u> No. <u>8</u> (each <u>  </u> in)		
Aluminum pipe/central - OD/ID		
<hr/>		
Lay direction of outermost layer		left-hand
<hr/>		
Rated Breaking Strength	(lbs.)	27,300
<hr/>		
Sectional Area	(in. <sup>2</sup> )	
Aluminum clad steel wire		0.156 in. <sup>2</sup>
Aluminum pipe/central core		0.078 in. <sup>2</sup>
Total		
<hr/>		
Approximate O.D. OPGW	(in.)	0.635"
<hr/>		
Approximate Weight	(lbs./mile)	2,973
<hr/>		
Modulus of elasticity	(ksi)	18.99 x 10 <sup>6</sup> psi
<hr/>		
Coefficient of linear expansion	(1/°C)	14.72 x 10 <sup>-6</sup>
<hr/>		
Reel size and type		60" wooden N.R.
Maximum reel length		4.4 km Dampφ = 2.8"
Minimum reel length		
<hr/>		
Rated Fault Current	(kA <sup>2</sup> sec)	160
<hr/>		
DC Resistance	(ohm/mi)	0.6336

SPECIFICATION T91-19  
 SCHEDULE E  
 FIBER OPTIC SHIELD WIRE INSTALLATION SAG/  
 TENSION

ALUMINUM COMPANY OF AMERICA SAG AND TENSION DATA

NORTHEAST UTILITIES SERVICE COMPANY  
 0.635" OPGW

AREA= .2300 SQ. IN.  
 DATA FROM CHART NO. 1-1830 (NEW CHART # 1-6350)  
 ENGLISH UNITS


SPAN= 315.0 FEET HEAVY LOADING  
 CREEP IS NOT A FACTOR  
 DESIGN CONDITION

DESIGN POINTS				FINAL		INITIAL		
TEMP	ICE	WIND	K	WEIGHT	SAG	TENSION	SAG	TENSION
F	IN	PSF	LB/F	LB/F	FT	LB	FT	LB
0.	.50	4.00	.30	1.681	5.50	3800.*	5.26	3968.
30.	1.50	.00	.00	4.547	8.13	6961.	8.13	6961. 25%
30.	1.00	.00	.00	2.597	6.83	4725.	6.69	4829.
32.	.50	.00	.00	1.269	5.56	2836.	5.23	3015.
60.	.00	20.00	.00	1.199	5.99	2489.	5.62	2648.
60.	.00	16.00	.00	1.017	5.77	2191.	5.36	2357.
80.	.00	.00	.00	.563	3.22	2166.	2.77	2518.
90.	.00	.00	.00	.563	3.70	1890.	3.18	2195.
90.	.00	.00	.00	.563	4.42	1583.	3.85	1815.
120.	.00	.00	.00	.563	5.11	1368.	4.53	1542.
120.	.00	.00	.00	.563	5.77	1213.	5.20	1345.
167.	.00	.00	.00	.563	6.38	1096.	5.84	1199.
167.	.00	.00	.00	.563	7.27	963.	6.76	1036.
212.	.00	.00	.00	.563	8.05	870.	7.57	925.

SPAN= 650.0 FEET HEAVY LOADING  
 CREEP IS NOT A FACTOR  
 DESIGN CONDITION

DESIGN POINTS				FINAL		INITIAL		
TEMP	ICE	WIND	K	WEIGHT	SAG	TENSION	SAG	TENSION
F	IN	PSF	LB/F	LB/F	FT	LB	FT	LB
0.	.50	4.00	.30	1.681	23.53	3800.*	22.95	3894.
30.	1.50	.00	.00	4.547	27.79	8725.	27.79	8725. 32%
30.	1.00	.00	.00	2.597	25.49	5424.	25.12	5503.
32.	.50	.00	.00	1.269	23.61	2859.	22.92	2944.
60.	.00	20.00	.00	1.199	24.15	2641.	23.44	2719.
60.	.00	16.00	.00	1.017	23.86	2267.	23.10	2340.
-20.	.00	.00	.00	.563	21.01	1423.	20.01	1493.
0.	.00	.00	.00	.563	21.55	1388.	20.57	1454.
20.	.00	.00	.00	.563	22.33	1340.	21.37	1399.
20.	.00	.00	.00	.563	23.10	1296.	22.16	1350.
40.	.00	.00	.00	.563	23.84	1256.	22.92	1306.
120.	.00	.00	.00	.563	24.56	1220.	23.66	1265.
167.	.00	.00	.00	.563	25.66	1169.	24.79	1209.
212.	.00	.00	.00	.563	26.67	1125.	25.82	1161.

**Attachment C**

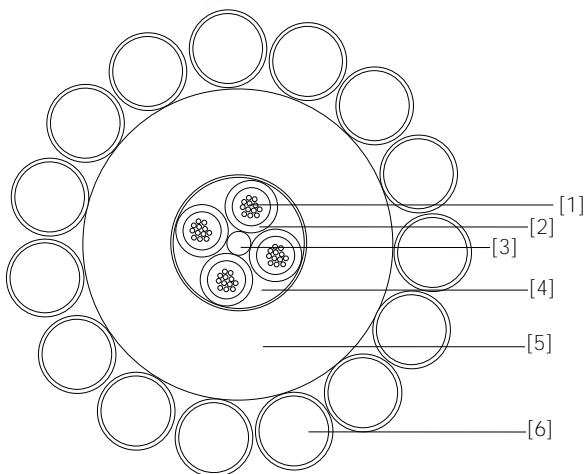

## Cable structure

### Optical core

- [1] Optical fibres
- [2] PBT loose buffer tubes.  $\text{Ø} = 0.098$  in
- [3] Pultruded threaded glass rod
- [4] Hydrogen absorbent jelly

### Aluminium Tube

- [5]  $\text{Ø} = 0.433$  in

### Armour

#### Layer 1 (S):

- [6] 15 ACS 20.3% IACS  $\text{Ø} 0.1071$  in

In areas where there is a high contamination or in the proximity of the sea, Prysmian recommend greasing the cable.

## Features and benefits

This cable has been custom designed to best match with customer requirements from optical, electrical, mechanical, quality and cost point of view, optimising diameter, weight, breaking load and short circuit capacity.

## Cable characteristics

### Mechanical and physical

Approximate cable diameter:	0.647 in
Approximate cable weight:	0.524 lb/ft
Rated tensile strength:	25000 lbf
Maximum cable design tension:	20000 lbf
Elasticity Modulus*:	16549 kpsi
Section*:	0.223 in <sup>2</sup>
Linear expansion thermal coefficient:	8.11x10 <sup>-6</sup> °F <sup>-1</sup>
Minimum bending radius:	
On pulley blocks (first and last of each reel, span $\geq 600$ m or angles $> 15^\circ$ ):	15.75 in
On pulley blocks (others):	11.81 in
On tensioner devices:	<b>25.59</b> in
After clamping (slack cable):	11.81 in
Operating temperature range:	from -40°F to +176°F

\*for stress-strain calculus

\*\*see "Installation procedures for OPGW fibre optic cable" document reference SIG-07-PE-PA-013

### Electrical

Short circuit rating from 40°C:	153.8 kA <sup>2</sup> s
Short circuit current for 1 s:	12.4 kA
Geometric Mean Radius:	0.233 in
DC Resistance at 20°C:	0.56 $\Omega$ /mil
DC Resistance at 25°C:	0.57 $\Omega$ /mil
DC Resistance at 50°C:	0.63 $\Omega$ /mil
DC Resistance at 75°C:	0.68 $\Omega$ /mil
AC Resistance at 20°C:	0.57 $\Omega$ /mil
AC Resistance at 25°C:	0.58 $\Omega$ /mil
AC Resistance at 50°C:	0.64 $\Omega$ /mil
AC Resistance at 75°C:	0.70 $\Omega$ /mil
60 Hz Inductive Reactance (1 ft):	0.48 $\Omega$ /mil

PLSCADD coefficients (American units)

A0	A1	A2	A3	A4
9.46	158319	40992	-172929	85240
-144.65	124843	65318	-142293	57290



## Fiber identification

No.	1	2	3	4	5	6
Color	Blue	Orange	Green	Brown	Slate	White
No.	7	8	9	10	11	12
Color	Red	Black	Yellow	Violet	Pink	Aqua

## Tube identification

No.	1	2	3	4
Color	Blue	Orange	Green	Brown

48 G.652D:

Fiber G.652D: Tubes #1, #2, #3 and #4

24G.655 + 24 G.652D:

Fiber G.655: Tubes #1 and #2

Fiber G.652D: Tubes #3 and #4

## Fibre characteristics

Fiber manufacturer: FOS (Prysmian Group)

According to ITU-T G.652D or ITU-T G.655

### ITU-T G.652D

<b>Attenuation coefficients (uncabled)</b>	
at 1310 nm	≤ 0.35 dB/km
at 1385 nm	≤ 0.35 dB/km
at 1550 nm	≤ 0.20 dB/km
at 1625 nm	≤ 0.23 dB/km
<b>Mode Field Diameter</b>	
at1310 nm	9.2 ± 0.4 μm
at1550 nm	10.4 ± 0.5 μm
<b>Geometrical properties</b>	
Cladding diameter	125 ± 7 μm
Cladding non-circularity	≤1 %
Core – cladding concentricity error	≤0.6 μm
Coating diameter	245 ± 5 μm
Coating – cladding concentricity error	≤12 μm
<b>Dispersion coefficients</b>	
from 1285 to 1330 nm	≤ 3.5 ps/(nm·km)
at 1550 nm	≤ 18 ps/(nm·km)
<b>Cable Cut-off</b>	
Cable Cut-off	<1260 λ <sub>c</sub> nm
Zero dispersion wavelength	1302 – 1322 nm

### ITU-T G.655

<b>Attenuation coefficients (uncabled)</b>	
at 1550 nm	≤ 0.23 dB/km
at 1625 nm	≤ 0.25 dB/km
<b>Mode Field Diameter</b>	
at1550 nm	9.6 ± 0.4 μm
<b>Geometrical properties</b>	
Cladding diameter	125 ± 0.7 μm
Cladding non-circularity	≤1 %
Core – cladding concentricity error	≤0.5 μm
Coating diameter	245 ± 5 μm
Coating – cladding concentricity error	≤10 μm
<b>Dispersion coefficients</b>	
from 1530 to 1565 nm	2.0÷6.0 ps/(nm·km)
In the range 1565-1625 nm	4.5÷11.2 ps/(nm·km)
<b>Cable Cut-off</b>	
Cable Cut-off	<1450 λ <sub>c</sub> nm

## Routine tests

100% of optical fibres will be measured by OTDR technique before leaving factory.

## Installation procedure

Prysmian recommends to install the cable described in this specification following the latest version of our "Installation procedures for OPGW fibre optic cable" reference SIG-07-PE-PA-013, "Instruction for the installation of the EWMJ joint box" reference SIG-07-PE-PA-015 and "Instruction for the installation of the EWJ joint box" reference SIG-07-PE-PA-008.

## Reels


	Type N	Type P
Wheel (A):	66.9 in	82.7 in
Cylinder (B):	35.4 in	35.4 in
Inside (C):	35.4 in	35.4 in
Outside (D):	41.3 in	41.3 in
Axe (H):	4.13 in	4.13 in
Weight:		
- empty:	604 lb	877 lb
- full:	7826 lb	13087 lb
Maximum length:	13780 ft	23290 ft
Tolerance length of the produced reel: $\pm 3\%$		

### NOTE:

Ordered lengths should include a distribution of lengths, i.e., all reels cannot be ordered at the maximum.

**The reel lengths' distribution should be as follows:**

Reel lengths	
0 - 8200	More than 5%
8200 - 14800	More than 30%
14800 - 19700	Less than 55%
> 19700	Less than 10%

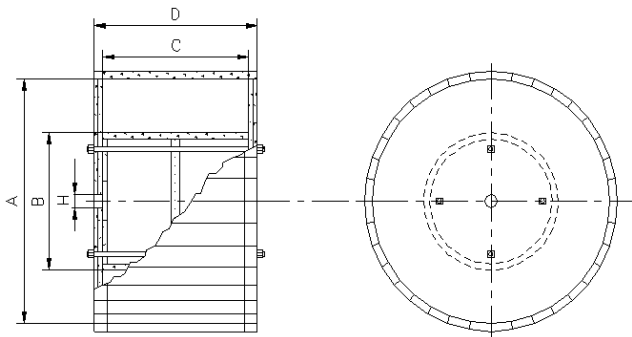

**Attachment D**

PRYSMIAN (New OPGW)				
Str No	Load Case Description	Horizontal Load (lb/ft)	Vertical Load (lb/ft)	Horizontal Tension (lb)
GDI_0002	NESC Heavy NA+	1.37	1.85	5613
B768A	NESC Heavy NA+	2.74	3.7	290
B767N	NESC Heavy NA+	2.74	3.7	56
B766N	NESC Heavy NA+	2.74	3.7	7
B765CN	NESC Heavy NA+	2.74	3.7	8
B765BN	NESC Heavy NA+	2.74	3.7	4
B765AN	NESC Heavy NA+	2.74	3.7	14
B765N	NESC Heavy NA+	2.74	3.7	0
B764N	NESC Heavy NA+	2.74	3.7	0
B763N	NESC Heavy NA+	2.74	3.7	172
B762N	NESC Heavy NA+	2.74	3.7	128
B761N	NESC Heavy NA+	2.74	3.7	385
B760N	NESC Heavy NA+	2.74	3.7	0
B759N	NESC Heavy NA+	2.74	3.7	2
B758N	NESC Heavy NA+	2.74	3.7	1
B757N	NESC Heavy NA+	2.74	3.7	458
TP756N	NESC Heavy NA+	2.74	3.7	136
TP754N	NESC Heavy NA+	2.74	3.7	245
B753N	NESC Heavy NA+	2.74	3.7	241
B752N	NESC Heavy NA+	2.74	3.7	2
B751N	NESC Heavy NA+	2.74	3.7	0
B750N	NESC Heavy NA+	2.74	3.7	0
B749N	NESC Heavy NA+	2.74	3.7	3
B748N	NESC Heavy NA+	2.74	3.7	1
B747N	NESC Heavy NA+	2.74	3.7	2
B746N	NESC Heavy NA+	2.74	3.7	1
B745N	NESC Heavy NA+	2.74	3.7	3
B744N	NESC Heavy NA+	2.74	3.7	4
B743N	NESC Heavy NA+	2.74	3.7	1
B742N	NESC Heavy NA+	2.74	3.7	1
B741N	NESC Heavy NA+	2.74	3.7	1
B740N	NESC Heavy NA+	2.74	3.7	1
B739N	NESC Heavy NA+	2.74	3.7	495
GDI_0035	NESC Heavy NA+	2.74	3.7	115
B738N	NESC Heavy NA+	2.74	3.7	292
B737N	NESC Heavy NA+	2.74	3.7	235
736EN	NESC Heavy NA+	2.74	3.7	444
TP735N	NESC Heavy NA+	2.74	3.7	88
TP734N	NESC Heavy NA+	2.74	3.7	166
733WN	NESC Heavy NA+	2.74	3.7	263
732WN	NESC Heavy NA+	2.74	3.7	140

FOCUS (Existing OPGW)				
Str No	Load Case Description	Horizontal Load (lb/ft)	Vertical Load (lb/ft)	Horizontal Tension (lb)
GDI_0002	NESC Heavy NA+	1.36	1.9	8634
B768A	NESC Heavy NA+	2.72	3.8	1893
B767N	NESC Heavy NA+	2.72	3.8	376
B766N	NESC Heavy NA+	2.72	3.8	186
B765CN	NESC Heavy NA+	2.72	3.8	1501
B765BN	NESC Heavy NA+	2.72	3.8	140
B765AN	NESC Heavy NA+	2.72	3.8	295
B765N	NESC Heavy NA+	2.72	3.8	423
B764N	NESC Heavy NA+	2.72	3.8	732
B763N	NESC Heavy NA+	2.72	3.8	401
B762N	NESC Heavy NA+	2.72	3.8	1099
B761N	NESC Heavy NA+	2.72	3.8	1948
B760N	NESC Heavy NA+	2.72	3.8	59
B759N	NESC Heavy NA+	2.72	3.8	39
B758N	NESC Heavy NA+	2.72	3.8	169
B757N	NESC Heavy NA+	2.72	3.8	3686
TP756N	NESC Heavy NA+	2.72	3.8	6466
TP754N	NESC Heavy NA+	2.72	3.8	3557
B753N	NESC Heavy NA+	2.72	3.8	1266
B752N	NESC Heavy NA+	2.72	3.8	222
B751N	NESC Heavy NA+	2.72	3.8	727
B750N	NESC Heavy NA+	2.72	3.8	40
B749N	NESC Heavy NA+	2.72	3.8	162
B748N	NESC Heavy NA+	2.72	3.8	269
B747N	NESC Heavy NA+	2.72	3.8	56
B746N	NESC Heavy NA+	2.72	3.8	354
B745N	NESC Heavy NA+	2.72	3.8	1364
B744N	NESC Heavy NA+	2.72	3.8	413
B743N	NESC Heavy NA+	2.72	3.8	326
B742N	NESC Heavy NA+	2.72	3.8	161
B741N	NESC Heavy NA+	2.72	3.8	9
B740N	NESC Heavy NA+	2.72	3.8	29
B739N	NESC Heavy NA+	2.72	3.8	356
GDI_0035	NESC Heavy NA+	2.72	3.8	669
B738N	NESC Heavy NA+	2.72	3.8	45
B737N	NESC Heavy NA+	2.72	3.8	658
736EN	NESC Heavy NA+	2.72	3.8	441
TP735N	NESC Heavy NA+	2.72	3.8	1245
TP734N	NESC Heavy NA+	2.72	3.8	1466
733WN	NESC Heavy NA+	2.72	3.8	1085
732WN	NESC Heavy NA+	2.72	3.8	949

Pertcent Change Horizontal Load	Pertcent Change Vertical Load	Change is Tension (lb)
1%	-3%	-3021
1%	-3%	-1603
1%	-3%	-320
1%	-3%	-179
1%	-3%	-1493
1%	-3%	-136
1%	-3%	-281
1%	-3%	-423
1%	-3%	-732
1%	-3%	-229
1%	-3%	-971
1%	-3%	-1563
1%	-3%	-59
1%	-3%	-37
1%	-3%	-168
1%	-3%	-3228
1%	-3%	-6330
1%	-3%	-3312
1%	-3%	-1025
1%	-3%	-220
1%	-3%	-727
1%	-3%	-40
1%	-3%	-159
1%	-3%	-268
1%	-3%	-54
1%	-3%	-353
1%	-3%	-1361
1%	-3%	-409
1%	-3%	-325
1%	-3%	-160
1%	-3%	-8
1%	-3%	-28
1%	-3%	139
1%	-3%	-554
1%	-3%	247
1%	-3%	-423
1%	-3%	3
1%	-3%	-1157
1%	-3%	-1300
1%	-3%	-822
1%	-3%	-809

PRYSMIAN (New OPGW)				
Str No	Load Case Description	Horizontal Load (lb/ft)	Vertical Load (lb/ft)	Horizontal Tension (lb)
731WN	NESC Heavy NA+	2.74	3.7	125
730EN	NESC Heavy NA+	2.74	3.7	236
729WN	NESC Heavy NA+	2.74	3.7	108
728WN	NESC Heavy NA+	2.74	3.7	7
727WN	NESC Heavy NA+	2.74	3.7	2
726WN	NESC Heavy NA+	2.74	3.7	0
725WN	NESC Heavy NA+	2.74	3.7	1
724WN	NESC Heavy NA+	2.74	3.7	22
723WN	NESC Heavy NA+	2.74	3.7	25
722WN	NESC Heavy NA+	2.74	3.7	58
721EN	NESC Heavy NA+	2.74	3.7	93
720EN	NESC Heavy NA+	2.74	3.7	83
719WN	NESC Heavy NA+	2.74	3.7	95
718WN	NESC Heavy NA+	2.74	3.7	4
717WN	NESC Heavy NA+	2.74	3.7	2
716WN	NESC Heavy NA+	2.74	3.7	1
715WN	NESC Heavy NA+	2.74	3.7	3
714WN	NESC Heavy NA+	2.74	3.7	31
713WN	NESC Heavy NA+	2.74	3.7	12
712WN	NESC Heavy NA+	2.74	3.7	30
711WN	NESC Heavy NA+	2.74	3.7	86
710EN	NESC Heavy NA+	2.74	3.7	38
709EN	NESC Heavy NA+	2.74	3.7	107
708WN	NESC Heavy NA+	2.74	3.7	51
TP707WN	NESC Heavy NA+	2.74	3.7	717
TP706EN	NESC Heavy NA+	2.74	3.7	690
705EN	NESC Heavy NA+	2.74	3.7	19
704WN	NESC Heavy NA+	2.74	3.7	37
703WN	NESC Heavy NA+	2.74	3.7	5
702WN	NESC Heavy NA+	2.74	3.7	3
701WN	NESC Heavy NA+	2.74	3.7	0
700WN	NESC Heavy NA+	2.74	3.7	0
699WN	NESC Heavy NA+	2.74	3.7	0
698WN	NESC Heavy NA+	2.74	3.7	3
697WN	NESC Heavy NA+	2.74	3.7	6
696WN	NESC Heavy NA+	2.74	3.7	1
695WN	NESC Heavy NA+	2.74	3.7	4
694WN	NESC Heavy NA+	2.74	3.7	0
693WN	NESC Heavy NA+	2.74	3.7	0
692WN	NESC Heavy NA+	2.74	3.7	2
691WN	NESC Heavy NA+	2.74	3.7	1

FOCUS (Existing OPGW)				
Str No	Load Case Description	Horizontal Load (lb/ft)	Vertical Load (lb/ft)	Horizontal Tension (lb)
731WN	NESC Heavy NA+	2.72	3.8	56
730EN	NESC Heavy NA+	2.72	3.8	165
729WN	NESC Heavy NA+	2.72	3.8	108
728WN	NESC Heavy NA+	2.72	3.8	298
727WN	NESC Heavy NA+	2.72	3.8	577
726WN	NESC Heavy NA+	2.72	3.8	53
725WN	NESC Heavy NA+	2.72	3.8	267
724WN	NESC Heavy NA+	2.72	3.8	187
723WN	NESC Heavy NA+	2.72	3.8	254
722WN	NESC Heavy NA+	2.72	3.8	250
721EN	NESC Heavy NA+	2.72	3.8	30
720EN	NESC Heavy NA+	2.72	3.8	233
719WN	NESC Heavy NA+	2.72	3.8	394
718WN	NESC Heavy NA+	2.72	3.8	598
717WN	NESC Heavy NA+	2.72	3.8	117
716WN	NESC Heavy NA+	2.72	3.8	170
715WN	NESC Heavy NA+	2.72	3.8	946
714WN	NESC Heavy NA+	2.72	3.8	1851
713WN	NESC Heavy NA+	2.72	3.8	91
712WN	NESC Heavy NA+	2.72	3.8	16
711WN	NESC Heavy NA+	2.72	3.8	43
710EN	NESC Heavy NA+	2.72	3.8	88
709EN	NESC Heavy NA+	2.72	3.8	58
708WN	NESC Heavy NA+	2.72	3.8	144
TP707WN	NESC Heavy NA+	2.72	3.8	119
TP706EN	NESC Heavy NA+	2.72	3.8	156
705EN	NESC Heavy NA+	2.72	3.8	198
704WN	NESC Heavy NA+	2.72	3.8	624
703WN	NESC Heavy NA+	2.72	3.8	18
702WN	NESC Heavy NA+	2.72	3.8	36
701WN	NESC Heavy NA+	2.72	3.8	144
700WN	NESC Heavy NA+	2.72	3.8	1
699WN	NESC Heavy NA+	2.72	3.8	207
698WN	NESC Heavy NA+	2.72	3.8	12
697WN	NESC Heavy NA+	2.72	3.8	213
696WN	NESC Heavy NA+	2.72	3.8	264
695WN	NESC Heavy NA+	2.72	3.8	3
694WN	NESC Heavy NA+	2.72	3.8	14
693WN	NESC Heavy NA+	2.72	3.8	144
692WN	NESC Heavy NA+	2.72	3.8	82
691WN	NESC Heavy NA+	2.72	3.8	76

Pertcent Change Horizontal Load	Pertcent Change Vertical Load	Change is Tension (lb)
1%	-3%	69
1%	-3%	71
1%	-3%	0
1%	-3%	-291
1%	-3%	-575
1%	-3%	-53
1%	-3%	-266
1%	-3%	-165
1%	-3%	-229
1%	-3%	-192
1%	-3%	63
1%	-3%	-150
1%	-3%	-299
1%	-3%	-594
1%	-3%	-115
1%	-3%	-169
1%	-3%	-943
1%	-3%	-1820
1%	-3%	-79
1%	-3%	14
1%	-3%	43
1%	-3%	-50
1%	-3%	49
1%	-3%	-93
1%	-3%	598
1%	-3%	534
1%	-3%	-179
1%	-3%	-587
1%	-3%	-13
1%	-3%	-33
1%	-3%	-144
1%	-3%	-1
1%	-3%	-207
1%	-3%	-9
1%	-3%	-207
1%	-3%	-263
1%	-3%	1
1%	-3%	-14
1%	-3%	-144
1%	-3%	-80
1%	-3%	-75

PRYSMIAN (New OPGW)				
Str No	Load Case Description	Horizontal Load (lb/ft)	Vertical Load (lb/ft)	Horizontal Tension (lb)
690WN	NESC Heavy NA+	2.74	3.7	1
689WN	NESC Heavy NA+	2.74	3.7	27
688EN	NESC Heavy NA+	2.74	3.7	12
687WN	NESC Heavy NA+	2.74	3.7	94
686WN	NESC Heavy NA+	2.74	3.7	6
685WN	NESC Heavy NA+	2.74	3.7	6
684WN	NESC Heavy NA+	2.74	3.7	2
683WN	NESC Heavy NA+	2.74	3.7	65
682WN	NESC Heavy NA+	2.74	3.7	2
681WN	NESC Heavy NA+	2.74	3.7	3
GDI_0094	NESC Heavy NA+	2.74	3.7	4
679WN	NESC Heavy NA+	2.74	3.7	129
678EN	NESC Heavy NA+	2.74	3.7	240
677WN	NESC Heavy NA+	2.74	3.7	112
676WN	NESC Heavy NA+	2.74	3.7	1
675WN	NESC Heavy NA+	2.74	3.7	1
674WN	NESC Heavy NA+	2.74	3.7	1
673WN	NESC Heavy NA+	2.74	3.7	1
672WN	NESC Heavy NA+	2.74	3.7	2
671WN	NESC Heavy NA+	2.74	3.7	14
670WN	NESC Heavy NA+	2.74	3.7	1
669WN	NESC Heavy NA+	2.74	3.7	164
668EN	NESC Heavy NA+	2.74	3.7	210
667WN	NESC Heavy NA+	2.74	3.7	211
TP667WN	NESC Heavy NA+	2.74	3.7	22
TP665EN	NESC Heavy NA+	2.74	3.7	55
665WN	NESC Heavy NA+	2.74	3.7	91
664WN	NESC Heavy NA+	2.74	3.7	1
663WN	NESC Heavy NA+	2.74	3.7	1
662WN	NESC Heavy NA+	2.74	3.7	6
661WN	NESC Heavy NA+	2.74	3.7	95
660EN	NESC Heavy NA+	2.74	3.7	91
659EN	NESC Heavy NA+	2.74	3.7	63
658WN	NESC Heavy NA+	2.74	3.7	42
657WN	NESC Heavy NA+	2.74	3.7	4
656WN	NESC Heavy NA+	2.74	3.7	85
655EN	NESC Heavy NA+	2.74	3.7	275
GDI_0121	NESC Heavy NA+	2.74	3.7	3
GDI_0122	NESC Heavy NA+	2.74	3.7	4
654WN	NESC Heavy NA+	2.74	3.7	390
653WN	NESC Heavy NA+	2.74	3.7	13

FOCUS (Existing OPGW)				
Str No	Load Case Description	Horizontal Load (lb/ft)	Vertical Load (lb/ft)	Horizontal Tension (lb)
690WN	NESC Heavy NA+	2.72	3.8	118
689WN	NESC Heavy NA+	2.72	3.8	67
688EN	NESC Heavy NA+	2.72	3.8	196
687WN	NESC Heavy NA+	2.72	3.8	169
686WN	NESC Heavy NA+	2.72	3.8	9
685WN	NESC Heavy NA+	2.72	3.8	384
684WN	NESC Heavy NA+	2.72	3.8	453
683WN	NESC Heavy NA+	2.72	3.8	884
682WN	NESC Heavy NA+	2.72	3.8	57
681WN	NESC Heavy NA+	2.72	3.8	26
GDI_0094	NESC Heavy NA+	2.72	3.8	112
679WN	NESC Heavy NA+	2.72	3.8	60
678EN	NESC Heavy NA+	2.72	3.8	156
677WN	NESC Heavy NA+	2.72	3.8	121
676WN	NESC Heavy NA+	2.72	3.8	45
675WN	NESC Heavy NA+	2.72	3.8	124
674WN	NESC Heavy NA+	2.72	3.8	52
673WN	NESC Heavy NA+	2.72	3.8	5
672WN	NESC Heavy NA+	2.72	3.8	56
671WN	NESC Heavy NA+	2.72	3.8	328
670WN	NESC Heavy NA+	2.72	3.8	219
669WN	NESC Heavy NA+	2.72	3.8	146
668EN	NESC Heavy NA+	2.72	3.8	400
667WN	NESC Heavy NA+	2.72	3.8	152
TP667WN	NESC Heavy NA+	2.72	3.8	121
TP665EN	NESC Heavy NA+	2.72	3.8	266
665WN	NESC Heavy NA+	2.72	3.8	506
664WN	NESC Heavy NA+	2.72	3.8	58
663WN	NESC Heavy NA+	2.72	3.8	129
662WN	NESC Heavy NA+	2.72	3.8	168
661WN	NESC Heavy NA+	2.72	3.8	199
660EN	NESC Heavy NA+	2.72	3.8	275
659EN	NESC Heavy NA+	2.72	3.8	105
658WN	NESC Heavy NA+	2.72	3.8	275
657WN	NESC Heavy NA+	2.72	3.8	199
656WN	NESC Heavy NA+	2.72	3.8	311
655EN	NESC Heavy NA+	2.72	3.8	594
GDI_0121	NESC Heavy NA+	2.72	3.8	15
GDI_0122	NESC Heavy NA+	2.72	3.8	217
654WN	NESC Heavy NA+	2.72	3.8	551
653WN	NESC Heavy NA+	2.72	3.8	174

Pertcent Change Horizontal Load	Pertcent Change Vertical Load	Change is Tension (lb)
1%	-3%	-117
1%	-3%	-40
1%	-3%	-184
1%	-3%	-75
1%	-3%	-3
1%	-3%	-378
1%	-3%	-451
1%	-3%	-819
1%	-3%	-55
1%	-3%	-23
1%	-3%	-108
1%	-3%	69
1%	-3%	84
1%	-3%	-9
1%	-3%	-44
1%	-3%	-123
1%	-3%	-51
1%	-3%	-4
1%	-3%	-54
1%	-3%	-314
1%	-3%	-218
1%	-3%	18
1%	-3%	-190
1%	-3%	59
1%	-3%	-99
1%	-3%	-211
1%	-3%	-415
1%	-3%	-57
1%	-3%	-128
1%	-3%	-162
1%	-3%	-104
1%	-3%	-184
1%	-3%	-42
1%	-3%	-233
1%	-3%	-195
1%	-3%	-226
1%	-3%	-319
1%	-3%	-12
1%	-3%	-213
1%	-3%	-161
1%	-3%	-161

PRYSMIAN (New OPGW)				
Str No	Load Case Description	Horizontal Load (lb/ft)	Vertical Load (lb/ft)	Horizontal Tension (lb)
652WN	NESC Heavy NA+	2.74	3.7	0
651WN	NESC Heavy NA+	2.74	3.7	1
650WN	NESC Heavy NA+	2.74	3.7	0
649WN	NESC Heavy NA+	2.74	3.7	274
GDI_0129	NESC Heavy NA+	2.74	3.7	45
648WN	NESC Heavy NA+	2.74	3.7	319
647WN	NESC Heavy NA+	2.74	3.7	0
GDI_0710	NESC Heavy NA+	2.74	3.7	1
GDI_0106	NESC Heavy NA+	1.37	1.85	6288

FOCUS (Existing OPGW)				
Str No	Load Case Description	Horizontal Load (lb/ft)	Vertical Load (lb/ft)	Horizontal Tension (lb)
652WN	NESC Heavy NA+	2.72	3.8	23
651WN	NESC Heavy NA+	2.72	3.8	96
650WN	NESC Heavy NA+	2.72	3.8	83
649WN	NESC Heavy NA+	2.72	3.8	437
GDI_0129	NESC Heavy NA+	2.72	3.8	187
648WN	NESC Heavy NA+	2.72	3.8	861
647WN	NESC Heavy NA+	2.72	3.8	32
GDI_0710	NESC Heavy NA+	2.72	3.8	21
GDI_0106	NESC Heavy NA+	1.36	1.9	6505

Pertcent Change Horizontal Load	Pertcent Change Vertical Load	Change is Tension (lb)
1%	-3%	-23
1%	-3%	-95
1%	-3%	-83
1%	-3%	-163
1%	-3%	-142
1%	-3%	-542
1%	-3%	-32
1%	-3%	-20
1%	-3%	-217