

July 12, 2016

Melanie Bachman
Acting Executive Director
Connecticut Siting Council
10 Franklin Square
New Britain, CT 06051

Re: **EM-VER-106-150108 – Cellco Partnership d/b/a Verizon Wireless
170 Ingram Hill Road, Old Saybrook, Connecticut**

Dear Ms. Bachman:

On February 2, 2015, the Siting Council acknowledged receipt of Cellco's notice of intent to modify its telecommunications facility at 170 Ingram Hill Road in Old Saybrook, Connecticut. The modifications involved the replacement of its antennas, the installation of remote radio heads and the installation of a new fiber optic antenna cable.

As required by the Council's approval, attached is a Tower Modification Certification letter confirming that some, but not all, of the approved equipment modifications referenced in the EM-VER-106-150108 Structural Report were completed. Cellco does not intend to complete the remaining approved modifications.

The attached Professional Engineer's Tower Modification Certification letter also confirms that the tower will not exceed 100% of the post-construction structural rating for those Cellco modifications completed. The attached As-Built Equipment Configuration plan will serve as the baseline for all future Cellco facility modifications for its 170 Ingram Hill Road cell site.

Robinson+Cole

Melanie A. Bachman
July 12, 2016
Page 2

Please do not hesitate to contact me if you have any questions.

Sincerely,

A handwritten signature in black ink, appearing to read "Kenneth C. Baldwin". The signature is fluid and cursive, with a long horizontal stroke at the end.

Kenneth C. Baldwin

Attachment

Copy to:

Tim Parks

Carlo F. Centore, PE

June 30, 2016

Mr. Tim Parks

Verizon Wireless

99 East River Drive

East Hartford, Connecticut 06108

Re: Tower Modification Certification

Project: Verizon Old Saybrook
170 Ingham Hill Rd, Old Saybrook, CT

Tower Owner: Crown Castle USA
3530 Torington Way, Suite 300, Charlotte, NC 28277

Engineer: B+T Group
1717 S Boulder, Suite 300, Tulsa, OK

Centek Project No.: 15003.005

CSC Exempt Mod Reference No.: EM-VER-106-150108

Dear Mr. Parks,

We are providing this "Tower Modification Certification" with regard to the structural components at the above referenced project.

The following are the basis for substantiating compliance with the tower modification documents prepared by B+T Group (B+T Group Project Number: 93496.003.01):


- Review of B+T Group Structural Analysis dated 10/22/14.
- Review of B+T Group Tower Modification Drawings dated 09/12/14.
- Review of the Sinnott Gering and Schmitt Towers, Inc. Modification Inspection Report dated 09/01/2015.
- Field observations by Centek Engineering personnel on 02/26/16 of the completed modifications which determined all modifications were installed in general compliance with the recommendations of the structural analysis report prepared by B+T Group on 10/22/2014.

Note: Not all proposed equipment listed in the aforementioned Structural Modification Report was installed. Refer to the As-Built Equipment Sketch (attached) dated 06/30/16. Less equipment was installed then included in the Structural Analysis Report; therefore the tower will not exceed 100 percent of the post construction structural rating. The work under this Contract has been reviewed and found, to the Engineer's best knowledge, information and belief, to be completed in general compliance with the documents referenced above. This certification is not a review of the adequacy or effectiveness of the modification/reinforcement solution.

Sincerely,

Carlo F. Centore, PE
Principal - Structural



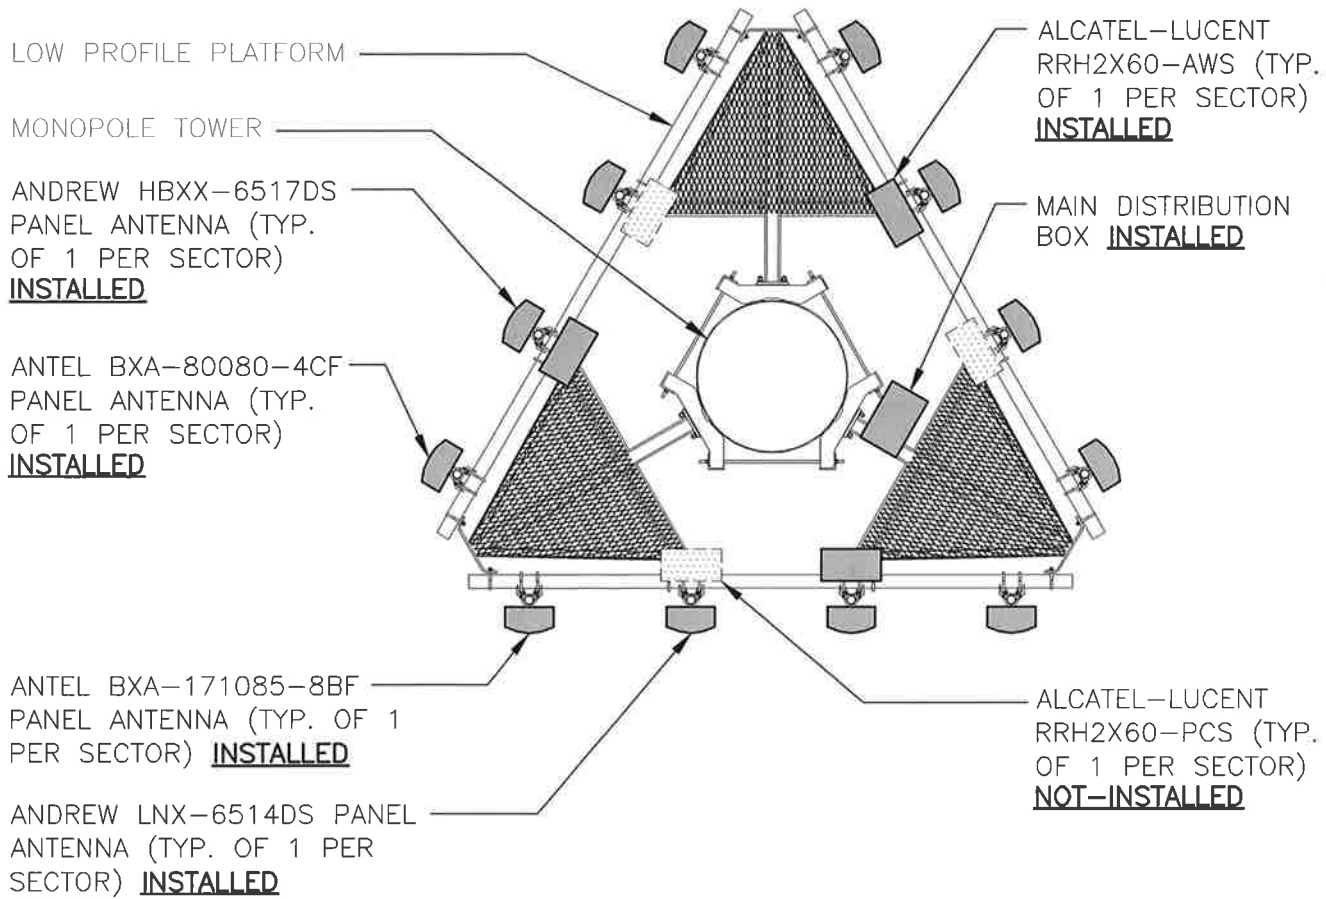

SECTOR	PANEL ANTENNA		REMOTE RADIO HEAD	
	Model	Status	Model	Status
ALPHA	BXA-171085-8BF	INSTALLED	N/A	N/A
	LNX-6514DS	INSTALLED	RRH2X60-PCS	NOT-INSTALLED
	HBXX-6517DS	INSTALLED	RRH2X60-AWS	INSTALLED
	BXA-80080-4CF	INSTALLED	N/A	N/A
BETA	BXA-171085-8BF	INSTALLED	N/A	N/A
	LNX-6514DS	INSTALLED	RRH2X60-PCS	NOT-INSTALLED
	HBXX-6517DS	INSTALLED	RRH2X60-AWS	INSTALLED
	BXA-80080-4CF	INSTALLED	N/A	N/A
GAMMA	BXA-171085-8BF	INSTALLED	N/A	N/A
	LNX-6514DS	INSTALLED	RRH2X60-PCS	NOT-INSTALLED
	HBXX-6517DS	INSTALLED	RRH2X60-AWS	INSTALLED
	BXA-80080-4CF	INSTALLED	N/A	N/A

1
ABSK-1

AS-BUILT EQUIPMENT CONFIGURATION

SCALE: NOT TO SCALE

REVISIONS		
0	6/30/16	AS-BUILT

CEN TEK engineering
Centered on Solutions™
www.CentekEng.com

(203) 488-0580
(203) 488-8587 Fax
63-2 North Branford Road, Branford, CT 06405

OLD SAYBROOK

170 INGHAM HILL ROAD
OLD SAYBROOK, CT 06475

PROJECT NO: 15003.005
DRAWN BY: TJL
CHECKED BY: CFC
SCALE: AS NOTED
DATE: 6/30/16

ABSK-1

DWG. 1 OF 1