

June 9, 2016

Melanie Bachman
Acting Executive Director
Connecticut Siting Council
10 Franklin Square
New Britain, CT 06051

Re: **EM-VER-119-150417 – Cellco Partnership d/b/a Verizon Wireless
699 Old Main Street, Rocky Hill, Connecticut**

Dear Ms. Bachman:

On May 11, 2015, the Siting Council acknowledged receipt of Cellco's notice of intent to modify its telecommunications facility at 699 Old Main Street in Rocky Hill, Connecticut. The modifications involved the replacement of its antennas, the installation of remote radio heads and the installation of a new fiber optic antenna cable.

As required by the Council's approval, attached is a Tower Modification Certification letter confirming that some, but not all, of the approved equipment modifications referenced in the EM-VER-119-150417 Structural Report were completed. Cellco does not intend to complete the remaining approved modifications.

The attached Professional Engineer's Tower Modification Certification letter also confirms that the tower will not exceed 100% of the post-construction structural rating for those Cellco modifications completed. The attached As-Built Equipment Configuration plan will serve as the baseline for all future Cellco facility modifications for its 699 Old Main Street cell site.

Robinson+Cole

Melanie A. Bachman
June 9, 2016
Page 2

Please do not hesitate to contact me if you have any questions.

Sincerely,

A handwritten signature in black ink, appearing to read "Kenneth C. Baldwin". The signature is fluid and cursive, with a long horizontal stroke at the end.

Kenneth C. Baldwin

Attachment

Copy to:

Tim Parks
Carlo F. Centore, PE

June 8, 2016

Mr. Tim Parks

Verizon Wireless
99 East River Drive
East Hartford, Connecticut 06108

Re: Tower Modification Certification

Project: Verizon Rocky Hill East
699 Old Main St. Rocky Hill, CT

Tower Owner: Crown Castle USA
3530 Toringdon Way, Suite 300, Charlotte, NC 28277

Engineer: Paul J. Ford and Company
250 East Broad Street, Columbus, OH

Centek Project No.: 15003.028

CSC Exempt Mod Reference No.: EM-VER-119-150417

Dear Mr. Parks,

We are providing this "Tower Modification Certification" with regard to the structural components at the above referenced project.

The following are the basis for substantiating compliance with the tower modification documents prepared by Paul J. Ford and Company (PJF Project Number: 37515-0126.002.7805):


- Review of the Paul J. Ford and Company Structural Analysis dated 03/18/15.
- Review of Engineered Tower Solutions Modification Inspection Report dated 08/19/15.
- Field observations by Centek Engineering personnel on 03/08/16 of the completed modifications which determined all modifications were installed in general compliance with the recommendations of the structural analysis report prepared by Paul J. Ford and Company on 03/18/15.


Note: Not all proposed equipment listed in the aforementioned Structural Analysis Report was installed. Refer to the As-Built Equipment Sketch (attached) dated 06/06/16. Less equipment was installed than included in the Structural Analysis Report; therefore the tower will not exceed 100 percent of the post construction structural rating. The work under this Contract has been reviewed and found, to the Engineer's best knowledge, information and belief, to be completed in general compliance with the documents referenced above. This certification is not a review of the adequacy or effectiveness of the modification/reinforcement solution.

Sincerely,



Carlo F. Centore, PE
Principal - Structural

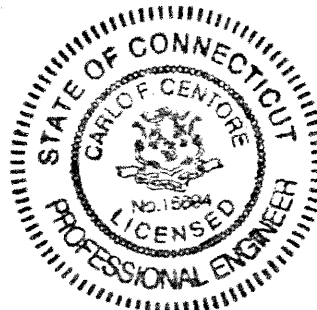

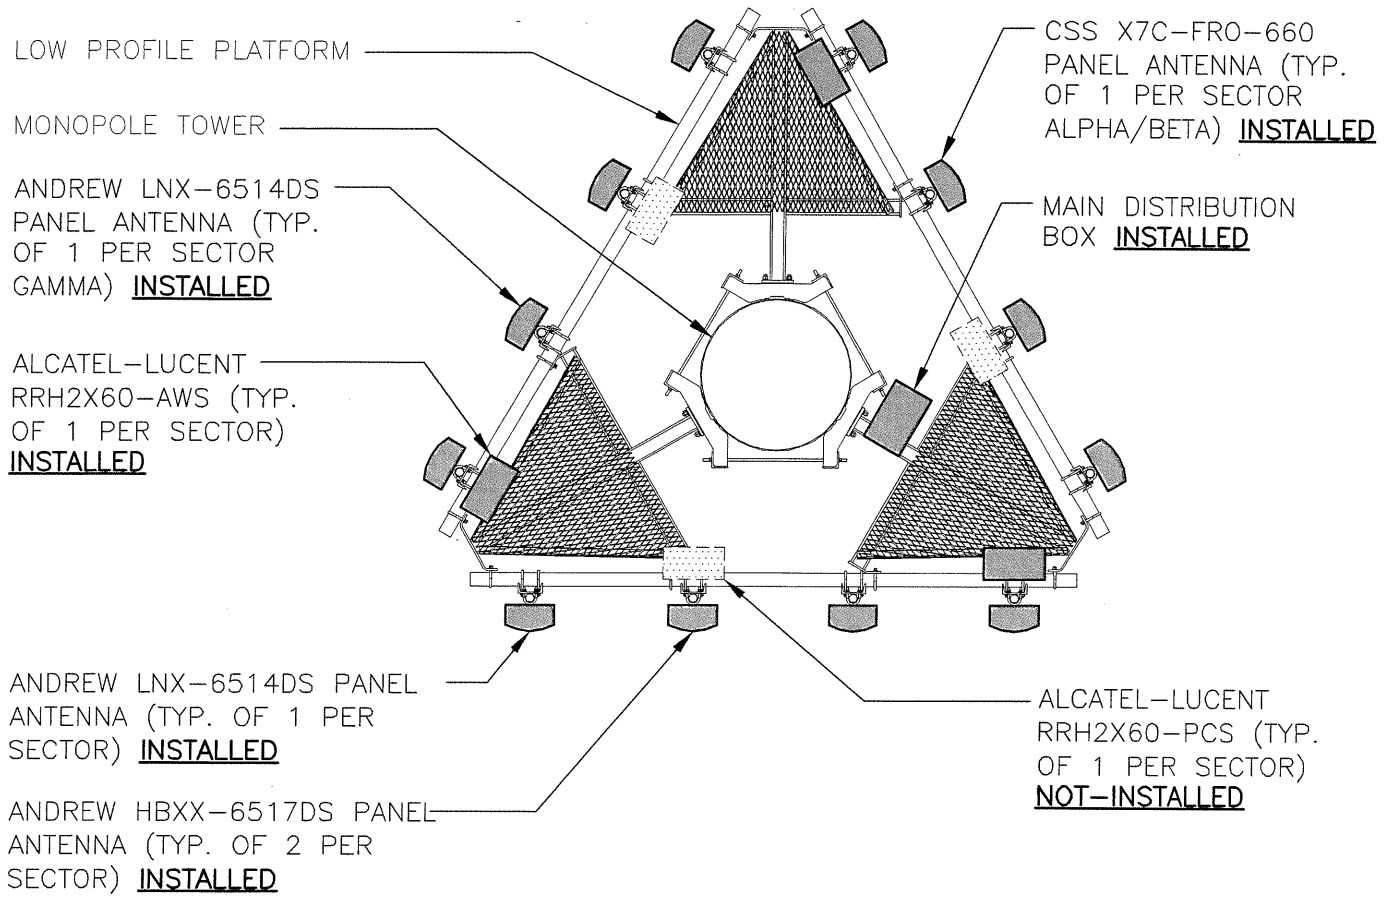

SECTOR	PANEL ANTENNA		REMOTE RADIO HEAD	
	Model	Status	Model	Status
ALPHA	HBXX-6517DS	INSTALLED	RRH2X60-AWS	INSTALLED
	LNX-6514DS	INSTALLED	N/A	N/A
	HBXX-6517DS	INSTALLED	RRH2X60-PCS	NOT-INSTALLED
	X7C-FRO-660	INSTALLED	N/A	N/A
BETA	HBXX-6517DS	INSTALLED	RRH2X60-AWS	INSTALLED
	LNX-6514DS	INSTALLED	N/A	N/A
	HBXX-6517DS	INSTALLED	RRH2X60-PCS	NOT-INSTALLED
	X7C-FRO-660	INSTALLED	N/A	N/A
GAMMA	HBXX-6517DS	INSTALLED	RRH2X60-AWS	INSTALLED
	LNX-6514DS	INSTALLED	N/A	N/A
	HBXX-6517DS	INSTALLED	RRH2X60-PCS	NOT-INSTALLED
	LNX-6514DS	INSTALLED	N/A	N/A

1
ABS-K-1

AS-BUILT EQUIPMENT CONFIGURATION

SCALE: NOT TO SCALE

REVISIONS		
0	6/6/16	AS-BUILT


CEN TEK engineering
Centered on Solutions™
www.CentekEng.com

(203) 488-0580
(203) 488-8587 Fax
63-2 North Branford Road, Branford, CT 06405

ROCKY HILL EAST

699 OLD MAIN STREET
ROCKY HILL, CT 06067

PROJECT NO:	15003.028
DRAWN BY:	TJL
CHECKED BY:	CFC
SCALE:	AS NOTED
DATE:	6/6/16

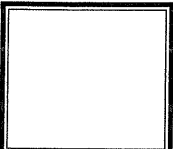

ABS-K-1

DWG. 1 OF 1