

February 14, 2023

Shawn Reed, Chief Building Official
Building Department
Stamford Government Center
888 Washington Boulevard
Stamford, CT 06901

**Construction Closeout Letter
Building Permit #B-22-1135**

ATC Site Name: **Stamford (Katoona)**
ATC Asset#: **88018**
AT&T Site#: **CTLo2135**
Site Address: **168 Catoona Lane**
 Stamford, CT 06902

Dear Mr. Reed,

In accordance with the requirements of the 2018 Connecticut State Building Code, Dewberry Engineers Inc. (Dewberry) reviewed the completed installation at the above location based on Rev-o Construction Drawings dated 07/18/22. A structural analysis report was completed by Airosmith Engineering, dated 11/24/21 and a mount analysis report was completed by American Tower Corporation dated 06/13/22.

Please see the attached reports and documentation for the completed site.

- February 14, 2023 – Contractor Report
- February 8, 2023 – As-Built drawings

Based on visual observations, it appears that the project is constructed in general conformance with the applicable plans and specifications. If you have any questions, please do not hesitate to contact Dewberry Engineers Inc.

Sincerely,
Dewberry Engineers Inc.

Benjamin Revette, P.E.
Associate Vice President



Statement of Special Inspections

Contractor Report #1

Attn: Mr. Blake Paynter
Project Manager
American Tower Corporation
10 Presidential Way
Woburn, MA 01801

ATC Site Name:	Stamford (Katoona)
ATC Site#/Project#:	88018 / 13683396
Site Address:	168 Catoona Lane Stamford, CT 06902
Contractor:	Centerline Communications, LLC

Dewberry Engineers Inc. (Dewberry) has reviewed the photos and as-built drawings provided by the general contractor of the recently completed site improvements at the aforementioned location. The site review was performed based on Rev-0 Construction Drawings dated 07/18/22. A structural analysis report was completed by Airosmith Engineering, dated 11/24/21 and a mount analysis report was completed by American Tower Corporation dated 06/13/22.

The following are on-site photos from the inspection:

Figure 1: View of installed alpha sector antennas and RRUs on existing sector frame

Figure 2: View of installed beta sector antennas and RRUs on existing sector frame

Figure 3: View of installed gamma sector antennas and RRUs on existing sector frame

All notes and items in this field report are a record of observations provided by the photos. Please notify Dewberry Engineers Inc. in writing of any discrepancies, errors or misinterpretations. Please find attached to this report, the figures and photos of construction and items observed.

Prepared By: 
Joseph Mazzeo
Engineer

Contractor Photos:




Figure 1: View of installed alpha sector antennas and RRUs on existing sector frame



Figure 2: View of installed beta sector antennas and RRUs on existing sector frame



Figure 3: View of installed gamma sector antennas and RRUs on existing sector frame

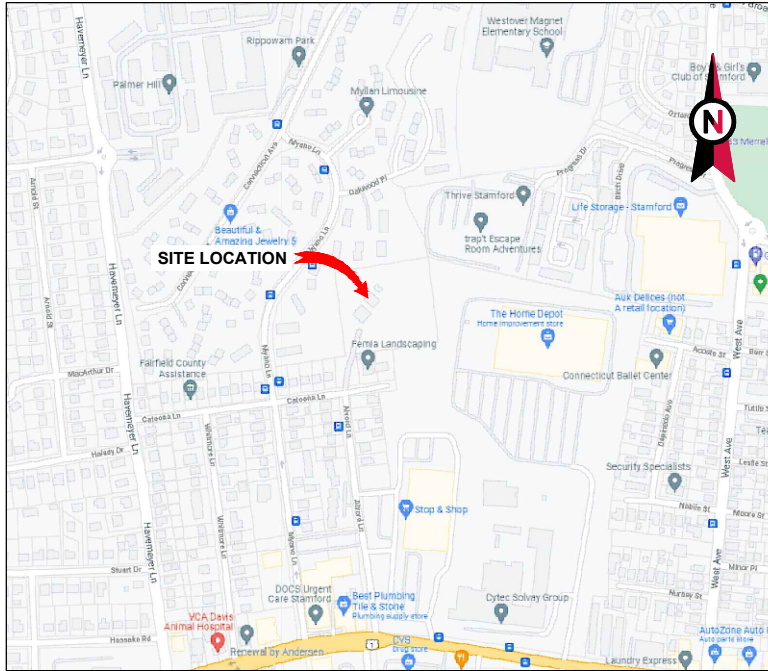

VICINITY MAP

Redlined - C-401, S-103
Centerline Communications
Tristen Spear
2/8/23 8:47 AM



AMERICAN TOWER®

ATC SITE NAME: STAMFORD (KATOONA)
ATC SITE NUMBER: 88018
AT&T PACE NUMBERS: MRCTB052218, MRCTB051710,
MRCTB051667, MRCTB051681,
MRCTB051674

AT&T SITE ID: CTL02135
AT&T FA CODE:10034997
AT&T SITE NAME: STAMFORD WEST
SITE ADDRESS: 168 CATOONA LANE
STAMFORD,CT 06902-4573

AT&T 5G NR C-BAND / BBU / CPRI / 4TXRX AMENDMENT PLAN



LOCATION MAP

BIRD WATCH SITE:
PLEASE CONTACT BIRD.WATCH@AMERICANTOWER.COM OR
AMERICAN TOWER NOC AT 877-518-6937 FOR ASSISTANCE

COMPLIANCE CODE	PROJECT SUMMARY	PROJECT DESCRIPTION	SHEET INDEX				
ALL WORK SHALL BE PERFORMED AND MATERIALS INSTALLED IN ACCORDANCE WITH THE CURRENT EDITIONS OF THE FOLLOWING CODES AS ADOPTED BY THE LOCAL GOVERNMENT AUTHORITIES. NOTHING IN THESE PLANS IS TO BE CONSTRUED TO PERMIT WORK NOT CONFORMING TO THESE CODES. 1. 2018 CONNECTICUT STATE BUILDING CODE-AMENDMENTS TO IBC 2015 2. INTERNATIONAL BUILDING CODE 2015, INTERNATIONAL CODE COUNCIL 3. TIA-222-G-4, STRUCTURAL STANDARD FOR ANTENNA SUPPORTING STRUCTURES AND ANTENNAS 4. ASCE 7-10 MINIMUM DESIGN LOADS FOR BUILDINGS AND OTHER STRUCTURES, AMERICAN SOCIETY OF CIVIL ENGINEERS 5. STEEL CONSTRUCTION MANUAL 14TH EDITION, AMERICAN INSTITUTE OF STEEL CONSTRUCTION 6. CITY/COUNTY ORDINANCES	<u>SITE ADDRESS:</u> 168 CATOONA LANE STAMFORD,CT 06902-4573 COUNTY: FAIRFIELD <u>GEOGRAPHIC COORDINATES:</u> LATITUDE: 41.052825 LONGITUDE: -73.56304722 GROUND ELEVATION: 50' AMSL	THE PROPOSED PROJECT INCLUDES MODIFYING GROUND BASED AND TOWER MOUNTED EQUIPMENT AS INDICATED PER BELOW: <u>TOWER WORK:</u> REMOVE (9) ANTENNA(S), (4) RRU(S), (3) DC SQUID(S), (2) DC CABLE(S), AND (3) FIBER CABLE(S) INSTALL (10) ANTENNA(S), (2) RRU(S), (2) DC SQUID(S) AND MOUNT MODIFICATION(S) EXISTING (3) ANTENNAS, (2) RRU(S), (2) SQUID(S), (4) DC AND (1) FIBER TRUNKS TO REMAIN <u>GROUND WORK:</u> INSTALL (1) 6648, (1) IDLE XCEDE, (1) 6675 FRONTHAUL GATEWAY AND (1) 6630	SHEET NO:	DESCRIPTION:	REV:	DATE:	BY:
	PROJECT TEAM	PROJECT NOTES	G-001	TITLE SHEET	0	07/18/22	VL
			G-002	GENERAL NOTES	0	07/18/22	VL
UTILITY COMPANIES	<u>TOWER OWNER:</u> AMERICAN TOWER 10 PRESIDENTIAL WAY WOBURN, MA 01801 <u>ENGINEER:</u> DEWBERRY ENGINEERS, INC. 99 SUMMER STREET SUITE 700 BOSTON, MA 02110 <u>PROPERTY OWNER:</u> ---- 168 CATOONA LANE STAMFORD,CT 06902-4573		C-101	DETAILED SITE PLAN	0	07/18/22	VL
			C-201	TOWER ELEVATION	0	07/18/22	VL
			C-401	RF SCHEDULE AND ANTENNA INSTALLATION	0	07/18/22	VL
			C-501	CONSTRUCTION DETAILS	0	07/18/22	VL
			E-501	GROUNDING DETAILS	0	07/18/22	VL
			R-601	SUPPLEMENTAL			
			R-602	SUPPLEMENTAL			
			R-603	SUPPLEMENTAL			
			MOUNT MODIFICATION SHEETS (9 PAGES)				

GENERAL CONSTRUCTION NOTES:

1. OWNER FURNISHED MATERIALS, AT&T "THE COMPANY" WILL PROVIDE AND THE CONTRACTOR WILL INSTALL
- A. BTS EQUIPMENT FRAME (PLATFORM) AND ICEBRIDGE SHELTER (GROUND BUILD/CO-LOCATE ONLY)

B. AC/TELCO INTERFACE BOX (PPC)

C. ICE BRIDGE (CABLE TRAY WITH COVER) (GROUND BUILD/CO-LOCATE ONLY, GC TO FURNISH AND INSTALL FOR ROOFTOP INSTALLATION)

D. TOWERS, MONOPOLES

E. TOWER LIGHTING

F. GENERATORS & LIQUID PROPANE TANK

G. ANTENNA STANDARD BRACKETS, FRAMES AND PIPES FOR MOUNTING

H. ANTENNAS (INSTALLED BY OTHERS)

I. TRANSMISSION LINE

J. TRANSMISSION LINE JUMPERS

K. TRANSMISSION LINE CONNECTORS WITH WEATHERPROOFING KITS

L. TRANSMISSION LINE GROUND KITS

M. HANGERS

N. HOISTING GRIPS

O. BTS EQUIPMENT
2. THE CONTRACTOR IS RESPONSIBLE TO PROVIDE ALL OTHER MATERIALS FOR THE COMPLETE INSTALLATION OF THE SITE INCLUDING, BUT NOT LIMITED TO, SUCH MATERIALS AS FENCING, STRUCTURAL STEEL SUPPORTING SUB-FRAME FOR PLATFORM, ROOFING LABOR AND MATERIALS, GROUNDING RINGS, GROUNDING WIRES, COPPER-CLAD OR XIT CHEMICAL GROUND ROD(S), BUSS BARS, TRANSFORMERS AND DISCONNECT SWITCHES WHERE APPLICABLE, TEMPORARY ELECTRICAL POWER, CONDUIT, LANDSCAPING COMPOUND STONE, CRANES, CORE DRILLING, SLEEPERS AND RUBBER MATTING, REBAR, CONCRETE CAISSONS, PADS AND/OR AUGER MOUNTS, MISCELLANEOUS FASTENERS, CABLE TRAYS, NON-STANDARD ANTENNA FRAMES AND ALL OTHER MATERIAL AND LABOR REQUIRED TO COMPLETE THE JOB ACCORDING TO THE DRAWINGS AND SPECIFICATIONS. IT IS THE POSITION OF AT&T TO APPLY FOR PERMITTING AND CONTRACTOR RESPONSIBLE FOR PICKUP AND PAYMENT OF REQUIRED PERMITS.
3. ALL WORK SHALL CONFORM TO ALL CURRENT APPLICABLE FEDERAL, STATE, AND LOCAL CODES, INCLUDING ANSI/EIA/TIA-222, AND COMPLY WITH ATC CONSTRUCTION SPECIFICATIONS.
4. CONTRACTOR SHALL CONTACT LOCAL 811 FOR IDENTIFICATION OF UNDERGROUND UTILITIES PRIOR TO START OF CONSTRUCTION.
5. CONTRACTOR SHALL BE RESPONSIBLE FOR COORDINATING ALL REQUIRED INSPECTIONS.
6. ALL DIMENSIONS TO, OF, AND ON EXISTING BUILDINGS, DRAINAGE STRUCTURES, AND SITE IMPROVEMENTS SHALL BE VERIFIED IN FIELD BY CONTRACTOR WITH ALL DISCREPANCIES REPORTED TO THE ENGINEER.
7. DO NOT CHANGE SIZE OR SPACING OF STRUCTURAL ELEMENTS.
8. DETAILS SHOWN ARE TYPICAL; SIMILAR DETAILS APPLY TO SIMILAR CONDITIONS UNLESS OTHERWISE NOTED.
9. THESE DRAWINGS DO NOT INCLUDE NECESSARY COMPONENTS FOR CONSTRUCTION SAFETY WHICH SHALL BE THE SOLE RESPONSIBILITY OF THE CONTRACTOR.
10. CONTRACTOR SHALL BRACE STRUCTURES UNTIL ALL STRUCTURAL ELEMENTS NEEDED FOR STABILITY ARE INSTALLED. THESE ELEMENTS ARE AS FOLLOWS: LATERAL BRACING, ANCHOR BOLTS, ETC.
11. CONTRACTOR SHALL DETERMINE EXACT LOCATION OF EXISTING UTILITIES, GROUNDS DRAINS, DRAIN PIPES, VENTS, ETC. BEFORE COMMENCING WORK.
12. INCORRECTLY FABRICATED, DAMAGED, OR OTHERWISE MISFITTING OR NONCONFORMING MATERIALS OR CONDITIONS SHALL BE REPORTED TO THE AT&T REP PRIOR TO REMEDIAL OR CORRECTIVE ACTION. ANY SUCH REMEDIAL ACTION SHALL REQUIRE WRITTEN APPROVAL BY THE AT&T REP PRIOR TO PROCEEDING.
13. EACH CONTRACTOR SHALL COOPERATE WITH THE AT&T REP, AND COORDINATE HIS WORK WITH THE WORK OF OTHERS.
14. CONTRACTOR SHALL REPAIR ANY DAMAGE CAUSED BY CONSTRUCTION OF THIS PROJECT TO MATCH EXISTING PRE-CONSTRUCTION CONDITIONS TO THE SATISFACTION OF THE AT&T CONSTRUCTION MANAGER.
15. ALL CABLE/CONDUIT ENTRY/EXIT PORTS SHALL BE WEATHERPROOFED DURING INSTALLATION USING A SILICONE SEALANT.
16. WHERE EXISTING CONDITIONS DO NOT MATCH THOSE SHOWN IN THIS PLAN SET, CONTRACTOR SHALL NOTIFY THE AT&T REP AND ENGINEER OF RECORD IMMEDIATELY.
17. CONTRACTOR SHALL ENSURE ALL SUBCONTRACTORS ARE PROVIDED WITH A COMPLETE AND CURRENT SET OF DRAWINGS AND SPECIFICATIONS FOR THIS PROJECT.
18. CONTRACTOR SHALL REMOVE ALL RUBBISH AND DEBRIS FROM THE SITE AT THE END OF EACH DAY.
19. CONTRACTOR SHALL COORDINATE WORK SCHEDULE WITH AMERICAN TOWER CORPORATION (ATC) AND TAKE PRECAUTIONS TO MINIMIZE IMPACT AND DISRUPTION OF OTHER OCCUPANTS OF THE FACILITY.
20. CONTRACTOR SHALL FURNISH AT&T AND AMERICAN TOWER CORPORATION (ATC) WITH A PDF MARKED UP AS-BUILT SET OF DRAWINGS UPON COMPLETION OF WORK.
21. PRIOR TO SUBMISSION OF BID, CONTRACTOR SHALL COORDINATE WITH AT&T REP TO DETERMINE WHAT, IF ANY, ITEMS WILL BE PROVIDED. ALL ITEMS NOT PROVIDED SHALL BE PROVIDED AND INSTALLED BY THE CONTRACTOR. CONTRACTOR WILL INSTALL ALL ITEMS PROVIDED.
22. PRIOR TO SUBMISSION OF BID, CONTRACTOR SHALL COORDINATE WITH AT&T REP TO

23. CONTRACTOR SHALL INSTALL ALL SITE SIGNAGE IN ACCORDANCE WITH AT&T SPECIFICATIONS AND REQUIREMENTS.
24. CONTRACTOR SHALL SUBMIT ALL SHOP DRAWINGS TO AT&T FOR REVIEW AND APPROVAL PRIOR TO FABRICATION.
25. ALL EQUIPMENT SHALL BE INSTALLED ACCORDING TO MANUFACTURER'S SPECIFICATIONS AND LOCATED ACCORDING TO AT&T SPECIFICATIONS, AND AS SHOWN IN THESE PLANS.
26. THE CONTRACTOR SHALL SUPERVISE AND DIRECT THE PROJECT DESCRIBED HEREIN. THE CONTRACTOR SHALL BE SOLELY RESPONSIBLE FOR ALL THE CONSTRUCTION MEANS, METHODS, TECHNIQUES, SEQUENCES AND PROCEDURES AND FOR COORDINATING ALL PORTIONS OF THE WORK UNDER THE CONTRACT.
27. CONTRACTOR SHALL NOTIFY AT&T REP A MINIMUM OF 48 HOURS IN ADVANCE OF POURING CONCRETE OR BACKFILLING ANY UNDERGROUND UTILITIES, FOUNDATIONS OR SEALING ANY WALL, FLOOR OR ROOF PENETRATIONS FOR ENGINEERING REVIEW AND APPROVAL.
28. CONTRACTOR SHALL BE RESPONSIBLE FOR SITE SAFETY INCLUDING COMPLIANCE WITH ALL APPLICABLE OSHA STANDARDS AND RECOMMENDATIONS AND SHALL PROVIDE ALL NECESSARY SAFETY DEVICES INCLUDING PPE AND PPM AND CONSTRUCTION DEVICES SUCH AS WELDING AND FIRE PREVENTION, TEMPORARY SHORING, SCAFFOLDING, TRENCH BOXES/SLOPING, BARRIERS, ETC.
29. THE CONTRACTOR SHALL PROTECT AT HIS OWN EXPENSE, ALL EXISTING FACILITIES AND SUCH OF HIS NEW WORK LIABLE TO INJURY DURING THE CONSTRUCTION PERIOD. ANY DAMAGE CAUSED BY NEGLIGENCE ON THE PART OF THIS CONTRACTOR OR HIS REPRESENTATIVES, OR BY THE ELEMENTS DUE TO NEGLIGENCE ON THE PART OF THIS CONTRACTOR OR HIS REPRESENTATIVES, EITHER TO THE EXISTING WORK, OR TO HIS WORK OR THE WORK OF ANY OTHER CONTRACTOR, SHALL BE REPAIRED AT HIS EXPENSE TO THE OWNER'S SATISFACTION.
30. ALL WORK SHALL BE INSTALLED IN A FIRST CLASS, NEAT AND WORKMANLIKE MANNER BY MECHANICS SKILLED IN THE TRADE INVOLVED. THE QUALITY OF WORKMANSHIP SHALL BE SUBJECT TO THE APPROVAL OF THE AT&T REP. ANY WORK FOUND BY THE AT&T REP TO BE OF INFERIOR QUALITY AND/OR WORKMANSHIP SHALL BE REPLACED AND/OR REWORKED AT CONTRACTOR EXPENSE UNTIL APPROVAL IS OBTAINED.
31. IN ORDER TO ESTABLISH STANDARDS OF QUALITY AND PERFORMANCE, ALL TYPES OF MATERIALS LISTED HEREINAFTER BY MANUFACTURER'S NAMES AND/OR MANUFACTURER'S CATALOG NUMBER SHALL BE PROVIDED BY THESE MANUFACTURERS AS SPECIFIED.
32. AT&T FURNISHED EQUIPMENT SHALL BE PICKED-UP AT THE AT&T WAREHOUSE, NO LATER THAN 48HR AFTER BEING NOTIFIED INSURED, STORED, UNCRATE, PROTECTED AND INSTALLED BY THE CONTRACTOR WITH ALL APPURTENANCES REQUIRED TO PLACE THE EQUIPMENT IN OPERATION, READY FOR USE. THE CONTRACTOR SHALL BE RESPONSIBLE FOR THE EQUIPMENT AFTER PICKING IT UP.
33. AT&T OR HIS ARCHITECT/ENGINEER RESERVES THE RIGHT TO REJECT ANY EQUIPMENT OR MATERIALS WHICH, IN HIS OWN OPINION ARE NOT IN COMPLIANCE WITH THE CONTRACT DOCUMENTS, EITHER BEFORE OR AFTER INSTALLATION AND THE EQUIPMENT SHALL BE REPLACED WITH EQUIPMENT CONFORMING TO THE REQUIREMENTS OF THE CONTRACT DOCUMENTS BY THE CONTRACTOR AT NO COST TO AT&T OR THEIR ARCHITECT/ENGINEER.
- STRUCTURAL STEEL NOTES:
1. STRUCTURAL STEEL SHALL CONFORM TO THE LATEST EDITION OF THE AISC "SPECIFICATION FOR THE DESIGN, FABRICATION AND ERECTION OF STRUCTURAL STEEL FOR BUILDINGS."
2. STRUCTURAL STEEL ROLLED SHAPES, PLATES AND BARS SHALL CONFORM TO THE FOLLOWING ASTM DESIGNATIONS:
- A. ASTM A-572, GRADE 50 - ALL W SHAPES, UNLESS NOTED OR A992 OTHERWISE

B. ASTM A-36 - ALL OTHER ROLLED SHAPES, PLATES AND BARS UNLESS NOTED OTHERWISE.

C. ASTM A-500, GRADE B - HSS SECTION (SQUARE, RECTANGULAR, AND ROUND)

D. ASTM A-325, TYPE SC OR N - ALL BOLTS FOR CONNECTING STRUCTURAL MEMBERS

E. ASTM F-1554 07 - ALL ANCHOR BOLTS, UNLESS NOTED OTHERWISE
3. ALL EXPOSED STRUCTURAL STEEL MEMBERS SHALL BE HOT-DIPPED GALVANIZED AFTER FABRICATION PER ASTM A123. EXPOSED STEEL HARDWARE AND ANCHOR BOLTS SHALL BE GALVANIZED PER ASTM A153 OR B695.
4. ALL FIELD CUT SURFACES, FIELD DRILLED HOLES AND GROUND SURFACES WHERE EXISTING PAINT OR GALVANIZATION REMOVAL WAS REQUIRED SHALL BE REPAIRED WITH (2) BRUSHED COATS OF ZRC GALVILITE COLD GALVANIZING COMPOUND PER ASTM A780 AND MANUFACTURER'S RECOMMENDATIONS.
5. DO NOT DRILL HOLES THROUGH STRUCTURAL STEEL MEMBERS EXCEPT AS SHOWN AND DETAILED ON STRUCTURAL DRAWINGS.
6. CONNECTIONS:
- A. ALL WELDING TO BE PERFORMED BY AWS CERTIFIED WELDERS AND CONDUCTED IN ACCORDANCE WITH THE LATEST EDITION OF THE AWS WELDING CODE D1.1.

B. ALL WELDS SHALL BE INSPECTED VISUALLY. 25% OF WELDS SHALL BE

- INSPECTED WITH DYE PENETRANT OR MAGNETIC PARTICLE TO MEET THE ACCEPTANCE CRITERIA OF AWS D1.1. REPAIR ALL WELDS AS NECESSARY.
- C. INSPECTION SHALL BE PERFORMED BY AN AWS CERTIFIED WELD INSPECTOR.
- D. IT IS THE CONTRACTORS RESPONSIBILITY TO PROVIDE BURNING/WELDING PERMITS AS REQUIRED BY LOCAL GOVERNING AUTHORITY AND IF REQUIRED SHALL HAVE FIRE DEPARTMENT DETAIL FOR ANY WELDING ACTIVITY.
- E. ALL ELECTRODES TO BE LOW HYDROGEN, MATCHING FILLER METAL, PER AWS D1.1, UNLESS NOTED OTHERWISE.
- F. MINIMUM WELD SIZE TO BE 0.1875 INCH FILLET WELDS, UNLESS NOTED OTHERWISE.
- G. PRIOR TO FIELD WELDING GALVANIZING MATERIAL, CONTRACTOR SHALL GRIND OFF GALVANIZING ¼" BEYOND ALL FIELD WELD SURFACES. AFTER WELD AND WELD INSPECTION IS COMPLETE, REPAIR ALL GROUND AND WELDED SURFACES WITH ZRC GALVILITE COLD GALVANIZING COMPOUND PER ASTM A780 AND MANUFACTURERS RECOMMENDATIONS.
- H. THE CONTRACTOR SHALL PROVIDE ADEQUATE SHORING AND/OR BRACING WHERE REQUIRED DURING CONSTRUCTION UNTIL ALL CONNECTIONS ARE COMPLETE.
- I. ANY FIELD CHANGES OR SUBSTITUTIONS SHALL HAVE PRIOR APPROVAL FROM THE ENGINEER, AND T- MOBILE PROJECT MANAGER IN WRITING

SPECIAL CONSTRUCTION
ANTENNA INSTALLATION NOTES:

1. WORK INCLUDED:
- A. ANTENNA AND COAXIAL CABLES ARE FURNISHED BY AT&T UNDER A SEPARATE CONTRACT. THE CONTRACTOR SHALL ASSIST ANTENNA INSTALLATION CONTRACTOR IN TERMS OF COORDINATION AND SITE ACCESS. ERECTION SUBCONTRACTOR SHALL BE RESPONSIBLE FOR THE PROTECTION OF PERSONNEL.

B. INSTALL ANTENNAS AS INDICATED ON DRAWINGS AND AT&T SPECIFICATIONS.

C. INSTALL GALVANIZED STEEL ANTENNA MOUNTS AS INDICATED ON DRAWINGS.

D. INSTALL FURNISHED GALVANIZED STEEL OR ALUMINUM WAVEGUIDE AND PROVIDE PRINTOUT OF THAT TEST.

E. CONTRACTOR SHALL PROVIDE FOUR (4) SETS OF SWEEP TESTS USING ANRITZU-PACKARD 8713B RF SCALAR NETWORK ANALYZER. SUBMIT FREQUENCY DOMAIN REFLECTOMETER(FDR) TESTS RESULTS TO THE PROJECT MANAGER. SWEEP TESTS SHALL BE AS PER ATTACHED RFS "MINIMUM FIELD TESTING RECOMMENDED FOR ANTENNA AND HELIAX COAXIAL CABLE SYSTEMS" DATED 10/5/93. TESTING SHALL BE PERFORMED BY AN INDEPENDENT TESTING SERVICE AND BE BOUND AND SUBMITTED WITHIN ONE WEEK OF WORK COMPLETION.

F. INSTALL COAXIAL CABLES AND TERMINATING BETWEEN ANTENNAS AND EQUIPMENT PER MANUFACTURER'S RECOMMENDATIONS. WEATHERPROOF ALL CONNECTIONS BETWEEN THE ANTENNA AND EQUIPMENT PER MANUFACTURER'S REQUIREMENTS. TERMINATE ALL COAXIAL CABLE THREE (3) FEET IN EXCESS OF ENTRY PORT LOCATION UNLESS OTHERWISE STATED.

G. ANTENNA AND COAXIAL CABLE GROUNDING:
2. ALL EXTERIOR #6 GREEN GROUND WIRE "DAISY CHAIN" CONNECTIONS ARE TO BE WEATHER SEALED WITH RFS CONNECTORS/SPLICE WEATHERPROOFING KIT #221213 OR EQUAL.
3. ALL COAXIAL CABLE GROUNDING KITS ARE TO BE INSTALLED ON STRAIGHT RUNS OF COAXIAL CABLE (NOT WITHIN BENDS).

AS BUILT
Centerline Communications
Tristen Spear
2/8/23 8:47 AM

ALL DISCREPANCIES FROM WHAT IS SHOWN ON THESE CONSTRUCTION DRAWINGS SHALL BE COMMUNICATED TO ATC ENGINEERING IMMEDIATELY FOR CORRECTION OR RE-DESIGN. FAILURE TO COMMUNICATE DIRECTLY WITH ATC ENGINEERING OR ANY CHANGES FROM THE DESIGN CONDUCTED WITHOUT PRIOR APPROVAL FROM ATC ENGINEERING SHALL BE THE SOLE RESPONSIBILITY OF THE GENERAL CONTRACTOR.



AMERICAN TOWER®



Dewberry Engineers Inc.
99 SUMMER STREET
SUITE 700
BOSTON, MA 02110
PHONE: 617.695.3400
FAX: 617.695.3310

REV.	DESCRIPTION	BY	DATE
<u>A</u>	PRELIM	FG	12/10/21
<u>B</u>	PRELIM	BR	03/15/22
<u>0</u>	FINAL	VL	07/18/22
<u> </u>			
<u> </u>			

ATC SITE NUMBER:
88018

ATC SITE NAME:
STAMFORD (KATOONA)

AT&T SITE NAME:
STAMFORD WEST

SITE ADDRESS:
168 CATOONA LANE
STAMFORD,CT 06902-4573

SEAL:



AT&T

DATE DRAWN:	12/10/21
ATC JOB NO:	13683396_D1
CUSTOMER ID:	CTL02135
CUSTOMER #:	10034997

GENERAL NOTES

SHEET NUMBER:

G-002


REVISION:

0

SITE PLAN NOTES:

1.
- THIS SITE PLAN REPRESENTS THE BEST PRESENT KNOWLEDGE AVAILABLE TO THE ENGINEER AT THE TIME OF THIS DESIGN. THE CONTRACTOR SHALL VISIT THE SITE PRIOR TO CONSTRUCTION AND VERIFY ALL EXISTING CONDITIONS RELATED TO THE SCOPE OF WORK FOR THIS PROJECT.
2.
- ICE BRIDGE, CABLE LADDER, COAX PORT, AND COAX CABLE ARE SHOWN FOR REFERENCE ONLY. CONTRACTOR SHALL CONFIRM THE EXACT LOCATION OF ALL PROPOSED AND EXISTING EQUIPMENT AND STRUCTURES DEPICTED ON THIS PLAN. BEFORE UTILIZING EXISTING CABLE SUPPORTS, COAX PORTS, INSTALLING NEW PORTS OR ANY OTHER EQUIPMENT, CONTRACTOR SHALL VERIFY ALL ASPECTS OF THE COMPONENTS MEET THE ATC SPECIFICATIONS.
3.
- THIS PROJECT INCLUDES NO INSTALL OR MODIFICATION AT GRADE.

LEGEND	
⊗	GROUNDING TEST WELL
ATS	AUTOMATIC TRANSFER SWITCH
B	BOLLARD
CSC	CELL SITE CABINET
D	DISCONNECT
E	ELECTRICAL
F	FIBER
GEN	GENERATOR
G	GENERATOR RECEPTACAL
HH, V	HAND HOLE, VAULT
IB	ICE BRIDGE
K	KENTROX BOX
LC	LIGHTING CONTROL
M	METER
PB	PULL BOX
PP	POWER POLE
T	TELCO
TRN	TRANSFORMER
— x —	CHAINLINK FENCE

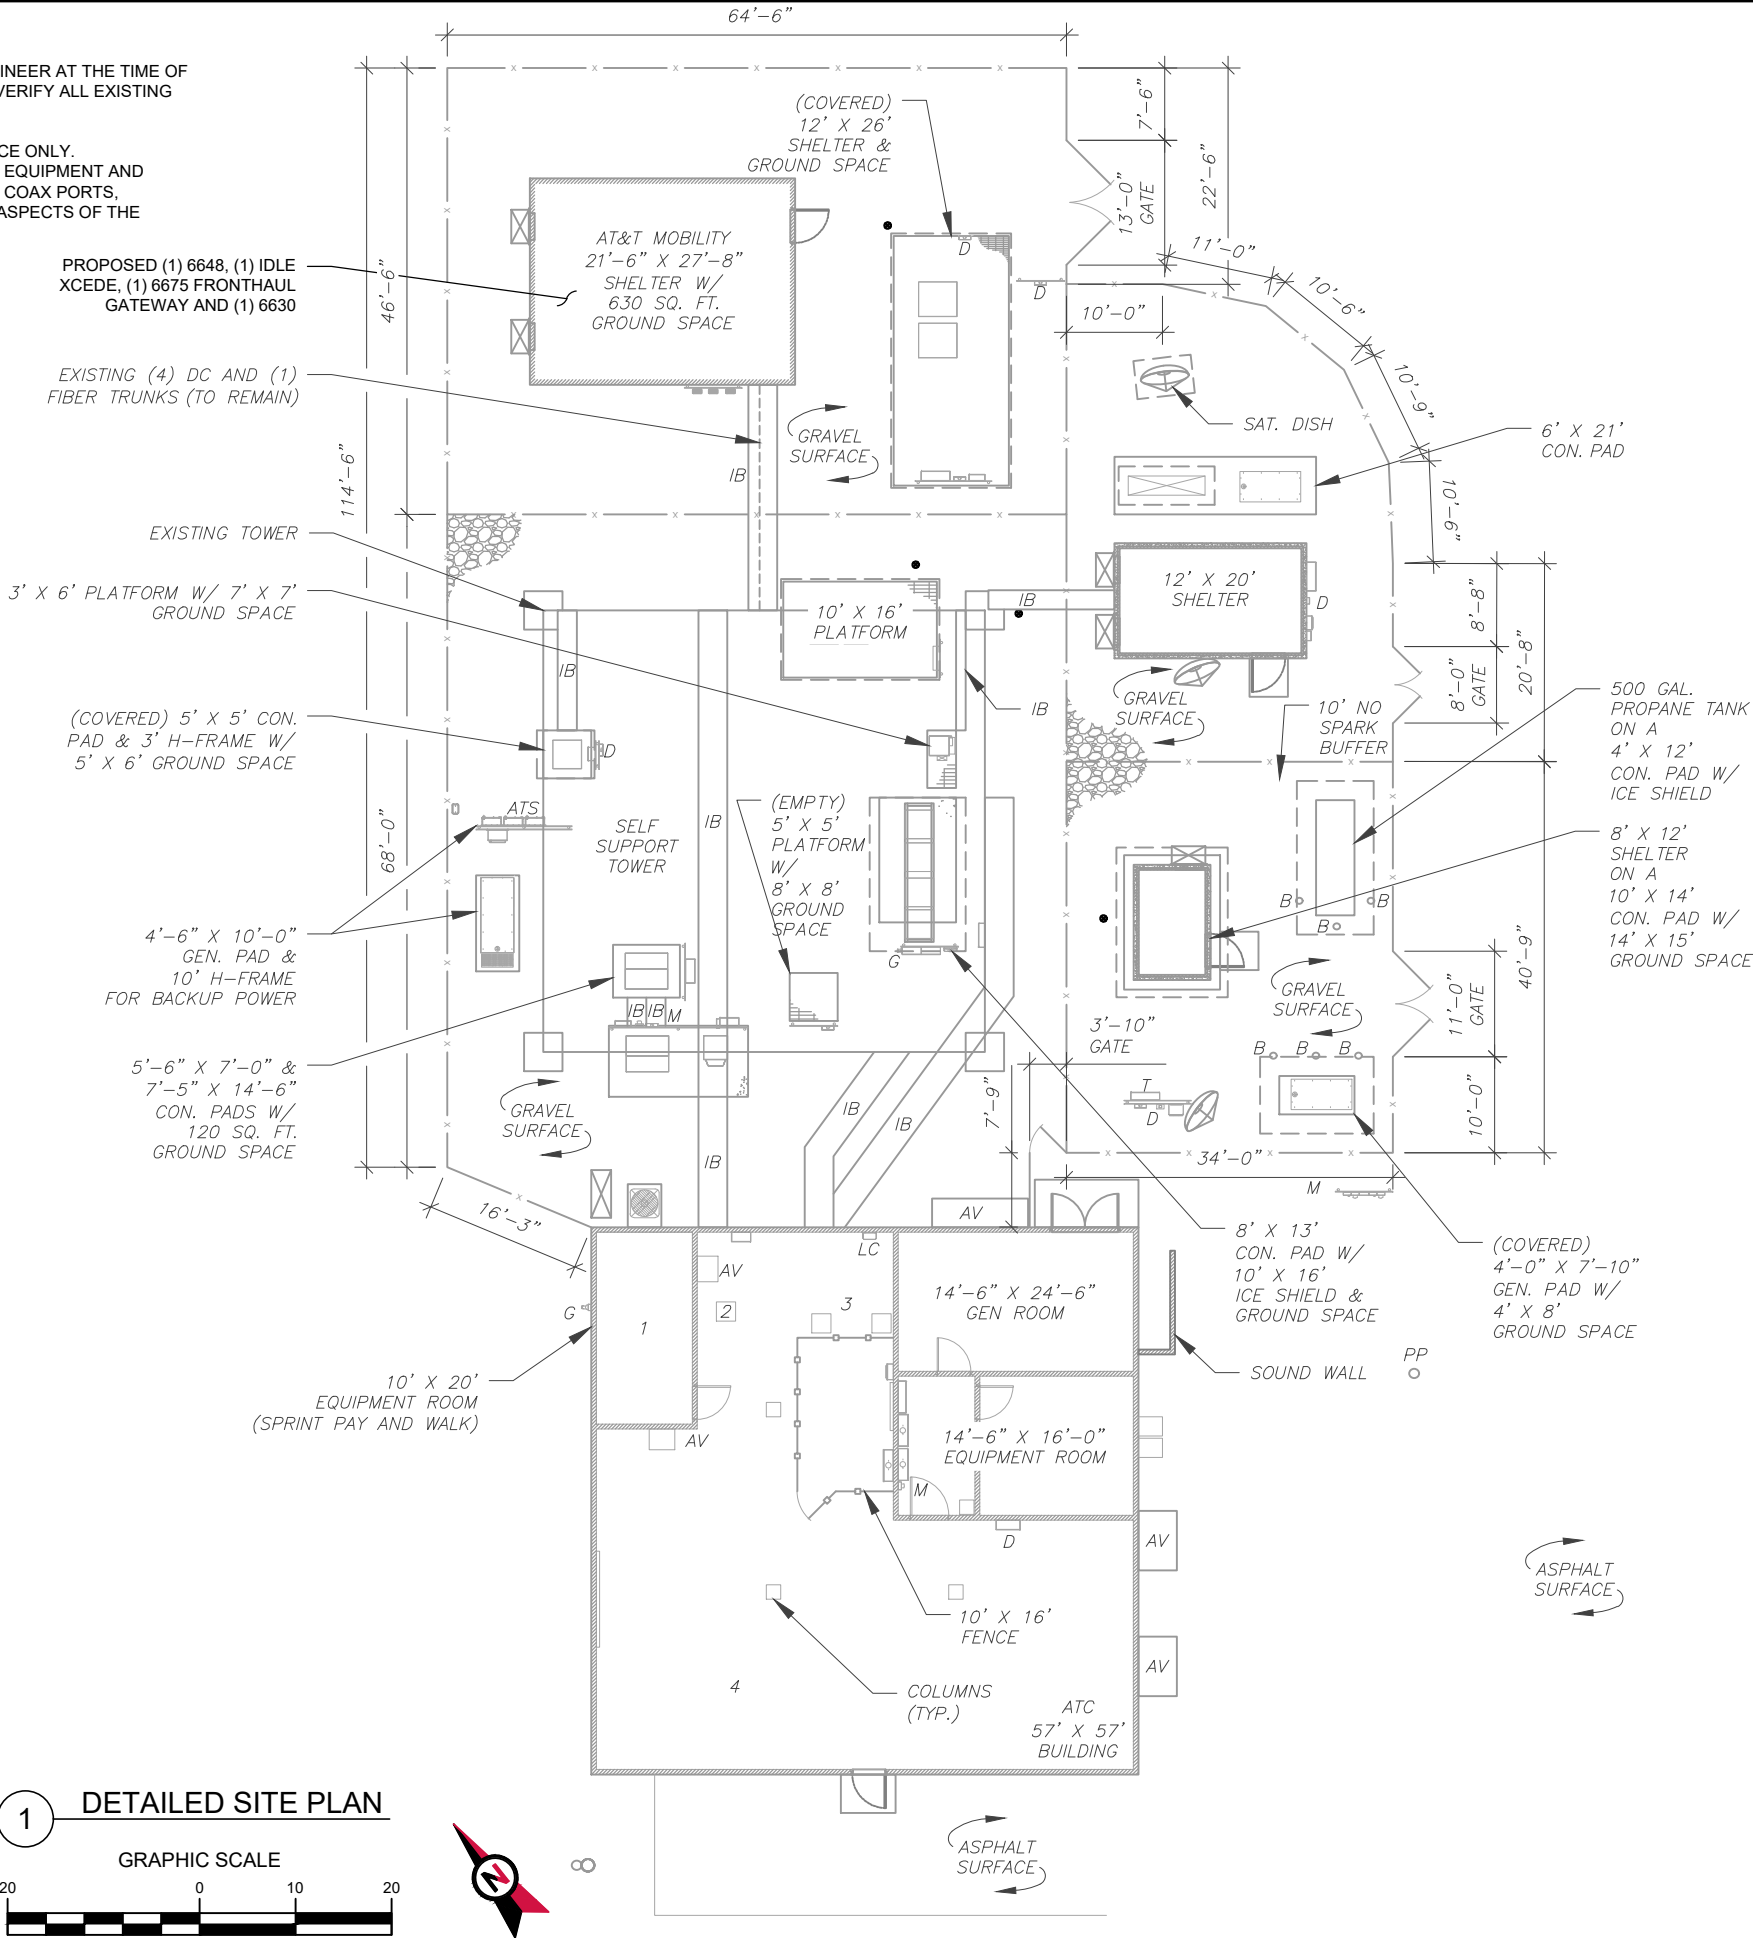

AS BUILT
Centerline Communications
Tristen Spear
2/8/23 8:47 AM



Dewberry

Dewberry Engineers Inc.
99 SUMMER STREET
SUITE 700
BOSTON, MA 02110
PHONE: 617.695.3400
FAX: 617.695.3310

REV.	DESCRIPTION	BY	DATE
A	PRELIM	FG	12/10/21
B	PRELIM	BR	03/15/22
C	FINAL	VL	07/18/22

ATC SITE NUMBER:
88018

ATC SITE NAME:
STAMFORD (KATOONA)

AT&T SITE NAME:
STAMFORD WEST

SITE ADDRESS:
168 CATOONA LANE
STAMFORD, CT 06902-4573

SEAL:



DATE DRAWN:	12/10/21
ATC JOB NO:	13683396_D1
CUSTOMER ID:	CTL02135
CUSTOMER #:	10034997

DETAILED SITE PLAN

SHEET NUMBER:

C-101

REVISION:

0

TOP OF EXISTING TOWER
ELEV 300'

1 4
C-501 C-501

EXISTING AND
PROPOSED AT&T
EQUIPMENT

EXISTING CARRIER ANTENNAS
RAD CENTER @ ELEV 245'

PROPOSED AT&T
RAD CENTER @ 237'

EXISTING AND PROPOSED AT&T
RAD CENTER @ 235'

PROPOSED AT&T
RAD CENTER @ 233'

EXISTING CARRIER ANTENNAS
RAD CENTER @ ELEV 210'

EXISTING TOWER

EXISTING (4) DC AND (1)
FIBER TRUNKS (TO REMAIN)

EXISTING TOP
OF BASE PLATE

1 TOWER ELEVATION
SCALE: N.T.S.

PER MOUNT ANALYSIS COMPLETED BY
AMERICAN TOWER CORPORATION, DATED
06/13/22, THE EXISTING MOUNT MUST BE
MODIFIED TO ADEQUATELY SUPPORT THE
PROPOSED LOADING. THE MOUNT MODIFICATION
PROPOSED IN THE MOUNT ANALYSIS, INCLUDED
AT THE END OF THIS PLAN SET, MUST BE
INSTALLED PRIOR TO THE INSTALLATION OF THE
PROPOSED ANTENNAS AND OTHER EQUIPMENT.

AS BUILT
Centerline Communications
Tristen Spear
2/8/23 8:47 AM

TOWER NOTE:

- IT IS THE CONTRACTOR'S RESPONSIBILITY TO
CONFIRM WITH THE PROJECT MANAGER THAT
THEY HAVE THE MOST RECENT VERSION OF THE
STRUCTURAL ANALYSIS BEFORE COMMENCING
WORK. EXISTING AND PROPOSED TOWER
APPURTENANCES, MOUNTS, AND ANTENNAS ARE
SHOWN BASED ON THE STRUCTURAL ANALYSIS.
- WHERE APPLICABLE, ALL NEW ANTENNAS,
EQUIPMENT, MOUNTS, CABLING, ETC. SHALL BE
PAINTED/SOCKED TO MATCH EXISTING EQUIPMENT
IN ACCORDANCE WITH FAA, JURISDICTION, AND/OR
OTHER LOCAL REQUIREMENTS.
- ROUTE PROPOSED CABLES ALONG SAME PATH AS
EXISTING CABLES AND IN ACCORDANCE WITH
STRUCTURAL ANALYSIS. WHERE POSSIBLE UTILIZE
EXISTING CABLE SUPPORT STRUCTURES AS
PROVIDED FOR CARRIER TO ADEQUATELY SECURE
CABLES, USING EITHER APPROPRIATELY SIZED
STAINLESS STEEL SNAP-INS OR MOUNTING
HARDWARE AND BRACKETS AS SPECIFIED BY
CABLE MANUFACTURER. OTHERWISE, ATTACH
CABLES TO HORIZONTAL OR DIAGONAL TOWER
MEMBERS USING PROPOSED STAINLESS STEEL
ADAPTERS (DO NOT ATTACH TO TOWER LEG).
- TOWER ELEVATIONS ARE MEASURED FROM TOP
OF BASE PLATE TO MATCH STRUCTURAL
ANALYSIS. ELEVATIONS DO NOT REFLECT TRUE
ABOVE GROUND LEVEL (A.G.L.).
- TOWER ELEVATION DEPICTION MAY NOT REFLECT
ALL EQUIPMENT INCLUDED IN STRUCTURAL
ANALYSIS. REFER TO STRUCTURAL ANALYSIS FOR
FULL TOWER LOADING.



Dewberry Engineers Inc.
99 SUMMER STREET
SUITE 700
BOSTON, MA 02110
PHONE: 617.695.3400
FAX: 617.695.3310

REV.	DESCRIPTION	BY	DATE
A	PRELIM	FG	12/10/21
B	PRELIM	BR	03/15/22
0	FINAL	VL	07/18/22

ATC SITE NUMBER:
88018

ATC SITE NAME:
STAMFORD (KATOONA)

AT&T SITE NAME:
STAMFORD WEST

SITE ADDRESS:
168 CATOONA LANE
STAMFORD,CT 06902-4573

SEAL:



DATE DRAWN:	12/10/21
ATC JOB NO:	13683396_D1
CUSTOMER ID:	CTL02135
CUSTOMER #:	10034997

TOWER ELEVATION


SHEET NUMBER:

C-201


REVISION:

0

EXISTING CONFIGURATIONS ARE BASED ON RFDS.
CONTRACTOR TO VERIFY EXISTING CONDITIONS.

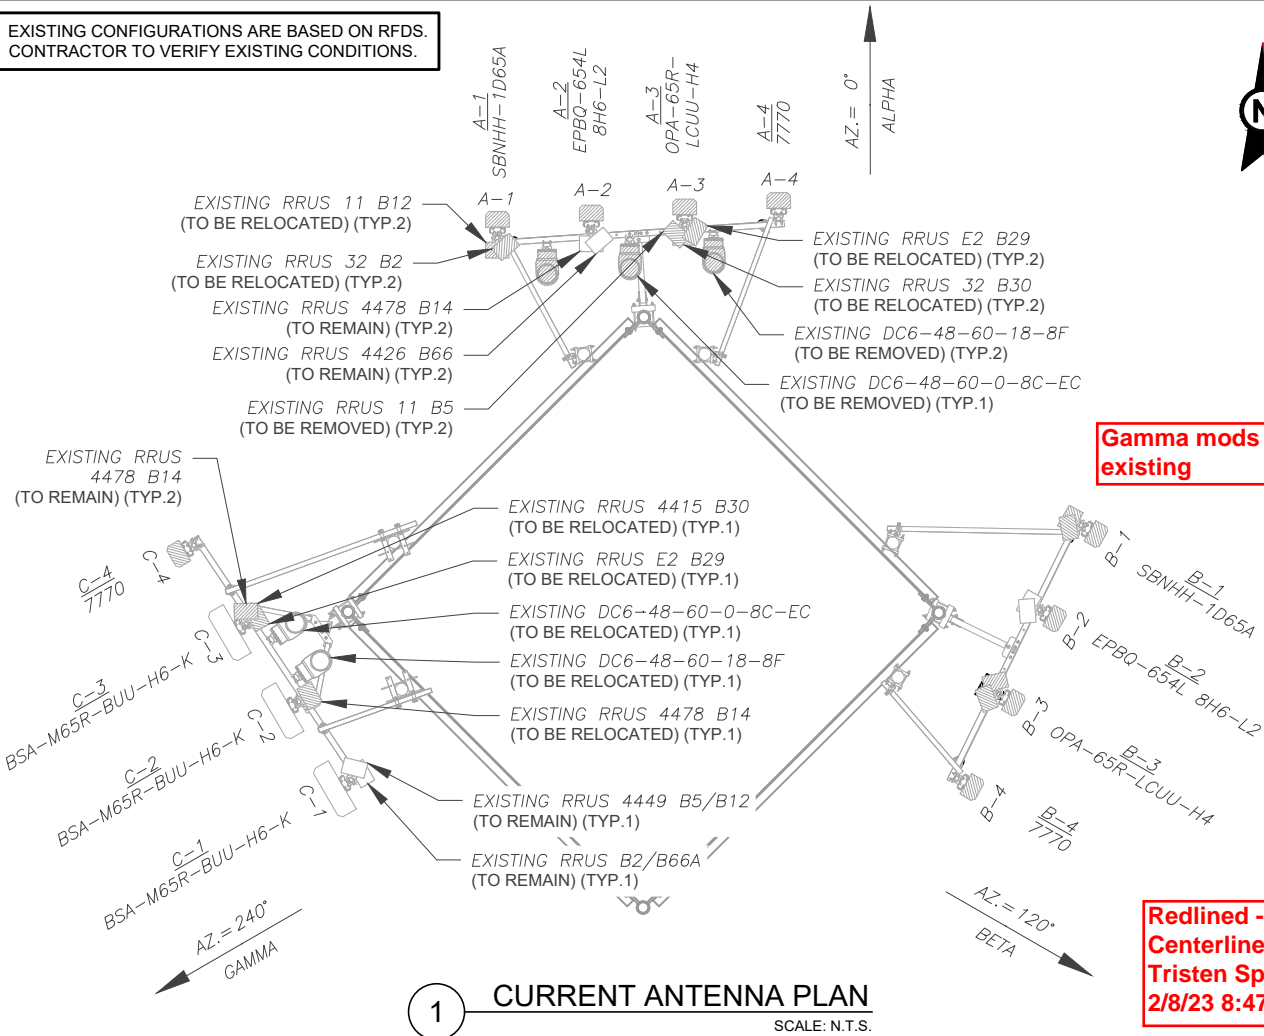

PER MOUNT ANALYSIS COMPLETED BY AMERICAN TOWER CORPORATION, DATED 06/13/22, THE EXISTING MOUNT MUST BE MODIFIED TO ADEQUATELY SUPPORT THE PROPOSED LOADING. THE MOUNT MODIFICATION PROPOSED IN THE MOUNT ANALYSIS, INCLUDED AT THE END OF THIS PLAN SET, MUST BE INSTALLED PRIOR TO THE INSTALLATION OF THE PROPOSED ANTENNAS AND OTHER EQUIPMENT.

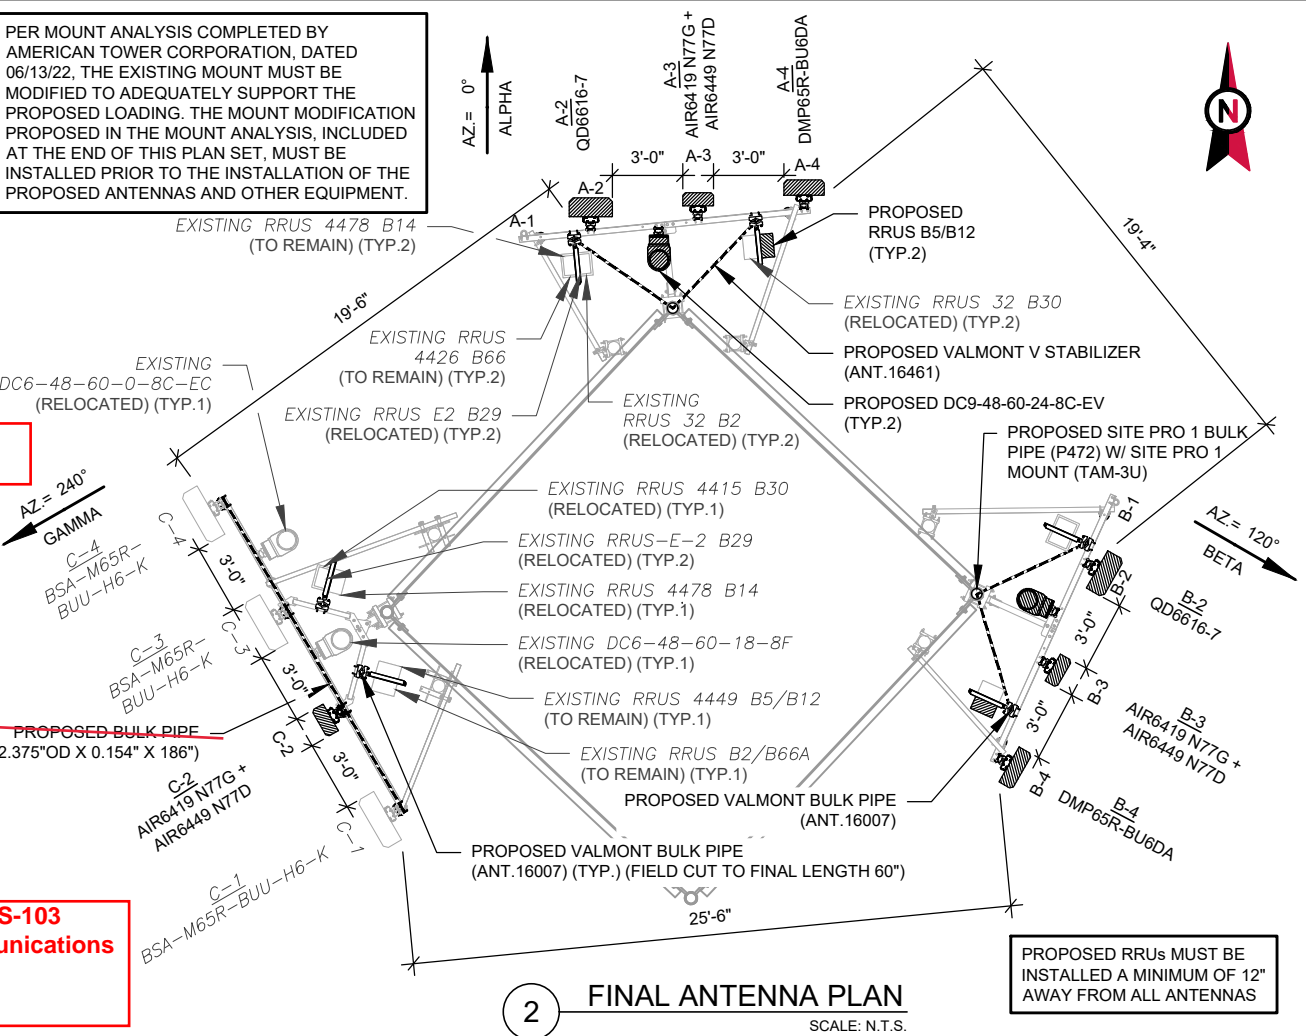

EXISTING ANTENNA SCHEDULE								
LOCATION			ANTENNA SUMMARY			NON ANTENNA SUMMARY		
SECTOR	RAD	AZ	POS	ANTENNA	BAND	STATUS	ADDITIONAL TOWER MOUNTED EQUIPMENT	STATUS
ALPHA	237'	0°	A1	SBNHH-1D65A	LTE 700/1900/1900	RMV	RRUS 11 B12	RMV
							RRUS 32 B2	REL
			A2	EPBQ-654L 8H6-L2	LTE 700/AWS	RMV	RRUS 4478 B14	RMN
							RRUS 4426 B66	
BETA	237'	120°	A3	OPA-65R-LCUU-H4	LTE 700/850/WCS	RMV	RRUS 11 B5	RMV
							RRUS E2 B29	REL
			A4	7770	UMTS 850	RMV	-	-
GAMMA	237'	240°	B1	SBNHH-1D65A	LTE 700/1900/1900	RMV	RRUS 11 B12	RMV
							RRUS 32 B2	REL
			B2	EPBQ-654L 8H6-L2	LTE 700/AWS	RMV	RRUS 4478 B14	RMN
							RRUS 4426 B66	
BETA	237'	120°	B3	OPA-65R-LCUU-H4	LTE 700/850/WCS	RMV	RRUS 11 B5	RMV
							RRUS E2 B29	REL
			B4	7770	UMTS 850	RMV	-	-
GAMMA	237'	240°	C1	BSA-M65R-BUU-H6-K	LTE 700/850/1900/19000	RMN	RRUS 4449 B5/B12	RMN
							RRUS 8843 B2/B66A	
			C2	BSA-M65R-BUU-H6-K	LTE 700/AWS	REL	RRUS 4478 B14	REL
							RRUS E2 B29	
GAMMA	237'	240°	C3	BSA-M65R-BUU-H6-K	LTE 700/WCS	REL	RRUS 4415 B30	REL
			C4	7770	UMTS 850	RMV	-	-

EXISTING FIBER DISTRIBUTION/SQUID			EXISTING CABLING SUMMARY			
MODEL NUMBER	STATUS	COAX	DC	FIBER	STATUS	
(1) DC6-48-60-18-8F	RMN	-	(4) DC	(1) FIBER	RMN	
(1) DC6-48-60-0-8C-EC	RMN	-	-	-	-	
(2) DC6-48-60-18-8F	RMV	-	-	-	-	
(1) DC6-48-60-0-8C-EC	RMV	-	-	-	-	

- NOTES
- CONFIRM WITH AT&T REP FOR APPLICABLE UPDATES/REVISIONS AND MOST RECENT RFDS FOR NSN CONFIGURATION (CONFIG). GC TO CAP ALL UNUSED PORTS.
 - CONFIRM SPACING OF PROPOSED EQUIP DOES NOT CAUSE TOWER CONFLICTS NOR IMPEDE TOWER CLIMBING PEGS.
 - THE ANTENNA ORIENTATION PLAN IS A SCHEMATIC. ATC DID NOT CONFIRM EXISTING SITE CONDITIONS INCLUDING, BUT NOT LIMITED TO, ANTENNA AZIMUTHS, MOUNT CONFIGURATIONS AND TOWER ORIENTATION. SCALES SHOWN ARE FOR REFERENCE ONLY AND EXISTING DIMENSIONS ARE APPROXIMATE. THE CONTRACTOR SHALL VERIFY ALL EXISTING CONDITIONS PRIOR TO INSTALLATION AND NOTIFY ATC OF ANY DISCREPANCIES.
 - CONTRACTOR TO ENSURE PROPER SEPARATION IN ACCORDANCE WITH AT&T'S FIRSTNET REQUIREMENTS (SEE SHEET R-602)

CABLE LENGTHS FOR JUMPERS
JUNCTION BOX TO RRU: 15'
RRU TO ANTENNA: 10'

STATUS ABBREVIATIONS
RMV: TO BE REMOVED
RMN: TO REMAIN
REL: TO BE RELOCATED
ADD: TO BE ADDED

3 EQUIPMENT SCHEDULES

FINAL ANTENNA SCHEDULE								
LOCATION			ANTENNA SUMMARY			NON ANTENNA SUMMARY		
SECTOR	RAD	AZ	POS	ANTENNA	BAND	STATUS	ADDITIONAL TOWER MOUNTED EQUIPMENT	STATUS
ALPHA	235'	0°	A1	-	-	-	-	-
			A2	QD6616-7	LTE 700/700/1900/1900/AWS/ 5G AWS/5G 1900	ADD	RRUS 4478 B14	RMN
							RRUS 4426 B66	
							RRUS 32 B2	REL
BETA	235'	120°	A3	AIR6419 N77G	5G CBAND	ADD	INTEGRATED	ADD
				AIR6449 N77D			INTEGRATED	
			A4	DMP65R-BU6DA	LTE 700/5G 850/LTE WCS	ADD	RRUS 4449 B5/B12	ADD
							RRUS 32 B30	REL
BETA	235'	120°	B1	-	-	-	-	-
			B2	QD6616-7	LTE 700/700/AWS/1900/1900/ 5G AWS/5G 1900	ADD	RRUS 4478 B14	RMN
							RRUS 4426 B66	
							RRUS 32 B2	REL
GAMMA	235'	240°	B3	AIR6419 N77G	5G CBAND	ADD	INTEGRATED	ADD
				AIR6449 N77D			INTEGRATED	
			B4	DMP65R-BU6DA	LTE 700/5G 850/LTE WCS	ADD	RRUS 4449 B5/B12	ADD
							RRUS 32 B30	REL
GAMMA	235'	240°	C1	BSA-M65R-BUU-H6-K	LTE 700/5G 850/LTE 1900/1900/5G 1900	RMN	RRUS 4449 B5/B12	RMN
							RRUS 8843 B2/B66A	
			C2	AIR6419 N77G	5G CBAND	ADD	INTEGRATED	ADD
				AIR6449 N77D			INTEGRATED	
GAMMA	235'	240°	C3	BSA-M65R-BUU-H6-K	LTE 700/AWS/5G AWS	REL	RRUS 4478 B14	REL
							RRUS E2 B29	
GAMMA	235'	240°	C4	BSA-M65R-BUU-H6-K	LTE 700/WCS	REL	RRUS 4415 B30	REL

FINAL FIBER DISTRIBUTION/SQUID			FINAL CABLING SUMMARY			
MODEL NUMBER	STATUS	COAX	DC	FIBER	STATUS	
(1) DC6-48-60-18-8F	RMN	-	(4) DC	(1) FIBER	RMN	
(1) DC6-48-60-0-8C-EC	ADD	-	-	-	-	
(2) DC9-48-60-24-8C-EV	ADD	-	-	-	-	



Dewberry
Dewberry Engineers Inc.
99 SUMMER STREET
SUITE 700
BOSTON, MA 02110
PHONE: 617.695.3400
FAX: 617.695.3310

REV.	DESCRIPTION	BY	DATE
A	PRELIM	FG	12/10/21
B	PRELIM	BR	03/15/22
D	FINAL	VL	07/18/22

ATC SITE NUMBER:
88018

ATC SITE NAME:
STAMFORD (KATOONA)

AT&T SITE NAME:
STAMFORD WEST

SITE ADDRESS:
168 CATOONA LANE
STAMFORD, CT 06902-4573




DATE DRAWN:	12/10/21
ATC JOB NO:	13683396_D1
CUSTOMER ID:	CTL02135
CUSTOMER #:	10034997


RF SCHEDULE AND ANTENNA INSTALLATION

SHEET NUMBER:
C-401


REVISION:
0

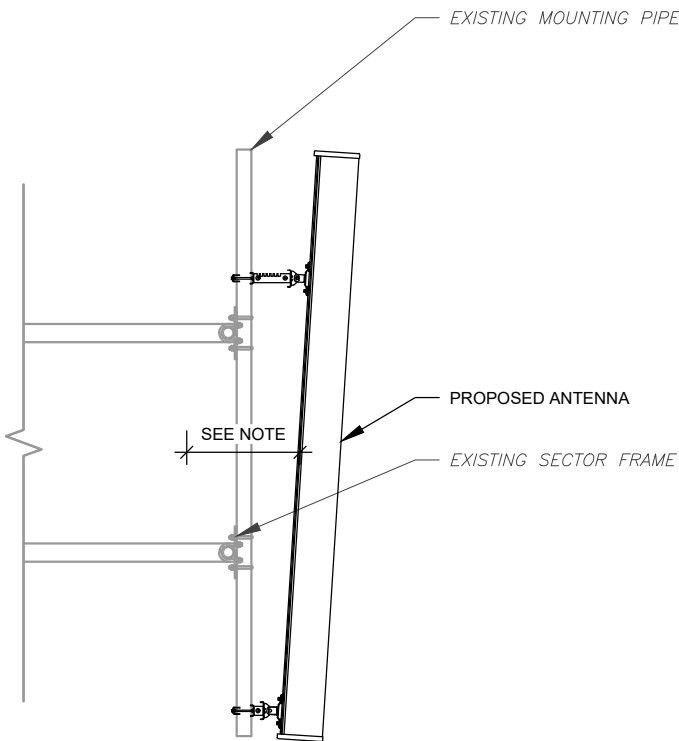


1 ANTENNA DETAIL
SCALE: N.T.S.

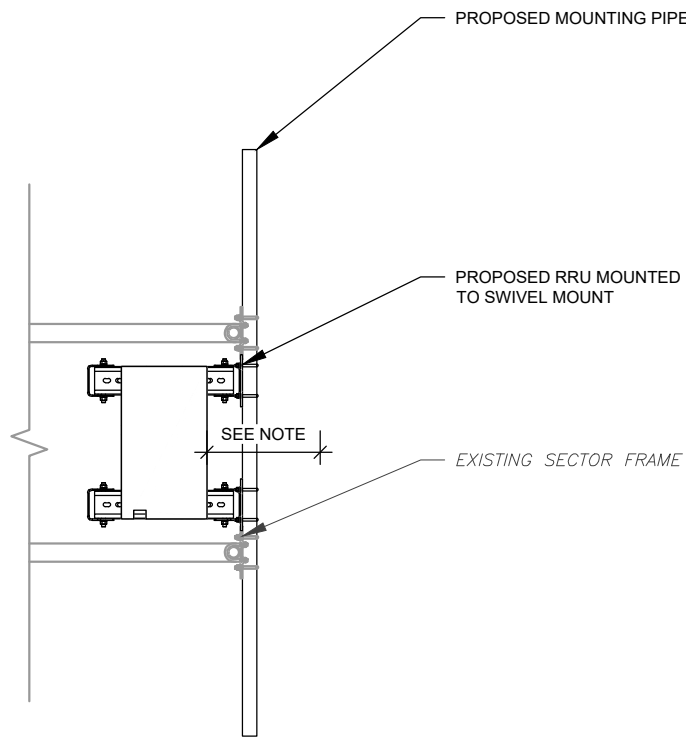

2 PROPOSED RRU MOUNTING DETAIL - TYPICAL
SCALE: N.T.S.

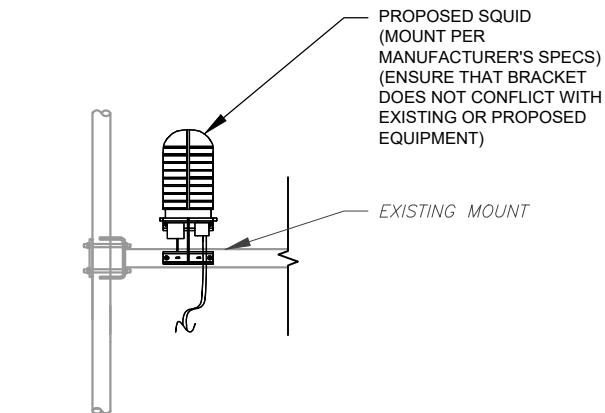

3 PROPOSED SQUID MOUNTING
SCALE: N.T.S.

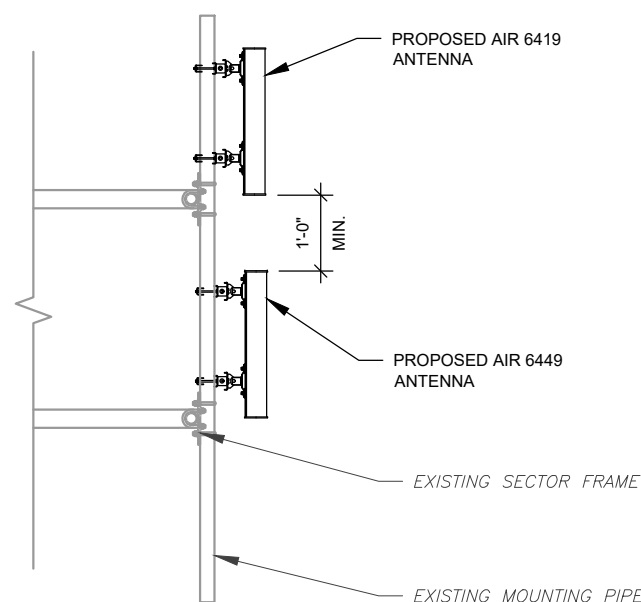

4 PROPOSED 5G ANTENNA MOUNTING DETAIL - TYPICAL
SCALE: N.T.S.

AS BUILT
Centerline Communications
Tristen Spear
2/8/23 8:47 AM



Dewberry Engineers Inc.
99 SUMMER STREET
SUITE 700
BOSTON, MA 02110
PHONE: 617.695.3400
FAX: 617.695.3310

REV.	DESCRIPTION	BY	DATE
A	PRELIM	FG	12/10/21
B	PRELIM	BR	03/15/22
0	FINAL	VL	07/18/22

ATC SITE NUMBER:
88018

ATC SITE NAME:
STAMFORD (KATOONA)

AT&T SITE NAME:
STAMFORD WEST

SITE ADDRESS:
168 CATOONA LANE
STAMFORD, CT 06902-4573

SEAL:



DATE DRAWN:	12/10/21
ATC JOB NO:	13683396_D1
CUSTOMER ID:	CTL02135
CUSTOMER #:	10034997


CONSTRUCTION
DETAILS

SHEET NUMBER:

C-501

REVISION:


0

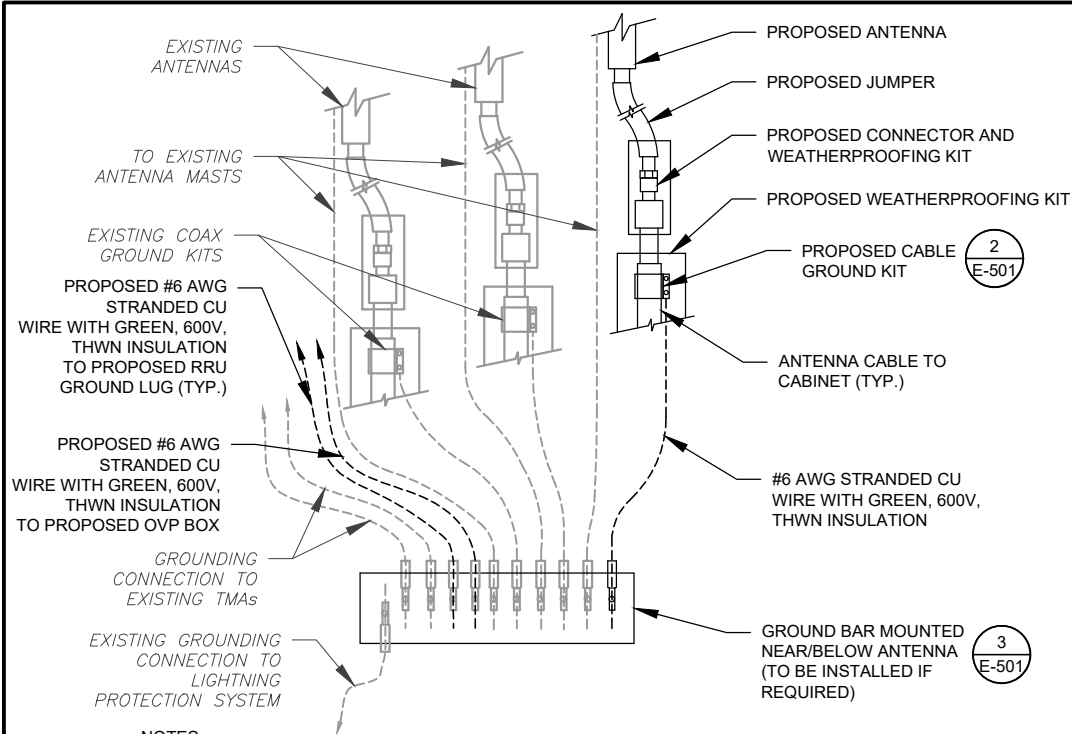

NOTES:

- THIS DETAIL IS INTENDED TO SHOW THE GENERAL GROUNDING REQUIREMENTS. SLIGHT ADJUSTMENTS MAY BE REQUIRED BASED ON EXISTING SITE CONDITIONS. THE CONTRACTOR SHALL MAKE FIELD ADJUSTMENTS AS NEEDED AND INFORM THE CONSTRUCTION MANAGER OF ANY CONFLICTS.
- SITE GROUNDING SHALL COMPLY WITH AT&T GROUNDING STANDARDS, LATEST EDITION, AND COMPLY WITH AT&T GROUNDING CHECKLIST, LATEST VERSION. WHEN NATIONAL AND LOCAL GROUNDING CODES ARE MORE STRINGENT THEY SHALL GOVERN.


1 TYPICAL ANTENNA GROUNDING DIAGRAM
SCALE: N.T.S.

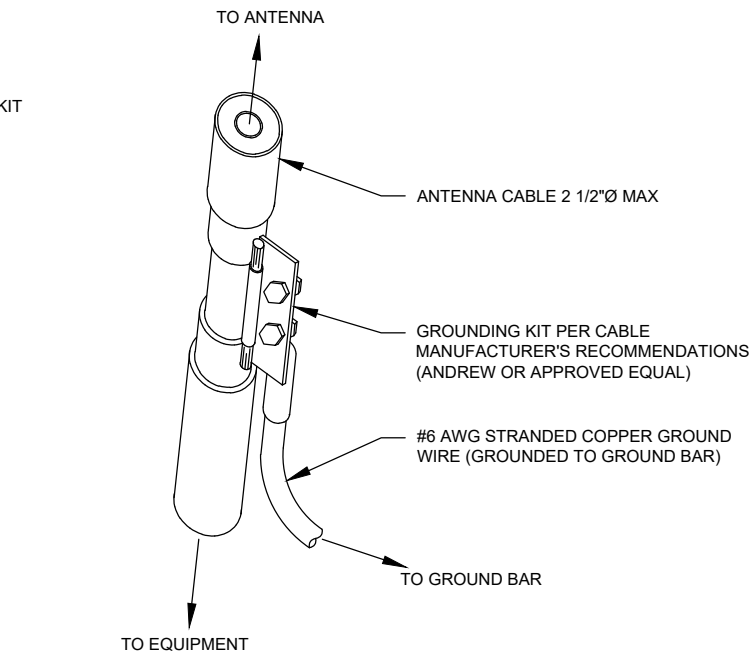

GROUND KIT NOTES:

- DO NOT INSTALL CABLE GROUND KIT AT A BEND AND ALWAYS DIRECT GROUND WIRE DOWN TO GROUND BAR.
- CONTRACTOR SHALL PROVIDE WEATHERPROOFING KIT (ANDREW PART NUMBER 221213) AND INSTALL/TAPE PER MANUFACTURER'S SPECIFICATIONS.


2 CABLE GROUND KIT CONNECTION DETAIL
SCALE: N.T.S.

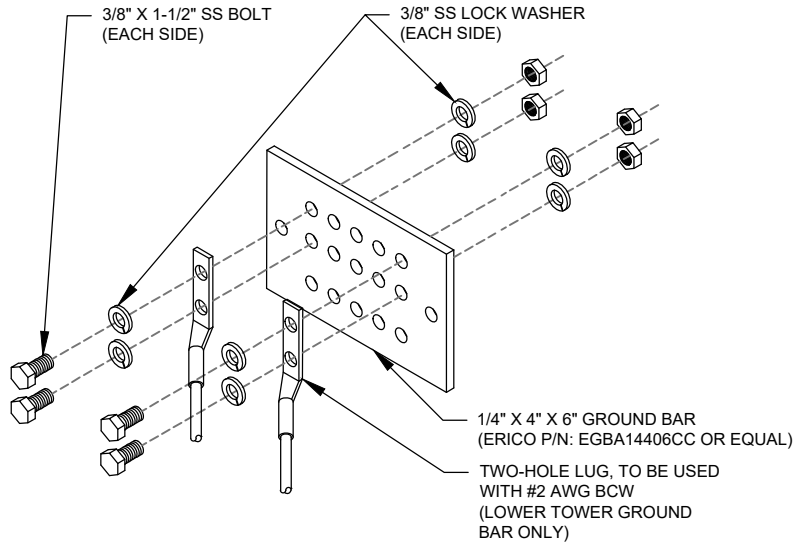

GROUND BAR NOTES:

- GROUND BAR KITS COME WITH ALL HARDWARE, NUTS, BOLTS, WASHERS, ETC. EXCEPT THE STRUCTURAL MOUNTING MEMBER(S).
- GROUND BAR TO BE BONDED DIRECTLY TO TOWER.


3 TOWER GROUND BAR DETAIL
SCALE: N.T.S.

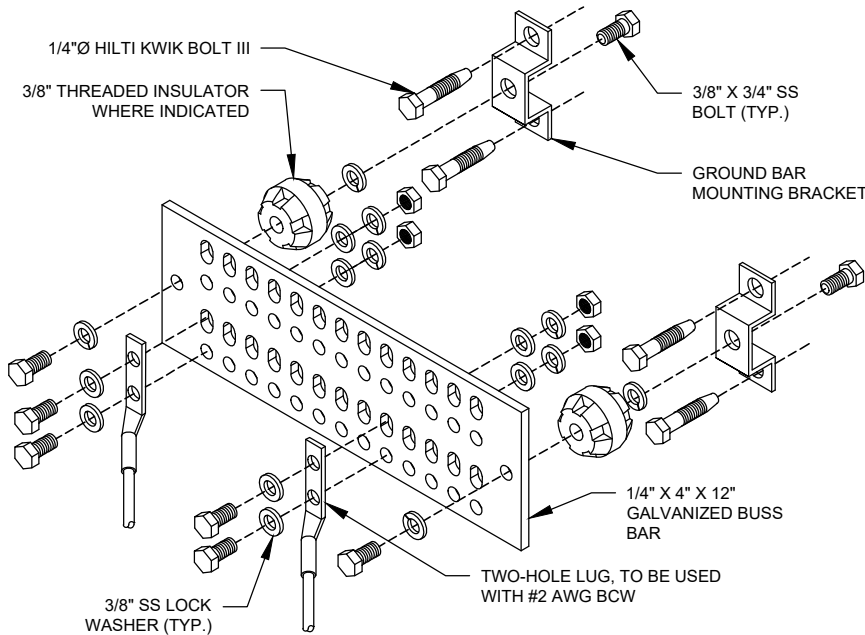


GROUND BAR NOTES

- GROUND KITS COME WITH ALL HARDWARE, NUTS, BOLTS, WASHERS, ETC. EXCEPT THE STRUCTURAL MOUNTING MEMBER(S).
- GROUND BAR SHALL BE BOLTED TO STRUCTURAL MEMBER OR ANCHORED TO CONCRETE SLAB W/ HILTI KWIK BOLT III.

4 MAIN GROUND BAR DETAIL
SCALE: N.T.S.

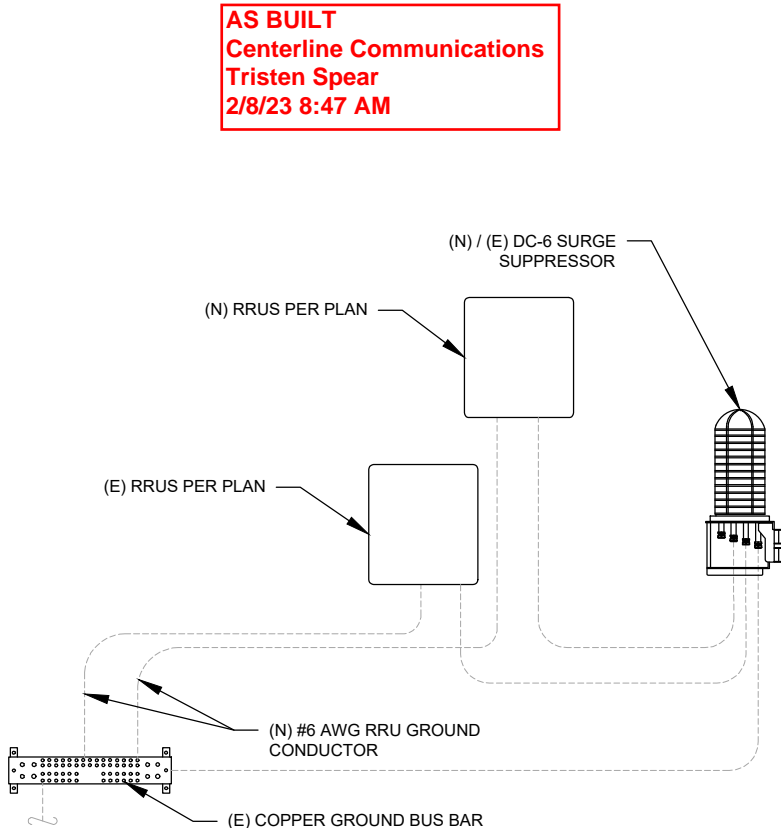

5 RRU GROUNDING
SCALE: N.T.S.

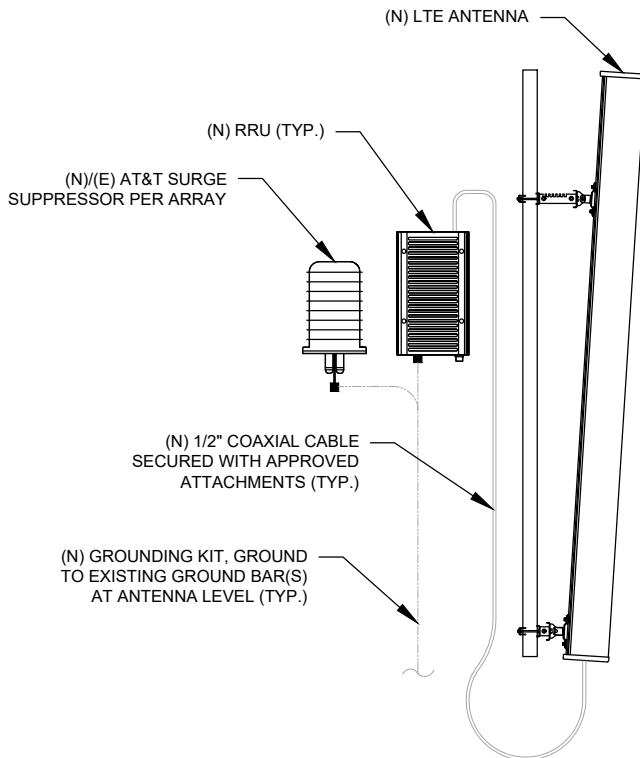

6 ANTENNA/RRU GROUNDING
SCALE: N.T.S.



Dewberry
Dewberry Engineers Inc.
99 SUMMER STREET
SUITE 700
BOSTON, MA 02110
PHONE: 617.695.3400
FAX: 617.695.3310

REV.	DESCRIPTION	BY	DATE
A	PRELIM	FG	12/10/21
B	PRELIM	BR	03/15/22
0	FINAL	VL	07/18/22

ATC SITE NUMBER:

88018

ATC SITE NAME:

STAMFORD (KATOONA)

AT&T SITE NAME:

STAMFORD WEST

SITE ADDRESS:

168 CATOONA LANE
STAMFORD, CT 06902-4573

SEAL:



DATE DRAWN:	12/10/21
ATC JOB NO:	13683396_D1
CUSTOMER ID:	CTL02135
CUSTOMER #:	10034997


GROUNDING DETAILS

SHEET NUMBER:


E-501

REVISION:


0

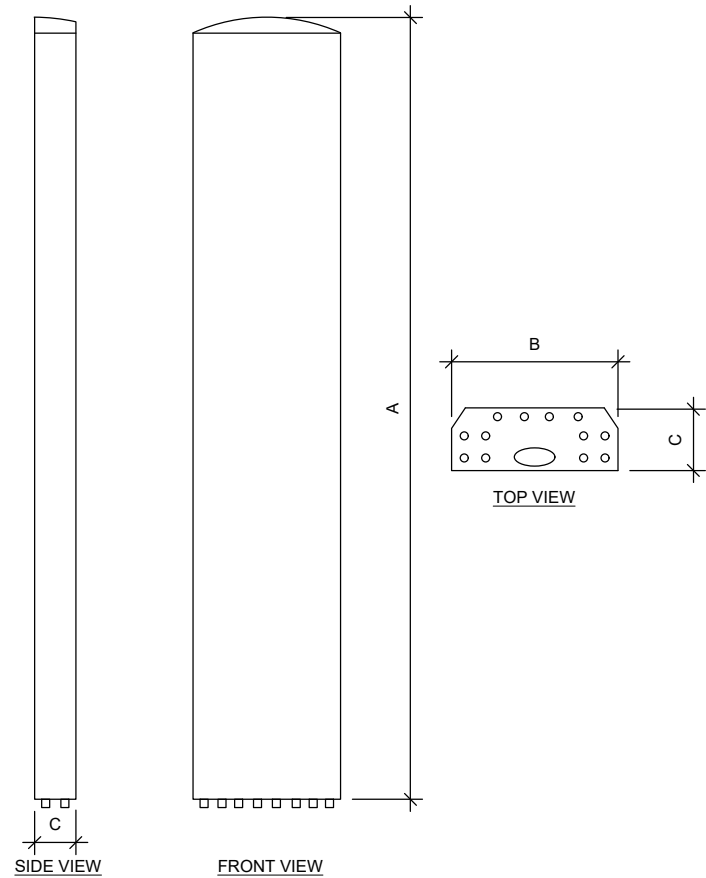


ANTENNA SPECIFICATIONS				
ANTENNA MODEL	A	B	C	WEIGHT (LBS)
AIR 6449 N77D	30.4"	15.9"	8.1"	81.6
AIR6419 N77G	15.7"	30"	6.7"	70.0
DMP65R-BU6DA	71.2"	20.7"	7.7"	79.4

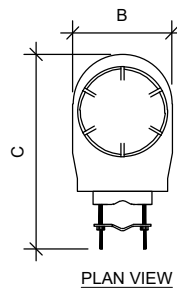

PLAN VIEW

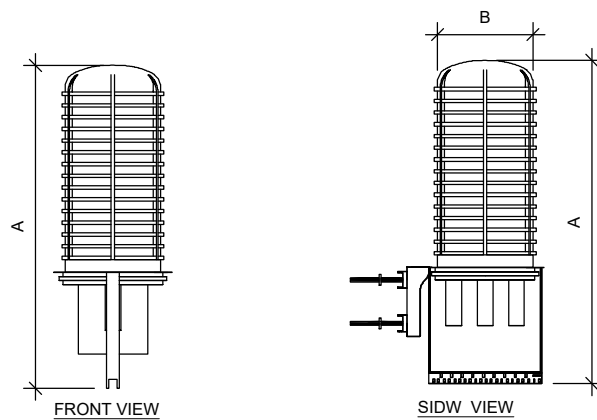

RAYCAP SPECIFICATIONS				
RAYCAP MODEL	A	B	C	WEIGHT (LBS)
DC9-48-60-24-8C-EV	31.4"	18.3"	10.2"	16.0

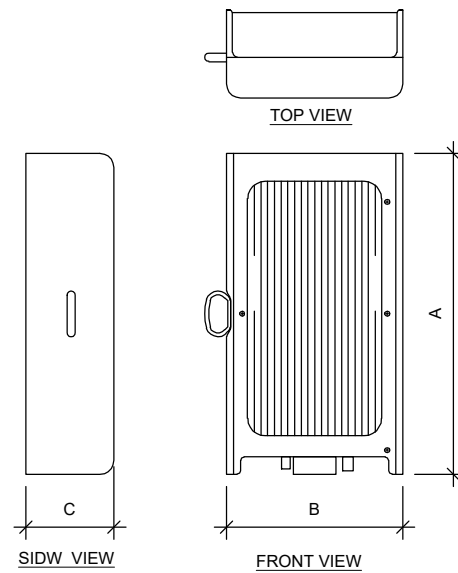

RRU SPECIFICATIONS				
RRU MODEL	A	B	C	WEIGHT (LBS)
RRUS 4449 B5, B12	17.9"	13.2"	9.4"	71.0

AS BUILT
Centerline Communications
Tristen Spear
2/8/23 8:47 AM



Dewberry®
Dewberry Engineers Inc.
99 SUMMER STREET
SUITE 700
BOSTON, MA 02110
PHONE: 617.695.3400
FAX: 617.695.3310

ATC SITE NUMBER:
88018

ATC SITE NAME:
STAMFORD (KATOONA)

AT&T SITE NAME:
STAMFORD WEST

SITE ADDRESS:
168 CATOONA LANE
STAMFORD,CT 06902-4573



DATE DRAWN:	12/10/21
ATC JOB NO:	13683396_D1
CUSTOMER ID:	CTL02135
CUSTOMER #:	10034997

SUPPLEMENTAL

SHEET NUMBER:

R-601



Post Modification Mount Analysis Report

ATC Site Name : STAMFORD (KATOONA), CT
ATC Site Number : 88018
Engineering Number : 13683396_C9_10
Mount Elevation : 236 ft
Carrier : AT&T Mobility
Carrier Site Name : MRCTB051681
Carrier Site Number : N/A
Site Location : 168 Catoona Lane
Stamford, CT 06902-4573
41.052825 , -73.56304722
County : Fairfield
Date : July 13, 2022
Max Usage : 63%
Result : Contingent Pass

Prepared By:
Mitchell Chen
Structural Engineer II

Reviewed By:



COA: PEC.0001553

A.T. Engineering Service, PLLC - 3500 Regency Parkway, Suite 100 - Cary, NC 27518 - 919.468.0112 Office - 919.466.5414 Fax - www.american-tower.com



Eng. Number 13683396_C9_10
July 13, 2022
Page 1

Introduction

The purpose of this report is to summarize results of the mount analysis performed for AT&T Mobility at 236 ft.

Supporting Documents

Specification Sheets	Sabre C10857001C, dated November 15, 2021 MTS SF-U12, dated September 17, 2003
Mount Mapping	Engineered Tower Solutions Project #21094494, dated November 4, 2021
Radio Frequency Data Sheet	RFDS ID #10034997, dated October 25, 2021
Reference Photos	Site photos from 2021

Analysis

This mount was analyzed using American Tower Corporation's Mount Analysis Program and RISA-3D

Basic Wind Speed:	117 mph (3-Second Gust)
Basic Wind Speed w/ Ice:	50 mph (3-Second Gust) w/ 1.00" radial ice concurrent
Codes:	ANSI/TIA-222-H
Exposure Category:	B
Risk Category:	II
Topographic Factor Procedure:	Method 2
Feature:	Flat
Crest Height (H):	0 ft
Crest Length (L):	0 ft
Spectral Response:	Ss = 0.265, S1 = 0.059
Site Class:	D - Stiff Soil - Default
Live Loads:	Lm = 500 lbs, Lv = 250 lbs

Conclusion

Based on the analysis results, the antenna mount meets the requirements per the applicable codes listed above provided the modifications listed below are completed:

- Install modification per ATC Drawing #13683396_C9_10

If you have any questions or require additional information, please contact American Tower via email at Engineering@americantower.com. Please include the American Tower site name, site number, and engineering number in the subject line for any questions.

A.T. Engineering Service, PLLC - 3500 Regency Parkway, Suite 100 - Cary, NC 27518 - 919.468.0112 Office - 919.466.5414 Fax - www.american-tower.com

AS BUILT
Centerline Communications
Tristen Spear
2/8/23 8:47 AM

NOTE: THIS SHEET WAS CREATED BY OTHERS AND PROVIDED AT THE REQUEST OF THE CUSTOMER WITHOUT EDIT. PLEASE REFERENCE THE MOUNT ANALYSIS REPORT FOR COMPLETE MOUNT ANALYSIS CALCULATIONS AND DETAILS. SUPPLEMENTAL PAGES INCLUDED IN THE CONSTRUCTION DRAWINGS ARE FOR REFERENCE ONLY. GENERAL CONTRACTOR IS TO VERIFY THEY HAVE THE MOST RECENT MOUNT ANALYSIS PRIOR TO CONTRUCTION.



Dewberry
Dewberry Engineers Inc.
99 SUMMER STREET
SUITE 700
BOSTON, MA 02110
PHONE: 617.695.3400
FAX: 617.695.3310




ATC SITE NUMBER:
88018
ATC SITE NAME:
STAMFORD (KATOONA)
AT&T SITE NAME:
STAMFORD WEST
SITE ADDRESS:
168 CATOONA LANE
STAMFORD, CT 06902-4573



DATE DRAWN:	12/10/21
ATC JOB NO:	13683396_D1
CUSTOMER ID:	CTL02135
CUSTOMER #:	10034997

SUPPLEMENTAL

SHEET NUMBER:
R-602

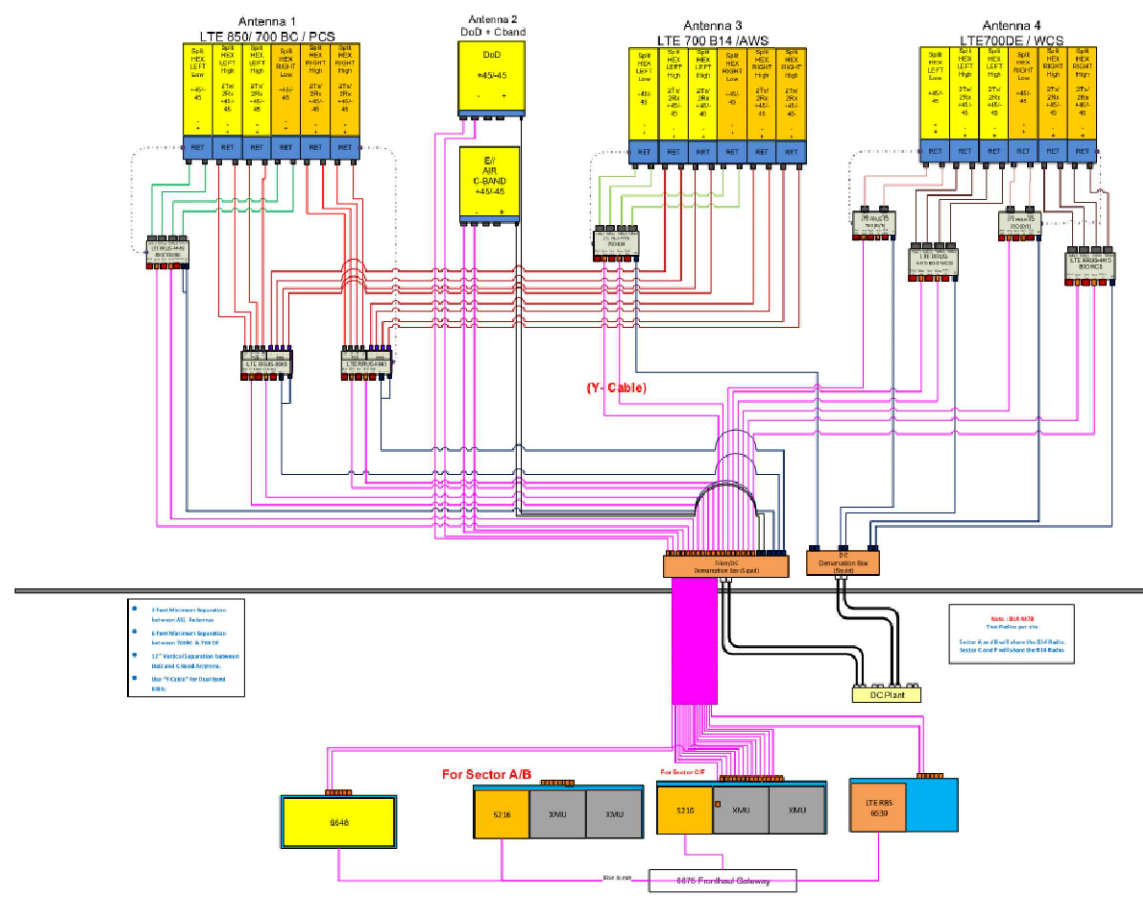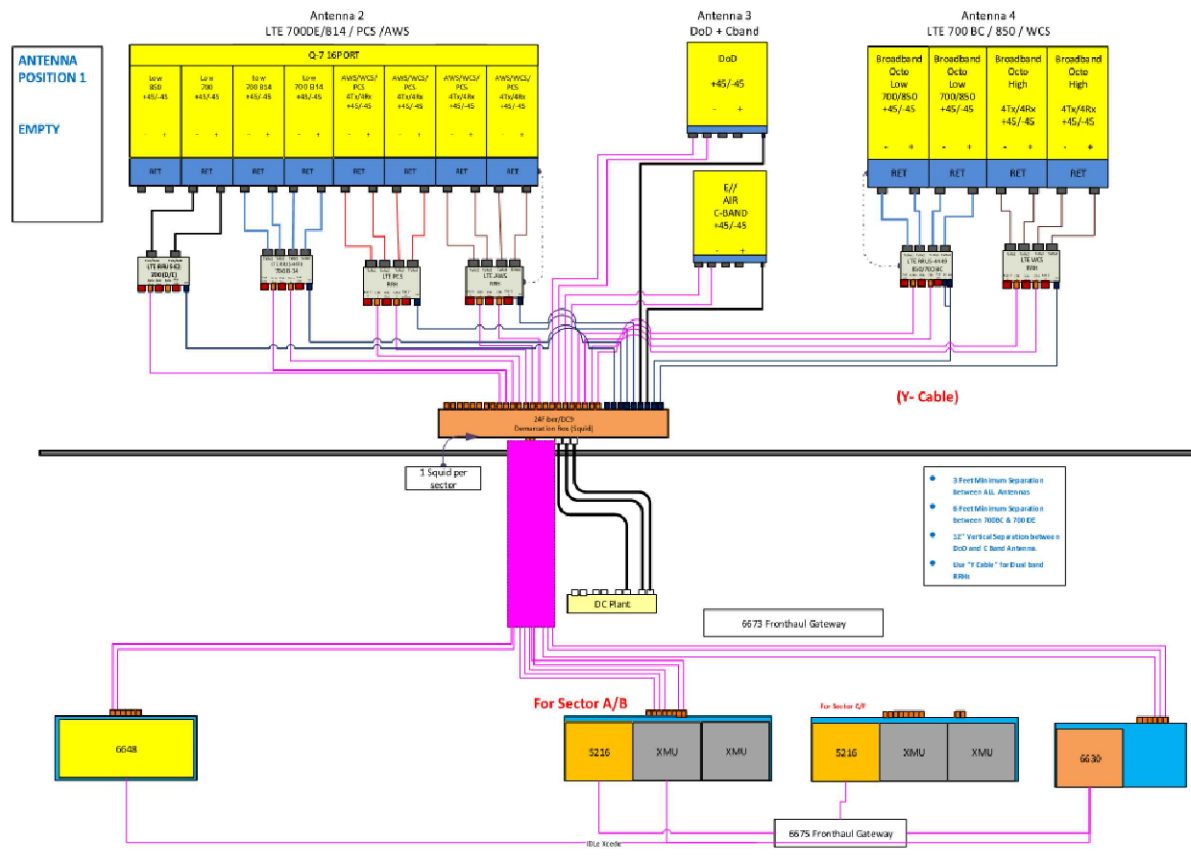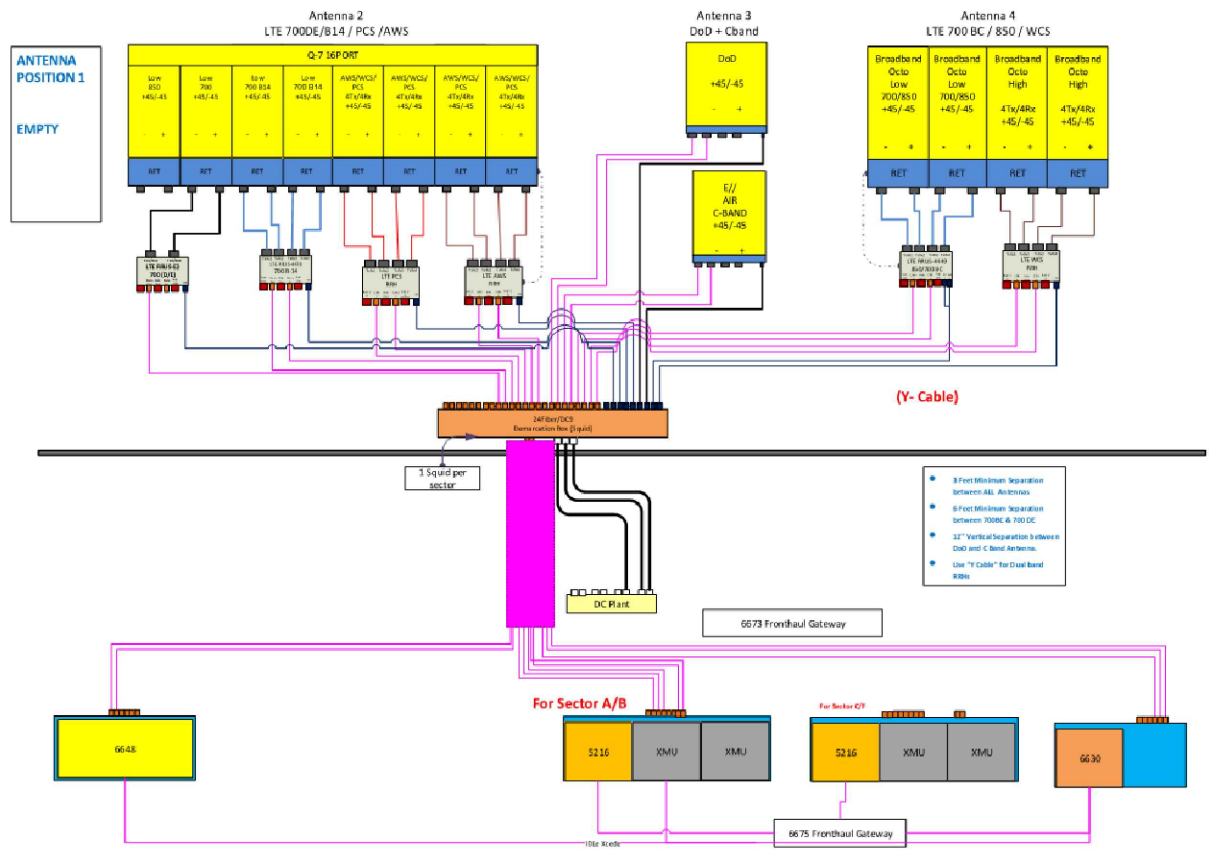

AS BUILT
Centerline Communications
Tristen Spear
2/8/23 8:47 AM

NOTE: THIS SHEET WAS CREATED BY OTHERS AND PROVIDED AT THE REQUEST OF THE CUSTOMER WITHOUT EDIT. GENERAL CONTRACTOR IS TO CHECK WITH THE AT&T CM TO ENSURE THIS IS THE MOST RECENT VERSION OF THE RFDS.

AMERICAN TOWER®

Dewberry®
Dewberry Engineers Inc.
99 SUMMER STREET
SUITE 700
BOSTON, MA 02110
PHONE: 617.695.3400
FAX: 617.695.3310

ATC SITE NUMBER:
88018

ATC SITE NAME:
STAMFORD (KATOONA)

AT&T SITE NAME:
STAMFORD WEST

SITE ADDRESS:
168 CATOONA LANE
STAMFORD, CT 06902-4573

AT&T

DATE DRAWN:	12/10/21
ATC JOB NO:	13683396_D1
CUSTOMER ID:	CTL02135
CUSTOMER #:	10034997

SUPPLEMENTAL

SHEET NUMBER:	
R-603	

Copyright © 2022 ATC IP LLC, All Rights Reserved.



VICINITY MAP



SITE NUMBER: 88018

SITE ADDRESS: 168 CATOONA LANE

STAMFORD, CT 06902



LOCATION MAP



THESE DRAWINGS AND/OR THE ACCOMPANYING SPECIFICATION AS INSTRUMENTS OR SERVICE ARE THE EXCLUSIVE PROPERTY OF AMERICAN TOWER. THEIR USE AND PUBLICATION SHALL BE RESTRICTED TO THE ORIGINAL SITE FOR WHICH THEY ARE PREPARED. ANY USE OR DISCLOSURE OTHER THAN THAT WHICH RELATES TO AMERICAN TOWER OR THE SPECIFIED CARRIER IS STRICTLY PROHIBITED. TITLE TO THESE DOCUMENTS SHALL REMAIN THE PROPERTY OF AMERICAN TOWER WHETHER OR NOT THE PROJECT IS EXECUTED. NEITHER THE ARCHITECT NOR THE ENGINEER WILL BE PROVIDING ON-SITE CONSTRUCTION REVIEW OF THIS PROJECT. CONTRACTOR(S) MUST VERIFY ALL DIMENSIONS AND ADVISE AMERICAN TOWER OF ANY DISCREPANCIES. ANY PRIOR ISSUANCE OF THIS DRAWING IS SUPERSEDED BY THE LATEST VERSION ON FILE WITH AMERICAN TOWER.

REV.	DESCRIPTION	BY	DATE
0	FIRST ISSUE	KPJ	07/14/22

88018

STAMFORD (KATOONA)

SITE ADDRESS:
168 CATOONA LANE
STAMFORD, CT 06902



DRAWN BY:	KPJ
APPROVED BY:	MCC
DATE DRAWN:	07/14/22
ATC JOB NO:	13683396_C9_10

G-001

C

[illegible]


GENERAL

1. ALL WORK TO BE COMPLETED PER APPLICABLE LOCAL, STATE, FEDERAL CODES AND ORDINANCES AND COMPLY WITH ATC CONSTRUCTION SPECIFICATIONS FOR WIRELESS TOWER SITES. THE CONTRACTOR IS RESPONSIBLE FOR OBTAINING AND ABIDING BY ALL REQUIRED PERMITS.
2. ALL WORK INDICATED ON THESE DRAWINGS SHALL BE PERFORMED BY QUALIFIED CONTRACTORS EXPERIENCED IN TOWER AND FOUNDATION CONSTRUCTION.
3. THE CONTRACTOR SHALL NOTIFY THE ENGINEER OF RECORD IMMEDIATELY OF ANY INSTALLATION INTERFERENCES. ALL NEW WORK SHALL ACCOMMODATE EXISTING CONDITIONS. DETAILS NOT SPECIFICALLY SHOWN ON THE DRAWINGS SHALL FOLLOW SIMILAR DETAILS FOR THIS JOB.
4. ANY SUBSTITUTIONS SHALL CONFORM TO THE REQUIREMENTS OF THESE NOTES AND SPECIFICATIONS, AND SHOULD BE SIMILAR TO THOSE SHOWN. ALL SUBSTITUTIONS SHALL BE SUBMITTED TO THE ENGINEER OF RECORD FOR REVIEW AND APPROVAL PRIOR TO FABRICATION.
5. ANY MANUFACTURED DESIGN ELEMENTS SHALL CONFORM TO THE REQUIREMENTS OF THESE NOTES AND SPECIFICATIONS AND SHOULD BE SIMILAR TO THOSE SHOWN. THESE DESIGN ELEMENTS MUST BE STAMPED BY AN ENGINEER PROFESSIONALLY REGISTERED IN THE STATE OF THE PROJECT, AND SUBMITTED TO THE ENGINEER OF RECORD FOR APPROVAL PRIOR TO FABRICATION.
6. ALL WORK SHALL BE DONE IN ACCORDANCE WITH LOCAL CODES AND OSHA SAFETY REGULATIONS.
7. THE CONTRACTOR IS RESPONSIBLE FOR THE DESIGN AND EXECUTION OF ALL MISCELLANEOUS SHORING, BRACING, TEMPORARY SUPPORTS, ETC. NECESSARY, PER ANSI/TIA-322 AND ANSI/ASSE A10.48, TO PROVIDE A COMPLETE AND STABLE STRUCTURE AS SHOWN ON THESE DRAWINGS.
8. CONTRACTOR'S PROPOSED INSTALLATION SHALL NOT INTERFERE, NOR DENY ACCESS TO, ANY EXISTING OPERATIONAL AND SAFETY EQUIPMENT.

STRUCTURAL STEEL

1. ALL DETAILING, FABRICATION AND ERECTION OF STRUCTURAL STEEL SHALL CONFORM TO THE AISC SPECIFICATIONS, LATEST EDITION.
2. ALL EXPOSED STRUCTURAL STEEL MEMBERS SHALL BE HOT-DIPPED GALVANIZED AFTER FABRICATION PER ASTM A123. EXPOSED STEEL HARDWARE AND ANCHOR BOLTS SHALL BE GALVANIZED PER ASTM A153 OR B695.
3. ALL U-BOLTS SHALL BE ASTM A36 OR EQUIVALENT, WITH LOCKING DEVICE, UNLESS NOTED OTHERWISE.
4. FIELD CUT EDGES, EXCEPT DRILLED HOLES, SHALL BE GROUND SMOOTH.
5. ALL FIELD CUT SURFACES, FIELD DRILLED HOLES & GROUND SURFACES WHERE EXISTING PAINT OR GALVANIZATION REMOVAL WAS REQUIRED SHALL BE REPAIRED WITH (2) BRUSHED COATS OF ZRC GALVILITE COLD GALVANIZING COMPOUND PER ASTM A780 AND MANUFACTURERS RECOMMENDATIONS.
6. ALL STRUCTURAL STEEL EMBEDDED IN THE CONCRETE SHALL BE APPLIED WITH (2) BRUSHED COATS OF POLYGUARD CA-14 MASTIC OR EQUIVALENT. REFER TO THE MANUFACTURER SPECIFICATIONS FOR SURFACE PREPARATION AND APPLICATION. APPLICATION OF POLYGUARD 400 WRAP IS NOT ESSENTIAL.
7. CONTRACTOR SHALL PERFORM WORK ON ONLY ONE (1) TOWER FACE AND REPLACE/REINFORCE ONE (1) BOLT/MEMBER AT A TIME.
8. ALL FIELD DRILLED HOLES TO BE USED FOR FIELD BOLTING INSTALLATION SHALL BE STANDARD HOLES, AS DEFINED BY AISC, UNLESS NOTED OTHERWISE.

MAXIMUM ALLOWABLE ANGLE CLIP

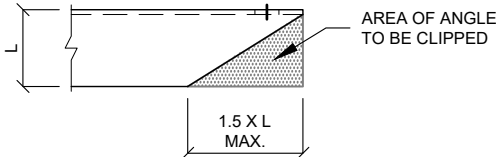

PAINT

1. AS REQUIRED, CLEAN AND PAINT PROPOSED STEEL ACCORDING TO FAA ADVISORY CIRCULAR AC 70/7460-1L.

WELDING

1. ALL WELDING TO BE PERFORMED BY AWS CERTIFIED WELDERS AND CONDUCTED IN ACCORDANCE WITH THE LATEST EDITION OF THE AWS WELDING CODE D1.1.
2. ALL WELDS SHALL BE INSPECTED VISUALLY. IF DIRECTED BY ENGINEER OF RECORD, 25% OF WELDS SHALL BE INSPECTED WITH DYE PENETRANT OR MAGNETIC PARTICLE (100% IF REJECTABLE DEFECTS ARE FOUND) TO MEET THE ACCEPTANCE CRITERIA OF AWS D1.1. REPAIR ALL WELDS AS NECESSARY.
3. INSPECTION SHALL BE PERFORMED BY AN AWS CERTIFIED WELD INSPECTOR.
4. ALL ELECTRODES TO BE LOW HYDROGEN, MATCHING FILLER AND/OR BASE METAL, PER AWS D1.1, UNLESS NOTED OTHERWISE.
5. IN CASES WHERE BASE METAL GRADE IS UNKNOWN, ALL WELDING ON LATTICE TOWERS SHALL BE DONE WITH E70XX ELECTRODES; ALL WELDING ON POLE STRUCTURES SHALL BE DONE WITH E80XX ELECTRODES, UNLESS NOTED OTHERWISE.
6. PRIOR TO FIELD WELDING GALVANIZED MATERIAL, CONTRACTOR SHALL GRIND OFF GALVANIZING 1/2" BEYOND ALL FIELD WELD SURFACES. AFTER WELD AND WELD INSPECTION IS COMPLETE, REPAIR ALL GROUND AND WELDED SURFACES WITH ZRC GALVILITE COLD GALVANIZING COMPOUND PER ASTM A780 AND MANUFACTURERS RECOMMENDATIONS.

BOLT TIGHTENING PROCEDURE

1. STRUCTURAL CONNECTIONS TO BE ASSEMBLED AND INSPECTED IN ACCORDANCE WITH RCSC SPECIFICATIONS.
2. FLANGE BOLTS SHALL BE INSTALLED AND TIGHTENED USING DIRECT TENSION INDICATING (DTI) SQUIRTER WASHERS. DTI SQUIRTER WASHERS ARE TO BE INSTALLED AND ORIENTED / TIGHTENED PER MANUFACTURER SPECIFICATIONS TO ACHIEVE DESIRED LEVEL OF BOLT PRE-TENSION.
3. IN LIEU OF USING DTI SQUIRTER WASHERS, FLANGE BOLTS MAY BE TIGHTENED USING AISC / RCSC "TURN-OF-THE-NUT" METHOD, PENDING APPROVAL BY THE ENGINEER OF RECORD (EOR). TIGHTEN FLANGE BOLTS USING THE CHART BELOW:

BOLT LENGTHS UP TO AND INCLUDING FOUR DIAMETERS

1/2"	BOLTS UP TO AND INCLUDING 2.0 INCH LENGTH	+1/3 TURN BEYOND SNUG TIGHT
5/8"	BOLTS UP TO AND INCLUDING 2.5 INCH LENGTH	+1/3 TURN BEYOND SNUG TIGHT
3/4"	BOLTS UP TO AND INCLUDING 3.0 INCH LENGTH	+1/3 TURN BEYOND SNUG TIGHT
7/8"	BOLTS UP TO AND INCLUDING 3.5 INCH LENGTH	+1/3 TURN BEYOND SNUG TIGHT
1"	BOLTS UP TO AND INCLUDING 4.0 INCH LENGTH	+1/3 TURN BEYOND SNUG TIGHT
1-1/8"	BOLTS UP TO AND INCLUDING 4.5 INCH LENGTH	+1/3 TURN BEYOND SNUG TIGHT
1-1/4"	BOLTS UP TO AND INCLUDING 5.0 INCH LENGTH	+1/3 TURN BEYOND SNUG TIGHT
1-3/8"	BOLTS UP TO AND INCLUDING 5.5 INCH LENGTH	+1/3 TURN BEYOND SNUG TIGHT
1-1/2"	BOLTS UP TO AND INCLUDING 6.0 INCH LENGTH	+1/3 TURN BEYOND SNUG TIGHT

BOLT LENGTHS OVER FOUR DIAMETERS BUT NOT EXCEEDING EIGHT DIAMETERS

1/2"	BOLTS 2.25 TO 4.0 INCH LENGTH	+1/2 TURN BEYOND SNUG TIGHT
5/8"	BOLTS 2.75 TO 5.0 INCH LENGTH	+1/2 TURN BEYOND SNUG TIGHT
3/4"	BOLTS 3.25 TO 6.0 INCH LENGTH	+1/2 TURN BEYOND SNUG TIGHT
7/8"	BOLTS 3.75 TO 7.0 INCH LENGTH	+1/2 TURN BEYOND SNUG TIGHT
1"	BOLTS 4.25 TO 8.0 INCH LENGTH	+1/2 TURN BEYOND SNUG TIGHT
1-1/8"	BOLTS 4.75 TO 9.0 INCH LENGTH	+1/2 TURN BEYOND SNUG TIGHT
1-1/4"	BOLTS 5.25 TO 10.0 INCH LENGTH	+1/2 TURN BEYOND SNUG TIGHT
1-3/8"	BOLTS 5.75 TO 11.0 INCH LENGTH	+1/2 TURN BEYOND SNUG TIGHT
1-1/2"	BOLTS 6.25 TO 12.0 INCH LENGTH	+1/2 TURN BEYOND SNUG TIGHT

BOLT TIGHTENING PROCEDURE (CONTINUED)

4. SPLICE BOLTS SUBJECT TO DIRECT TENSION SHALL BE INSTALLED AND TIGHTENED AS PER SECTION 8.2.1 OF THE AISC "SPECIFICATION FOR STRUCTURAL JOINTS USING A325 OR A490 BOLTS", LOCATED IN THE AISC MANUAL OF STEEL CONSTRUCTION. THE INSTALLATION PROCEDURE IS PARAPHRASED AS FOLLOWS:

FASTENERS SHALL BE INSTALLED IN PROPERLY ALIGNED HOLES AND TIGHTENED BY ONE OF THE METHODS DESCRIBED IN SUBSECTION 8.2.1 THROUGH 8.2.4.

8.2.1 TURN-OF-NUT PRETENSIONING
BOLTS SHALL BE INSTALLED IN ALL HOLES OF THE CONNECTION AND BROUGHT TO A SNUG TIGHT CONDITION AS DEFINED IN SECTION 8.1, UNTIL ALL THE BOLTS ARE SIMULTANEOUSLY SNUG TIGHT AND THE CONNECTION IS FULLY COMPACTED. FOLLOWING THIS INITIAL OPERATION ALL BOLTS IN THE CONNECTION SHALL BE TIGHTENED FURTHER BY THE APPLICABLE AMOUNT OF ROTATION SPECIFIED ABOVE. DURING THE TIGHTENING OPERATION THERE SHALL BE NO ROTATION OF THE PART NOT TURNED BY THE WRENCH. TIGHTENING SHALL PROGRESS SYSTEMATICALLY.

5. ALL OTHER BOLTED CONNECTIONS SHALL BE BROUGHT TO A SNUG TIGHT CONDITION AS DEFINED IN SECTION 8.1 OF THE SPECIFICATION.

ALL BOLT HOLES SHALL BE ALIGNED TO PERMIT INSERTION OF THE BOLTS WITHOUT UNDUE DAMAGE TO THE THREADS. BOLTS SHALL BE PLACED IN ALL HOLES WITH WASHERS POSITIONED AS REQUIRED AND NUTS THREADED TO COMPLETE THE ASSEMBLY. COMPACTING THE JOINT TO THE SNUG-TIGHT CONDITION SHALL PROGRESS SYSTEMATICALLY FROM THE MOST RIGID PART OF THE JOINT. THE SNUG-TIGHTENED CONDITION IS THE TIGHTNESS THAT IS ATTAINED WITH A FEW IMPACTS OF AN IMPACT WRENCH OR THE FULL EFFORT OF AN IRONWORKER USING AN ORDINARY SPUD WRENCH TO BRING THE CONNECTED PLIES INTO FIRM CONTACT.

AS BUILT
Centerline Communications
Tristen Spear
2/8/23 8:47 AM

MODIFICATION INSPECTION NOTES

THE MOUNT MODIFICATION INSPECTION (MMI) PROCEDURE IS INTENDED TO CONFIRM THAT CONSTRUCTION AND INSTALLATION MEETS ENGINEERING DESIGN, ATC PROCEDURES AND ATC STANDARD SPECIFICATIONS FOR WIRELESS TOWER SITES.

TO ENSURE THAT THE REQUIREMENTS OF THE MMI ARE MET, IT IS VITAL THAT THE GENERAL CONTRACTOR SUBMIT ALL REQUIRED PHOTOGRAPHS AND DRAWINGS TO AMERICAN TOWER CORPORATION (ATC).

GENERAL CONTRACTOR

THE GENERAL CONTRACTOR IS REQUIRED TO:

- REVIEW THE REQUIREMENTS OF THE MMI CHECKLIST.
- UNDERSTAND ALL INSPECTION REQUIREMENTS.

THE GENERAL CONTRACTOR SHALL PERFORM AND RECORD THE INSPECTION RESULTS IN ACCORDANCE WITH THE REQUIREMENTS OF THE MMI CHECKLIST.

MOUNT MODIFICATION INSPECTION CHECKLIST			
INSPECTION DOCUMENT	DESCRIPTION	INSPECTION TESTING REQUIRED	RESPONSIBILITY
ON-SITE COLD GALVANIZING VERIFICATION	PHOTOGRAPHIC EVIDENCE OF COLD GALVANIZATION TYPE AND APPLICATION IN ALL APPLICABLE LOCATIONS TO BE INCLUDED WITHIN THE MMI REPORT	✓	GC
GC AS-BUILT DRAWINGS WITH CONSTRUCTION RED-LINES	"AS-BUILT" DRAWINGS INDICATING ANY APPROVED CHANGES TO ENGINEERED PLANS TO MMI FOR APPROVAL/REVIEW AND INCLUSION IN MMI REPORT	✓	GC
PHOTOGRAPHS	PHOTOGRAPHIC EVIDENCE OF MOUNT MODIFICATION INSPECTION, ON SITE REMEDIATION, AND ITEMS FAILING INSPECTION & REQUIRING FOLLOW UP TO BE INCLUDED WITHIN THE MMI REPORT. COMPLETE PHOTO LOG IS TO BE SUBMITTED WITHIN MMI REPORT.	✓	GC

TABLE KEY:
MMI - MOUNT MODIFICATION INSPECTION
GC - GENERAL CONTRACTOR
ATC - AMERICAN TOWER CORPORATION



AMERICAN TOWER®
A.T. ENGINEERING SERVICE, PLLC
3500 REGENCY PARKWAY
SUITE 100
CARY, NC 27518
PHONE: (919) 468-0112
COA: PEC.0001553

THESE DRAWINGS AND/OR THE ACCOMPANYING SPECIFICATION AS INSTRUMENTS OR SERVICE ARE THE EXCLUSIVE PROPERTY OF AMERICAN TOWER. THEIR USE AND PUBLICATION SHALL BE RESTRICTED TO THE ORIGINAL SITE FOR WHICH THEY ARE PREPARED. ANY USE OR DISCLOSURE OTHER THAN THAT WHICH RELATES TO AMERICAN TOWER OR THE SPECIFIED CARRIER IS STRICTLY PROHIBITED. TITLE TO THESE DOCUMENTS SHALL REMAIN THE PROPERTY OF AMERICAN TOWER WHETHER OR NOT THE PROJECT IS EXECUTED. NEITHER THE ARCHITECT NOR THE ENGINEER WILL BE PROVIDING ON-SITE CONSTRUCTION REVIEW OF THIS PROJECT. CONTRACTOR(S) MUST VERIFY ALL DIMENSIONS AND ADVISE AMERICAN TOWER OF ANY DISCREPANCIES. ANY PRIOR ISSUANCE OF THIS DRAWING IS SUPERSEDED BY THE LATEST VERSION ON FILE WITH AMERICAN TOWER.

REV.	DESCRIPTION	BY	DATE
△	FIRST ISSUE	KPJ	07/14/22
△			
△			
△			
△			

ATC SITE NUMBER:

88018

ATC SITE NAME:

STAMFORD (KATOONA)

CONNECTICUT

SITE ADDRESS:

168 CATOONA LANE
STAMFORD, CT 06902



DRAWN BY:	KPJ
APPROVED BY:	MCC
DATE DRAWN:	07/14/22
ATC JOB NO:	13683396_C9_10


IBC GENERAL NOTES & MOUNT MODIFICATION INSPECTION

SHEET NUMBER:


G-002

REVISION:


0

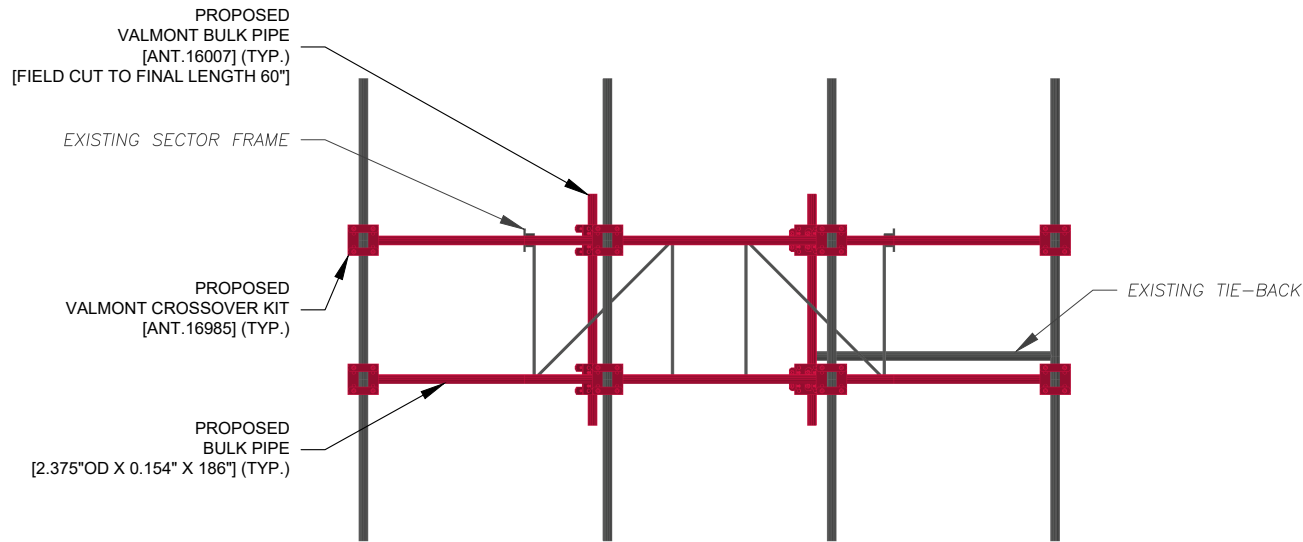


MOUNT MODIFICATION
FRONT VIEW

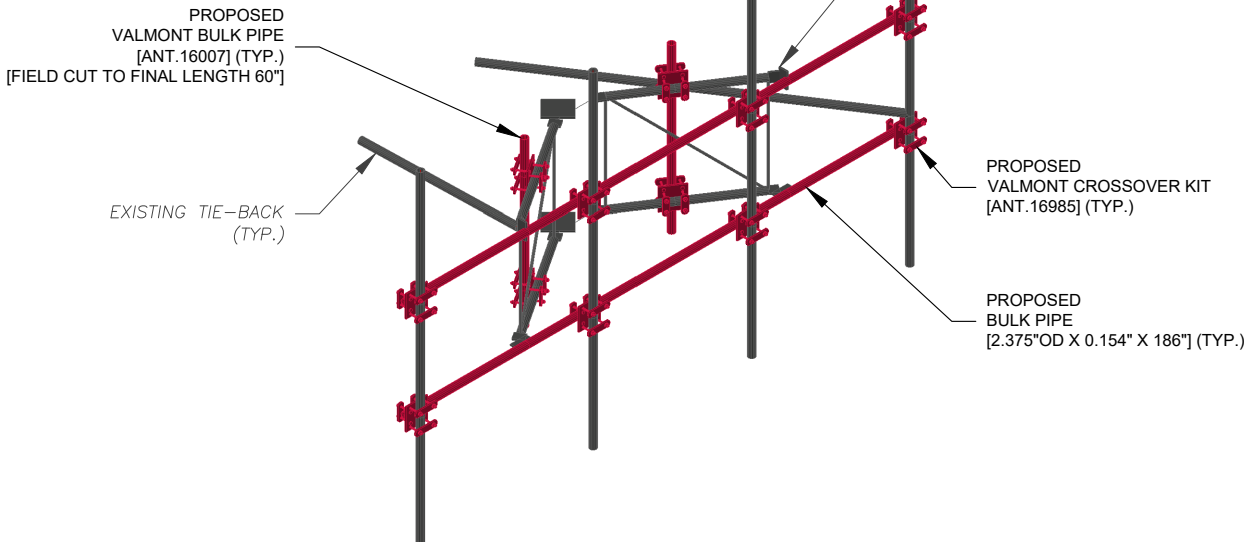

MOUNT MODIFICATION
ISOMETRIC VIEW

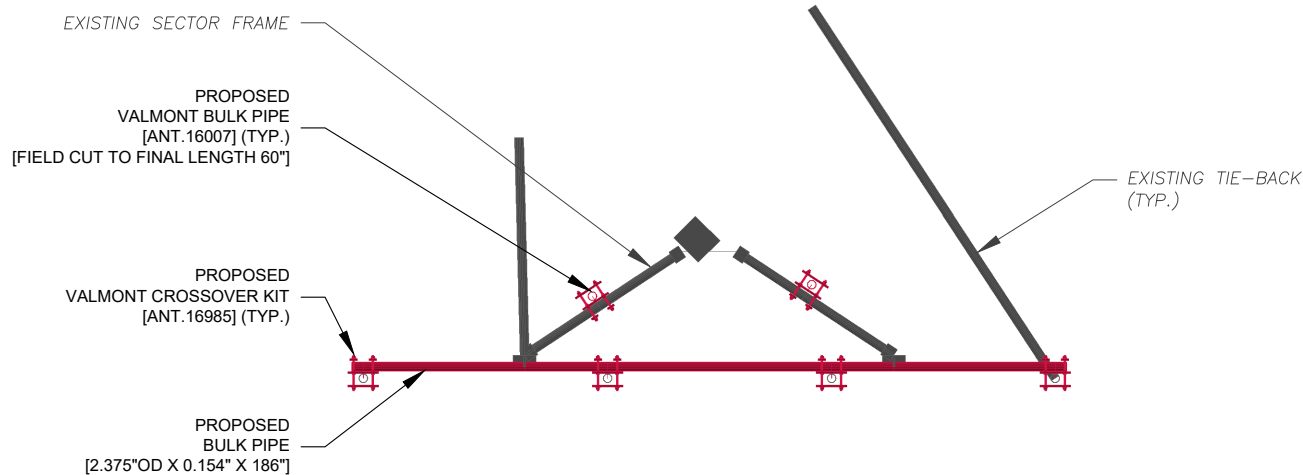

MOUNT MODIFICATION
TOP VIEW

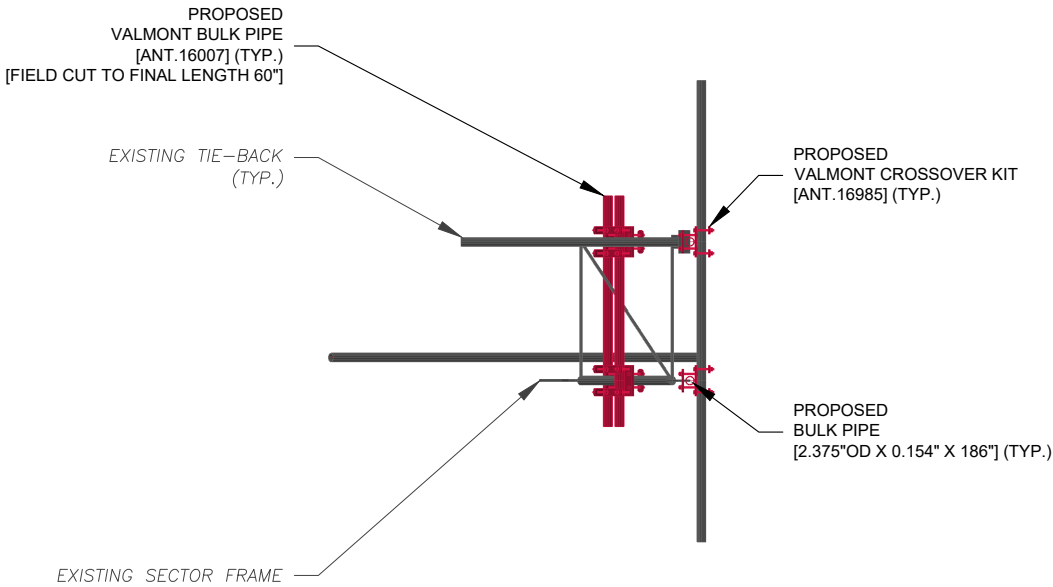

MOUNT MODIFICATION
SIDE VIEW

AS BUILT
Centerline Communications
Tristen Spear
2/8/23 8:47 AM

- NOTES:**
- CONTRACTOR TO REPLACE EXISTING FACE HORIZONTAL PIPES.
 - IN THE EVENT A PROPOSED MODIFICATION PART LISTED IN THE DRAWINGS IS NOT AVAILABLE, AN APPROVED EQUIVALENT CAN BE SUBSTITUTED. FOR APPROVAL OF EQUIVALENT PART OR QUESTIONS PLEASE CONTACT AMERICAN TOWER PMI INBOX AT PMI@AMERICANTOWER.COM.

THESE DRAWINGS AND/OR THE ACCOMPANYING SPECIFICATION AS INSTRUMENTS OR SERVICE ARE THE EXCLUSIVE PROPERTY OF AMERICAN TOWER. THEIR USE AND PUBLICATION SHALL BE RESTRICTED TO THE ORIGINAL SITE FOR WHICH THEY ARE PREPARED. ANY USE OR DISCLOSURE OTHER THAN THAT WHICH RELATES TO AMERICAN TOWER OR THE SPECIFIED CARRIER IS STRICTLY PROHIBITED. TITLE TO THESE DOCUMENTS SHALL REMAIN THE PROPERTY OF AMERICAN TOWER WHETHER OR NOT THE PROJECT IS EXECUTED. NEITHER THE ARCHITECT NOR THE ENGINEER WILL BE PROVIDING ON-SITE CONSTRUCTION REVIEW OF THIS PROJECT. CONTRACTOR(S) MUST VERIFY ALL DIMENSIONS AND ADVISE AMERICAN TOWER OF ANY DISCREPANCIES. ANY PRIOR ISSUANCE OF THIS DRAWING IS SUPERSEDED BY THE LATEST VERSION ON FILE WITH AMERICAN TOWER.


REV.	DESCRIPTION	BY	DATE
0	FIRST ISSUE	KPJ	07/14/22

ATC SITE NUMBER:
88018

ATC SITE NAME:
STAMFORD (KATOONA)

CONNECTICUT


SITE ADDRESS:
168 CATOONA LANE
STAMFORD, CT 06902

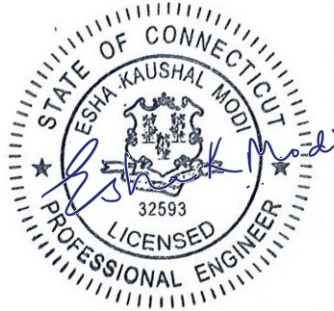

DRAWN BY:	KPJ
APPROVED BY:	MCC
DATE DRAWN:	07/14/22
ATC JOB NO:	13683396_C9_10

MODIFICATION PROFILE
(GAMMA SECTOR)

SHEET NUMBER:	REVISION:
S-102	0

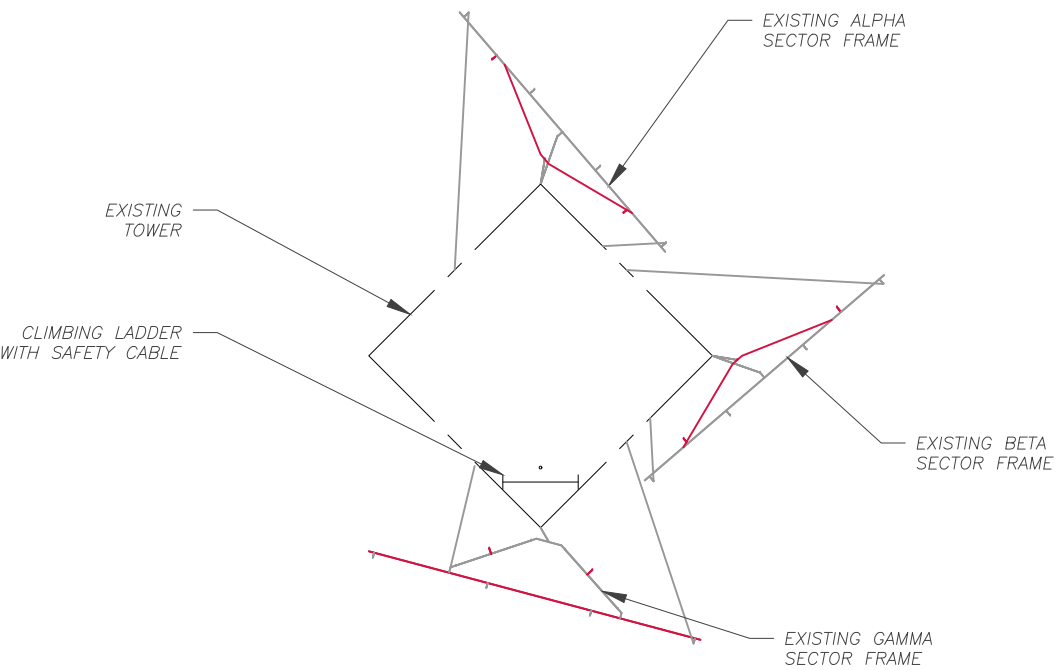

Gamma mods were existing

Redlined - C-401, S-103
Centerline Communications
Tristen Spear
2/8/23 8:47 AM

SAFETY CLIMB LOCATION



NOTE:
CONTRACTOR TO INSTALL MOUNT MODIFICATIONS PER THE MANUFACTURERS SPECIFICATION. MODIFICATIONS SHALL NOT OBSTRUCT, INTERFERE, OR BLOCK EXISTING SAFETY CLIMB SYSTEM. IF ANY OF THESE OCCURS DURING INSTALLATION CONTACT THE AMERICAN TOWER PMI INBOX PMI@AMERICANTOWER.COM



AMERICAN TOWER®
A.T. ENGINEERING SERVICE, PLLC
3500 REGENCY PARKWAY
SUITE 100
CARY, NC 27518
PHONE: (919) 468-0112
COA: PEC.0001553

THESE DRAWINGS AND/OR THE ACCOMPANYING SPECIFICATION AS INSTRUMENTS OR SERVICE ARE THE EXCLUSIVE PROPERTY OF AMERICAN TOWER. THEIR USE AND PUBLICATION SHALL BE RESTRICTED TO THE ORIGINAL SITE FOR WHICH THEY ARE PREPARED. ANY USE OR DISCLOSURE OTHER THAN THAT WHICH RELATES TO AMERICAN TOWER OR THE SPECIFIED CARRIER IS STRICTLY PROHIBITED. TITLE TO THESE DOCUMENTS SHALL REMAIN THE PROPERTY OF AMERICAN TOWER WHETHER OR NOT THE PROJECT IS EXECUTED. NEITHER THE ARCHITECT NOR THE ENGINEER WILL BE PROVIDING ON-SITE CONSTRUCTION REVIEW OF THIS PROJECT. CONTRACTOR(S) MUST VERIFY ALL DIMENSIONS AND ADVISE AMERICAN TOWER OF ANY DISCREPANCIES. ANY PRIOR ISSUANCE OF THIS DRAWING IS SUPERSEDED BY THE LATEST VERSION ON FILE WITH AMERICAN TOWER.

REV.	DESCRIPTION	BY	DATE
0	FIRST ISSUE	KPJ	07/14/22

ATC SITE NUMBER:
88018

ATC SITE NAME:
STAMFORD (KATOONA)
CONNECTICUT

SITE ADDRESS:
168 CATOONA LANE
STAMFORD, CT 06902



DRAWN BY:	KPJ
APPROVED BY:	MCC
DATE DRAWN:	07/14/22
ATC JOB NO:	13683396_C9_10

SAFETY CLIMB LAYOUT

SHEET NUMBER:	REVISION:
S-103	0

Option 1 - Modify: Estimate for AT&T Mobility @ 88018 (STAMFORD (KATOONA)) -- 13683396_C9_10

Site Data and Design Parameters			Dates and Designers		
Asset OTM #	88018		Mount Analysis Date / By	7/7/2022 /	BH
Asset Name	STAMFORD (KATOONA)		Design Date / By	7/13/2022 /	MCC
State	Connecticut		Checked Date / By	/	
County	Fairfield		Detailer (Prev/Current/Level) / /		
City	Stamford		Software	RISA	
Failing Analysis Eng. #	13683396_C8_09		Tower Type	Self-Support	4-sided
Mod. Drawing Eng. #	13683396_C9_10		Mount Type	T-Frame	
Building Codes	TIA/IBC:	ANSI/TIA-222-H / 2015 IBC			
	Local:	2018 Connecticut State Building Code			
Failing Analysis % / Code	103%	/ TIA-H			
Post Mod % / Controlling Member	63%	/ Connections			
Usage Limit % / Reason	100%	/ Jurisdiction			
Any modification design comments or assumptions? Yes <i>(including notes to the Estimator)</i>					
Gamma Sector: No structural failures were addressed with the noted modifications. Modifications address Carrier's antenna spacing requirements.					

Modification Summary	
Item #	Scope Item
1	Install Site Pro 1 SFS-V V Style Stabilizer (ANT.16461) on A & B sector(s)
2	Install 2.0" Pipe x 186" Pipe w/ Site Pro 1 SCX7-U (ANT.16985) crossovers on Gamma sector(s)*
3	Install 2.0" Pipe x 186" Pipe w/ Site Pro 1 SCX7-U (ANT.16985) crossovers on Gamma sector(s)*
4	Install Site Pro 1 P2126 (ANT.16007) MP w/ Site Pro 1 SCX7-U (ANT.16985) crossovers on A & B sector(s) at position 2.*
5	Install Site Pro 1 P2126 (ANT.16007) MP w/ Site Pro 1 SCX7-U (ANT.16985) crossovers on A & B sector(s) at position 5.*
6	Install Site Pro 1 P2126 (ANT.16007) MP w/ Site Pro 1 SCX7-U (ANT.16985) crossovers on Gamma sector(s) at position 5.*
7	Install Site Pro 1 P2126 (ANT.16007) MP w/ Site Pro 1 SCX7-U (ANT.16985) crossovers on Gamma sector(s) at position 6.*
8	Install Site Pro 1 TAM-3U Leg Mount with P472 Pipe on A & B tower legs

Estimated Modification Cost	\$16,000
-----------------------------	----------

Option 2 - Replace: Estimate for AT&T Mobility @ 88018 (STAMFORD (KATOONA)) -- 13683396_C9_10

Tower Info	
Tower Number	88018
Tower Name	STAMFORD (KATOONA)
State	Connecticut

Jurisdictional Codes	
Design TIA Code	Unknown
Current TIA Code	ANSI/TIA-222-H
IBC	2015 IBC
Other	2018 Connecticut State Building Code

Project Information	
Carrier	AT&T Mobility
Structure Type	Self-Support

Recommended Mount Replacement	
Sabre C10857007C*	

*or approved equivalent

Project Requirements		
New Mount Face Width	150	in
Number of Sectors	3	

Estimated Replacement Cost	\$ 36,000.00
----------------------------	--------------

AS BUILT
Centerline Communications
Tristen Spear
2/8/23 8:47 AM

SUPPLEMENTAL

SHEET NUMBER:

R-901

REVISION:

0



Post Modification Mount Analysis Report

ATC Site Name : STAMFORD (KATOONA), CT
ATC Site Number : 88018
Engineering Number : 13683396_C9_10
Mount Elevation : 236 ft
Carrier : AT&T Mobility
Carrier Site Name : MRCTB051681
Carrier Site Number : N/A
Site Location : 168 Catoona Lane
Stamford, CT 06902-4573
41.052825 , -73.56304722
County : Fairfield
Date : July 13, 2022
Max Usage : 63%
Result : Contingent Pass



Prepared By: Mitchell Chen
Structural Engineer II

Reviewed By:

COA: PEC.0001553

A.T. Engineering Service, PLLC - 3500 Regency Parkway, Suite 100 - Cary, NC 27518 - 919.468.0112 Office - 919.466.5414 Fax - www.americantower.com



Eng. Number 13683396_C9_10
July 13, 2022

Table of Contents

Introduction	1
Supporting Documents	1
Analysis	1
Conclusion	1
Application Loading	2
Structure Usages	2
Mount Layout	3
Equipment Layout	4
Standard Conditions	6
Calculations	Attached

A.T. Engineering Service, PLLC - 3500 Regency Parkway, Suite 100 - Cary, NC 27518 - 919.468.0112 Office - 919.466.5414 Fax - www.americantower.com



Eng. Number 13683396_C9_10
July 13, 2022
Page 1

Introduction

The purpose of this report is to summarize results of the mount analysis performed for AT&T Mobility at 236 ft.

Supporting Documents

Specification Sheets	Sabre C10857001C, dated November 15, 2021 MTS SF-U12, dated September 17, 2003
Mount Mapping	Engineered Tower Solutions Project #21094494, dated November 4, 2021
Radio Frequency Data Sheet	RFDS ID #10034997, dated October 25, 2021
Reference Photos	Site photos from 2021

Analysis

This mount was analyzed using American Tower Corporation's Mount Analysis Program and RISA-3D

Basic Wind Speed:	117 mph (3-Second Gust)
Basic Wind Speed w/ Ice:	50 mph (3-Second Gust) w/ 1.00" radial ice concurrent
Codes:	ANSI/TIA-222-H
Exposure Category:	B
Risk Category:	II
Topographic Factor Procedure:	Method 2
Feature:	Flat
Crest Height (H):	0 ft
Crest Length (L):	0 ft
Spectral Response:	Ss = 0.265, S1 = 0.059
Site Class:	D - Stiff Soil - Default
Live Loads:	Lm = 500 lbs, Lv = 250 lbs

Conclusion

Based on the analysis results, the antenna mount meets the requirements per the applicable codes listed above provided the modifications listed below are completed:

- Install modification per ATC Drawing #13683396_C9_10

If you have any questions or require additional information, please contact American Tower via email at Engineering@americantower.com. Please include the American Tower site name, site number, and engineering number in the subject line for any questions.

A.T. Engineering Service, PLLC - 3500 Regency Parkway, Suite 100 - Cary, NC 27518 - 919.468.0112 Office - 919.466.5414 Fax - www.americantower.com



Eng. Number 13683396_C9_10
July 13, 2022
Page 2

Application Loading

Mount Centerline (ft)	Equipment Centerline (ft)	Qty	Equipment Manufacturer & Model
236.0	237.0	3	Ericsson AIR 6449 n77D
	6		CCI BSA-M65R-BUJ-H6 (101 lbs)
	2		CCI DMP65R-BUGDA
	2		Quintel QD6616-7
	3		Powerwave Allgon TT19-088P111-001
	2		Raycap DC9-48-60-24-8C-EV
	2		Raycap DC6-48-60-18-8C-EV
	4		Ericsson RRUS E2 B29
	2		Ericsson RRUS 4415 B30
	3		Ericsson RRUS 4449 B5, B12
	2		Ericsson RRUS 4426 B66
	2		Ericsson RRUS 32 B30 (53 lbs)
	2		Ericsson RRUS 32 B2
	2		Ericsson RRUS 8843 B2, B66A
	3		Ericsson RRUS 4478 B14
	233.0	3	Ericsson AIR 6419 N77G

Structure Usages

Structural Component	Controlling Usage	Pass/Fail
Horizontals	52%	Pass
Verticals	15%	Pass
Diagonals	18%	Pass
Tie-Backs	10%	Pass
Mount Pipes	32%	Pass
Tower Leg Check	63%	Pass

A.T. Engineering Service, PLLC - 3500 Regency Parkway, Suite 100 - Cary, NC 27518 - 919.468.0112 Office - 919.466.5414 Fax - www.americantower.com



A.T. ENGINEERING SERVICE, PLLC
3500 REGENCY PARKWAY
SUITE 100
CARY, NC 27518
PHONE: (919) 468-0112
COA: PEC.0001553

THESE DRAWINGS AND/OR THE ACCOMPANYING SPECIFICATION AS INSTRUMENTS OR SERVICE ARE THE EXCLUSIVE PROPERTY OF AMERICAN TOWER. THEIR USE AND PUBLICATION SHALL BE RESTRICTED TO THE ORIGINAL SITE FOR WHICH THEY ARE PREPARED. ANY USE OR DISCLOSURE OTHER THAN THAT WHICH RELATES TO AMERICAN TOWER OR THE SPECIFIED CARRIER IS STRICTLY PROHIBITED. TITLE TO THESE DOCUMENTS SHALL REMAIN THE PROPERTY OF AMERICAN TOWER WHETHER OR NOT THE PROJECT IS EXECUTED. NEITHER THE ARCHITECT NOR THE ENGINEER WILL BE PROVIDING ON-SITE CONSTRUCTION REVIEW OF THIS PROJECT. CONTRACTOR(S) MUST VERIFY ALL DIMENSIONS AND ADVISE AMERICAN TOWER OF ANY DISCREPANCIES. ANY PRIOR ISSUANCE OF THIS DRAWING IS SUPERSEDED BY THE LATEST VERSION ON FILE WITH AMERICAN TOWER.

REV.	DESCRIPTION	BY	DATE
0	FIRST ISSUE	KPJ	07/14/22

ATC SITE NUMBER:
88018
ATC SITE NAME:
STAMFORD (KATOONA)
CONNECTICUT
SITE ADDRESS:
168 CATOONA LANE
STAMFORD, CT 06902



DRAWN BY:	KPJ
APPROVED BY:	MCC
DATE DRAWN:	07/14/22
ATC JOB NO:	13683396_C9_10


SUPPLEMENTAL

SHEET NUMBER:
R-902
REVISION:
0



Eng. Number 13683396_C9_10
July 13, 2022
Page 3

Mount Layout

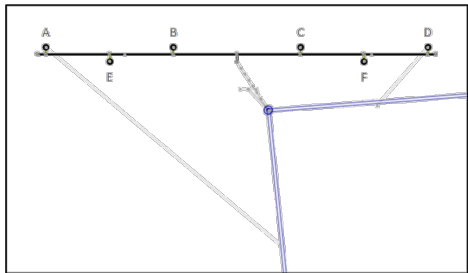


A.T. Engineering Service, PLLC - 3500 Regency Parkway, Suite 100 - Cary, NC 27518 - 919.468.0112 Office - 919.466.5414 Fax - www.americantower.com



Eng. Number 13683396_C9_10
July 13, 2022
Page 4

Equipment Layout

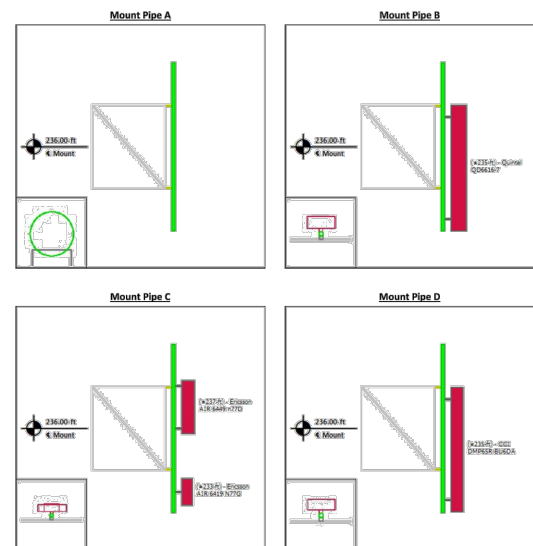


A.T. Engineering Service, PLLC - 3500 Regency Parkway, Suite 100 - Cary, NC 27518 - 919.468.0112 Office - 919.466.5414 Fax - www.americantower.com



Eng. Number 13683396_C9_10
July 13, 2022
Page 5

Equipment Layout Cont'd.

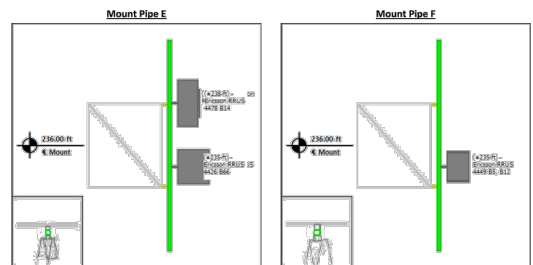

A.T. Engineering Service, PLLC - 3500 Regency Parkway, Suite 100 - Cary, NC 27518 - 919.468.0112 Office - 919.466.5414 Fax - www.americantower.com

AS BUILT
Centerline Communications
Tristen Spear
2/8/23 8:47 AM



Eng. Number 13683396_C9_10
July 13, 2022
Page 6

Standard Conditions

All engineering services performed by A.T. Engineering Service, PLLC are prepared on the basis that the information used is current and correct. This information may consist of, but is not limited to the following:

- Information supplied by the client regarding equipment, mounts and feed line loading
- Information from drawings, design and analysis documents, and field notes in the possession of A.T. Engineering Service, PLLC

It is the responsibility of the client to ensure that the information provided to A.T. Engineering Service, PLLC and used in the performance of our engineering services is correct and complete.

American Tower assumes that all structures were constructed in accordance with the drawings and specifications.

All connections are to be verified for condition and tightness by the installation contractor preceding any changes to the appurtenance mounting system and/or equipment attached to it.

Unless explicitly agreed by both the client and A.T. Engineering Service, PLLC, all services will be performed in accordance with the current revision of ANSI/TIA-222.

Installation of all equipment and steel should be confirmed not to cause tower conflicts nor impede the tower climbing pegs.

All services are performed, results obtained, and recommendations made in accordance with generally accepted engineering principles and practices. A.T. Engineering Service, PLLC is not responsible for the conclusions, opinions and recommendations made by others based on the information supplied herein.

A.T. Engineering Service, PLLC - 3500 Regency Parkway, Suite 100 - Cary, NC 27518 - 919.468.0112 Office - 919.466.5414 Fax - www.americantower.com



Site Number: 88018
Project Number: 13683396_C9_10
Carrier: AT&T Mobility
Mount Elevation: 236 ft
Date: 7/13/2022

Mount Analysis Force Calculations

Wind & Ice Load Calculations				Seismic Load Calculations			
Velocity Pressure Coefficient	K_z	1.26		Short Period DSRAP	S_{DS}	0.212	
Topographic Factor	K_{zt}	1.00		1 Second DSRAP	S_{D1}	0.094	
Rooftop Wind Speed-up Factor	K_{zs}	1.00		Importance Factor	I	1.0	
Shielding Factor	K_d	0.90		Response Modification Coefficient	R	2.0	
Ground Elevation Factor	K_e	1.00		Seismic Response Coefficient	C_s	0.106	
Wind Direction Probability Factor	K_d	0.95		Amplification Factor	A	1.0	
Basic Wind Speed	V	117	mph	Total Weight	W	1322.4	lbs
Velocity Pressure	q_z	42.0	psf	Total Shear Force	V_p	140.2	lbs
Height Exaltation Factor	K_{e2}	1.22		Horizontal Seismic Load	H	140.2	lbs
Thickness of Radial Glaze Ice	T_{gi}	1.22	in	Vertical Seismic Load	E_v	56.1	lbs

Antenna Calculations (Elevations per Application/RFD5)*									
Equipment Model #	Height in	Width in	Depth in	Weight lbs	EPA_{ht} sqft	EPA_{wt} sqft	EPA_{ht} sqft	EPA_{wt} sqft	
Ericsson AIR 6449 n77D	30.4	15.9	8.1	81.6	4.03	1.34	5.02	1.88	
CCI BSA-M65R-BUU-H6 (101 lbs)	72.0	28.5	9.7	101.0	N/A	N/A	N/A	N/A	
CCI DMP65R-BUGDA	71.2	20.7	7.7	79.4	12.71	2.28	14.69	3.11	
Quintel QD6616-7	72.0	22.0	9.6	130.0	13.58	2.88	15.59	3.73	
Powerwave Algon TT19-088P111-001	9.9	6.7	5.4	16.0	N/A	N/A	N/A	N/A	
Raycap DC9-48-60-24-8C-EV	31.4	18.3	10.2	16.0	N/A	N/A	N/A	N/A	
Raycap DC9-48-60-18-8C-EV	31.4	18.3	10.2	16.0	N/A	N/A	N/A	N/A	
Ericsson RRUS E2 829	30.4	18.5	7.5	60.0	3.15	1.29	3.98	1.91	
Ericsson RRUS 4415 830	16.5	13.4	5.9	46.0	1.84	0.82	2.50	1.33	
Ericsson RRUS 4449 85, B12	17.9	13.2	9.4	71.0	1.97	1.40	2.65	2.01	
Ericsson RRUS 4426 866	15.0	13.2	5.8	48.4	1.65	0.73	2.27	1.20	
Ericsson RRUS 32 830 (53 lbs)	27.2	12.1	7.0	53.0	N/A	N/A	N/A	N/A	
Ericsson RRUS 32 B2	27.2	12.1	7.0	53.0	2.74	1.67	3.59	2.45	
Ericsson RRUS 8843 B2, B66A	14.9	13.2	10.9	72.0	N/A	N/A	N/A	N/A	
Ericsson RRUS 4478 B14	16.5	13.4	7.7	59.9	1.84	1.06	2.50	1.60	
Ericsson AIR 6419 N77G	15.7	30.0	6.7	70.0	3.93	0.38	4.90	0.59	


* Equipment with EPA values N/A were not considered in the mount analysis



Site Number: 88018
Project Number: 13683396_C9_10
Carrier: AT&T Mobility
Mount Elevation: 236 ft
Date: 7/13/2022

Tower Leg Reaction Analysis

Applied Loads from RISA 3D			
Controlling Load Combination	72		
Leg Node Label(s)	N006 N067 N069		
Force in X, F_x	-307.0	-286.2	-259.2 lbs
Force in Y, F_y	184.9	752.6	267.0 lbs
Force in Z, F_z	-25.3	414.3	214.8 lbs
Moment about X, M_x	-50.8	-636.2	-40.5 lb-ft
Moment about Y, M_y	-987.8	-396.2	-385.2 lb-ft
Moment about Z, M_z	45.6	451.5	358.8 lb-ft

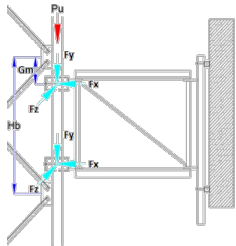

Tower Leg Properties			
Leg Type	Single Angle		
Leg Member	L6x6x3/16		
Leg Bay Height	Hb	6.27	ft
Upper Mount Offset	Gm	6.00	in
Tower Axial Load			
Leg Grade		A36	
Leg Yield Strength	F_y	36	ksi
Cross Sectional Area	A_g	6.450	in ²
Radius of Gyration	r	1.180	in
Moment of Inertia	I	8.900	in ⁴
Section Modulus	S_{xx}	3.730	in ³
Plastic Modulus	Z_{xx}	9.180	in ³
Torsional Constant	J	0.704	in ⁴
Elastic Modulus	E	29,000	ksi
Shear Modulus	G	11,200	ksi
Slenderness Limit	$4.71\sqrt{E/F_y}$	133.7	-
Member Slenderness	KL/r	63.8	-
Rotation of Leg	θ	0.0000	rads
Leg Torsional Stiffness	k	1181.5	k-in/rad


Tower Leg Analysis			
Critical Stress	F_{cr}	31.4	ksi
Axial Stress	σ_a	0.19	ksi
Shear Stress	τ_v	0.17	ksi
Bending Stress	σ_b	3.41	ksi
Torsional Stress	τ_t	11.99	ksi
Normal Stress Limit State	F_{tn}	32.4	ksi
Shear Stress Limit State	F_{tv}	19.4	ksi
Bending Stress Limit State	F_{bn}	54.0	ksi
Buckling Limit State	F_{br}	51.4	ksi
Torsional/Shear Impact	τ_t / F_{tn}	63%	Pass
Buckling/Axial Impact	τ_t / F_{br}	6%	Pass

* This analysis confirms the impact of the antennas mount on the tower leg. Axial loads in the leg from the tower analysis were not considered.



Company : American Tower Corp.
Designer : Mitchell Chen
Job Number : 13683396_C9_10
Model Name : 88018, STAMFORD (KATOONA)

7/13/2022
1:41:48 PM
Checked By : -

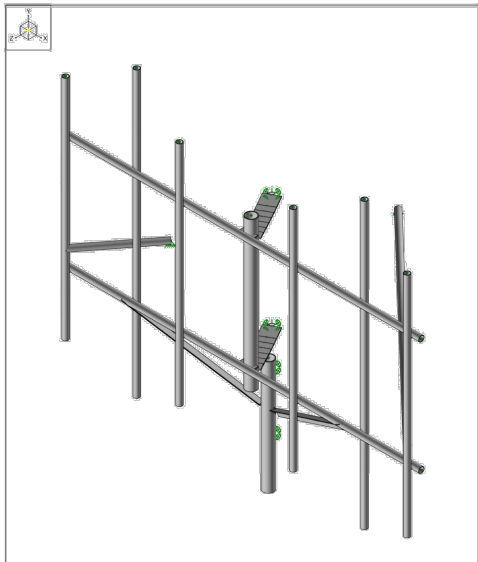


American Tower Corp.	88018, STAMFORD (KATOONA)	SK-1
Mitchell Chen	3D Rendering (Final Configuration) - AlphaBeta Sector	Jul 13, 2022
13683396_C9_10		R3D. AT&T MOBILITY @ 88018, ...

RISA-3D Version 19 [R3D. AT&T MOBILITY @ 88018, STAMF... Page 1



Company : American Tower Corp.
Designer : Mitchell Chen
Job Number : 13683396_C9_10
Model Name : 88018, STAMFORD (KATOONA)

7/13/2022
1:41:48 PM
Checked By : -

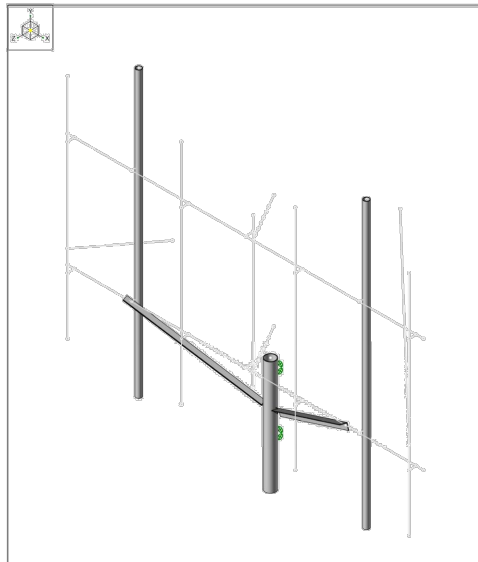

American Tower Corp.	88018, STAMFORD (KATOONA)	SK-2
Mitchell Chen	3D Rendering (Proposed Configuration) - AlphaBeta S...	Jul 13, 2022
13683396_C9_10		R3D. AT&T MOBILITY @ 88018, ...


RISA-3D Version 19 [R3D. AT&T MOBILITY @ 88018, STAMF... Page 2

AS BUILT
Centerline Communications
Tristen Spear
2/8/23 8:47 AM



Company : American Tower Corp.
Designer : Mitchell Chen
Job Number : 13683396_C9_10
Model Name : 88018, STAMFORD (KATOONA)

7/13/2022
1:41:48 PM
Checked By : -

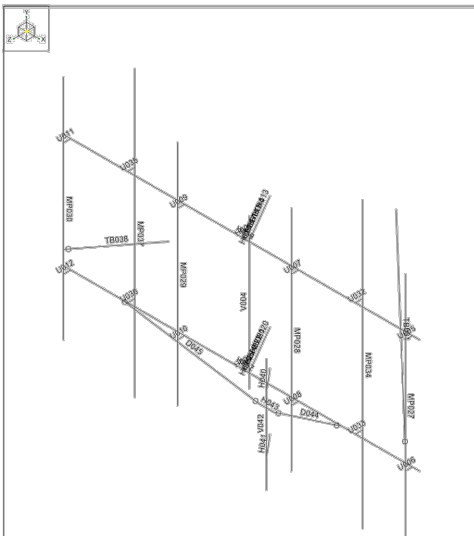


American Tower Corp.	88018, STAMFORD (KATOONA)	SK-3
Mitchell Chen	AlphaBeta Sector	Jul 13, 2022
13683396_C9_10		R3D. AT&T MOBILITY @ 88018, ...

RISA-3D Version 19 [R3D. AT&T MOBILITY @ 88018, STAMF... Page 3



Company : American Tower Corp.
Designer : Mitchell Chen
Job Number : 13683396_C9_10
Model Name : 88018, STAMFORD (KATOONA)

7/13/2022
1:41:48 PM
Checked By : -

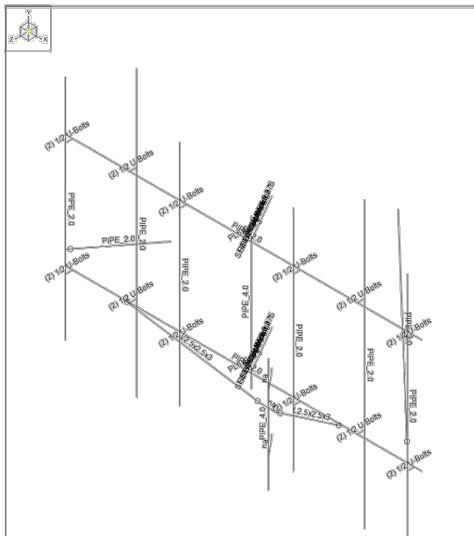

American Tower Corp.	88018, STAMFORD (KATOONA)	SK-4
Mitchell Chen	AlphaBeta Sector	Jul 13, 2022
13683396_C9_10		R3D. AT&T MOBILITY @ 88018, ...

RISA-3D Version 19 [R3D. AT&T MOBILITY @ 88018, STAMF... Page 4



Company : American Tower Corp.
Designer : Mitchell Chen
Job Number : 13683396_C9_10
Model Name : 88018, STAMFORD (KATOONA)

7/13/2022
1:41:48 PM
Checked By : -




Member Code Checks Displayed (Envelope)		
American Tower Corp.	88018, STAMFORD (KATOONA)	SK-5
Mitchell Chen	AlphaBeta Sector	Jul 13, 2022
13683396_C9_10		R3D. AT&T MOBILITY @ 88018, ...

RISA-3D Version 19 [R3D. AT&T MOBILITY @ 88018, STAMF... Page 5



Company : American Tower Corp.
Designer : Mitchell Chen
Job Number : 13683396_C9_10
Model Name : 88018, STAMFORD (KATOONA)

7/13/2022
1:41:48 PM
Checked By : -

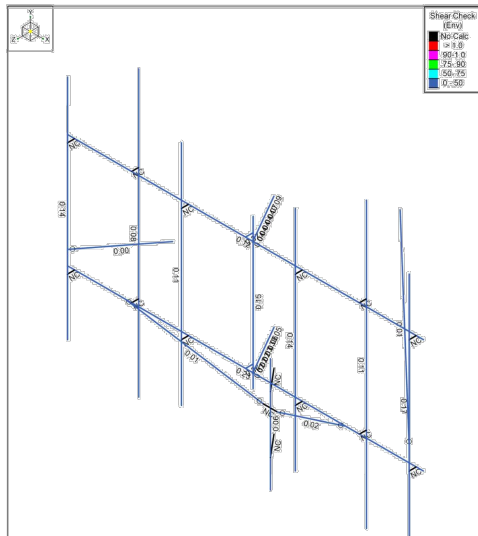

Member Shear Checks Displayed (Envelope)		
American Tower Corp.	88018, STAMFORD (KATOONA)	SK-6
Mitchell Chen	AlphaBeta Sector	Jul 13, 2022
13683396_C9_10		R3D. AT&T MOBILITY @ 88018, ...

RISA-3D Version 19 [R3D. AT&T MOBILITY @ 88018, STAMF... Page 6



AMERICAN TOWER®
A.T. ENGINEERING SERVICE, PLLC
3500 REGENCY PARKWAY
SUITE 100
CARY, NC 27518
PHONE: (919) 468-0112
COA: PEC.0001553

THESE DRAWINGS AND/OR THE ACCOMPANYING SPECIFICATION AS INSTRUMENTS OR SERVICE ARE THE EXCLUSIVE PROPERTY OF AMERICAN TOWER. THEIR USE AND PUBLICATION SHALL BE RESTRICTED TO THE ORIGINAL SITE FOR WHICH THEY ARE PREPARED. ANY USE OR DISCLOSURE OTHER THAN THAT WHICH RELATES TO AMERICAN TOWER OR THE SPECIFIED CARRIER IS STRICTLY PROHIBITED. TITLE TO THESE DOCUMENTS SHALL REMAIN THE PROPERTY OF AMERICAN TOWER WHETHER OR NOT THE PROJECT IS EXECUTED. NEITHER THE ARCHITECT NOR THE ENGINEER WILL BE PROVIDING ON-SITE CONSTRUCTION REVIEW OF THIS PROJECT. CONTRACTOR(S) MUST VERIFY ALL DIMENSIONS AND ADVISE AMERICAN TOWER OF ANY DISCREPANCIES. ANY PRIOR ISSUANCE OF THIS DRAWING IS SUPERSEDED BY THE LATEST VERSION ON FILE WITH AMERICAN TOWER.

REV.	DESCRIPTION	BY	DATE
△	FIRST ISSUE	KPJ	07/14/22
△			
△			
△			
△			

ATC SITE NUMBER:
88018

ATC SITE NAME:
STAMFORD (KATOONA)
CONNECTICUT

SITE ADDRESS:
168 CATOONA LANE
STAMFORD, CT 06902



DRAWN BY:	KPJ
APPROVED BY:	MCC
DATE DRAWN:	07/14/22
ATC JOB NO:	13683396_C9_10

SUPPLEMENTAL

SHEET NUMBER:

R-903

REVISION:

0



Company : American Tower Corp.
Designer : Mitchell.Chen
Job Number : 13683396_C9_10
Model Name : 88018, STAMFORD (KATOONA)

7/13/2022
1:41:48 PM
Checked By :-

Basic Load Cases

BLC Description	Category	Y Gravity	Nodal	Point	Distributed
1 D	DL	-1		13	
2 Di	DL			13	30
3 W1	WL			13	44
4 W30	WL			26	86
5 W60	WL			26	86
6 W90	WL			13	43
7 W120	WL			26	86
8 W150	WL			26	86
9 W180	WL			13	44
10 W210	WL			26	86
11 W240	WL			26	86
12 W270	WL			13	43
13 W300	WL			26	86
14 W330	WL			26	86
15 W0	WL			13	44
16 W30	WL			26	86
17 W60	WL			26	86
18 W90	WL			13	43
19 W120	WL			26	86
20 W150	WL			26	86
21 W180	WL			13	44
22 W210	WL			26	86
23 W240	WL			26	86
24 W270	WL			13	43
25 W300	WL			26	86
26 W330	WL			26	86
27 Ws 0	WL			13	44
28 Ws 30	WL			26	86
29 Ws 60	WL			26	86
30 Ws 90	WL			13	43
31 Ws 120	WL			26	86
32 Ws 150	WL			26	86
33 Ws 180	WL			13	44
34 Ws 210	WL			26	86
35 Ws 240	WL			26	86
36 Ws 270	WL			13	43
37 Ws 300	WL			26	86
38 Ws 330	WL			26	86
39 Ev-y	ELY			30	
40 Eh-z	ELZ			30	
41 Eh-x	ELX			30	
42 Lv (1)	LL			1	
43 Lv (2)	LL			1	
44 Lm (1)	LL			1	
45 Lm (2)	LL			1	
46 Lm (3)	LL			1	
47 Lm (4)	LL			1	
48 Lm (5)	LL			1	
49 Lm (6)	LL			1	

RISA-3D Version 19 [R3D. AT&T MOBILITY @ 88018, STAMF... Page 7



Company : American Tower Corp.
Designer : Mitchell.Chen
Job Number : 13683396_C9_10
Model Name : 88018, STAMFORD (KATOONA)

7/13/2022
1:41:48 PM
Checked By :-

Load Combinations

Description	Solve	P-Delta	BLC	Factor	BLC	Factor	BLC	Factor	BLC	Factor
1 1.4D	Yes	Y	DL	1.4						
2 1.2D + 1.0W [0°]	Yes	Y	DL	1.2	3	1				
3 1.2D + 1.0W [90°]	Yes	Y	DL	1.2	4	1				
4 1.2D + 1.0W [90°]	Yes	Y	DL	1.2	5	1				
5 1.2D + 1.0W [90°]	Yes	Y	DL	1.2	6	1				
6 1.2D + 1.0W [120°]	Yes	Y	DL	1.2	7	1				
7 1.2D + 1.0W [150°]	Yes	Y	DL	1.2	8	1				
8 1.2D + 1.0W [180°]	Yes	Y	DL	1.2	9	1				
9 1.2D + 1.0W [210°]	Yes	Y	DL	1.2	10	1				
10 1.2D + 1.0W [240°]	Yes	Y	DL	1.2	11	1				
11 1.2D + 1.0W [270°]	Yes	Y	DL	1.2	12	1				
12 1.2D + 1.0W [300°]	Yes	Y	DL	1.2	13	1				
13 1.2D + 1.0W [330°]	Yes	Y	DL	1.2	14	1				
14 0.9D + 1.0W [0°]	Yes	Y	DL	0.9	3	1				
15 0.9D + 1.0W [90°]	Yes	Y	DL	0.9	4	1				
16 0.9D + 1.0W [90°]	Yes	Y	DL	0.9	5	1				
17 0.9D + 1.0W [90°]	Yes	Y	DL	0.9	6	1				
18 0.9D + 1.0W [120°]	Yes	Y	DL	0.9	7	1				
19 0.9D + 1.0W [150°]	Yes	Y	DL	0.9	8	1				
20 0.9D + 1.0W [180°]	Yes	Y	DL	0.9	9	1				
21 0.9D + 1.0W [210°]	Yes	Y	DL	0.9	10	1				
22 0.9D + 1.0W [240°]	Yes	Y	DL	0.9	11	1				
23 0.9D + 1.0W [270°]	Yes	Y	DL	0.9	12	1				
24 0.9D + 1.0W [300°]	Yes	Y	DL	0.9	13	1				
25 0.9D + 1.0W [330°]	Yes	Y	DL	0.9	14	1				
26 1.2D + 1.0D + 1.0W [0°] + 1.0T	Yes	Y	DL	1.2	IL	1	15	1		
27 1.2D + 1.0D + 1.0W [90°] + 1.0T	Yes	Y	DL	1.2	IL	1	16	1		
28 1.2D + 1.0D + 1.0W [90°] + 1.0T	Yes	Y	DL	1.2	IL	1	17	1		
29 1.2D + 1.0D + 1.0W [90°] + 1.0T	Yes	Y	DL	1.2	IL	1	18	1		
30 1.2D + 1.0D + 1.0W [120°] + 1.0T	Yes	Y	DL	1.2	IL	1	19	1		
31 1.2D + 1.0D + 1.0W [150°] + 1.0T	Yes	Y	DL	1.2	IL	1	20	1		
32 1.2D + 1.0D + 1.0W [180°] + 1.0T	Yes	Y	DL	1.2	IL	1	21	1		
33 1.2D + 1.0D + 1.0W [210°] + 1.0T	Yes	Y	DL	1.2	IL	1	22	1		
34 1.2D + 1.0D + 1.0W [240°] + 1.0T	Yes	Y	DL	1.2	IL	1	23	1		
35 1.2D + 1.0D + 1.0W [270°] + 1.0T	Yes	Y	DL	1.2	IL	1	24	1		
36 1.2D + 1.0D + 1.0W [300°] + 1.0T	Yes	Y	DL	1.2	IL	1	25	1		
37 1.2D + 1.0D + 1.0W [330°] + 1.0T	Yes	Y	DL	1.2	IL	1	26	1		
38 1.2D + 1.0Ev + 1.0Eh [0°]	Yes	Y	DL	1.2	ELY	1	ELZ	1	ELX	0.001
39 1.2D + 1.0Ev + 1.0Eh [30°]	Yes	Y	DL	1.2	ELY	1	ELZ	0.866	ELX	0.5
40 1.2D + 1.0Ev + 1.0Eh [60°]	Yes	Y	DL	1.2	ELY	1	ELZ	0.5	ELX	0.866
53 0.9D + 1.0Ev + 1.0Eh [90°]	Yes	Y	DL	0.9	ELY	1	ELZ	0.001	ELX	0.866
54 0.9D + 1.0Ev + 1.0Eh [120°]	Yes	Y	DL	0.9	ELY	1	ELZ	-0.5	ELX	0.866
55 0.9D + 1.0Ev + 1.0Eh [150°]	Yes	Y	DL	0.9	ELY	1	ELZ	-0.866	ELX	0.5

RISA-3D Version 19 [R3D. AT&T MOBILITY @ 88018, STAMF... Page 8



Company : American Tower Corp.
Designer : Mitchell.Chen
Job Number : 13683396_C9_10
Model Name : 88018, STAMFORD (KATOONA)

7/13/2022
1:41:48 PM
Checked By :-

Load Combinations (Continued)

	Description	Solve	P-Delta	BLC	Factor	BLC	Factor	BLC	Factor	BLC	Factor
56	0.9D + 1.0Ev + 1.0Eh [180°]	Yes	Y	DL	0.9	ELY	1	ELZ	-1	ELX	0.001
57	0.9D + 1.0Ev + 1.0Eh [210°]	Yes	Y	DL	0.9	ELY	1	ELZ	-0.866	ELX	-0.5
58	0.9D + 1.0Ev + 1.0Eh [240°]	Yes	Y	DL	0.9	ELY	1	ELZ	-0.5	ELX	-0.866
59	0.9D + 1.0Ev + 1.0Eh [270°]	Yes	Y	DL	0.9	ELY	1	ELZ	0.001	ELX	-1
60	0.9D + 1.0Ev + 1.0Eh [300°]	Yes	Y	DL	0.9	ELY	1	ELZ	0.5	ELX	-0.866
61	0.9D + 1.0Ev + 1.0Eh [330°]	Yes	Y	DL	0.9	ELY	1	ELZ	0.866	ELX	-0.5
62	1.2D + 1.0W [0°]TF	Yes	Y	DL	1.2	3	0.845				
63	1.2D + 1.0W [90°]TF	Yes	Y	DL	1.2	4	0.845				
64	1.2D + 1.0W [90°]TF	Yes	Y	DL	1.2	5	0.845				
65	1.2D + 1.0W [90°]TF	Yes	Y	DL	1.2	6	0.845				
66	1.2D + 1.0W [120°]TF	Yes	Y	DL	1.2	7	0.845				
67	1.2D + 1.0W [150°]TF	Yes	Y	DL	1.2	8	0.845				
68	1.2D + 1.0W [180°]TF	Yes	Y	DL	1.2	9	0.845				
69	1.2D + 1.0W [210°]TF	Yes	Y	DL	1.2	10	0.845				
70	1.2D + 1.0W [240°]TF	Yes	Y	DL	1.2	11	0.845				
71	1.2D + 1.0W [270°]TF	Yes	Y	DL	1.2	12	0.845				
72	1.2D + 1.0W [300°]TF	Yes	Y	DL	1.2	13	0.845				
73	1.2D + 1.0W [330°]TF	Yes	Y	DL	1.2	14	0.845				
74	0.9D + 1.0W [0°]TF	Yes	Y	DL	0.9	3	0.845				
75	0.9D + 1.0W [90°]TF	Yes	Y	DL	0.9	4	0.845				
76	0.9D + 1.0W [90°]TF	Yes	Y	DL	0.9	5	0.845				
77	0.9D + 1.0W [90°]TF	Yes	Y	DL	0.9	6	0.845				
78	0.9D + 1.0W [120°]TF	Yes	Y	DL	0.9	7	0.845				
79	0.9D + 1.0W [150°]TF	Yes	Y	DL	0.9	8	0.845				
80	0.9D + 1.0W [180°]TF	Yes	Y	DL	0.9	9	0.845				
81	0.9D + 1.0W [210°]TF	Yes	Y	DL	0.9	10	0.845				
82	0.9D + 1.0W [240°]TF	Yes	Y	DL	0.9	11	0.845				
83	0.9D + 1.0W [270°]TF	Yes	Y	DL	0.9	12	0.845				
84	0.9D + 1.0W [300°]TF	Yes	Y	DL	0.9	13	0.845				
85	0.9D + 1.0W [330°]TF	Yes	Y	DL	0.9	14	0.845				
86	1.2D + 1.0D + 1.0W [0°]TF + 1.0T	Yes	Y	DL	1.2	IL	1	15	0.845		
87	1.2D + 1.0D + 1.0W [90°]TF + 1.0T	Yes	Y	DL	1.2	IL	1	16	0.845		
88	1.2D + 1.0D + 1.0W [90°]TF + 1.0T	Yes	Y	DL	1.2	IL	1	17	0.845		
89	1.2D + 1.0D + 1.0W [90°]TF + 1.0T	Yes	Y	DL	1.2	IL	1	18	0.845		
90	1.2D + 1.0D + 1.0W [120°]TF + 1.0T	Yes	Y	DL	1.2	IL	1	19	0.845		
91	1.2D + 1.0D + 1.0W [150°]TF + 1.0T	Yes	Y	DL	1.2	IL	1	20	0.845		
92	1.2D + 1.0D + 1.0W [180°]TF + 1.0T	Yes	Y	DL	1.2	IL	1	21	0.845		
93	1.2D + 1.0D + 1.0W [210°]TF + 1.0T	Yes	Y	DL	1.2	IL	1	22	0.845		
94	1.2D + 1.0D + 1.0W [240°]TF + 1.0T	Yes	Y	DL	1.2	IL	1	23	0.845		
95	1.2D + 1.0D + 1.0W [270°]TF + 1.0T	Yes	Y	DL	1.2	IL	1	24	0.845		
96	1.2D + 1.0D + 1.0W [300°]TF + 1.0T	Yes	Y	DL	1.2	IL	1	25	0.845		
97	1.2D + 1.0D + 1.0W [330°]TF + 1.0T	Yes	Y	DL	1.2	IL	1	26	0.845		
98	1.2D + 1.5Lm(1)	Yes	Y	DL	1.2	42	1.5				
99	1.2D + 1.5Lm(2)	Yes	Y	DL	1.2	43	1.5				
100	1.2D + 1.5Lm(3)	Yes	Y	DL	1.2	44	1.5				
101	1.2D + 1.5Lm(1) + 1.0Wm [0°]	Yes	Y	DL	1.2	45	1.5	27	1		
102	1.2D + 1.5Lm(1) + 1.0Wm [30°]	Yes	Y	DL	1.2	45	1.5	28	1		
103	1.2D + 1.5Lm(1) + 1.0Wm [60°]	Yes	Y	DL	1.2	45	1.5	29	1		
104	1.2D + 1.5Lm(1) + 1.0Wm [90°]	Yes	Y	DL	1.2	45	1.5	30	1		
105	1.2D + 1.5Lm(1) + 1.0Wm [120°]	Yes	Y	DL	1.2	45	1.5	31	1		
106	1.2D + 1.5Lm(1) + 1.0Wm [150°]	Yes	Y	DL	1.2	45	1.5	32	1		
107	1.2D + 1.5Lm(1) + 1.0Wm [180°]	Yes	Y	DL	1.2	45	1.5	33	1		
108	1.2D + 1.5Lm(1) + 1.0Wm [210°]	Yes	Y	DL	1.2	45	1.5	34	1		
109	1.2D + 1.5Lm(1) + 1.0Wm [240°]	Yes	Y	DL	1.2	45	1.5	35	1		
110	1.2D + 1.5Lm(1) + 1.0Wm [270°]	Yes	Y	DL	1.2	45	1.5	36	1		