

From: Aja Chase <aja.chase@ericsson.com>
Sent: Thursday, May 11, 2023 7:23 AM
To: CSC-DL Siting Council <Siting.Council@ct.gov>
Subject: EM-CING-158-200723

EXTERNAL EMAIL: This email originated from outside of the organization. Do not click any links or open any attachments unless you trust the sender and know the content is safe.

Good Morning CSC,

Please find the attached letter for this site, as construction is complete. If you have any other questions, please reach out!

2 Allen Raymond Lane | Westport



Aja Chase
Construction Manager I
AT&T NE Market
401-952-6205



STATE OF CONNECTICUT
CONNECTICUT SITING COUNCIL

Ten Franklin Square, New Britain, CT 06051
Phone: (860) 827-2935 Fax: (860) 827-2950
E-Mail: siting.council@ct.gov
Web Site: www.ct.gov/csc

VIA ELECTRONIC MAIL

September 28, 2020

Patricia Nowak
Site Acquisition Consultant
Centerline Communications, LLC
750 West Center Street, Suite 301
West Bridgewater, MA 02379

RE: **EM-CING-158-200723** – New Cingular Wireless PCS, LLC (AT&T) notice of intent to modify an existing telecommunications facility located at 2 Allen Raymond Lane, Westport, Connecticut.

Dear Ms. Nowak:

The Connecticut Siting Council (Council) hereby acknowledges your notice to modify this existing telecommunications facility, pursuant to Section 16-50j-73 of the Regulations of Connecticut State Agencies with the following conditions:

1. Prior to AT&T's antenna installation, the antenna mount modifications shall be installed in accordance with the Mount Analysis prepared by Mastec Network Solutions, dated May 18, 2020 and stamped and signed by Raphael Mohamed;
2. Within 45 days following completion of equipment installation, AT&T shall provide documentation certified by a Professional Engineer that its installation complied with the recommendations of the Mount Analysis;
3. Any deviation from the proposed modification as specified in this notice and supporting materials with the Council shall render this acknowledgement invalid;
4. Any material changes to this modification as proposed shall require the filing of a new notice with the Council;
5. Within 45 days after completion of construction, the Council shall be notified in writing that construction has been completed;
6. Any nonfunctioning antenna and associated antenna mounting equipment on this facility owned and operated by AT&T shall be removed within 60 days of the date the antenna ceased to function;
7. The validity of this action shall expire one year from the date of this letter; and
8. The applicant may file a request for an extension of time beyond the one year deadline provided that such request is submitted to the Council not less than 60 days prior to the expiration.

The proposed modifications including the placement of all necessary equipment and shelters within the tower compound are to be implemented as specified here and in your notice dated July 23, 2020, and additional information received September 10, 2020. The modifications are in compliance with the exception criteria in Section 16-50j-72 (b) of the Regulations of Connecticut State Agencies as changes to an existing facility site that would not increase tower height, extend the boundaries of the tower site by any dimension, increase noise levels at the tower site boundary by six decibels or more, and increase the total radio frequencies electromagnetic radiation power density measured at the tower site boundary to or above the standards adopted by the Federal Communications Commission pursuant to Section 704 of the Telecommunications Act of 1996 and by the state Department of Energy and Environmental Protection pursuant to Connecticut General Statutes § 22a-162. This facility has also been carefully modeled to ensure that radio frequency emissions are conservatively below state and federal standards applicable to the frequencies now used on this tower.

This decision is under the exclusive jurisdiction of the Council. Please be advised that the validity of this action shall expire one year from the date of this letter. Any additional change to this facility will require explicit notice to this agency pursuant to Regulations of Connecticut State Agencies Section 16-50j-73. Such notice shall include all relevant information regarding the proposed change with cumulative worst-case modeling of radio frequency exposure at the closest point of uncontrolled access to the tower base, consistent with Federal Communications Commission, Office of Engineering and Technology, Bulletin 65. Thank you for your attention and cooperation.

Sincerely,


s/ Melanie A. Bachman

Melanie A. Bachman
Executive Director

MAB/IN/emr

c: The Honorable Jim Marpe, First Selectman, Town of Westport (selectman@westportct.gov)

AS-BUILT CDs
 Ramapo Communication Corp
 12/3/2020
 Matthew Schlosser
 Matthew Schlosser
 REDLINE ON PAGE 5

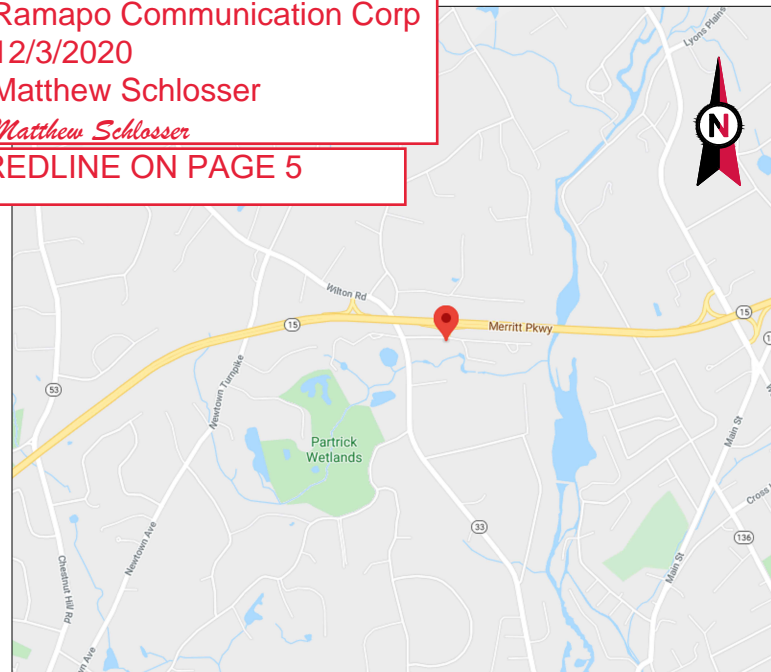


VICINITY MAP



AMERICAN TOWER®

ATC SITE NAME: CRANBURYSU CT
 ATC SITE NUMBER: 411189
 AT&T PACE NUMBER: MRCTB045060, MRCTB045017,
 MRCTB045016, MRCTB045027, & MRCTB045127
 AT&T SITE ID: CTL02094
 AT&T FA CODE: 10035342
 AT&T SITE NAME: CANTON - COLLINSVILLE
 PROJECTS: 3C, 4C, 4T4R ANTENNA RETROFIT, 5G NR
 SITE ADDRESS: 2 SUNNY LANE
 WESTPORT, CT 06880-1906

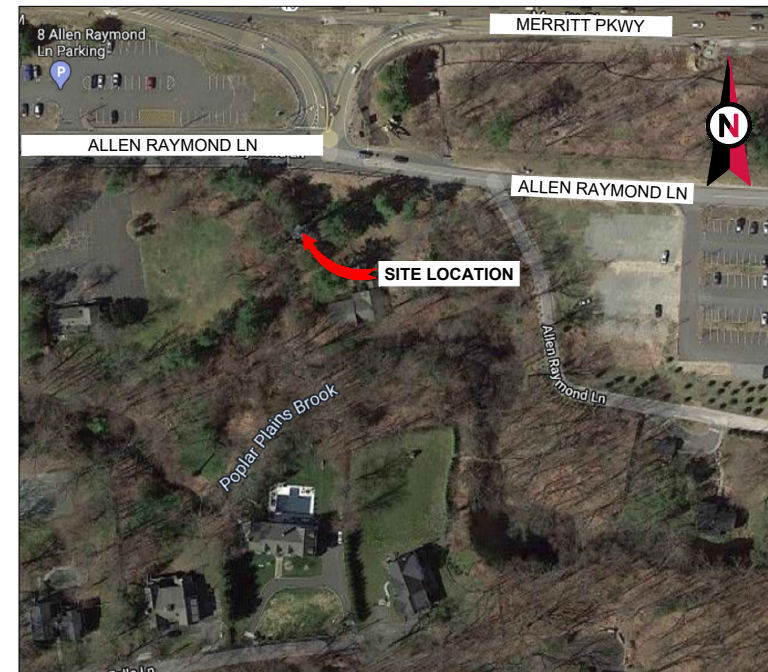

LOCATION MAP

**AT&T MOBILITY
 ANTENNA AMENDMENT DRAWINGS**




TOGETHER PLANNING A BETTER TOMORROW
 158 BUSINESS CENTER DRIVE
 BIRMINGHAM, AL 35244
 TEL: 205-252-6985 FAX: 205-320-1504

REV.	DESCRIPTION	BY	DATE
0	FOR CONSTRUCTION	ZDS	05/28/20
1	FOR CONSTRUCTION	ZDS	06/10/20

ATC SITE NUMBER:
411189
 ATC SITE NAME:
CRANBURYSU CT

SITE ADDRESS:
 2 SUNNY LANE
 WESTPORT, CT 06880-1906

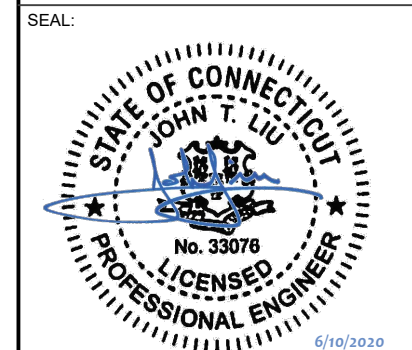

DATE DRAWN:	05/13/20
ATC JOB NO:	411189-REV-1-1587496885727
CUSTOMER ID:	10035342
CUSTOMER #:	MRCTB045060, MRCTB045017, MRCTB045016, MRCTB045027, & MRCTB045127

COVER SHEET

SHEET NUMBER:
G-001
 REVISION:
A

COMPLIANCE CODE	PROJECT SUMMARY	PROJECT DESCRIPTION	SHEET INDEX				
ALL WORK SHALL BE PERFORMED AND MATERIALS INSTALLED IN ACCORDANCE WITH THE CURRENT EDITIONS OF THE FOLLOWING CODES AS ADOPTED BY THE LOCAL GOVERNMENT AUTHORITIES. NOTHING IN THESE PLANS IS TO BE CONSTRUED TO PERMIT WORK NOT CONFORMING TO THESE CODES. 1. INTERNATIONAL BUILDING CODE (IBC) 2. NATIONAL ELECTRIC CODE (NEC) 3. LOCAL BUILDING CODE 4. CITY/COUNTY ORDINANCES	<u>SITE ADDRESS:</u> 2 SUNNY LANE WESTPORT, CT 06880-1906 COUNTY: FAIRFIELD <u>GEOGRAPHIC COORDINATES:</u> LATITUDE: 41.162917 LONGITUDE: -73.373083 GROUND ELEVATION: 51' AMSL	THE PROPOSED PROJECT INCLUDES MODIFYING GROUND BASED AND TOWER MOUNTED EQUIPMENT AS INDICATED PER BELOW: <u>TOWER WORK:</u> REMOVE (3) ANTENNA3, (3) RRU-11 B12, (3) RRU-12, 12 TMA'S, (6) 1-5/8" UMTS COAX CABLES. INSTALL (6) ANTENNAS, (9) RRH'S, (1) DC9 SQUID, (2) 0.78" 8AWG6 DC CABLES, AND (1) 0.39" FIBER CABLE. NOTE: (1) EXISTING AND (2) PROPOSED 0.78" 8AWG6 DC CABLES TO BE USED FOR PROPOSED (1) DC9 SQUID. EXISTING (3) ANTENNAS, (1) DC6 SQUID, (6) 1-5/8" COAX CABLES, (2) 0.78" 8AWG6 DC CABLES, (1) 0.39" FIBER CABLE TO REMAIN, (3) ANTENNAS, AND (1) HOME RUN RET TO BE RELOCATED. <u>GROUND WORK:</u> REMOVE (12) DIPLEXERS. INSTALL (1) 5G RBS 6630 AND (1) IDLE.	SHEET NO:	DESCRIPTION:	REV:	DATE:	BY:
	<u>PROJECT TEAM</u> <u>TOWER OWNER:</u> AMERICAN TOWER 10 PRESIDENTIAL WAY WOBURN, MA 01801 <u>ENGINEER:</u> SMW ENGINEERING GROUP INC. 158 BUSINESS CENTER DR. BIRMINGHAM, AL. 35244 JOB# 20-10209 <u>PROPERTY OWNER:</u> AMERICAN TOWER 116 HUNTINGTON AVE BOSTON, MA 02116 <u>APPLICANT:</u> AT&T MOBILITY <u>CONSULTING ENGINEER</u> JOHN LIU, PE (423) 541-0561 JOHNLIU@TELECOM.TEAM	<u>PROJECT NOTES</u> 1. THE FACILITY IS UNMANNED. 2. A TECHNICIAN WILL VISIT THE SITE APPROXIMATELY ONCE A MONTH FOR ROUTINE INSPECTION AND MAINTENANCE. 3. THE PROJECT WILL NOT RESULT IN ANY SIGNIFICANT LAND DISTURBANCE OR EFFECT OF STORM WATER DRAINAGE. 4. NO SANITARY SEWER, POTABLE WATER OR TRASH DISPOSAL IS REQUIRED. 5. HANDICAP ACCESS IS NOT REQUIRED.		G-001	COVER SHEET	A	05/13/20
<u>UTILITY COMPANIES</u> POWER COMPANY: NOT PROVIDED PHONE: NOT PROVIDED TELEPHONE COMPANY: NOT PROVIDED PHONE: NOT PROVIDED		<u>PROJECT LOCATION DIRECTIONS</u> HEAD SOUTHWEST ON I-95 S, TAKE EXIT 16 TOWARD EAST NORWALK 0.1 MI, TURN RIGHT ONTO EAST AVE (SIGNS FOR U.S. 1) 1.2 MI, CONTINUE ONTO NEWTOWN AVE 1.4 MI, TURN RIGHT ONTO PARTRICK AVE 1.7 MI, TURN LEFT ONTO WILTON RD 0.3 MI, TURN RIGHT ONTO SUNNY LN 0.1 MI					



Copyright © 2020 ATC IP, LLC. All Rights Reserved.

GENERAL CONSTRUCTION NOTES:

1. OWNER FURNISHED MATERIALS, AT&T MOBILITY "THE COMPANY" WILL PROVIDE AND THE CONTRACTOR WILL INSTALL
 - A. BTS EQUIPMENT FRAME (PLATFORM) AND ICEBRIDGE SHELTER (GROUND BUILD/CO-LOCATE ONLY)
 - B. AC/TELCO INTERFACE BOX (PPC)
 - C. ICE BRIDGE (CABLE TRAY WITH COVER) (GROUND BUILD/CO-LOCATE ONLY, GC TO FURNISH AND INSTALL FOR ROOFTOP INSTALLATION)
 - D. TOWERS, MONOPOLES
 - E. TOWER LIGHTING
 - F. GENERATORS & LIQUID PROPANE TANK
 - G. ANTENNA STANDARD BRACKETS, FRAMES AND PIPES FOR MOUNTING
 - H. ANTENNAS (INSTALLED BY OTHERS)
 - I. TRANSMISSION LINE
 - J. TRANSMISSION LINE JUMPERS
 - K. TRANSMISSION LINE CONNECTORS WITH WEATHERPROOFING KITS
 - L. TRANSMISSION LINE GROUND KITS
 - M. HANGERS
 - N. HOISTING GRIPS
 - O. BTS EQUIPMENT
2. THE CONTRACTOR IS RESPONSIBLE TO PROVIDE ALL OTHER MATERIALS FOR THE COMPLETE INSTALLATION OF THE SITE INCLUDING, BUT NOT LIMITED TO, SUCH MATERIALS AS FENCING, STRUCTURAL STEEL SUPPORTING SUB-FRAME FOR PLATFORM, ROOFING LABOR AND MATERIALS, GROUNDING RINGS, GROUNDING WIRES, COPPER-CLAD OR XIT CHEMICAL GROUND ROD(S), BUSS BARS, TRANSFORMERS AND DISCONNECT SWITCHES WHERE APPLICABLE, TEMPORARY ELECTRICAL POWER, CONDUIT, LANDSCAPING COMPOUND STONE, CRANES, CORE DRILLING, SLEEPERS AND RUBBER MATTING, REBAR, CONCRETE CAISSONS, PADS AND/OR AUGER MOUNTS, MISCELLANEOUS FASTENERS, CABLE TRAYS, NON-STANDARD ANTENNA FRAMES AND ALL OTHER MATERIAL AND LABOR REQUIRED TO COMPLETE THE JOB ACCORDING TO THE DRAWINGS AND SPECIFICATIONS. IT IS THE POSITION OF AT&T MOBILITY TO APPLY FOR PERMITTING AND CONTRACTOR RESPONSIBLE FOR PICKUP AND PAYMENT OF REQUIRED PERMITS.
3. ALL WORK SHALL CONFORM TO ALL CURRENT APPLICABLE FEDERAL, STATE, AND LOCAL CODES, INCLUDING ANSIEIA/NTIA-222, AND COMPLY WITH ATC CONSTRUCTION SPECIFICATIONS.
4. CONTRACTOR SHALL CONTACT LOCAL 811 FOR IDENTIFICATION OF UNDERGROUND UTILITIES PRIOR TO START OF CONSTRUCTION.
5. CONTRACTOR SHALL BE RESPONSIBLE FOR COORDINATING ALL REQUIRED INSPECTIONS.
6. ALL DIMENSIONS TO, OF, AND ON EXISTING BUILDINGS, DRAINAGE STRUCTURES, AND SITE IMPROVEMENTS SHALL BE VERIFIED IN FIELD BY CONTRACTOR WITH ALL DISCREPANCIES REPORTED TO THE ENGINEER.
7. DO NOT CHANGE SIZE OR SPACING OF STRUCTURAL ELEMENTS.
8. DETAILS SHOWN ARE TYPICAL; SIMILAR DETAILS APPLY TO SIMILAR CONDITIONS UNLESS OTHERWISE NOTED.
9. THESE DRAWINGS DO NOT INCLUDE NECESSARY COMPONENTS FOR CONSTRUCTION SAFETY WHICH SHALL BE THE SOLE RESPONSIBILITY OF THE CONTRACTOR.
10. CONTRACTOR SHALL BRACE STRUCTURES UNTIL ALL STRUCTURAL ELEMENTS NEEDED FOR STABILITY ARE INSTALLED. THESE ELEMENTS ARE AS FOLLOWS: LATERAL BRACING, ANCHOR BOLTS, ETC.
11. CONTRACTOR SHALL DETERMINE EXACT LOCATION OF EXISTING UTILITIES, GROUNDS DRAINS, DRAIN PIPES, VENTS, ETC. BEFORE COMMENCING WORK.
12. INCORRECTLY FABRICATED, DAMAGED, OR OTHERWISE MISFITTING OR NONCONFORMING MATERIALS OR CONDITIONS SHALL BE REPORTED TO THE AT&T MOBILITY REP PRIOR TO REMEDIAL OR CORRECTIVE ACTION. ANY SUCH REMEDIAL ACTION SHALL REQUIRE WRITTEN APPROVAL BY THE AT&T MOBILITY REP PRIOR TO PROCEEDING.
13. EACH CONTRACTOR SHALL COOPERATE WITH THE AT&T MOBILITY REP, AND COORDINATE HIS WORK WITH THE WORK OF OTHERS.
14. CONTRACTOR SHALL REPAIR ANY DAMAGE CAUSED BY CONSTRUCTION OF THIS PROJECT TO MATCH EXISTING PRE-CONSTRUCTION CONDITIONS TO THE SATISFACTION OF THE AT&T MOBILITY CONSTRUCTION MANAGER.
15. ALL CABLE/CONDUIT ENTRY/EXIT PORTS SHALL BE WEATHERPROOFED DURING INSTALLATION USING A SILICONE SEALANT.
16. WHERE EXISTING CONDITIONS DO NOT MATCH THOSE SHOWN IN THIS PLAN SET, CONTRACTOR SHALL NOTIFY THE AT&T MOBILITY REP AND ENGINEER OF RECORD IMMEDIATELY.
17. CONTRACTOR SHALL ENSURE ALL SUBCONTRACTORS ARE PROVIDED WITH A COMPLETE AND CURRENT SET OF DRAWINGS AND SPECIFICATIONS FOR THIS PROJECT.
18. CONTRACTOR SHALL REMOVE ALL RUBBISH AND DEBRIS FROM THE SITE AT THE END OF EACH DAY.
19. CONTRACTOR SHALL COORDINATE WORK SCHEDULE WITH AMERICAN TOWER CORPORATION (ATC) AND TAKE PRECAUTIONS TO MINIMIZE IMPACT AND DISRUPTION OF OTHER OCCUPANTS OF THE FACILITY.
20. CONTRACTOR SHALL FURNISH AT&T MOBILITY AND AMERICAN TOWER CORPORATION (ATC) WITH A PDF MARKED UP AS-BUILT SET OF DRAWINGS UPON COMPLETION OF WORK.
21. PRIOR TO SUBMISSION OF BID, CONTRACTOR SHALL COORDINATE WITH AT&T MOBILITY REP TO DETERMINE WHAT, IF ANY, ITEMS WILL BE PROVIDED. ALL ITEMS NOT PROVIDED SHALL BE PROVIDED AND INSTALLED BY THE CONTRACTOR. CONTRACTOR WILL INSTALL

- ALL ITEMS PROVIDED.
22. PRIOR TO SUBMISSION OF BID, CONTRACTOR SHALL COORDINATE WITH AT&T MOBILITY REP TO DETERMINE IF ANY PERMITS WILL BE OBTAINED BY CONTRACTOR. ALL REQUIRED PERMITS NOT OBTAINED BY AT&T MOBILITY MUST BE OBTAINED, AND PAID FOR, BY THE CONTRACTOR.
 23. CONTRACTOR SHALL INSTALL ALL SITE SIGNAGE IN ACCORDANCE WITH AT&T MOBILITY SPECIFICATIONS AND REQUIREMENTS.
 24. CONTRACTOR SHALL SUBMIT ALL SHOP DRAWINGS TO AT&T MOBILITY FOR REVIEW AND APPROVAL PRIOR TO FABRICATION.
 25. ALL EQUIPMENT SHALL BE INSTALLED ACCORDING TO MANUFACTURER'S SPECIFICATIONS AND LOCATED ACCORDING TO AT&T MOBILITY SPECIFICATIONS, AND AS SHOWN IN THESE PLANS.
 26. THE CONTRACTOR SHALL SUPERVISE AND DIRECT THE PROJECT DESCRIBED HEREIN. THE CONTRACTOR SHALL BE SOLELY RESPONSIBLE FOR ALL THE CONSTRUCTION MEANS, METHODS, TECHNIQUES, SEQUENCES AND PROCEDURES AND FOR COORDINATING ALL PORTIONS OF THE WORK UNDER THE CONTRACT.
 27. CONTRACTOR SHALL NOTIFY AT&T MOBILITY REP A MINIMUM OF 48 HOURS IN ADVANCE OF POURING CONCRETE OR BACKFILLING ANY UNDERGROUND UTILITIES, FOUNDATIONS OR SEALING ANY WALL, FLOOR OR ROOF PENETRATIONS FOR ENGINEERING REVIEW AND APPROVAL.
 28. CONTRACTOR SHALL BE RESPONSIBLE FOR SITE SAFETY INCLUDING COMPLIANCE WITH ALL APPLICABLE OSHA STANDARDS AND RECOMMENDATIONS AND SHALL PROVIDE ALL NECESSARY SAFETY DEVICES INCLUDING PPE AND PPM AND CONSTRUCTION DEVICES SUCH AS WELDING AND FIRE PREVENTION, TEMPORARY SHORING, SCAFFOLDING, TRENCH BOXES/SLOPING, BARRIERS, ETC.
 29. THE CONTRACTOR SHALL PROTECT AT HIS OWN EXPENSE, ALL EXISTING FACILITIES AND SUCH OF HIS NEW WORK LIABLE TO INJURY DURING THE CONSTRUCTION PERIOD. ANY DAMAGE CAUSED BY NEGLIGENCE ON THE PART OF THIS CONTRACTOR OR HIS REPRESENTATIVES, OR BY THE ELEMENTS DUE TO NEGLIGENCE ON THE PART OF THIS CONTRACTOR OR HIS REPRESENTATIVES, EITHER TO THE EXISTING WORK, OR TO HIS WORK OR THE WORK OF ANY OTHER CONTRACTOR, SHALL BE REPAIRED AT HIS EXPENSE TO THE OWNER'S SATISFACTION.
 30. ALL WORK SHALL BE INSTALLED IN A FIRST CLASS, NEAT AND WORKMANLIKE MANNER BY MECHANICS SKILLED IN THE TRADE INVOLVED. THE QUALITY OF WORKMANSHIP SHALL BE SUBJECT TO THE APPROVAL OF THE AT&T MOBILITY REP. ANY WORK FOUND BY THE AT&T MOBILITY REP TO BE OF INFERIOR QUALITY AND/OR WORKMANSHIP SHALL BE REPLACED AND/OR REWORKED AT CONTRACTOR EXPENSE UNTIL APPROVAL IS OBTAINED.
 31. IN ORDER TO ESTABLISH STANDARDS OF QUALITY AND PERFORMANCE, ALL TYPES OF MATERIALS LISTED HEREINAFTER BY MANUFACTURER'S NAMES AND/OR MANUFACTURER'S CATALOG NUMBER SHALL BE PROVIDED BY THESE MANUFACTURERS AS SPECIFIED.
 32. AT&T MOBILITY FURNISHED EQUIPMENT SHALL BE PICKED-UP AT THE AT&T MOBILITY WAREHOUSE, NO LATER THAN 48HR AFTER BEING NOTIFIED INSURED, STORED, UNGRATE, PROTECTED AND INSTALLED BY THE CONTRACTOR WITH ALL APPURTENANCES REQUIRED TO PLACE THE EQUIPMENT IN OPERATION, READY FOR USE. THE CONTRACTOR SHALL BE RESPONSIBLE FOR THE EQUIPMENT AFTER PICKING IT UP.
 33. AT&T MOBILITY OR HIS ARCHITECT/ENGINEER RESERVES THE RIGHT TO REJECT ANY EQUIPMENT OR MATERIALS WHICH, IN HIS OWN OPINION ARE NOT IN COMPLIANCE WITH THE CONTRACT DOCUMENTS, EITHER BEFORE OR AFTER INSTALLATION AND THE EQUIPMENT SHALL BE REPLACED WITH EQUIPMENT CONFORMING TO THE REQUIREMENTS OF THE CONTRACT DOCUMENTS BY THE CONTRACTOR AT NO COST TO AT&T MOBILITY OR THEIR ARCHITECT/ENGINEER.

SPECIAL CONSTRUCTION

ANTENNA INSTALLATION NOTES:

1. WORK INCLUDED:
 - A. ANTENNA AND COAXIAL CABLES ARE FURNISHED BY AT&T MOBILITY UNDER A SEPARATE CONTRACT. THE CONTRACTOR SHALL ASSIST ANTENNA INSTALLATION CONTRACTOR IN TERMS OF COORDINATION AND SITE ACCESS. ERECTION SUBCONTRACTOR SHALL BE RESPONSIBLE FOR THE PROTECTION OF PERSONNEL AND
 - B. INSTALL ANTENNA AS INDICATE ON DRAWINGS AND AT&T MOBILITY SPECIFICATIONS.
 - C. INSTALL GALVANIZED STEEL ANTENNA MOUNTS AS INDICATED ON DRAWINGS
 - D. INSTALL FURNISHED GALVANIZED STEEL OR ALUMINUM WAVEGUIDE AND PROVIDE PRINTOUT OF THAT TEST.
 - E. CONTRACTOR SHALL PROVIDE FOUR (4) SETS OF SWEEP TESTS USING ANRITZU-PACKARD 8713B RF SCALAR NETWORK ANALYZER. SUBMIT FREQUENCY DOMAIN REFLECTOMETER(FDR) TESTS RESULTS TO THE PROJECT MANAGER. SWEEP TESTS SHALL BE AS PER ATTACHED RFS "MINIMUM FIELD TESTING RECOMMENDED FOR ANTENNA AND HELIAX COAXIAL CABLE SYSTEMS" DATED 10/5/93. TESTING SHALL BE PERFORMED BY AN INDEPENDENT TESTING SERVICE AND BE BOUND AND SUBMITTED WITHIN ONE WEEK OF WORK COMPLETION.
 - F. INSTALL COAXIAL CABLES AND TERMINATING BETWEEN ANTENNAS AND EQUIPMENT PER MANUFACTURER'S RECOMMENDATIONS. WEATHERPROOF ALL CONNECTIONS BETWEEN THE ANTENNA AND EQUIPMENT PER MANUFACTURER'S REQUIREMENTS. TERMINATE ALL COAXIAL CABLE THREE (3) FEET IN EXCESS OF ENTRY PORT LOCATION UNLESS OTHERWISE STATED.
 - G. ANTENNA AND COAXIAL CABLE GROUNDING:
2. ALL EXTERIOR #6 GREED GROUND WIRE "DAISY CHAIN" CONNECTIONS ARE TO BE

WEATHER SEALED WITH RFS CONNECTORS/SPLICE WEATHERPROOFING KIT #221213 OR EQUAL.

3. ALL COAXIAL CABLE GROUNDING KITS ARE TO BE INSTALLED ON STRAIGHT RUNS OF COAXIAL CABLE (NOT WITHIN BENDS)

AS-BUILT CDs
Ramapo Communication Corp
12/3/2020
Matthew Schlosser
Matthew Schlosser

ALL DISCREPANCIES FROM WHAT IS SHOWN ON THESE CONSTRUCTION DRAWINGS SHALL BE COMMUNICATED TO ATC ENGINEERING IMMEDIATELY FOR CORRECTION OR RE-DESIGN. FAILURE TO COMMUNICATE DIRECTLY WITH ATC ENGINEERING OR ANY CHANGES FROM THE DESIGN CONDUCTED WITHOUT PRIOR APPROVAL FROM ATC ENGINEERING SHALL BE THE SOLE RESPONSIBILITY OF THE GENERAL CONTRACTOR.



AMERICAN TOWER®



SMW ENGINEERING GROUP, INC.
 TOGETHER PLANNING A BETTER TOMORROW
 158 BUSINESS CENTER DRIVE
 BIRMINGHAM, AL 35244
 TEL: 205-252-6985 FAX: 205-320-1504



REV.	DESCRIPTION	BY	DATE
0	FOR CONSTRUCTION	ZDS	05/28/20

ATC SITE NUMBER:
411189

ATC SITE NAME:
CRANBURYSU CT

SITE ADDRESS:
 2 SUNNY LANE
 WESTPORT, CT 06880-1906

SEAL:

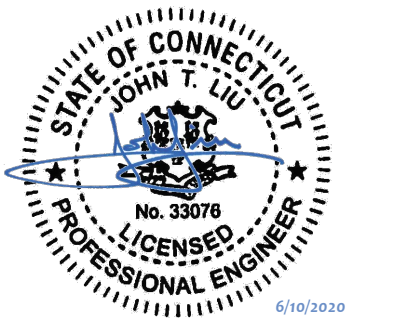DATE DRAWN:	05/13/20
ATC JOB NO:	411189-REV-1-1587496885727
CUSTOMER ID:	10035342
CUSTOMER #:	MRCTB045060, MRCTB045017, MRCTB045016, MRCTB045027, & MRCTB045127

GENERAL NOTES


SHEET NUMBER: G-002	REVISION: A
-------------------------------	-----------------------

Copyright © 2020 ATC IP, LLC. All Rights Reserved.

SITE PLAN NOTES:

1. THIS SITE PLAN REPRESENTS THE BEST PRESENT KNOWLEDGE AVAILABLE TO THE ENGINEER AT THE TIME OF THIS DESIGN. THE CONTRACTOR SHALL VISIT THE SITE PRIOR TO CONSTRUCTION AND VERIFY ALL EXISTING CONDITIONS RELATED TO THE SCOPE OF WORK FOR THIS PROJECT.
2. ICE BRIDGE, CABLE LADDER, COAX PORT, AND COAX CABLE ARE SHOWN FOR REFERENCE ONLY. CONTRACTOR SHALL CONFIRM THE EXACT LOCATION OF ALL PROPOSED AND EXISTING EQUIPMENT AND STRUCTURES DEPICTED ON THIS PLAN. BEFORE UTILIZING EXISTING CABLE SUPPORTS, COAX PORTS, INSTALLING NEW PORTS OR ANY OTHER EQUIPMENT, CONTRACTOR SHALL VERIFY ALL ASPECTS OF THE COMPONENTS MEET THE ATC SPECIFICATIONS.
3. THIS PROJECT INCLUDES NO INSTALL OR MODIFICATION AT GRADE.

LEGEND	
⊗	GROUNDING TEST WELL
ATS	AUTOMATIC TRANSFER SWITCH
B	BOLLARD
CSC	CELL SITE CABINET
D	DISCONNECT
E	ELECTRICAL
F	FIBER
GEN	GENERATOR
G	GENERATOR RECEPTACAL
HH, V	HAND HOLE, VAULT
IB	ICE BRIDGE
K	KENTROX BOX
LC	LIGHTING CONTROL
M	METER
PB	PULL BOX
PP	POWER POLE
T	TELCO
TRN	TRANSFORMER
— x —	CHAINLINK FENCE

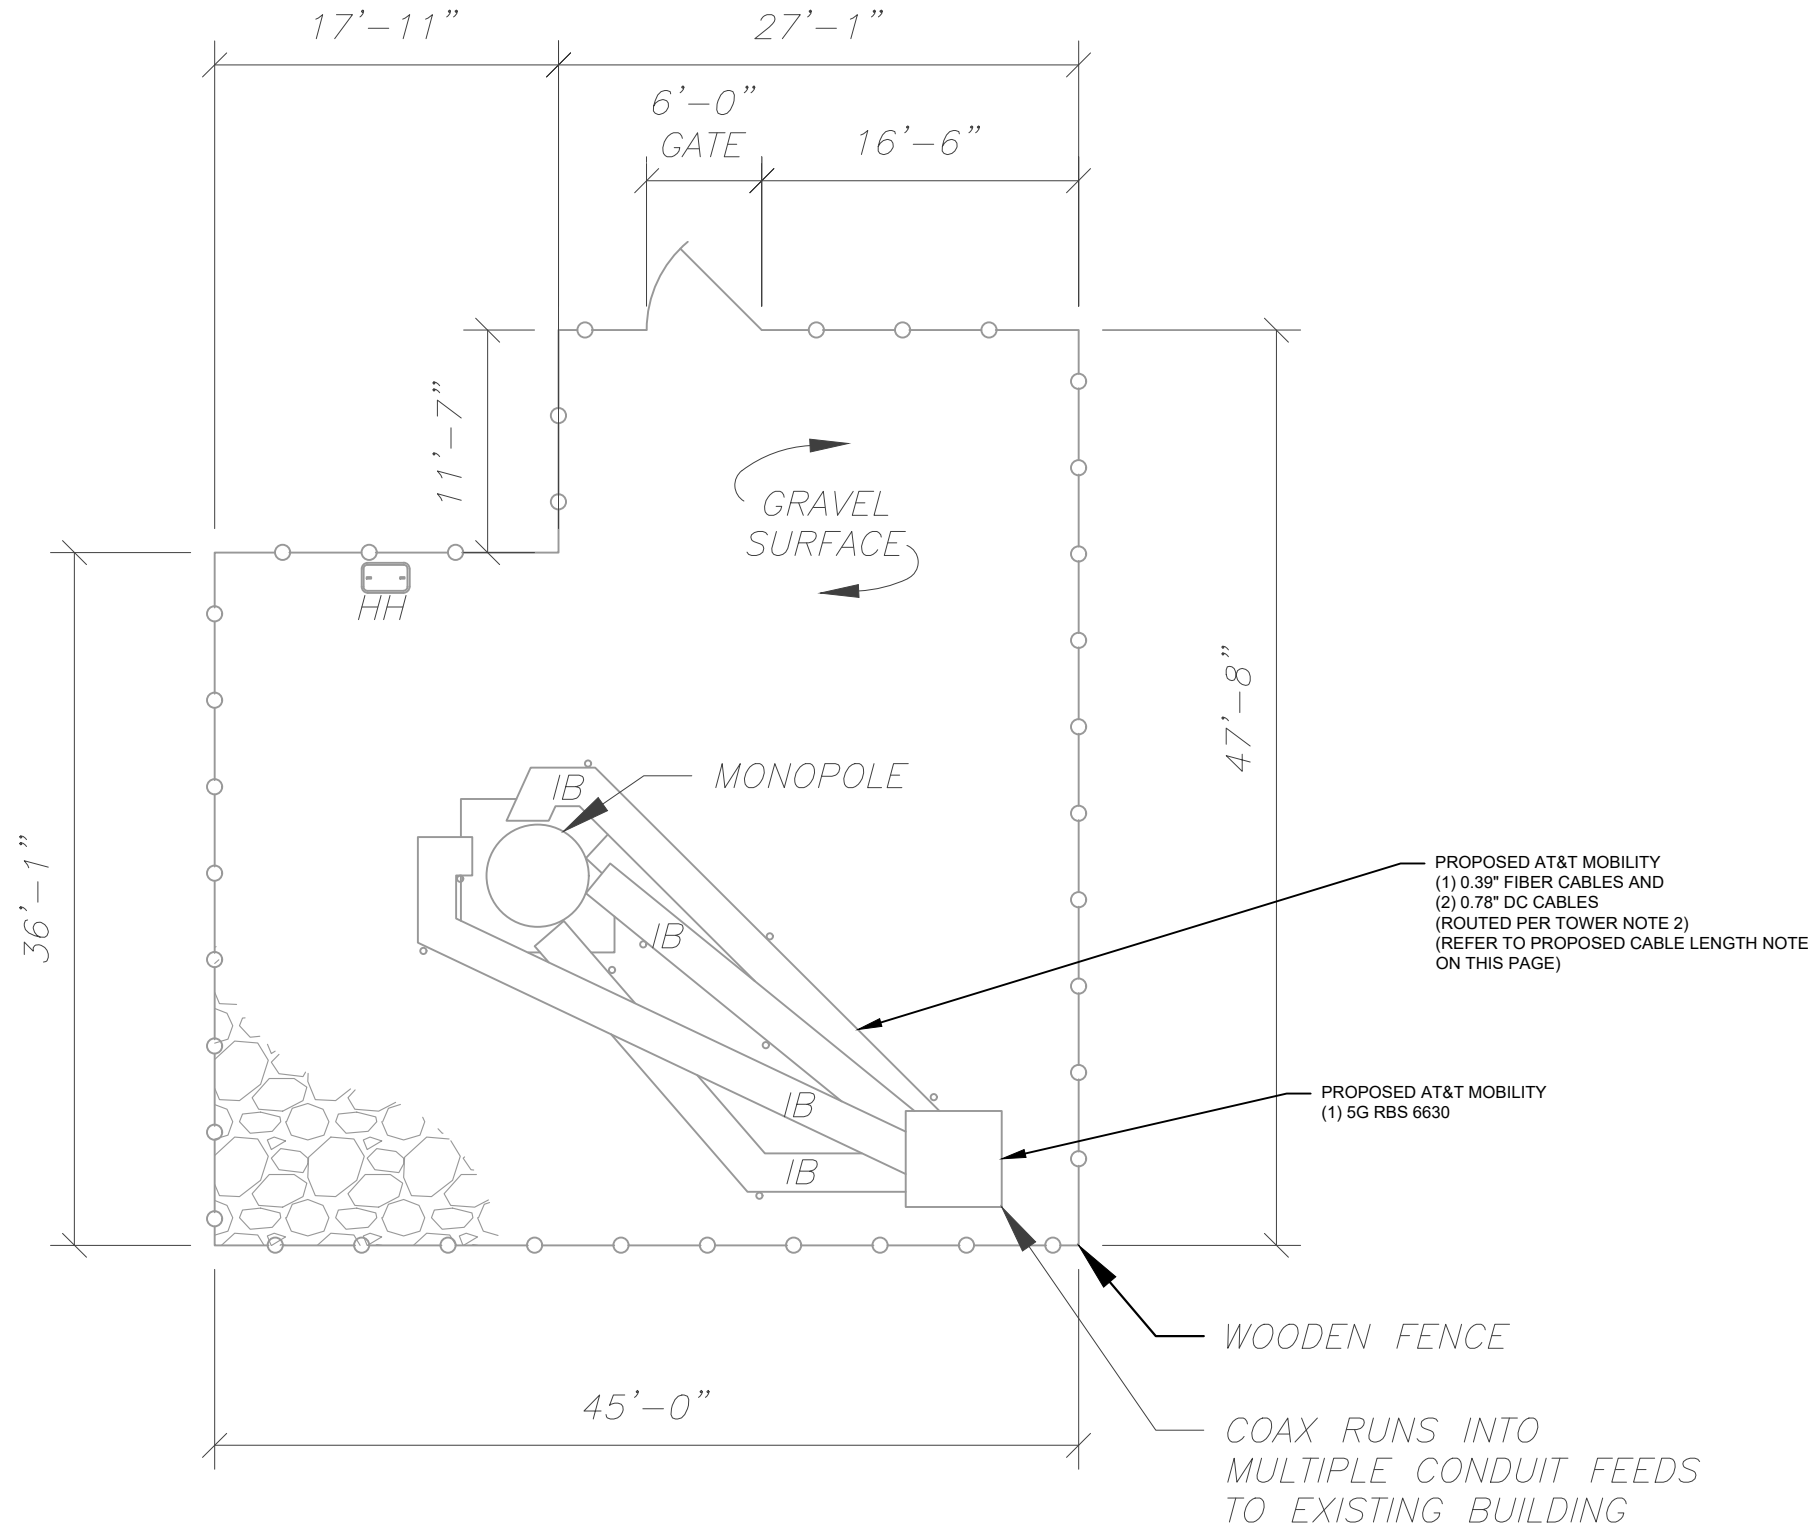

PROPOSED CABLE LENGTH:

1. ESTIMATED LENGTH OF PROPOSED CABLE IS **xxx**. ESTIMATED LENGTH OF CABLE WAS PROVIDED BY CUSTOMER OR CALCULATED BY ADDING THE RAD CENTER AND THE DISTANCE FROM THE SHELTER ENTRY PLATE TO THE TOWER (ALONG THE ICE BRIDGE) AND A SAFETY FACTOR MEASUREMENT OF 15% (OF THE TWO PREVIOUS VALUES). CDS DEFER TO GREATEST CABLE LENGTH.
2. ROUTE PROPOSED CABLES ALONG SAME PATH AS EXISTING CABLES AND IN ACCORDANCE WITH STRUCTURAL ANALYSIS. WHERE POSSIBLE UTILIZE EXISTING CABLE SUPPORT STRUCTURES AS PROVIDED FOR CARRIER TO ADEQUATELY SECURE CABLES, USING EITHER APPROPRIATELY SIZED STAINLESS STEEL SNAP-INS OR MOUNTING HARDWARE AND BRACKETS AS SPECIFIED BY CABLE MANUFACTURER. OTHERWISE, ATTACH CABLES TO HORIZONTAL OR DIAGONAL TOWER MEMBERS USING PROPOSED STAINLESS STEEL ADAPTERS (DO NOT ATTACH TO TOWER LEG).



AS-BUILT CDs
 Ramapo Communication Corp
 12/3/2020
 Matthew Schlosser
Matthew Schlosser

AMERICAN TOWER®


SMW ENGINEERING GROUP, INC.
 TOGETHER PLANNING A BETTER TOMORROW
 158 BUSINESS CENTER DRIVE
 BIRMINGHAM, AL 35244
 TEL: 205-252-6985 FAX: 205-320-1504

REV.	DESCRIPTION	BY	DATE
0	FOR CONSTRUCTION	ZDS	05/28/20

ATC SITE NUMBER:
411189

ATC SITE NAME:
CRANBURYSU CT

SITE ADDRESS:
 2 SUNNY LANE
 WESTPORT, CT 06880-1906

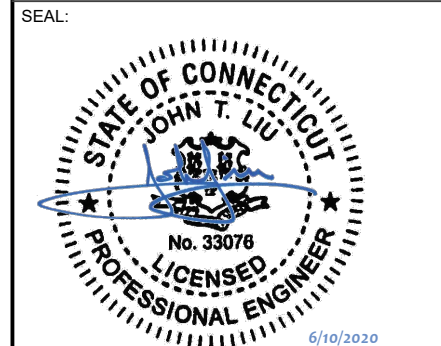

DATE DRAWN:	05/13/20
ATC JOB NO:	411189-REV-1-1587496885727
CUSTOMER ID:	10035342
CUSTOMER #:	MRCTB045060, MRCTB045017, MRCTB045016, MRCTB045027, & MRCTB045127

DATE DRAWN: 05/13/20
 ATC JOB NO: 411189-REV-1-1587496885727
 CUSTOMER ID: 10035342
 CUSTOMER #: MRCTB045060, MRCTB045017, MRCTB045016, MRCTB045027, & MRCTB045127

DETAILED SITE PLAN

SHEET NUMBER: **C-101** REVISION: **A**

EXISTING AND FINAL CONFIGURATIONS ARE BASED ON RFDS. CONTRACTOR TO VERIFY EXISTING CONDITIONS.

PER MOUNT ANALYSIS COMPLETED BY MASTEC, DATED 04/24/20, THE EXISTING MOUNT CAN NOT ADEQUATELY SUPPORT THE PROPOSED LOADING. A MOUNT MODIFICATION DESIGN SHALL BE COMPLETED AND MODIFICATION MUST BE INSTALLED PRIOR TO THE INSTALLATION OF THE PROPOSED ANTENNAS AND OTHER EQUIPMENT

TOWER NOTE:

- IT IS THE CONTRACTOR'S RESPONSIBILITY TO CONFIRM WITH THE AMERICAN TOWER CONSTRUCTION MANAGER THAT THEY HAVE THE MOST RECENT VERSION OF THE STRUCTURAL ANALYSIS BEFORE COMMENCING WORK. EXISTING AND PROPOSED TOWER APPURTENANCES, MOUNTS, AND ANTENNAS ARE SHOWN BASED ON THE STRUCTURAL ANALYSIS.
- ROUTE PROPOSED CABLES ALONG SAME PATH AS EXISTING CABLES AND IN ACCORDANCE WITH STRUCTURAL ANALYSIS. IF ADEQUATE SPACE EXISTS, ROUTE CABLES THROUGH ENTRY PORT HOLE, UP INSIDE OF MONOPOLE, AND THROUGH EXIT PORT HOLE. IF ROUTING OUTSIDE THE MONOPOLE, ATTACH CABLES USING STAND-OFF ADAPTERS MOUNTED TO TOWER USING STAINLESS STEEL BANDING. ADEQUATELY SECURE CABLES USING EITHER APPROPRIATELY SIZED STAINLESS STEEL SNAP-INS OR MOUNTING HARDWARE AND BRACKETS AS SPECIFIED BY CABLE MANUFACTURER.
- TOWER ELEVATIONS ARE MEASURED FROM TOP OF BASE PLATE TO MATCH STRUCTURAL ANALYSIS. ELEVATIONS DO NOT REFLECT TRUE ABOVE GROUND LEVEL (A.G.L.)

SCOPE OF WORK:

- WHEN STACKING CABLES 3 OR MORE DEEP, USE STACKABLE SNAP-INS, TALLEY PART NUMBER SSH-158-3 (OR ENGINEER APPROVED EQUAL).
- CONTRACTOR SHALL CONFIRM THE FINAL CABLE ROUTING PLAN WITH THE STRUCTURAL ANALYSIS.

COAXIAL CABLE NOTES:

- CONTRACTOR SHALL CONFIRM COAX COLOR CODING PRIOR TO CONSTRUCTION. REFER TO "ANTENNA SYSTEM LABELING STANDARD" ND-00027 LATEST VERISON.
- CONTRACTOR SHALL WEATHERPROOF ALL ANTENNA CONNECTORS WITH SELF AMALGAMATING TAPE. WEATHERPROOFING SHALL BE COMPLETED IN STRICT ACCODRANCE WITH AT&T STANDARDS.
- CONTRACTOR SHALL GROUND ALL EQUIPMENT. INCLUDING ANTENNAS, RET MOTORS, TMA'S, COAX CABLES, AND RET CONTROL CBALES AS A COMPLETE SYTEM. GROUNDING SHALL BE EXECUTED BY QUALIFIED WIREMEN IN COMPLIANCE WITH MANUFACTURER'S SPECIFICATION AND RECOMMENDATION.
- CONTRACTOR TO VERIFY THAT EXISTING COAX HANGERS ARE STACKABLE SNAP IN HANGERS. IF EXISTING HANGERS ARE NOT STACKABLE SNAP IN HANGERS THE CONTRACTOR SHALL REPLACE EXISTING HANGERS WITH NEW SNAP IN HANGERS IF APPLICABLE.



TOGETHER PLANNING A BETTER TOMORROW
158 BUSINESS CENTER DRIVE
BIRMINGHAM, AL 35244
TEL: 205-252-6985 FAX: 205-320-1504

REV.	DESCRIPTION	BY	DATE
0	FOR CONSTRUCTION	ZDS	05/28/20

ATC SITE NUMBER:

411189


ATC SITE NAME:

CRANBURYSU CT

SITE ADDRESS:

2 SUNNY LANE
WESTPORT, CT 06880-1906

SEAL:

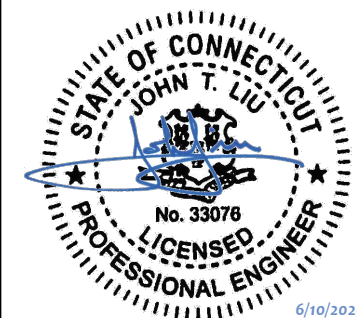

DATE DRAWN:	05/13/20
ATC JOB NO:	411189-REV-1-1587496885727
CUSTOMER ID:	10035342
CUSTOMER #:	MRCTB045060, MRCTB045017, MRCTB045016, MRCTB045027, & MRCTB045127


TOWER ELEVATION

SHEET NUMBER:

C-201


REVISION:

A

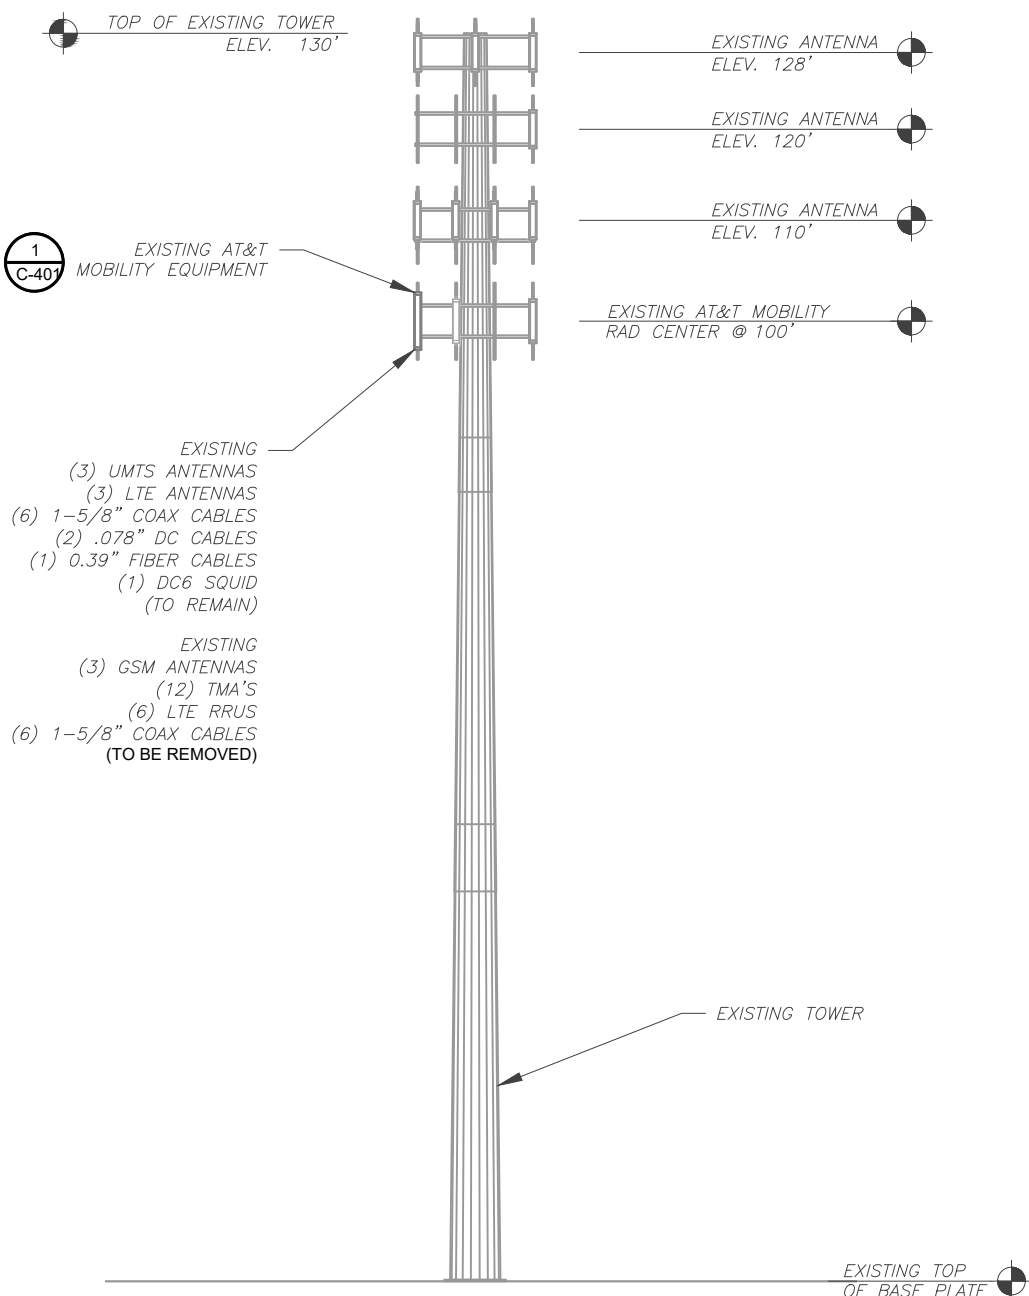

1 EXISTING TOWER ELEVATION

SCALE: 1" = 20'

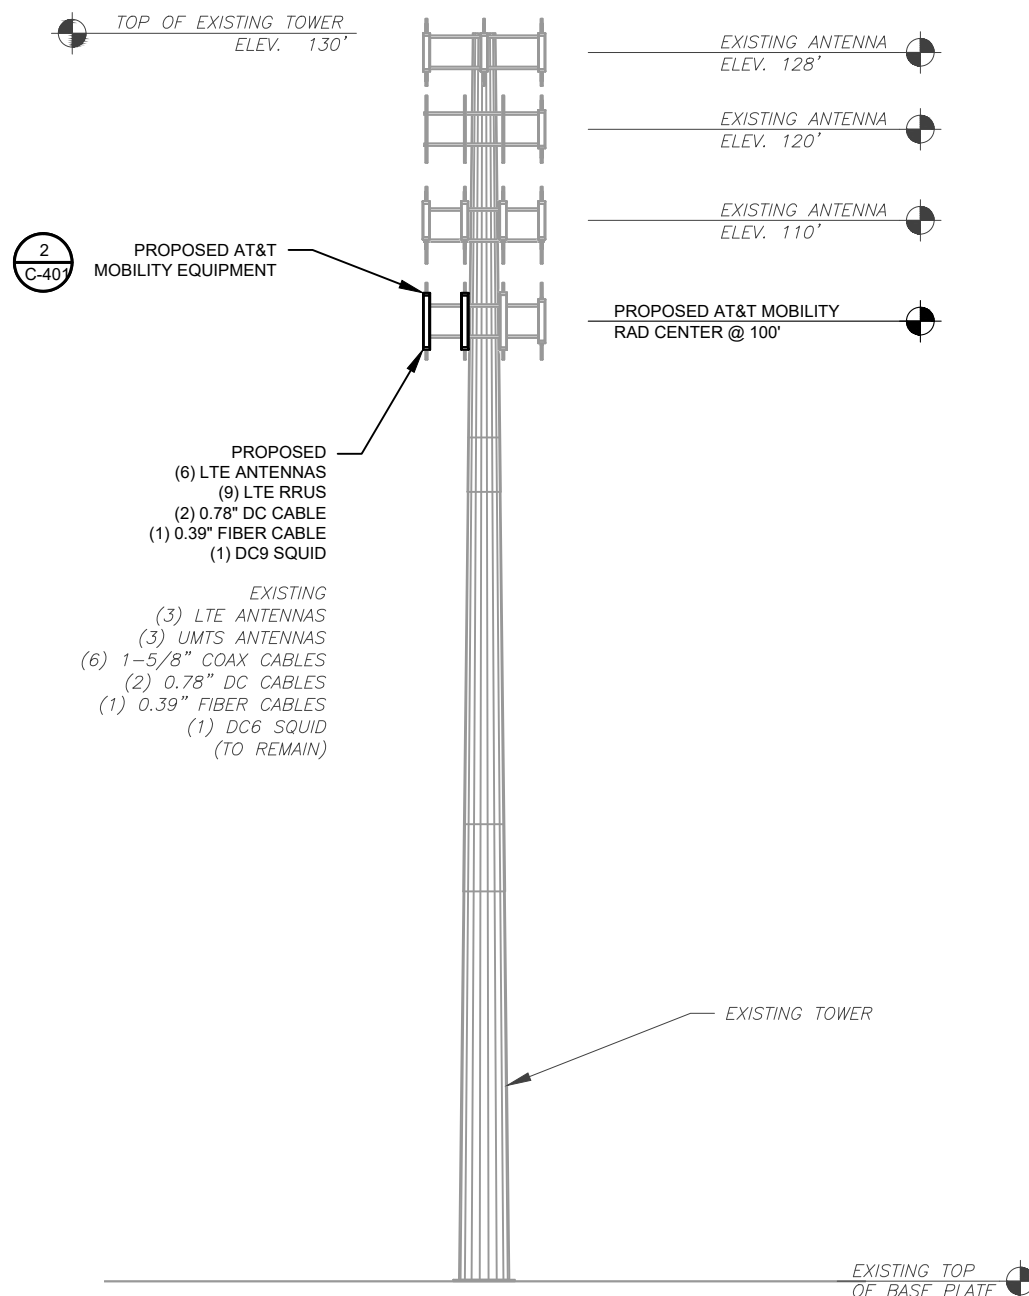


2 FINAL TOWER ELEVATION

SCALE: 1" = 20'

AS-BUILT CDs
Ramapo Communication Corp
12/3/2020
Matthew Schlosser
Matthew Schlosser


Copyright © 2020 ATC IP, LLC. All Rights Reserved.

EXISTING AND FINAL CONFIGURATIONS ARE BASED ON RFDS. CONTRACTOR TO VERIFY EXISTING CONDITIONS.

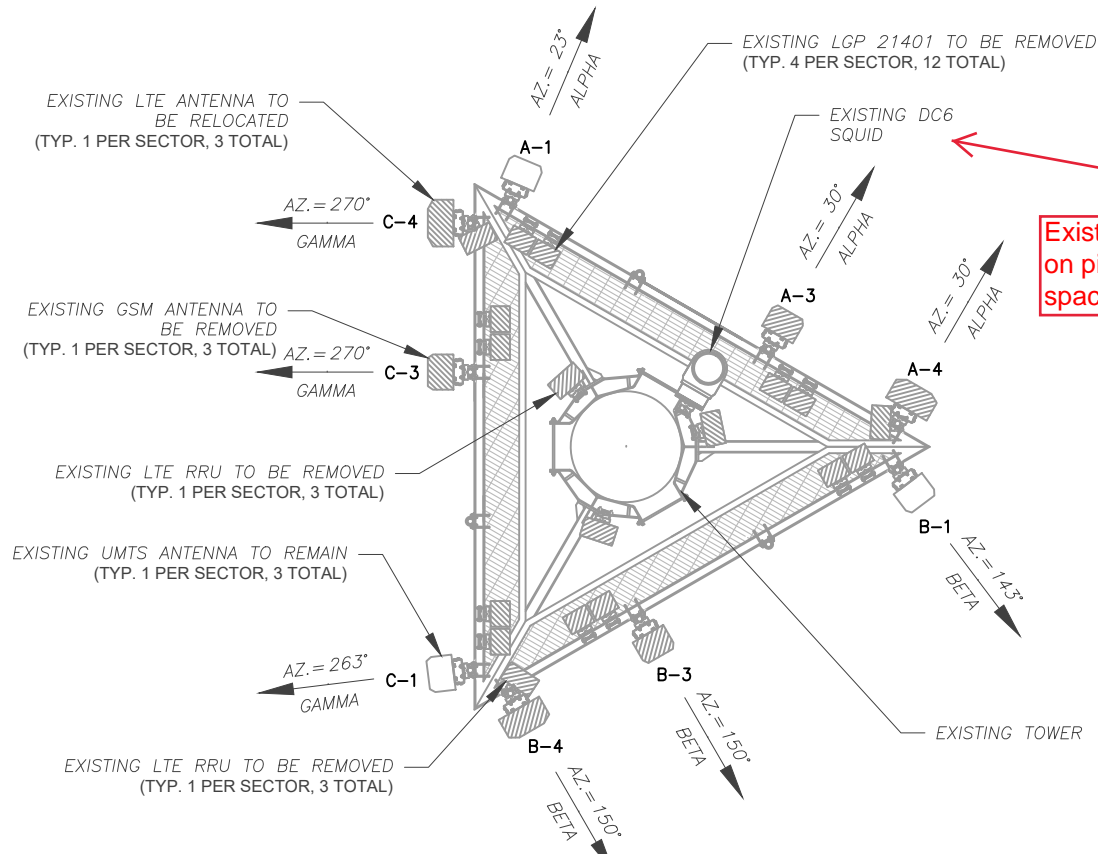

1 CURRENT ANTENNA PLAN
1" = 5'-0"

PER MOUNT ANALYSIS COMPLETED BY MASTEC, DATED 04/24/20, THE EXISTING MOUNT CAN NOT ADEQUATELY SUPPORT THE PROPOSED LOADING. A MOUNT MODIFICATION DESIGN SHALL BE COMPLETED AND MODIFICATION MUST BE INSTALLED PRIOR TO THE INSTALLATION OF THE PROPOSED ANTENNAS AND OTHER EQUIPMENT

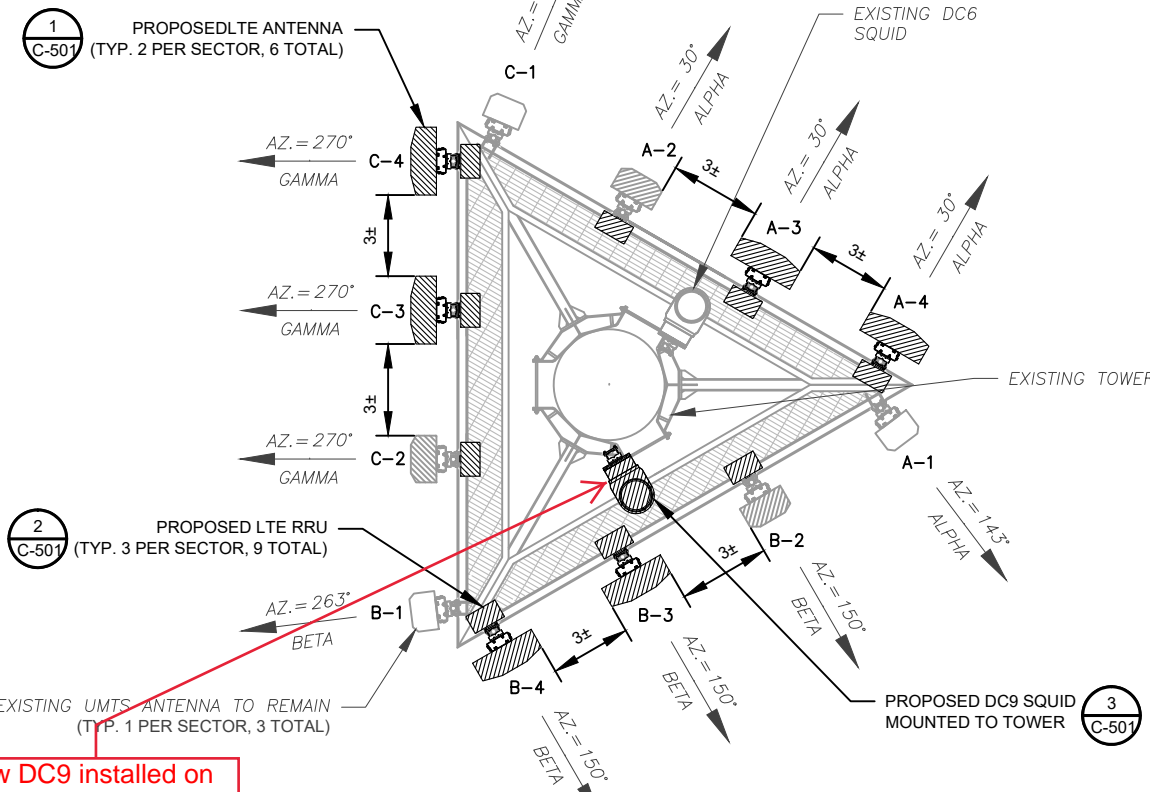

2 FINAL ANTENNA PLAN
1" = 5'-0"

PROPOSED RRUs MUST BE INSTALLED A MINIMUM OF 8" AWAY FROM ALL ANTENNAS

EXISTING ANTENNA SCHEDULE								
LOCATION			ANTENNA SUMMARY				NON ANTENNA SUMMARY	
SECTOR	RAD	AZ	POS	ANTENNA	BAND	STATUS	ADDITIONAL TOWER MOUNTED EQUIPMENT	STATUS
FIND	100'	23°	A1	POWER WAVE 7770	UMTS	RMN	(2) POWERWAVE LGP 12104 TMA	RMV
		-	A2	-	-	-	-	-
		30°	A3	POWERWAVE 7770	GSM	RMV	(2) POWERWAVE LGP 12104 TMA	RMV
		30°	A4	CCI HPA-65R-BUU-H6	LTE	REL	RRUS-11 B12 RRUS-12 B2	RMV
BETA	100'	143°	B1	POWER WAVE 7770	UMTS	RMN	(2) POWERWAVE LGP 12104 TMA	RMV
		-	B2	-	-	-	-	-
		150°	B3	POWERWAVE 7770	GSM	RMV	(2) POWERWAVE LGP 12104 TMA	RMV
		150°	B4	CCI HPA-65R-BUU-H6	LTE	REL	RRUS-11 B12 RRUS-12 B2	RMV
GAMMA	100'	263°	C1	POWER WAVE 7770	UMTS	RMN	(2) POWERWAVE LGP 12104 TMA	RMV
		-	C2	-	-	-	-	-
		270°	C3	POWERWAVE 7770	GSM	RMV	(2) POWERWAVE LGP 12104 TMA	RMV
		270°	C4	CCI HPA-65R-BUU-H6	LTE	REL	RRUS-11 B12 RRUS-12 B2	RMV

- NOTES
- BASED ON APPROVED ATC APPLICATION 411189-REV-1-1587496885727, DATED 04/21/20. CONFIRM WITH AT&T MOBILITY REP FOR APPLICABLE UPDATES/REVISIONS AND MOST RECENT RFDS FOR NSN CONFIGURATION (CONFIG). GC TO CAP ALL UNUSED PORTS.
 - ATC HAS NOT YET VERIFIED ANY EXISTING ANTENNA CONFIG OR MOUNT CONFIG. CONTRACTOR TO VERIFY MOUNT CONFIG HAS SUFFICIENT SPACE FOR PROPOSED LESSEE EQUIPMENT (EQUIP) (I.E. CLEARANCES, MOUNT PIPE, SUFFICIENT LENGTH, ETC.) ATC DID NOT ANALYZE ANTENNA MOUNT TO DETERMINE ADEQUATE STRUCTURAL CAPACITY FOR ANY LESSEE LOADING.
 - ALL PROPOSED EQUIP INCLUDING ANTENNAS, COAX, ETC. SHALL BE MOUNTED IN ACCORDANCE WITH THE TOWER STRUCTURAL ANALYSIS ON FILE WITH ATC'S CM.
 - CONFIRM SPACING OF PROPOSED EQUIP DOES NOT CAUSE TOWER CONFLICTS NOR IMPEDE TOWER CLIMBING PEGS.
 - POSITIONS START WITH FIRST PIPE ON THE LEFT SIDE (AS VIEWED FROM BEHIND THE MOUNT).

FINAL ANTENNA SCHEDULE								
LOCATION			ANTENNA SUMMARY				NON ANTENNA SUMMARY	
SECTOR	RAD	AZ	POS	ANTENNA	BAND	STATUS	ADDITIONAL TOWER MOUNTED EQUIPMENT	STATUS
ALPHA	100'	23°	C1	POWER WAVE 7770	UMTS	RMN	-	-
		30°	A2	CCI HPA-65R-BUU-H6	LTE	REL	RRUS-4415 B30	ADD
		30°	A3	CCI OPA65R-BU6DA	LTE	ADD	RRUS-8843 B2/B66A	ADD
		30°	A4	CCI DMP65R-BU6DA	LTE	ADD	RRUS-4449 B5/B12	ADD
BETA	100'	143°	A1	POWER WAVE 7770	UMTS	RMN	-	-
		150°	B2	CCI HPA-65R-BUU-H6	LTE	REL	RRUS-4415 B30	ADD
		150°	B3	CCI OPA65R-BU6DA	LTE	ADD	RRUS-8843 B2/B66A	ADD
		150°	B4	CCI DMP65R-BU6DA	LTE	ADD	RRUS-4449 B5/B12	ADD
GAMMA	100'	263°	B1	POWER WAVE 7770	UMTS	RMN	-	-
		270°	C2	CCI HPA-65R-BUU-H6	LTE	REL	RRUS-4415 B30	ADD
		270°	C3	CCI OPA65R-BU6DA	LTE	ADD	RRUS-8843 B2/B66A	ADD
		270°	C4	CCI DMP65R-BU6DA	LTE	ADD	RRUS-4449 B5/B12	ADD

AS-BUILT CDs
Ramapo Communication Corp
12/3/2020
Matthew Schlosser
Matthew Schlosser

EXISTING FIBER DISTRIBUTION/SQUID		EXISTING CABLING SUMMARY			
MODEL NUMBER	STATUS	COAX	DC	FIBER	STATUS
DC6-48-60-18-8F	RMN	(6) 1-5/8" COAX	(2) 0.78"	(1) 0.40"	RMN
-	-	(6) 1-5/8" COAX	-	-	RMV

STATUS ABBREVIATIONS
RMV: TO BE REMOVED
RMN: TO REMAIN
REL: TO BE RELOCATED
DSC: TO BE DISCONNECTED & REMAIN
ADD: TO BE ADDED

3 EQUIPMENT SCHEDULES

CABLE LENGTHS FOR JUMPERS
FIBER DISTRIBUTION/SQUID TO RRU: 15'
RRU TO ANTENNA: 10'

FINAL FIBER DISTRIBUTION/SQUID		FINAL CABLING SUMMARY			
MODEL NUMBER	STATUS	COAX	DC	FIBER	STATUS
DC6-48-60-18-8F	RMN	(6) 1-5/8" COAX	(2) 0.78"	(1) 0.39"	RMN
DC9-48-60-24-8C-EV	ADD	-	(2) 0.78"	(1) 0.39"	ADD

AMERICAN TOWER®

SMW ENGINEERING GROUP, INC.


TOGETHER PLANNING A BETTER TOMORROW
158 BUSINESS CENTER DRIVE
BIRMINGHAM, AL 35244
TEL: 205-252-6985 FAX: 205-320-1504

REV.	DESCRIPTION	BY	DATE
0	FOR CONSTRUCTION	ZDS	05/28/20
1	FOR CONSTRUCTION	ZDS	06/10/20

ATC SITE NUMBER:
411189

ATC SITE NAME:
CRANBURYSU CT

SITE ADDRESS:
2 SUNNY LANE
WESTPORT, CT 06880-1906

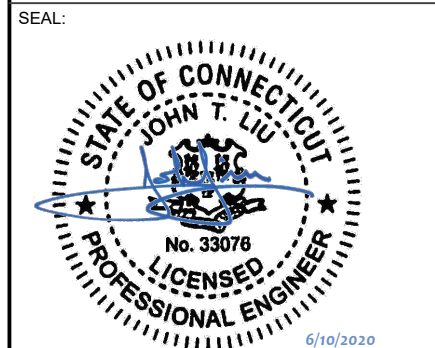


DATE DRAWN:	05/13/20
ATC JOB NO:	411189-REV-1-1587496885727
CUSTOMER ID:	10035342
CUSTOMER #:	MRCTB045060, MRCTB045017, MRCTB045016, MRCTB045027, & MRCTB045127


RF SCHEDULE AND ANTENNA INSTALLATION

SHEET NUMBER:
C-401


REVISION:
A

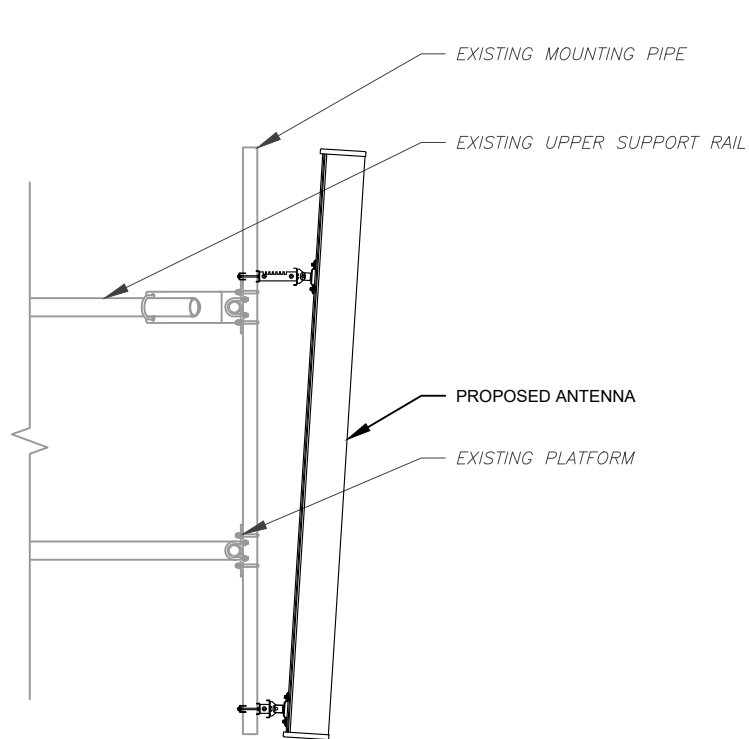

1 ANTENNA DETAIL
SCALE: N.T.S.

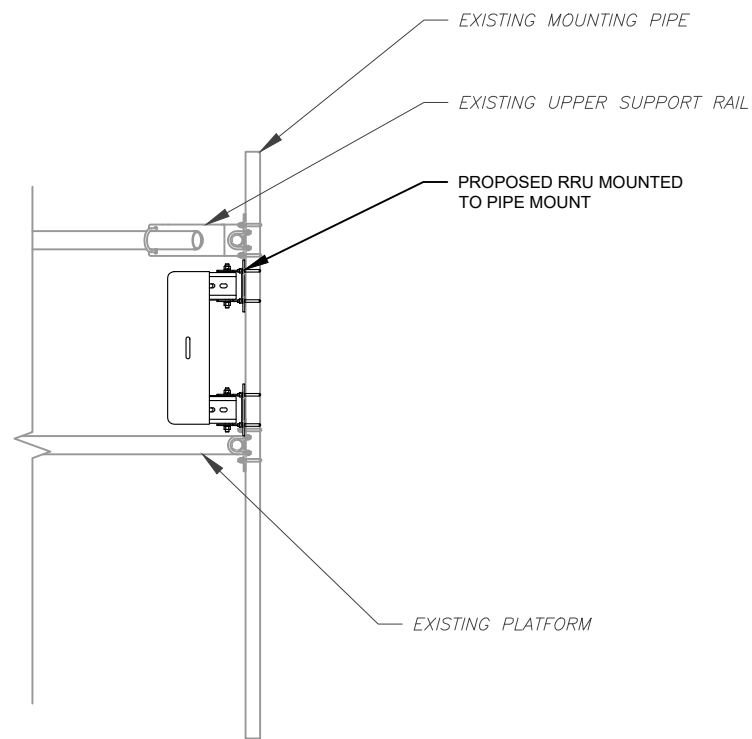

2 RRU DETAIL
SCALE: N.T.S.

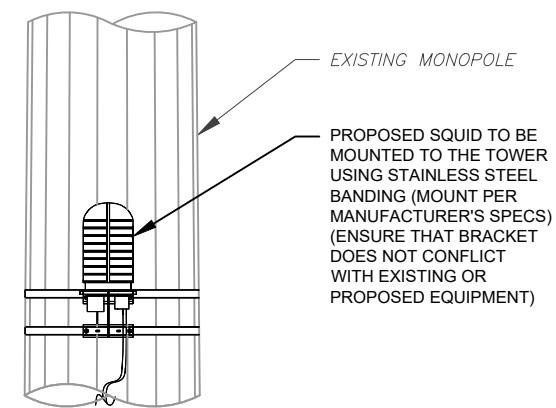

3 PROPOSED SQUID MOUNTING
SCALE: NOT TO SCALE

AS-BUILT CDs
Ramapo Communication Corp
12/3/2020
Matthew Schlosser
Matthew Schlosser




TOGETHER PLANNING A BETTER TOMORROW
158 BUSINESS CENTER DRIVE
BIRMINGHAM, AL 35244
TEL: 205-252-6985 FAX: 205-320-1504

REV.	DESCRIPTION	BY	DATE
0	FOR CONSTRUCTION	ZDS	05/28/20
1	FOR CONSTRUCTION	ZDS	06/10/20

ATC SITE NUMBER:
411189
ATC SITE NAME:
CRANBURYSU CT

SITE ADDRESS:
2 SUNNY LANE
WESTPORT, CT 06880-1906

SEAL:

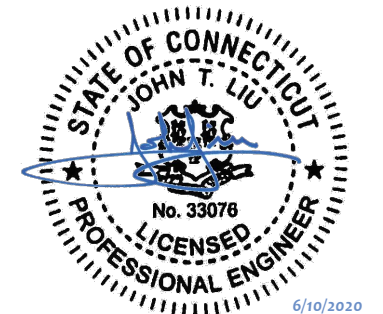


DATE DRAWN:	05/13/20
ATC JOB NO:	411189-REV-1-1587496885727
CUSTOMER ID:	10035342
CUSTOMER #:	MRCTB045060, MRCTB045017, MRCTB045016, MRCTB045027, & MRCTB045127


CONSTRUCTION
DETAILS

SHEET NUMBER: C-501	REVISION: A
-------------------------------	-----------------------



Copyright © 2020 ATC IP, LLC. All Rights Reserved.

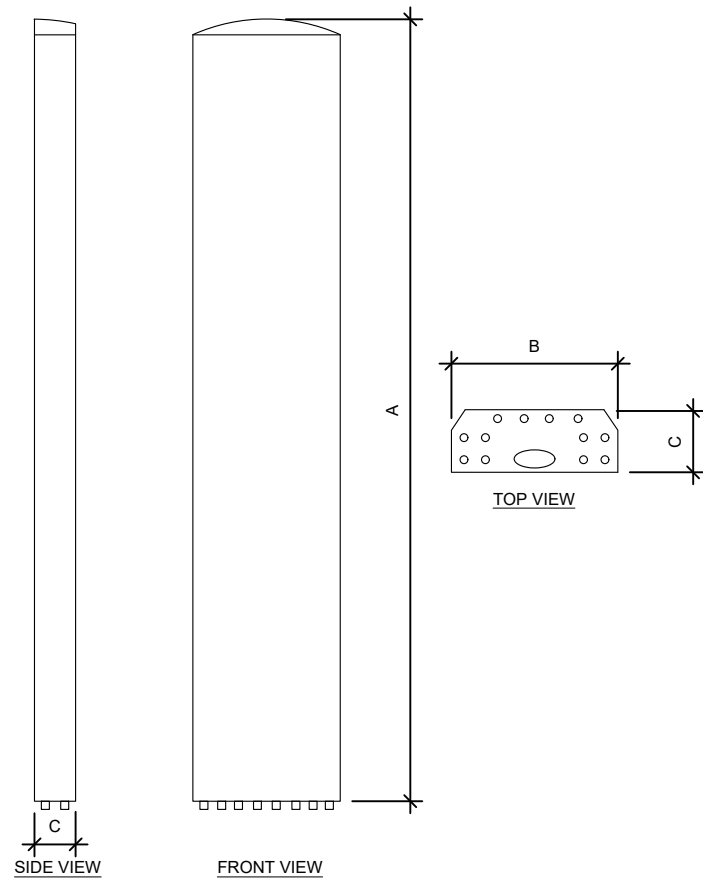

ANTENNA SPECIFICATIONS				
ANTENNA MODEL	A	B	C	WEIGHT (LBS)
CCI OPA65R-BU6DA	71.2"	21.0"	7.8"	60.2
CCI DMP65R-BU6DA	71.2"	20.7"	7.7"	79.4

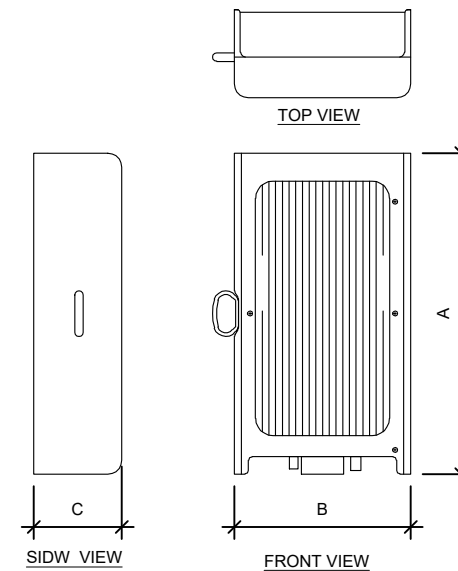

RRU SPECIFICATIONS				
RRU MODEL	A	B	C	WEIGHT (LBS)
4415 B30	16.5"	13.4"	5.9"	46.0
RRUS-8843 B2/B66A	18.0"	13.2"	11.3"	75.0
4449 B5, B12	17.9"	13.2"	9.4"	71.0

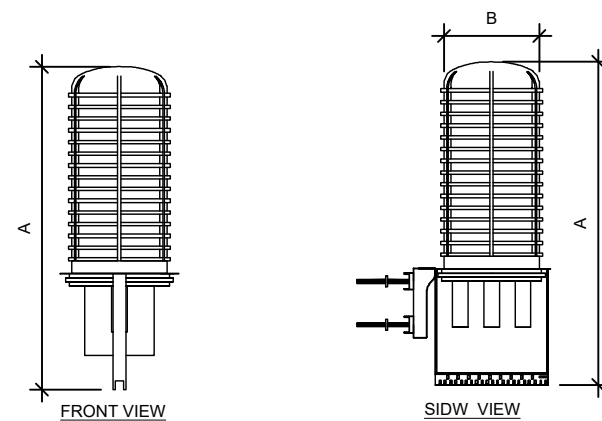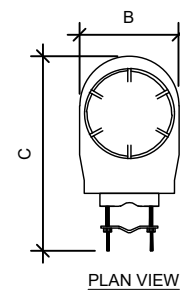

RAYCAP SPECIFICATIONS				
RAYCAP MODEL	A	B	C	WEIGHT (LBS)
DC9-48-60-24-8C-EV	31.41"	10.24"	18.28"	16.0

1 EQUIPMENT SPECIFICATIONS
SCALE: NOT TO SCALE

AS-BUILT CDs
Ramapo Communication Corp
12/3/2020
Matthew Schlosser
Matthew Schlosser




TOGETHER PLANNING A BETTER TOMORROW
158 BUSINESS CENTER DRIVE
BIRMINGHAM, AL 35244
TEL: 205-252-6985 FAX: 205-320-1504

REV.	DESCRIPTION	BY	DATE
0	FOR CONSTRUCTION	ZDS	05/28/20

ATC SITE NUMBER:
411189
ATC SITE NAME:
CRANBURYSU CT

SITE ADDRESS:
2 SUNNY LANE
WESTPORT, CT 06880-1906

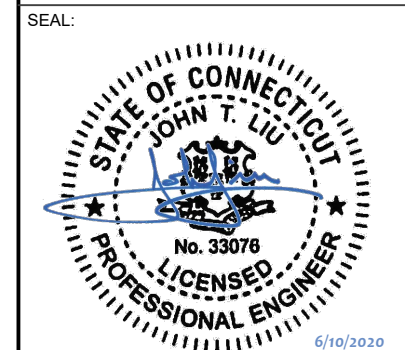


DATE DRAWN:	05/13/20
ATC JOB NO:	411189-REV-1-1587496885727
CUSTOMER ID:	10035342
CUSTOMER #:	MRCTB045060, MRCTB045017, MRCTB045016, MRCTB045027, & MRCTB045127

EQUIPMENT SPECIFICATIONS


SHEET NUMBER:
C-502
REVISION:
A

Copyright © 2020 ATC IP, LLC. All Rights Reserved.

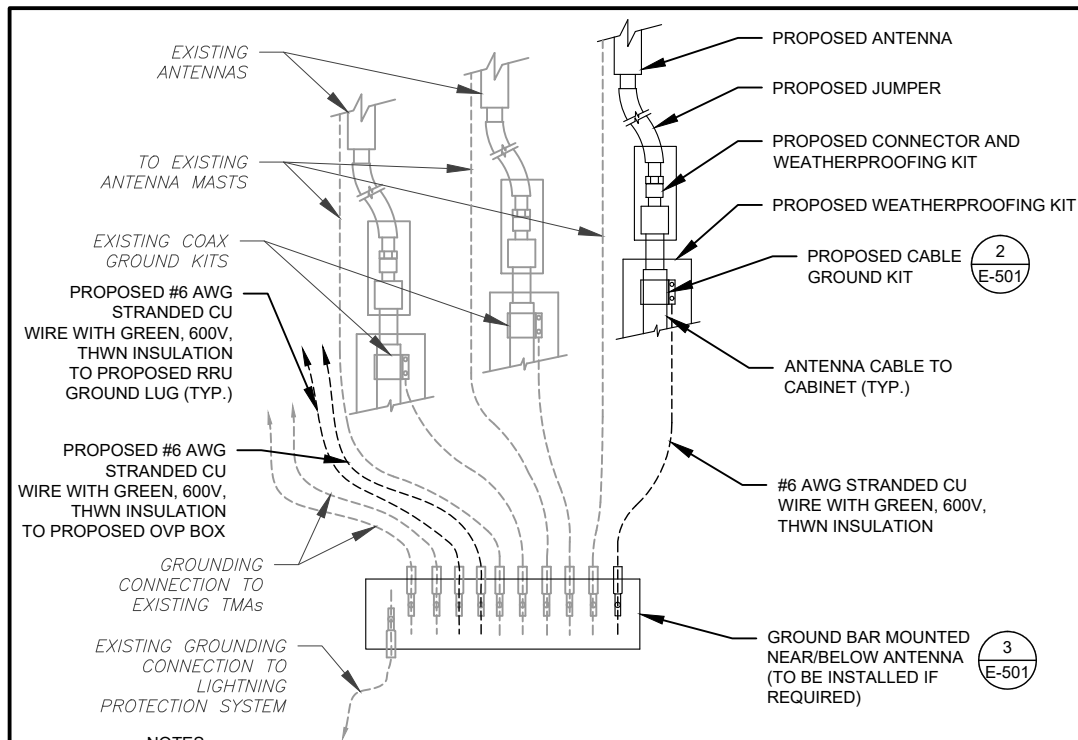


- NOTES:**
1. THIS DETAIL IS INTENDED TO SHOW THE GENERAL GROUNDING REQUIREMENTS. SLIGHT ADJUSTMENTS MAY BE REQUIRED BASED ON EXISTING SITE CONDITIONS. THE CONTRACTOR SHALL MAKE FIELD ADJUSTMENTS AS NEEDED AND INFORM THE CONSTRUCTION MANAGER OF ANY CONFLICTS.
 2. SITE GROUNDING SHALL COMPLY WITH AT&T MOBILITY GROUNDING STANDARDS, LATEST EDITION, AND COMPLY WITH AT&T MOBILITY GROUNDING CHECKLIST, LATEST VERSION. WHEN NATIONAL AND LOCAL GROUNDING CODES ARE MORE STRINGENT THEY SHALL GOVERN.

1 TYPICAL ANTENNA GROUNDING DIAGRAM
SCALE: N.T.S.

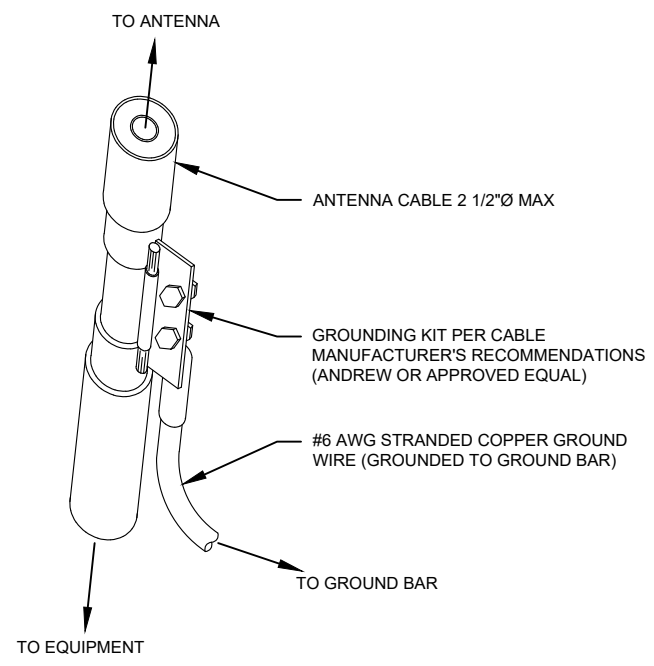


- GROUND KIT NOTES:**
1. DO NOT INSTALL CABLE GROUND KIT AT A BEND AND ALWAYS DIRECT GROUND WIRE DOWN TO GROUND BAR.
 2. CONTRACTOR SHALL PROVIDE WEATHERPROOFING KIT (ANDREW PART NUMBER 221213) AND INSTALL/TAPE PER MANUFACTURER'S SPECIFICATIONS.

2 CABLE GROUND KIT CONNECTION DETAIL
SCALE: N.T.S.

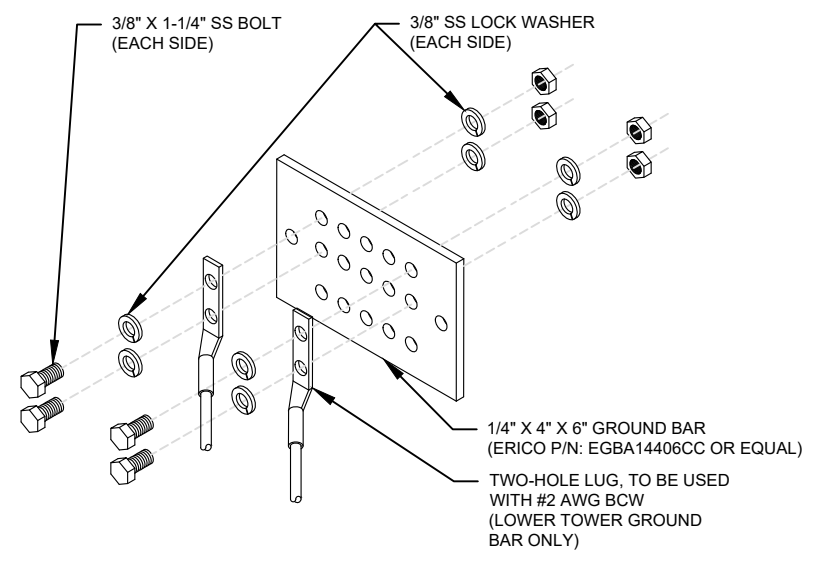


- GROUND BAR NOTES:**
1. GROUND BAR KITS COME WITH ALL HARDWARE, NUTS, BOLTS, WASHERS, ETC. EXCEPT THE STRUCTURAL MOUNTING MEMBER(S).
 2. GROUND BAR TO BE BONDED DIRECTLY TO TOWER.

3 TOWER GROUND BAR DETAIL
SCALE: N.T.S.

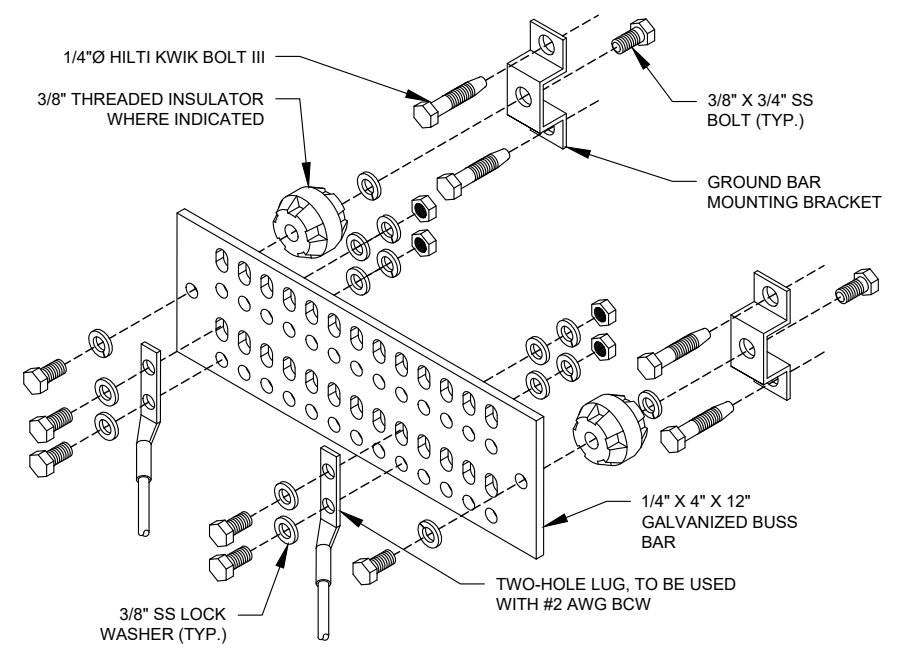


- GROUND BAR NOTES:**
1. GROUND KITS COME WITH ALL HARDWARE, NUTS, BOLTS, WASHERS, ETC. EXCEPT THE STRUCTURAL MOUNTING MEMBER(S).
 2. GROUND BAR SHALL BE BOLTED TO STRUCTURAL MEMBER OR ANCHORED TO CONCRETE SLAB W/ HILTI KWIK BOLT III.

4 MAIN GROUND BAR DETAIL
SCALE: N.T.S.

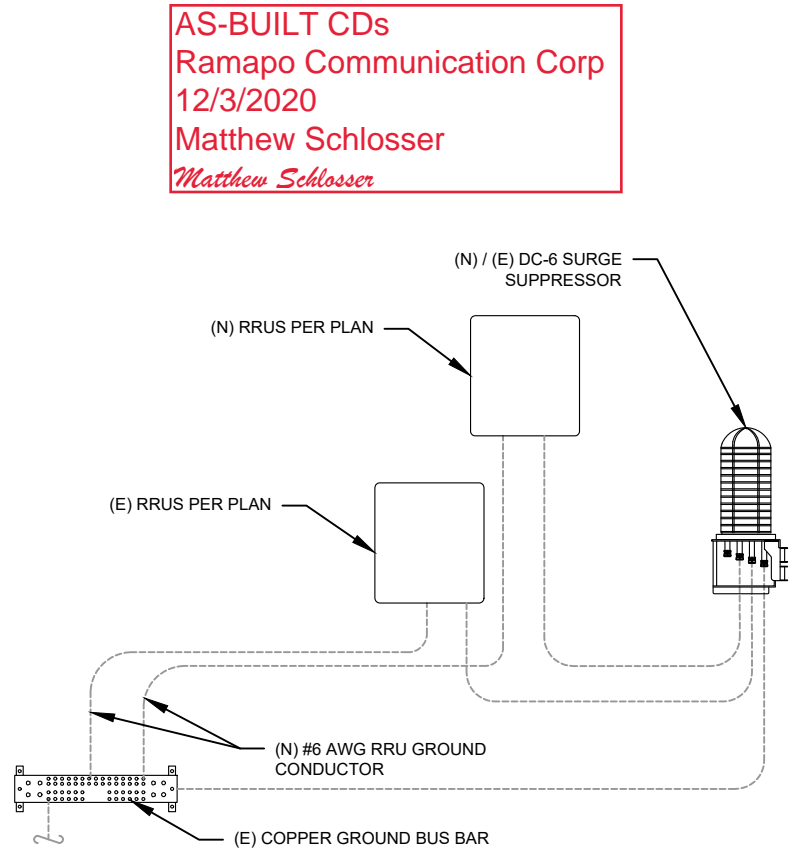

5 RRU GROUNDING
SCALE: N.T.S.

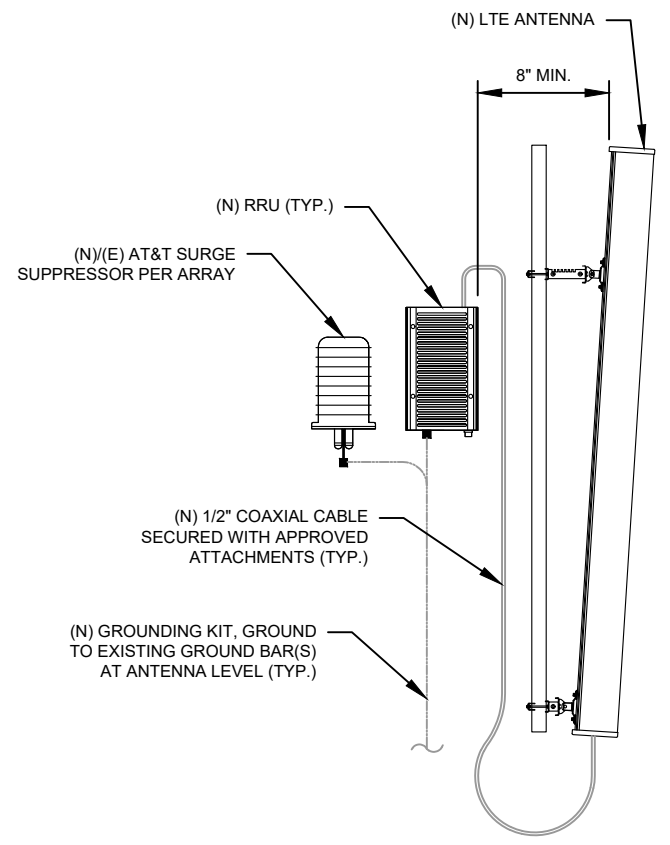

6 ANTENNA/RRU GROUNDING
SCALE: N.T.S.

AS-BUILT CDs
Ramapo Communication Corp
12/3/2020
Matthew Schlosser
Matthew Schlosser




TOGETHER PLANNING A BETTER TOMORROW
 158 BUSINESS CENTER DRIVE
 BIRMINGHAM, AL 35244
 TEL: 205-252-6985 FAX: 205-320-1504

REV.	DESCRIPTION	BY	DATE
0	FOR CONSTRUCTION	ZDS	05/28/20

ATC SITE NUMBER:
411189

ATC SITE NAME:
CRANBURYSU CT

SITE ADDRESS:
2 SUNNY LANE
WESTPORT, CT 06880-1906

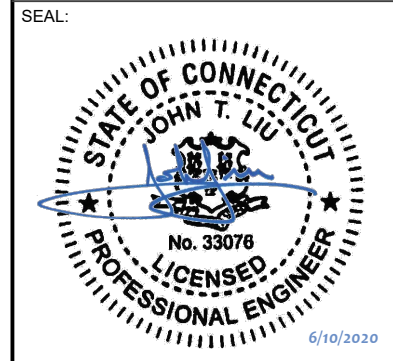

DATE DRAWN:	05/13/20
ATC JOB NO:	411189-REV-1-1587496885727
CUSTOMER ID:	10035342
CUSTOMER #:	MRCTB045060, MRCTB045017, MRCTB045016, MRCTB045027, & MRCTB045127

GROUNDING DETAILS

SHEET NUMBER:
E-501

REVISION:
A

Copyright © 2020 ATC IP, LLC. All Rights Reserved.



AS-BUILT CDs
 Ramapo Communication Corp
 12/3/2020
 Matthew Schlosser
Matthew Schlosser

May 18, 2020

Geoff Middlebrooks
 American Tower Corporation
 3500 Regency Parkway, Suite 100
 Cary, NC 27518

MasTec Network Solutions
 507 Airport Blvd, Suite 111
 Morrisville, NC 27560
 Tel (919) 674-5895
 MNS.Engineering@mastec.com

Subject: Mount Modification Structural Analysis

ATC Designation: Site Name: Cranburysu CT
 Site Number: 411189

Carrier Designation: Carrier: AT&T
 Site Name: MRCTB045060
 Site Number: CTL02094
 FA Number: 10035342

Engineering Firm Designation: MNS Project Number: 21944-MOD1

Site Data: 2 Sunny Ln, Westport, Fairfield County, CT 06880
 Latitude 41.1628°, Longitude -73.3735°
 130 ft Monopole
 100 ft RAD Center (14.5 ft Platform w/ Handrail)

Dear Geoff,

MasTec Network Solutions is pleased to submit this Mount Modification Structural Analysis to determine the structural integrity of the above-mentioned structure.

This analysis has been performed in compliance with the *ANSI/TIA-222-H Structural Standard for Antenna Supporting Structures and Antennas and Small Wind Turbine Support Structures*. Based on our analysis we have determined the structural strength to have the following result:

Antenna Mounting Structure 49% Sufficient*

*Structure has sufficient capacity provided the proposed reinforcement is installed as recommended.

We at MasTec Network Solutions appreciate the opportunity of providing continued specialty services. Please do not hesitate to contact our office should you have any questions.

Prepared By:

Noah Noxon, EIT
 Structural Engineer I



Reviewed By:

Digitally signed by Raphael Mohamed
 DN: E=Raphael.Mohamed@mastec.com, CN=Raphael Mohamed, OU=Users, OU=MasTec Network Solutions, OU=Senior Lives, DC=mastec, DC=local
 Date: 2020.05.18 15:24:05-0400


Raphael I. Mohamed, PE, PEng
 Senior Director of Engineering
 CT PE License No. 25112

This item has been digitally signed and sealed by Raphael I. Mohamed, PE.
 Printed copies of this document are not considered signed and sealed and the signature must be verified on any electronic copies.

NOTE: THIS SHEET WAS CREATED BY OTHERS AND PROVIDED AT THE REQUEST OF THE CUSTOMER WITHOUT EDIT. PLEASE REFERENCE THE MOUNT ANALYSIS REPORT FOR COMPLETE MOUNT ANALYSIS CALCULATIONS AND DETAILS. SUPPLEMENTAL PAGES INCLUDED IN THE CONSTRUCTION DRAWINGS ARE FOR REFERENCE ONLY. GENERAL CONTRACTOR IS TO VERIFY THEY HAVE THE MOST RECENT MOUNT ANALYSIS PRIOR TO CONSTRUCTION.

SUPPLEMENTAL

SHEET NUMBER: R-601	REVISION: A
-------------------------------	-----------------------

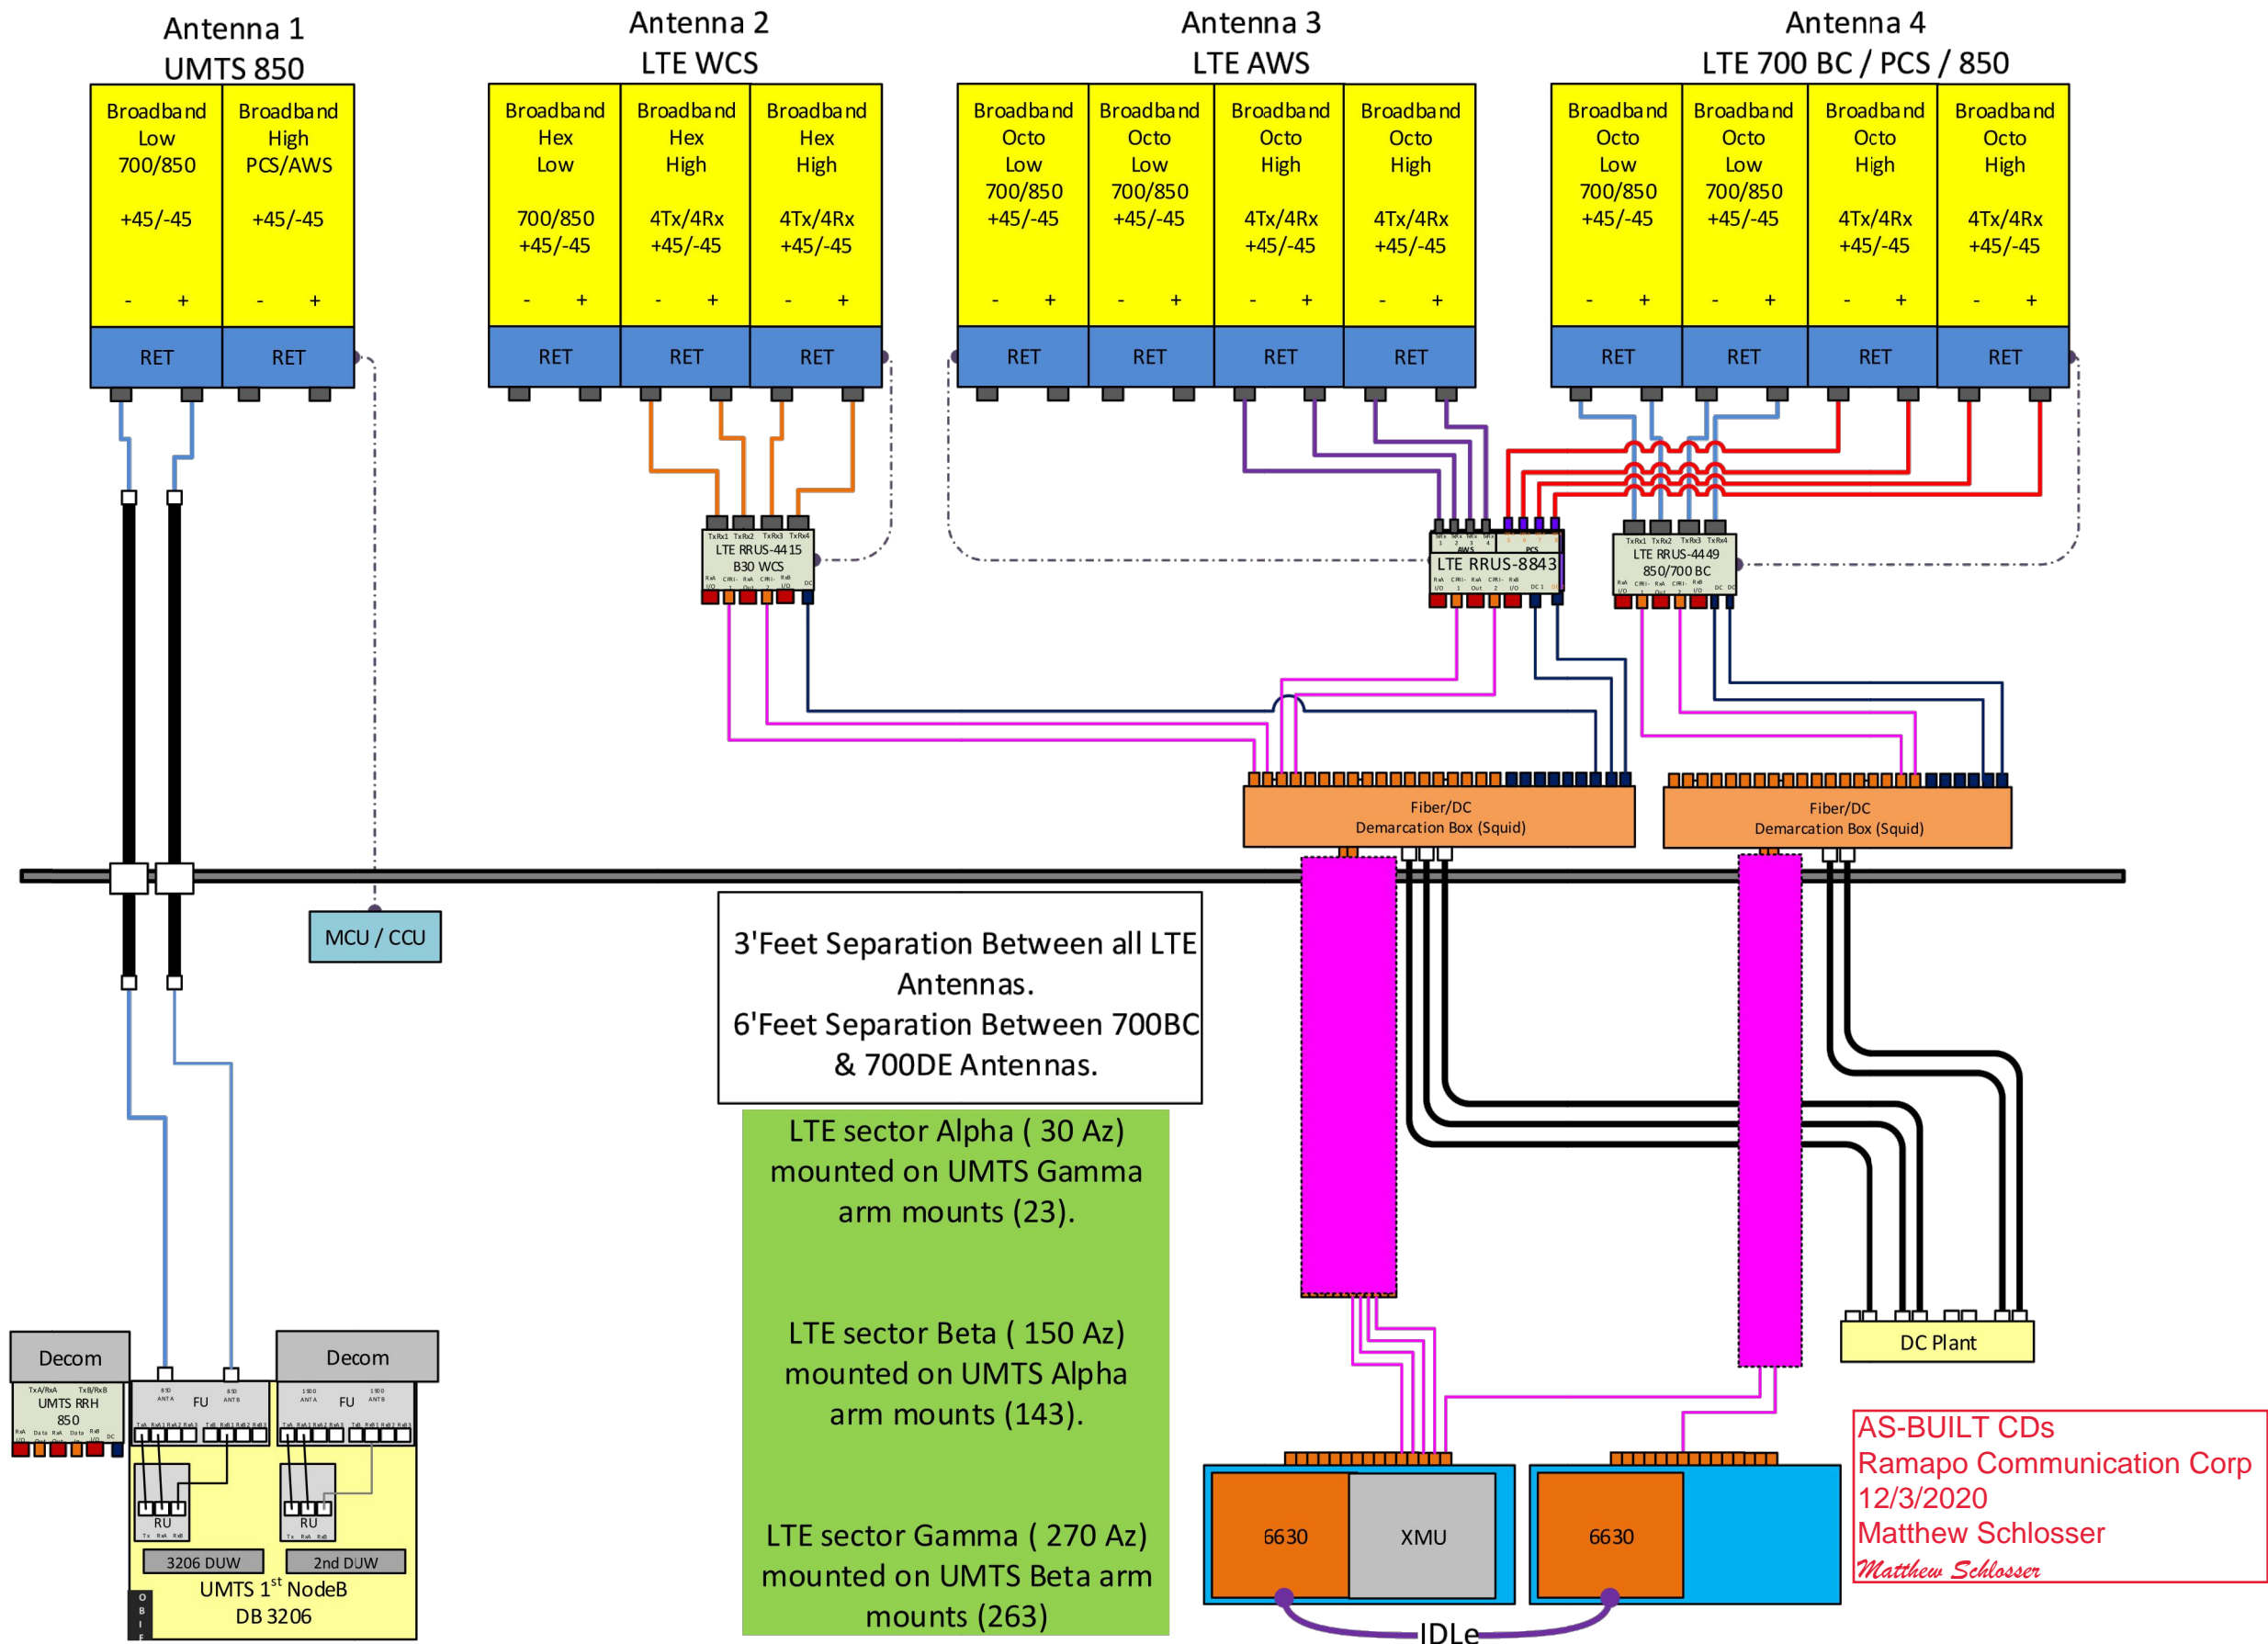

3' Feet Separation Between all LTE Antennas.
6' Feet Separation Between 700BC & 700DE Antennas.

- LTE sector Alpha (30 Az) mounted on UMTS Gamma arm mounts (23).
- LTE sector Beta (150 Az) mounted on UMTS Alpha arm mounts (143).
- LTE sector Gamma (270 Az) mounted on UMTS Beta arm mounts (263)

AS-BUILT CDs
Ramapo Communication Corp
12/3/2020
Matthew Schlosser
Matthew Schlosser

1 PLUMBING DIAGRAM
SCALE: NOT TO SCALE

NOTE: THIS SHEET CREATED BY OTHERS AND PROVIDED BY REQUEST OF CUSTOMER WITHOUT EDIT.

SUPPLEMENTAL	
SHEET NUMBER: R-602	REVISION: A

MOUNT REINFORCEMENT DRAWINGS PREPARED FOR AT&T ATC SITE NO. 411189

SITE NAME: MRCTB045060
SITE NUMBER: CTL02094
FA#: 10035342

SITE ADDRESS:
2 SUNNY LN, WESTPORT
FAIRFIELD COUNTY, CT 06880

PROJECT CONTACTS:

- PROJECT MANAGER
GEOFF MIDDLEBROOKS
919-466-5292
GEOFF.MIDDLEBROOKS@AMERICANTOWER.COM
- DESIGN ENGINEER - MAIN RFI CONTACT
NOAH NOXON
919-674-5889
NOAH.NOXON@MASTEC.COM
- ENGINEER OF RECORD
RAPHAEL I. MOHAMED, PE, PEng
919-674-5895
507 AIRPORT BLVD.
SUITE 111
MORRISVILLE, NC 27560
RAPHAEL.MOHAMED@MASTEC.COM
- FOR FABRICATION AND CONSTRUCTION
RELATED INQUIRIES: CONTACT MASTEC
DESIGN ENGINEER AND ENGINEER OF RECORD.

DRAWINGS INCLUDED

SHEET NO.	DESCRIPTION	SHEET NO.	DESCRIPTION
T-1	TITLE SHEET		
N-1	MODIFICATION INSPECTION CHECKLIST		
N-2	GENERAL NOTES		
S-1	MODIFICATION SCHEDULE		
S-2	PLATFORM REINFORCEMENT DETAILS		
A-1	MANUFACTURER SPECIFICATIONS I		

QUALIFIED ENGINEERING SERVICES ARE AVAILABLE FROM MASTEC NETWORK SOLUTIONS TO ASSIST CONTRACTORS IN CLASS IV RIGGING PLAN REVIEWS. FOR REQUESTED QUALIFIED ENGINEERING SERVICES, PLEASE CONTACT RAPHAEL MOHAMED AT (919) 244-5207.

TOWER INFORMATION

TOWER HEIGHT / TYPE: 130 FT MONOPOLE
MOUNT HEIGHT/TYPE: 100 FT 14.5FT PLATFORM W/ HANDRAILS

TOWER LOCATION: LAT: 41.1628°
LONG: -73.3735°



FAILING ANALYSIS FIRM NAME: MASTEC NETWORK SOLUTIONS
PROJECT NUMBER: 21944-MNT1
STRUCTURAL ANALYSIS DATE: 04/24/2020

PASSING ANALYSIS FIRM NAME: MASTEC NETWORK SOLUTIONS
PROJECT NUMBER: 21944-MOD1

CODE COMPLIANCE

ANSI/TIA-222-H
2018 INTERNATIONAL BUILDING CODE

AS-BUILT CDs
Ramapo Communication Corp
12/3/2020
Matthew Schlosser
Matthew Schlosser

 <small>507 AIRPORT BLVD., SUITE 111 MORRISVILLE, NC 27560</small>			
<small>THE INFORMATION CONTAINED IN THESE DOCUMENTS IS PROPRIETARY BY NATURE. REPRODUCTION OR CAUSING TO BE REPRODUCED THE WHOLE OR ANY PART OF THESE DRAWINGS WITHOUT THE PERMISSION OF MASTEC NETWORK SOLUTIONS IS PROHIBITED.</small>			
0	05/18/19	FIRST ISSUE	NDN
NO.	DATE	DESCRIPTION	BY
REVISIONS			
			SITE NAME: MRCTB045060 SITE NUMBER: CTL02094 FA NUMBER: 10035342 MNS ENG. NUMBER: 21944 - MOD1 SITE ADDRESS: 2 SUNNY LN, WESTPORT FAIRFIELD COUNTY, CT 06880
DRAWN BY: NDN CHECKED BY: CDG APPROVED BY: RIM			SCALE: N.T.S
RAPHAEL I. MOHAMED, PE, PEng SENIOR DIRECTOR OF ENGINEERING CT PE LICENSE NO. 25112			TITLE SHEET
I HEREBY CERTIFY THAT THIS ENGINEERING DOCUMENT WAS PREPARED BY ME OR UNDER MY DIRECT PERSONAL SUPERVISION AND THAT I AM A DULY LICENSED PROFESSIONAL ENGINEER UNDER THE LAWS OF THE STATE OF CONNECTICUT.			REV T-1 0

MI CHECKLIST	
CONSTRUCTION/INSTALLATION INSPECTIONS AND TESTING REQUIRED (COMPLETED BY EOR)	REPORT ITEM
PRE-CONSTRUCTION	
X	MI CHECKLIST DRAWING
N/A	EOR APPROVAL
N/A	FABRICATION INSPECTION
N/A	FABRICATOR CERTIFIED WELD INSPECTION
X	MATERIAL TEST REPORT (MTR)
N/A	FABRICATOR NDE INSPECTION
N/A	NDE REPORT OF BASE PLATE
X	PACKING SLIPS
ADDITIONAL TESTING AND INSPECTIONS:	
CONSTRUCTION	
X	CONSTRUCTION INSPECTIONS
N/A	CONTINUOUS FOUNDATION INSPECTIONS
N/A	CONCRETE COMP. STRENGTH AND SLUMP TESTS
N/A	GROUT COMP. STRENGTH (ASTM C109)
N/A	POST INSTALLED ANCHOR ROD VERIFICATION
N/A	BASE PLATE GROUT VERIFICATION
N/A	CONTRACTOR'S CERTIFIED WELD INSPECTION AND NDE REPORTS
N/A	EARTHWORK: LIFT AND DENSITY
X	ON SITE COLD GALVANIZING VERIFICATION
N/A	GUY WIRE TENSION REPORT
X	GC AS-BUILT DOCUMENTS
ADDITIONAL TESTING AND INSPECTIONS:	
POST-CONSTRUCTION	
X	MI INSPECTOR REDLINE OR RECORD DRAWING(S)
N/A	POST INSTALLED ANCHOR ROD PULL-OUT TESTING
X	PHOTOGRAPHS
ADDITIONAL TESTING AND INSPECTIONS:	

NOTE: X DENOTES A DOCUMENT NEEDED FOR THE PMI REPORT
N/A DENOTES A DOCUMENT THAT IS NOT REQUIRED FOR THE PMI REPORT

MODIFICATION INSPECTION NOTES:

GENERAL:

1. THE MODIFICATION INSPECTION (MI) IS A VISUAL INSPECTION OF THE TOWER MODIFICATIONS AND A REVIEW OF CONSTRUCTION INSPECTIONS AND OTHER REPORTS TO ENSURE THE INSTALLATION WAS CONSTRUCTED IN ACCORDANCE WITH THE CONTRACT DOCUMENTS, NAMELY THE MODIFICATION DRAWINGS, AS DESIGNED BY THE ENGINEER OF RECORD (EOR)
2. THE MI IS TO CONFIRM INSTALLATION CONFIGURATION AND WORKMANSHIP ONLY AND IS NOT A REVIEW OF THE MODIFICATION DESIGN ITSELF, NOR DOES THE MI INSPECTOR TAKE OWNERSHIP OF THE MODIFICATION DESIGN. OWNERSHIP OF THE STRUCTURAL MODIFICATION DESIGN EFFECTIVENESS AND INTEGRITY RESIDES WITH THE EOR AT ALL TIMES.
3. TO ENSURE THAT THE REQUIREMENTS OF THE MI ARE MET IT IS VITAL THAT THE GENERAL CONTRACTOR (GC) AND THE MI INSPECTOR BEGIN COMMUNICATING AND COORDINATING AS SOON AS A PO IS RECEIVED. IT IS EXPECTED THAT EACH PARTY WILL BE PROACTIVE IN REACHING OUT TO THE OTHER PARTY. IF CONTACT INFORMATION IS NOT KNOWN, CONTACT YOUR POINT OF CONTACT (POC).

MI INSPECTOR:

1. THE MI INSPECTOR IS REQUIRED TO CONTACT THE GC AS SOON AS RECEIVING A PO FOR THE MI TO, AT A MINIMUM
REVIEW THE REQUIREMENTS OF THE MI CHECKLIST WORK WITH THE GC TO DEVELOP A SCHEDULE TO CONDUCT ON-SITE INSPECTIONS, INCLUDING FOUNDATION INSPECTIONS.
2. THE MI IS RESPONSIBLE FOR COLLECTING ALL GENERAL CONTRACTORS (GC) INSPECTION AND TEST REPORTS, REVIEWING THE DOCUMENTS FOR ADHERENCE TO THE CONTRACT DOCUMENTS, CONDUCTING THE IN-FIELD INSPECTIONS. AND SUBMITTING THE MI REPORT.

GENERAL CONTRACTOR:

1. THE GC IS REQUIRED TO CONTACT THE MI INSPECTOR AS SOON AS RECEIVING A PO FOR THE MODIFICATION INSTALLATION OR TURNKEY PROJECT TO, AT A MINIMUM:
 - REVIEW THE REQUIREMENTS OF THE MI CHECKLIST.
 - WORK WITH THE MI INSPECTOR TO DEVELOP A SCHEDULE TO CONDUCT
 - ON-SITE MI INSPECTIONS, INCLUDING FOUNDATION INSPECTIONS.
 - BETTER UNDERSTAND ALL INSPECTION AND TESTING REQUIREMENTS.
2. THE GC SHALL PERFORM AND RECORD THE TEST AND INSPECTION RESULTS IN ACCORDANCE WITH THE REQUIREMENTS OF THE MI CHECKLIST.

MI VERIFICATION INSPECTIONS:

VERIFICATION INSPECTION MAY BE CONDUCTED BY AN INDEPENDENT FIRM AFTER A MODIFICATION PROJECT IS COMPLETED, AS MARKED BY THE OF AN ACCEPTED "PASSING MI" OR "PASS AS NOTED MI" REPORT FOR THE ORIGINAL PROJECT.

REQUIRED PHOTOS:

BETWEEN THE GC AND THE MI INSPECTOR THE FOLLOWING PHOTOGRAPHS, AT A MINIMUM, ARE TO BE TAKEN AND INCLUDED IN THE MI REPORT:

- PRE-CONSTRUCTION GENERAL SITE CONDITION
- PHOTOGRAPHS DURING THE REINFORCEMENT MODIFICATION CONSTRUCTION/ERECTIONS AND INSPECTION:
- RAW MATERIALS
- PHOTOS OF ALL CRITICAL DETAILS
- FOUNDATION MODIFICATIONS
- WELD PREPARATION
- BOLT INSTALLATION AND TORQUE
- FINAL INSTALLED CONDITION
- SURFACE COATING REPAIR
- POST CONSTRUCTION PHOTOGRAPHS
- FINAL IN FIELD CONDITIONS

PHOTOS OF ELEVATED MODIFICATION TAKEN FROM THE GROUND SHALL BE CONSIDERED INADEQUATE.

CORRECTION OF FAILING MI'S:

IF THE MODIFICATION INSTALLATION WOULD FAIL THE MI ("FAILED MI"), THE GC SHALL WORK WITH THE TOWER OWNER TO COORDINATE A REMEDIATION PLAN IN ONE OF TWO WAYS:

- CORRECT FAILING ISSUES TO COMPLY WITH THE SPECIFICATIONS CONTAINED IN THE ORIGINAL CONTRACT DOCUMENTS AND COORDINATE A SUPPLEMENT MI.
- OR, THE GC MAY WORK WITH THE EOR TO RE-ANALYZE THE MODIFICATION/ENFORCEMENT USING THE AS-BUILT CONDITION.

RECOMMENDATIONS:



THE FOLLOWING RECOMMENDATIONS AND SUGGESTIONS ARE OFFERED TO ENHANCE THE EFFICIENCY AND EFFECTIVENESS OF DELIVERING A MI REPORT:

- IT IS SUGGESTED THAT THE GC PROVIDE A MINIMUM OF 5 BUSINESS DAYS NOTICE, PREFERABLY 10, TO THE MI INSPECTOR AS TO WHEN THE SITE WILL BE READY FOR THE MI TO BE CONDUCTED.
- THE GC AND MI INSPECTOR COORDINATE CLOSELY THROUGHOUT THE ENTIRE PROJECT.
- WHEN POSSIBLE IT IS PREFERRED TO HAVE THE GC AND MI INSPECTOR ON-SITE SIMULTANEOUSLY FOR ANY GUY WIRE TENSIONING OR RE-TENSIONING OPERATIONS.
- IT MAY BE BENEFICIAL TO INSTALL ALL TOWER MODIFICATIONS PRIOR TO CONDUCTING THE FOUNDATION INSPECTIONS TO ALLOW FOUNDATION AND MI INSPECTION(S) TO COMMENCE WITH ONE SITE VISIT.
- WHEN POSSIBLE, IT IS PREFERRED TO HAVE THE GC AND MI INSPECTOR ON-SITE DURING THE MI TO HAVE ANY DEFICIENCIES CORRECTED DURING THE INITIAL MI, THEREFORE, THE GC MAY CHOOSE TO COORDINATE THE MI CAREFULLY TO ENSURE ALL CONSTRUCTION FACILITIES ARE AT THEIR DISPOSAL WHEN THE MI INSPECTOR IS ON SITE.

CANCELLATION OR DELAYS IN SCHEDULED MI:

IF THE GC AND MI INSPECTOR AGREE TO A DATE ON WHICH THE MI WILL BE CONDUCTED, AND EITHER PARTY CANCELS OR DELAYS, TOWER OWNER SHALL NOT BE RESPONSIBLE FOR ANY COSTS, FEES, LOSS OF DEPOSITS AND/OR OTHER PENALTIES RELATED TO THE CANCELLATION OR DELAY INCURRED BY EITHER PARTY FOR ANY TIME (E.G. TRAVEL AND LODGING, COSTS OF KEEPING EQUIPMENT ON-SITE, ETC.). IF TOWER OWNER CONTRACTS DIRECTLY FOR A THIRD PARTY MI, EXCEPTIONS MAY BE MADE IN THE EVENT THAT THE DELAY/CANCELLATION IS CAUSED BY WEATHER OR OTHER CONDITIONS THAT MAY COMPROMISE THE SAFETY OF THE PARTIES INVOLVED.

AS-BUILT CDs
Ramapo Communication Corp
12/3/2020
Matthew Schlosser
Matthew Schlosser

 <p>507 AIRPORT BLVD., SUITE 111 MORRISVILLE, NC 27560</p>			
<p>THE INFORMATION CONTAINED IN THESE DOCUMENTS IS PROPRIETARY BY NATURE. REPRODUCTION OR CAUSING TO BE REPRODUCED THE WHOLE OR ANY PART OF THESE DRAWINGS WITHOUT THE PERMISSION OF MASTEC NETWORK SOLUTIONS IS PROHIBITED.</p>			
0	05/18/19	FIRST ISSUE	NDN
NO.	DATE	DESCRIPTION	BY
REVISIONS			
			SITE NAME: MRCTB045060 SITE NUMBER: CTL02094 FA NUMBER: 10035342 MNS ENG. NUMBER: 21944 - MOD1
			SITE ADDRESS: 2 SUNNY LN, WESTPORT FAIRFIELD COUNTY, CT 06880
DRAWN BY: NDN			
CHECKED BY: CDG			
APPROVED BY: RIM			
SCALE: N.T.S			
RAPHAEL I. MOHAMED, PE,PEng SENIOR DIRECTOR OF ENGINEERING CT PE LICENSE NO. 25112			
I HEREBY CERTIFY THAT THIS ENGINEERING DOCUMENT WAS PREPARED BY ME OR UNDER MY DIRECT PERSONAL SUPERVISION AND THAT I AM A DULY LICENSED PROFESSIONAL ENGINEER UNDER THE LAWS OF THE STATE OF CONNECTICUT.			
MODIFICATION INSPECTION CHECKLIST		REV	
		N-1	0

GENERAL NOTES:

- ALL WORK PRESENTED IN THESE DRAWINGS MUST BE COMPLETED BY THE CONTRACTOR UNLESS OTHERWISE SPECIFIED.
- THE CONTRACTOR MUST HAVE A MINIMUM OF 5 YEARS OF EXPERIENCE IN TOWER ERECTION AND RETROFIT SIMILAR TO THAT DESCRIBED HEREIN.
- ALL CONSTRUCTION IS TO BE COMPLETE IN ACCORDANCE WITH THE ANSI/ASSE A10.48 AND ANSI/TIA-322 STANDARDS. THE CONTRACTOR MUST HAVE CONSIDERABLE WORKING KNOWLEDGE IN THESE STANDARDS TO ACCEPT THIS WORK. BY ACCEPTING THIS PROJECT, THE CONTRACTOR IS ATTESTING THAT HE HAS SUFFICIENT EXPERIENCE, ABILITY, AND KNOWLEDGE OF THE WORK TO BE PERFORMED AND IS PROPERLY LICENSED AND REGISTERED TO COMPLETE THIS WORK.
- THE CONTRACTOR SHALL BE RESPONSIBLE FOR VERIFYING ALL DIMENSIONS, ELEVATIONS, AND EXISTING CONDITIONS PRIOR TO BEGINNING ANY MATERIAL ORDERS, FABRICATION OR CONSTRUCTION WORK ON THIS PROJECT. ANY DISCREPANCIES SHALL BE IMMEDIATELY BROUGHT TO THE ATTENTION OF THE EOR. THE DISCREPANCIES MUST BE RESOLVED BEFORE THE CONTRACTOR MAY PROCEED WITH THE PROJECT.
- ANY WORK PERFORMED WITHOUT A PREFABRICATION MAPPING IS DONE AT THE RISK OF THE CONTRACTOR AND/OR FABRICATOR.
- ALL MANUFACTURERS' INSTRUCTIONS FOR INSTALLATION MUST BE FOLLOWED EXACTLY AS SPECIFIED. WHEN CONFLICTING WITH THESE DRAWINGS, THE MANUFACTURER SPECIFICATIONS SHALL GOVERN.
- ALL MATERIALS AND EQUIPMENT USED IN THE INSTALLATION OF THESE DRAWINGS SHALL BE IN NEW OR GOOD WORKING QUALITY, FREE FROM DEFECTS AND FAULTS AND IN CONFORMANCE WITH THE CONTRACT DOCUMENTS. ALL SUBSTITUTIONS MUST BE GIVEN WRITTEN APPROVAL FROM THE EOR PRIOR TO INSTALLATION. ALL MATERIALS SHALL BE WARRANTED FOR ONE YEAR FROM ACCEPTANCE DATE.
- THE CONTRACTOR IS RESPONSIBLE FOR COORDINATING ALL INTENDED CONSTRUCTION ACTIVITY INCLUDING MATERIALS, ACCESS AND WORK SCHEDULE. THE CONTRACTOR IS RESPONSIBLE FOR OBTAINING ALL PERMITS AND WILL BE RESPONSIBLE FOR ABIDING BY ALL REQUIREMENTS AND CONDITIONS OF THE PERMITS. WHEN APPLICABLE, THE CONTRACTOR MUST NOTIFY THE APPLICABLE JURISDICTION PRIOR TO BEGINNING OF ANY CONSTRUCTION.
- THE CONTRACTOR IS RESPONSIBLE FOR ALL CONSTRUCTION MEANS AND METHODS. INCLUDING BUT NOT LIMITED TO, ERECTION PLANS, RIGGING PLANS, CLIMBING PLANS, AND RESCUE PLANS. CONSTRUCTION OF THE PROPOSED WORK SHALL MEET ANSI/ASSE A10.48, OSHA, AND GENERAL INDUSTRY STANDARDS. ALL RIGGING PLANS SHALL ADHERE TO ANSI/TIA-322 INCLUDING THE REQUIRED INVOLVEMENT OF A QUALIFIED ENGINEER FOR CLASS IV CONSTRUCTION.

- IT IS THE CONTRACTOR'S SOLE RESPONSIBILITY TO DETERMINE INSTALLATION PROCEDURE AND SEQUENCE TO INSURE THE SAFETY OF THE STRUCTURE AND ITS COMPONENTS DURING ERECTION AND/OR FIELD ALTERATIONS. THIS INCLUDES, BUT IS NOT LIMITED TO, THE ADDITION OF TEMPORARY BRACING, GUYS OR TIE-DOWNS THAT MAY BE NECESSARY; SUCH MATERIAL SHALL BE REMOVED AFTER THE COMPLETION OF THE PROJECT.
- THE CONTRACTOR SHALL BE RESPONSIBLE FOR INITIATING, MAINTAINING, AND SUPERVISING ALL SAFETY PRECAUTIONS AND PROGRAMS IN CONNECTION WITH THIS PROJECT. THE CONTRACTOR IS RESPONSIBLE FOR ENSURING THAT THIS PROJECT AND RELATED WORK COMPLIES WITH ALL APPLICABLE LOCAL, STATE, AND FEDERAL SAFETY CODES AND REGULATIONS GOVERNING THIS WORK.
- THE CLIMBING FACILITIES, SAFETY CLIMB AND ALL PARTS THEREOF SHALL NOT BE IMPEDED, MODIFIED OR ALTERED WITHOUT THE EXPRESS WRITTEN APPROVAL OF THE EOR.
- INCORRECTLY FABRICATED, DAMAGED, MIS-FITTING, OR NON-CONFORMING MATERIALS AND CONDITIONS SHALL BE REPORTED TO THE EOR PRIOR TO ANY REMEDIAL OR CORRECTING ACTION. ALL ACTIONS SHALL REQUIRE EOR APPROVAL.

STEEL:

- THE FABRICATION AND ERECTION OF STRUCTURAL STEEL SHALL CONFORM TO THE LATEST AISC CODE AND ASTM SPECIFICATIONS.
- HOLES SHALL NOT BE TORCH CUT THROUGH STRUCTURAL STEEL FOR FABRICATION. ALL STEEL FABRICATION MUST FOLLOW AISC SPECIFICATIONS.
- HOT-DIP GALVANIZE ALL ITEMS AFTER FABRICATION IN COMPLIANCE WITH ASTM A-123 UNLESS OTHERWISE SPECIFIED. ALL NEW STEEL IS TO BE PAINTED TO MATCH THE EXISTING STEEL.
- NEW STEEL MEMBERS MUST HAVE SINGLE DRILLED HOLES. SLOTTED AND DOUBLY DRILLED HOLES ARE NOT ACCEPTABLE MEANS OF FABRICATION UNLESS OTHERWISE SPECIFIED.
- ALL CONNECTIONS NOT DETAILED IN THESE DRAWINGS MUST BE DETAILED BY THE STEEL FABRICATOR IN ACCORDANCE WITH THE LATEST AISC SPECIFICATIONS.
- ALL BOLTED CONNECTIONS MUST BE INSTALLED TO A SNUG-TIGHTENED CONDITION PER AISC "SPECIFICATION FOR STRUCTURAL JOINTS USING ASTM 325 OR A490 BOLTS" SECTION 8.1 UNLESS OTHERWISE SPECIFIED.
- CONTRACTOR MAY BE REQUIRED TO STACK WASHERS FOR BOLTS WHERE THREADS ARE EXCLUDED FROM SHEAR PLANE TO OBTAIN SNUG TIGHT INSTALLATION. A NUT LOCKING DEVICE MUST BE INSTALLED ON ALL PROPOSED AND/OR REPLACED BOLTS. GALVANIZED ASTM 325 OR A490 BOLTS SHALL NOT BE REUSED.

COLD GALVANIZATION:

- ALL DAMAGED SURFACES SHALL BE REPAIRED WITH A COLD-GALVANIZING COATING CONFORMING TO ASTM 780. THIS COATING SHALL BE APPLIED BY BRUSH. THE GALVANIZING COMPOUND SHALL CONTAIN A MINIMUM OF 95% ± PURE ZINC. THE FINISHED COATING SHALL BE A MINIMUM THICKNESS OF 4 MILS.
- CONTRACTOR TO USE ZINGA OR ZRC COLD GALVANIZATION COMPOUNDS OR APPROVED EQUIVALENTS.
- CLEAN AREAS TO BE PREPARED AND REMOVE SLAG FROM WELDS FOR TREATMENT ACCORDING TO MANUFACTURER'S RECOMMENDATIONS.
- IF THE TOWER IS PAINTED, ALL TREATED AREAS ARE TO BE BRUSH PAINTED TO MATCH THE TOWER AFTER COLD GALVANIZING COMPOUND IS ALLOWED TO CURE.

U-BOLTS:

- ALL U-BOLTS ARE TO BE ASTM A36/A307, SAE 429 GR. 2 UNLESS OTHERWISE SPECIFIED.
- U-BOLTS SHALL MEET REQUIREMENTS OF ASME B18.31.5-2011 BENT BOLTS.
- U-BOLT ASSEMBLY SHALL COME COMPLETE WITH NUTS (ASTM A563), WASHERS (ASTM F436), AND LOCK WASHERS.
- FULL U-BOLT ASSEMBLY TO BE HOT-DIP GALVANIZED PER ASTM A153/A153M OR A123, AS APPLICABLE.


AS-BUILT CDs
Ramapo Communication Corp
12/3/2020
Matthew Schlosser
Matthew Schlosser

MODIFICATION MATERIALS				
SCOPE	SHAPE	GRADE	YIELD STRENGTH (Fy)	ULTIMATE STRENGTH (Fu)
ALL	PIPE	A53 GR. B	35 KSI	60 KSI
ALL	ANGLE	A36	36 KSI	58 KSI

 <p>507 AIRPORT BLVD., SUITE 111 MORRISVILLE, NC 27560</p>						
<p>THE INFORMATION CONTAINED IN THESE DOCUMENTS IS PROPRIETARY BY NATURE. REPRODUCTION OR CAUSING TO BE REPRODUCED THE WHOLE OR ANY PART OF THESE DRAWINGS WITHOUT THE PERMISSION OF MASTEC NETWORK SOLUTIONS IS PROHIBITED.</p>						
0	05/18/19	FIRST ISSUE	NDN			
NO.	DATE	DESCRIPTION	BY			
REVISIONS						
			SITE NAME: MRCTB045060 SITE NUMBER: CTL02094 FA NUMBER: 10035342 MNS ENG. NUMBER: 21944 - MOD1 SITE ADDRESS: 2 SUNNY LN, WESTPORT FAIRFIELD COUNTY, CT 06880			
			DRAWN BY: NDN CHECKED BY: CDG APPROVED BY: RIM SCALE: N.T.S			
RAPHAEL I. MOHAMED, PE,PEng SENIOR DIRECTOR OF ENGINEERING CT PE LICENSE NO. 25112			NOTES			
I HEREBY CERTIFY THAT THIS ENGINEERING DOCUMENT WAS PREPARED BY ME OR UNDER MY DIRECT PERSONAL SUPERVISION AND THAT I AM A DULY LICENSED PROFESSIONAL ENGINEER UNDER THE LAWS OF THE STATE OF CONNECTICUT.			<table border="1"> <tr> <td rowspan="2" style="font-size: 2em;">N-2</td> <td>REV</td> </tr> <tr> <td style="text-align: center;">0</td> </tr> </table>	N-2	REV	0
N-2	REV					
	0					

MODIFICATION SCHEDULE

SCOPE NO.	MODIFICATION DESCRIPTION	BOTTOM ELEVATION	TOP ELEVATION	SHEET NO.
1	INSTALLATION OF NEW PRK-1245 KICKER KIT	-	100'-0" ±	S-2

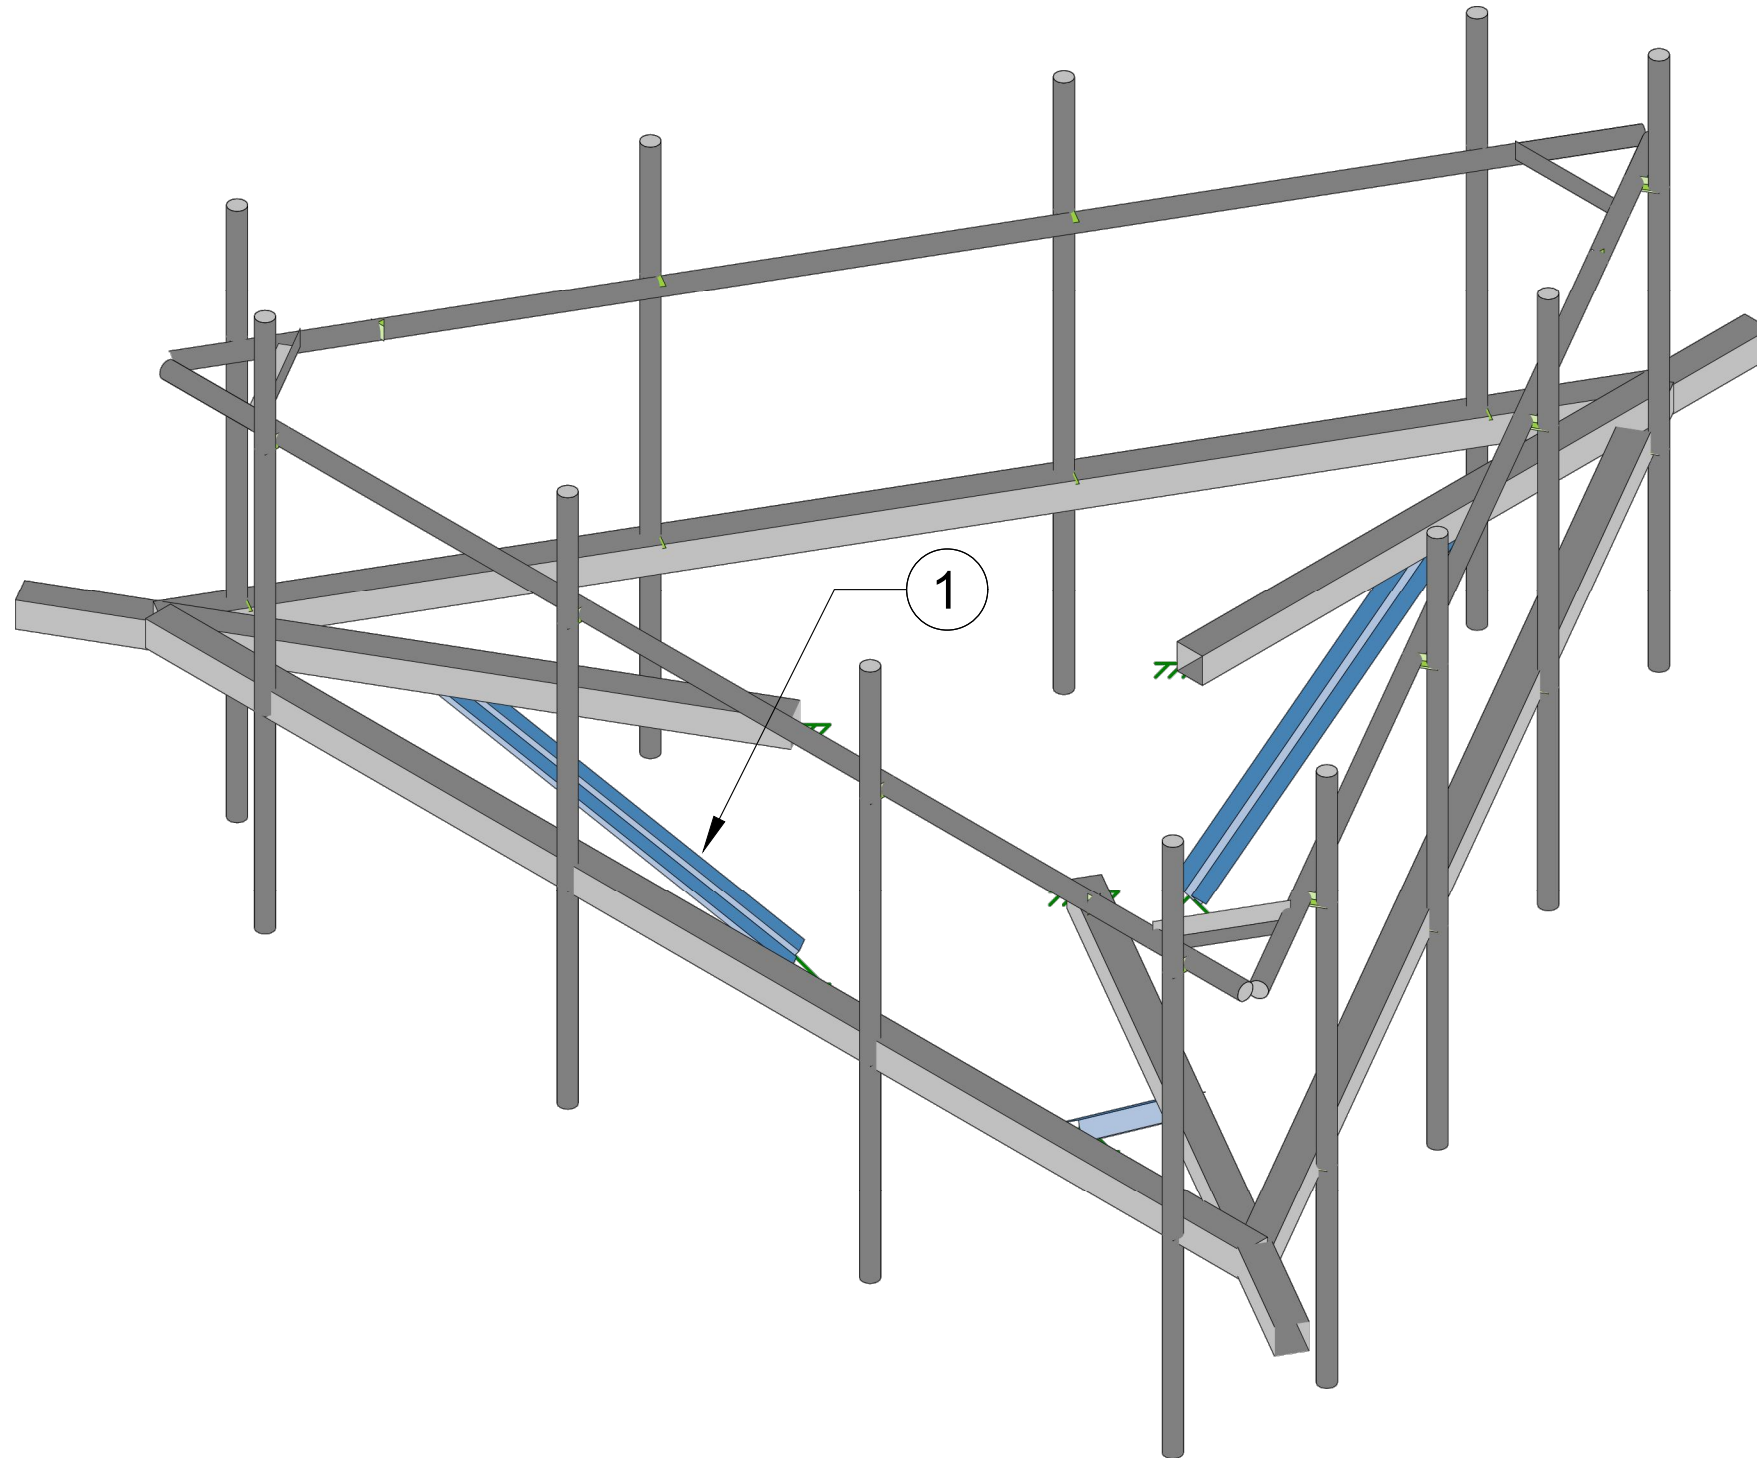

NOTES:

1. APPURTENANCES MAY INTERFERE WITH PROPOSED MODIFICATIONS.
2. ALL MODIFICATIONS TO BE INSTALLED CONTINUOUSLY THROUGH EXISTING EQUIPMENT. ALL EXISTING EQUIPMENT MUST NOT BE DAMAGED OR TAKEN OFF AIR DURING INSTALLATION OF PROPOSED MODIFICATIONS.
3. ANTENNA AND COAX NOT SHOWN FOR CLARITY. SEE STRUCTURAL ANALYSIS REPORT FOR EXISTING ANTENNA LOADING AND COAX CONFIGURATION.
4. PRIOR TO FABRICATION AND INSTALLATION , CONTRACTOR SHALL FIELD VERIFY ALL LENGTHS AND QUANTITIES GIVEN. INFORMATION PROVIDED IS FOR QUOTING PURPOSES ONLY, AND SHALL NOT BE USED FOR FABRICATION.
5. EXISTING RRU'S AND ANCILLARY EQUIPMENT MAY NEED TO BE TEMPORARILY RELOCATED AS NECESSARY TO COMPLETE THIS MODIFICATION. EQUIPMENT IS NOT TO BE TAKEN OFF AIR AT ANY TIME DURING INSTALLATION. PLEASE CONTACT EOR IF THIS CANNOT BE MET.
6. CONTACT EOR IF PROPOSED MOUNT REINFORCEMENT DIMENSIONS CANNOT BE MET.

AS-BUILT CDs
 Ramapo Communication Corp
 12/3/2020
 Matthew Schlosser
Matthew Schlosser


<p style="font-size: small; margin: 0;">507 AIRPORT BLVD., SUITE 111 MORRISVILLE, NC 27560</p>			
THE INFORMATION CONTAINED IN THESE DOCUMENTS IS PROPRIETARY BY NATURE. REPRODUCTION OR CAUSING TO BE REPRODUCED THE WHOLE OR ANY PART OF THESE DRAWINGS WITHOUT THE PERMISSION OF MASTEC NETWORK SOLUTIONS IS PROHIBITED.			
0	05/18/19	FIRST ISSUE	NDN
NO.	DATE	DESCRIPTION	BY
REVISIONS			
		SITE NAME: MRCTB045060 SITE NUMBER: CTL02094 FA NUMBER: 10035342 MNS ENG. NUMBER: 21944 - MOD1 SITE ADDRESS: 2 SUNNY LN, WESTPORT FAIRFIELD COUNTY, CT 06880	
RAPHAEL I. MOHAMED, PE,PEng SENIOR DIRECTOR OF ENGINEERING CT PE LICENSE NO. 25112		DRAWN BY: NDN CHECKED BY: CDG APPROVED BY: RIM SCALE: N.T.S	
I HEREBY CERTIFY THAT THIS ENGINEERING DOCUMENT WAS PREPARED BY ME OR UNDER MY DIRECT PERSONAL SUPERVISION AND THAT I AM A DULY LICENSED PROFESSIONAL ENGINEER UNDER THE LAWS OF THE STATE OF CONNECTICUT.		MODIFICATION SCHEDULE	
S-1			REV 0

NOTES:

1. CONTRACTOR TO FIELD VERIFY THE REQUIRED LENGTH OF THE NEW STIFF-ARM PIPES AND MAY CUT ENDS AS REQUIRED TO AVOID UNNECESSARY OVERHANG AND OVERLAP.
2. TWO COATS OF COLD GALVANIZING COATING MUST BE APPLIED TO ALL CUT ENDS IN ACCORDANCE TO ASTM A780 PRIOR TO INSTALLATION.

NEW PLATFORM REINFORCEMENT STABILIZER KIT MATERIAL LIST


PART NO.	QTY.	LENGTH	DESCRIPTION
SITE PRO1 PRK-1245	1	4'-4.75"	PLATFORM REINFORCEMENT KICKER KIT

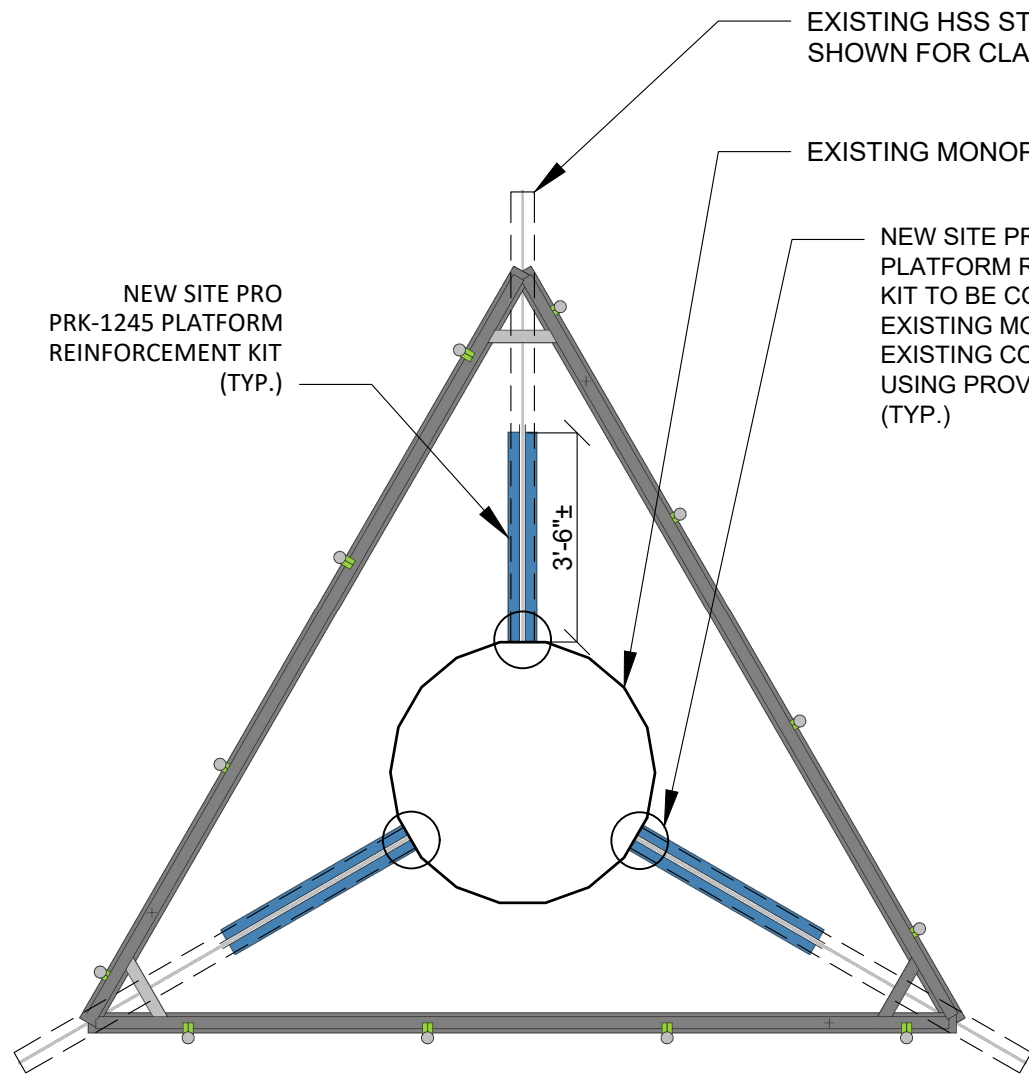

2
S-2

1
S-2

PRK 1245 KICKER KIT INSTALLATION
PLAN VIEW
NTS

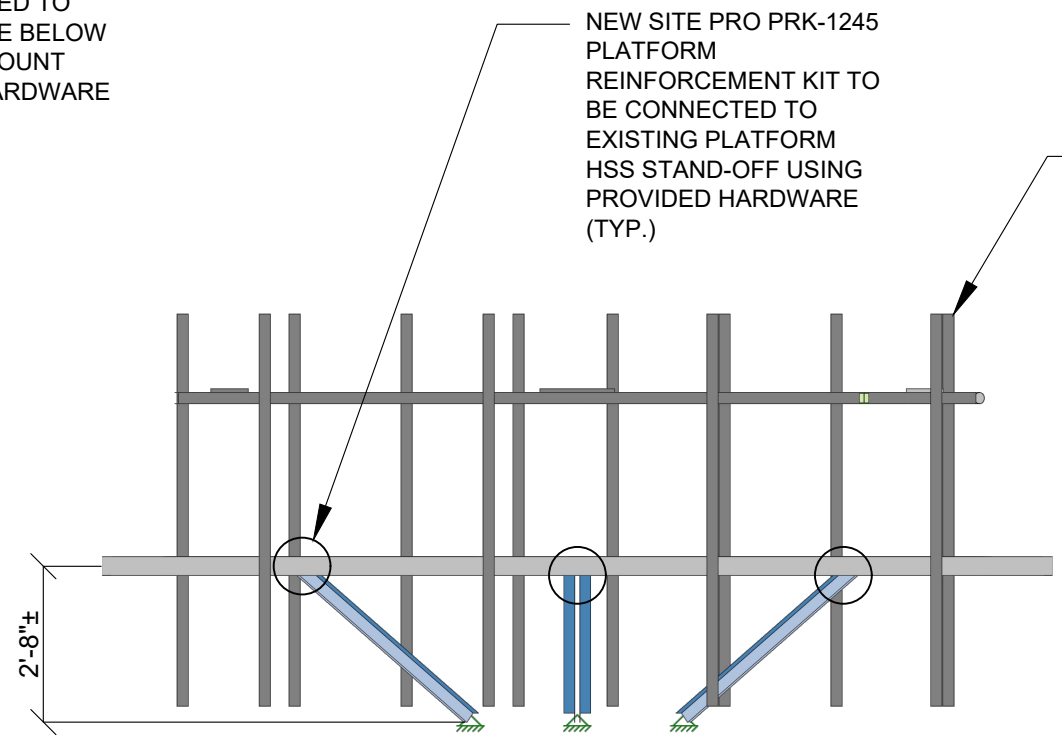

2
S-2

PRK 1245 KICKER KIT INSTALLATION
SIDE VIEW
NTS

AS-BUILT CDs
 Ramapo Communication Corp
 12/3/2020
 Matthew Schlosser
Matthew Schlosser

NO.	DATE	DESCRIPTION	BY
0	05/18/19	FIRST ISSUE	NDN

RAPHAEL I. MOHAMED, PE, PEng
 SENIOR DIRECTOR OF ENGINEERING
 CT PE LICENSE NO. 25112

I HEREBY CERTIFY THAT THIS ENGINEERING DOCUMENT WAS PREPARED BY ME OR UNDER MY DIRECT PERSONAL SUPERVISION AND THAT I AM A DULY LICENSED PROFESSIONAL ENGINEER UNDER THE LAWS OF THE STATE OF CONNECTICUT.

MasTec
 Network Solutions
 507 AIRPORT BLVD., SUITE 111
 MORRISVILLE, NC 27560

THE INFORMATION CONTAINED IN THESE DOCUMENTS IS PROPRIETARY BY NATURE. REPRODUCTION OR CAUSING TO BE REPRODUCED THE WHOLE OR ANY PART OF THESE DRAWINGS WITHOUT THE PERMISSION OF MASTEC NETWORK SOLUTIONS IS PROHIBITED.

SITE NAME: MRCTB045060
 SITE NUMBER: CTL02094
 FA NUMBER: 10035342
 MNS ENG. NUMBER: 21944 - MOD1
 SITE ADDRESS:
 2 SUNNY LN, WESTPORT
 FAIRFIELD COUNTY, CT 06880


DRAWN BY: NDN
 CHECKED BY: CDG
 APPROVED BY: RIM

SCALE: N.T.S.
 PLATFORM REINFORCEMENT
 DETAILS

S-2	REV
	0

AS-BUILT CDs
 Ramapo Communication Corp
 12/3/2020
 Matthew Schlosser
 Matthew Schlosser

PARTS LIST						
ITEM	QTY	PART NO.	PART DESCRIPTION	LENGTH	UNIT WT.	NET WT.
1	3	X-LWRM	RING MOUNT WELDMNT		68.81	206.42
2	36	G58LW	5/8" HDG LOCKWASHER		0.03	0.94
3	36	G58NUT	5/8" HDG HEAVY 2H HEX NUT		0.13	4.68
4	9	G58R-24	5/8" x 24" THREADED ROD (HDG.)	24 in	0.40	3.59
4	9	G58R-48	5/8" x 48" THREADED ROD (HDG.)	48 in	0.40	3.59
5	18	A582114	5/8" x 2-1/4" HDG A325 HEX BOLT	2 1/4 in	0.31	5.62
6	24	G12FW	1/2" HDG USS FLATWASHER	3/32 in	0.03	0.82
7	12	G12LW	1/2" HDG LOCKWASHER	1/8 in	0.01	0.17
8	12	G12NUT	1/2" HDG HEAVY 2H HEX NUT		0.07	0.86
9	3	SCX4	CROSSOVER PLATE	8 1/2 in	6.02	18.06
10	6	X-253993	PLATFORM REINFORCEMENT KIT ANGLE	52 25/32 in	14.33	85.99
11	6	X-253992	T-BRACKET FOR REINFORCEMENT KIT		13.55	81.27
12	12	G12065	1/2" x 6-1/2" HDG HEX BOLT GR5 FULL THREAD	6 1/2 in	0.41	4.91
TOTAL WT. #						466.20

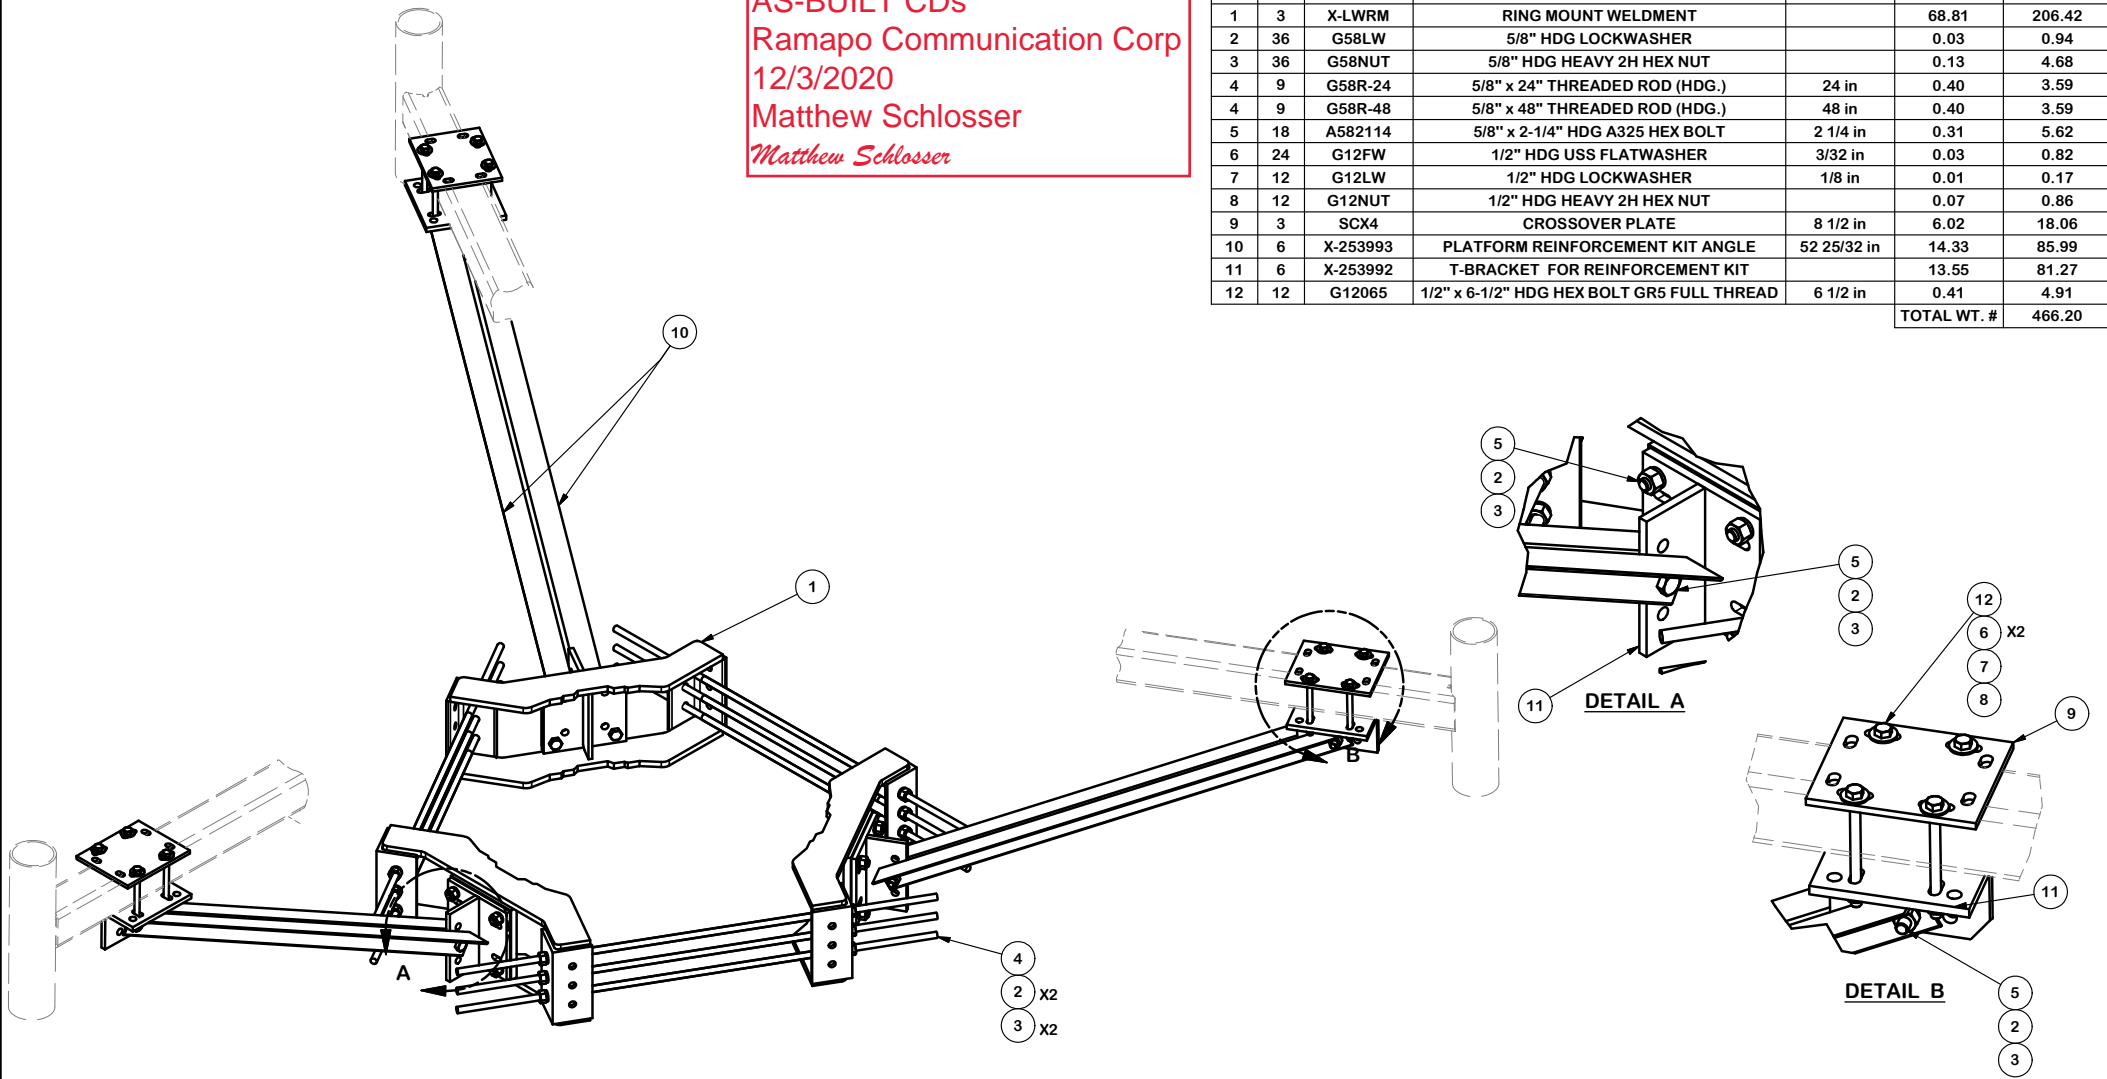

REV	DESCRIPTION OF REVISIONS	CPD	CEK	DATE
A	CHANGED ALL 5/8" BOLTS TO A582114	4488	CEK	10/1/2015
REVISION HISTORY				




TOLERANCE NOTES
 TOLERANCES ON DIMENSIONS, UNLESS OTHERWISE NOTED ARE:
 SAWED, SHEARED AND GAS CUT EDGES ($\pm 0.030"$)
 DRILLED AND GAS CUT HOLES ($\pm 0.030"$) - NO CONING OF HOLES
 LASER CUT EDGES AND HOLES ($\pm 0.010"$) - NO CONING OF HOLES
 BENDS ARE $\pm 1/2$ DEGREE
 ALL OTHER MACHINING ($\pm 0.030"$)
 ALL OTHER ASSEMBLY ($\pm 0.060"$)

PROPRIETARY NOTE:
 THE DATA AND TECHNIQUES CONTAINED IN THIS DRAWING ARE PROPRIETARY INFORMATION OF VALMONT INDUSTRIES AND CONSIDERED A TRADE SECRET. ANY USE OR DISCLOSURE WITHOUT THE CONSENT OF VALMONT INDUSTRIES IS STRICTLY PROHIBITED.


DESCRIPTION		DRAWN BY		ENG. APPROVAL	
PLATFORM REINFORCEMENT ON A 12" TO 45" POLE 4' 6" ANGLE		CEK 4/11/2014			
CPD NO.	4488	DRAWING USAGE	CUSTOMER	CHECKED BY	BMC 1/18/2016
CLASS	81	SUB	01		

 A valmont COMPANY	Engineering Support Team: 1-888-753-7446	Locations: New York, NY Atlanta, GA Los Angeles, CA Plymouth, IN Salem, OR Dallas, TX
	PART NO. PRK-1245	DWG. NO. PRK-1245

AS-BUILT CDs
 Ramapo Communication Corp
 12/3/2020
 Matthew Schlosser
Matthew Schlosser

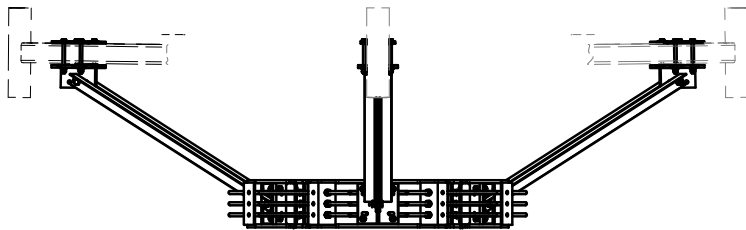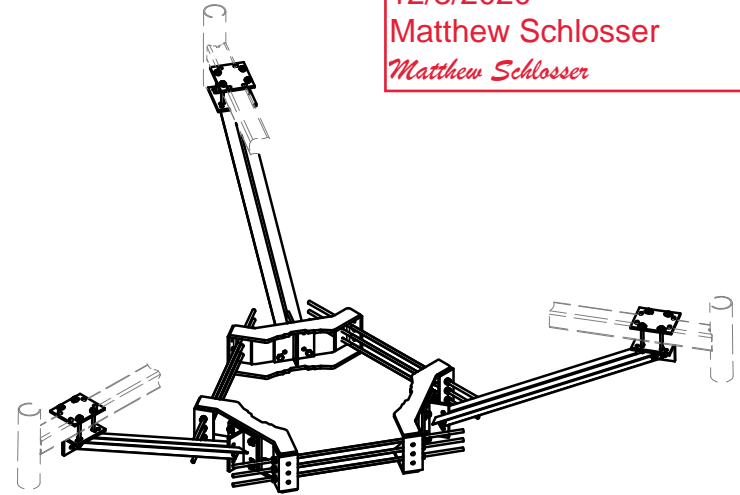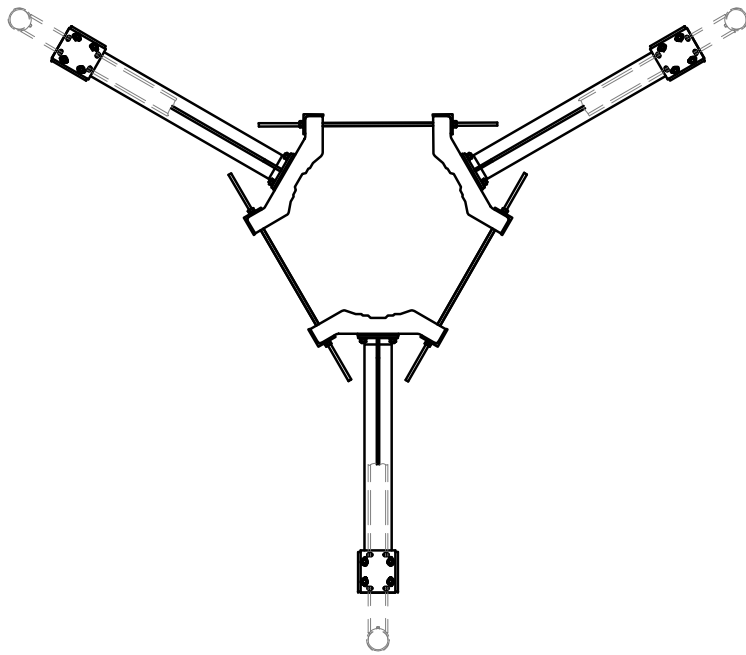

FITS UP TO 4" ROUND
 OR SQUARE TUBES

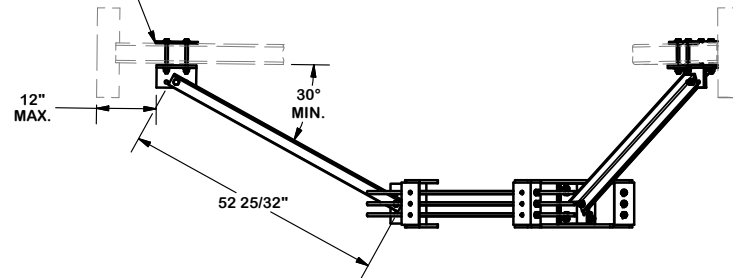

TOLERANCE NOTES

TOLERANCES ON DIMENSIONS, UNLESS OTHERWISE NOTED ARE:
 SAWED, SHEARED AND GAS CUT EDGES ($\pm 0.030"$)
 DRILLED AND GAS CUT HOLES ($\pm 0.030"$) - NO CONING OF HOLES
 LASER CUT EDGES AND HOLES ($\pm 0.010"$) - NO CONING OF HOLES
 BENDS ARE $\pm 1/2$ DEGREE
 ALL OTHER MACHINING ($\pm 0.030"$)
 ALL OTHER ASSEMBLY ($\pm 0.060"$)

PROPRIETARY NOTE:
 THE DATA AND TECHNIQUES CONTAINED IN THIS DRAWING ARE PROPRIETARY INFORMATION OF VALMONT
 INDUSTRIES AND CONSIDERED A TRADE SECRET. ANY USE OR DISCLOSURE WITHOUT THE CONSENT OF
 VALMONT INDUSTRIES IS STRICTLY PROHIBITED.

DESCRIPTION

PLATFORM REINFORCEMENT
 ON A 12" TO 45" POLE
 4' 6" ANGLE



A valmont COMPANY

Engineering
 Support Team:
 1-888-753-7446

Locations:
 New York, NY
 Atlanta, GA
 Los Angeles, CA
 Plymouth, IN
 Salem, OR
 Dallas, TX

CPD NO.
 4488

DRAWN BY
 CEK 4/11/2014

ENG. APPROVAL

PART NO.

PRK-1245

CLASS SUB
 81 01

DRAWING USAGE
 CUSTOMER

CHECKED BY
 BMC 1/18/2016

DWG. NO.

PRK-1245

REV	DESCRIPTION OF REVISIONS	CPD	BY	DATE
A	CHANGED ALL 5/8" BOLTS TO A582114	4488	CEK	10/1/2015
REVISION HISTORY				