

From: John Prinssen <john.prinssen@doosan.com>

Sent: Monday, May 20, 2024 2:06 PM

To: LaFountain, Dakota <Dakota.LaFountain@ct.gov>; Fontaine, Lisa <Lisa.Fontaine@ct.gov>; Mathews, Lisa A <Lisa.A.Mathews@ct.gov>

Cc: Walter Bonola <walter.bonola@doosan.com>

Subject: PE 1595 As Built drawing for UHART Project

Good afternoon

As part of our close out for this project for UHART (PE 1595), I have attached the as built set of construction drawings.

Thank you for all your assistance in making this project a success.

Any questions please let me know.

Thanks

John Prinssen

Project Manager - Installations

M: 860.727-2091

E: john.prinssen@doosan.com



GENERAL NOTES

- 1. THE STRUCTURAL DRAWINGS AND SPECIFICATIONS, TO THE BEST OF OUR KNOWLEDGE, COMPLY WITH THE APPLICABLE REQUIREMENTS OF THE 2022 CONNECTICUT STATE BUILDING CODE, AND AMENDMENTS TO THE 2018 INTERNATIONAL BUILDING CODE.
2. THE CONTRACTOR SHALL COMPLY WITH THE REQUIREMENTS OF THE 2018 INTERNATIONAL BUILDING CODE WITH STATE OF CONNECTICUT AMENDMENTS AND ALL APPLICABLE FEDERAL & STATE CODES, STANDARDS, REGULATIONS AND LAWS.
3. ALL REFERENCED STANDARDS REFER TO THE EDITION IN FORCE AT THE TIME THESE PLANS AND SPECIFICATIONS ARE ISSUED FOR PERMIT.
4. WORK NOT INDICATED ON A PART OF THE DRAWINGS BUT REASONABLY IMPLIED TO BE SIMILAR TO THAT SHOWN AT CORRESPONDING PLACES SHALL BE REPEATED.
5. IN ANY CASE OF CONFLICT BETWEEN THE NOTES, DETAILS AND SPECIFICATIONS, THE MOST RIGID REQUIREMENTS SHALL GOVERN. CONTRACTOR SHALL MAKE NO DEVIATION FROM CONTRACT DOCUMENTS WITHOUT WRITTEN APPROVAL OF THE ENGINEER.
6. THE CONTRACTOR SHALL VERIFY ALL DIMENSIONS AND CONDITIONS AND COORDINATE WITH LAYOUT DRAWINGS, DRAWINGS FROM OTHER CONSULTANTS, PROJECT SHOP DRAWINGS AND FIELD CONDITIONS.
7. THE CONTRACTOR SHALL PROTECT EXISTING FACILITIES, STRUCTURES AND UTILITY LINES FROM ALL DAMAGE.
8. JOB SAFETY AND CONSTRUCTION PROCEDURES ARE THE RESPONSIBILITY OF THE CONTRACTOR.
9. THE STRUCTURES ARE DESIGNED FOR THE FOLLOWING LOADS:

SEISMIC LOADS:
SEISMIC PARAMETERS
-SPECTRAL ACCELERATIONS: Ss = 0.181, S1 = 0.064
-SEISMIC DESIGN CATEGORY: "D"

WIND LOADS
-ULTIMATE DESIGN WIND SPEED = 120 MPH.
-EXPOSURE "C"

SNOW LOADS
-GROUND SNOW LOAD = 30 PSF + DRIFT

FLOOD DESIGN DATA
-FLOOD ZONE: (LATER)
-GROUND ELEVATION: (LATER)

- 10. THE PLAN AND DETAILS HERE IN ARE BASED ON LIMITED SITE OBSERVATIONS AND EXISTING DRAWINGS. ANY DISCREPANCIES BETWEEN EXISTING FIELD CONDITIONS AND THE DRAWINGS SHALL BE BROUGHT TO THE IMMEDIATE ATTENTION OF THE ENGINEER.
11. THE CONTRACTOR SHALL PERFORM ALL WORK WITH CARE SO THAT ANY EXISTING MATERIALS THAT ARE TO REMAIN SHALL NOT BE DAMAGED. IF THE CONTRACTOR DAMAGES ANY MATERIALS THAT ARE TO REMAIN IN PLACE, THE DAMAGED MATERIALS SHALL BE REPAIRED OR REPLACED IN A MANNER SATISFACTORY TO THE ENGINEER AT THE EXPENSE OF THE CONTRACTOR.
12. ALL AREAS DISTURBED BY THE CONTRACTOR WITHOUT AUTHORIZATION OF THE ENGINEER SHALL BE RESTORED BY THE CONTRACTOR AT NO ADDITIONAL EXPENSE.

FOUNDATION NOTES

- 1. FOUNDATION DESIGN PARAMETERS FROM GEOTECHNICAL INVESTIGATION REPORT PREPARED BY WELTI GEOTECHNICAL, INC. OF GLASTONBURY, CT. DATED MARCH 1, 2023.
2. FOUNDATION IS DESIGNED TO BE SUPPORTED ON BEARING PRESSURE OF 2,000 PSF OR HELICAL PILES AS SPECIFIED BY "HELICAL DRILLING" OUT OF BRAINTREE, MA.
3. CONTRACTOR SHALL BE FAMILIAR WITH THE SUBSURFACE CONDITIONS AND GEOTECHNICAL REPORT BEFORE COMMENCING EXCAVATION.
4. DOWELS FROM FOOTINGS INTO PIERS AND WALLS ABOVE SHALL BE THE SAME SIZE AND NUMBER AS VERTICAL REBAR IN PIERS AND WALLS, AND SHALL BE EXTENDED "LTE" INTO FOOTINGS AND "LTS" INTO PIERS AND WALLS UNLESS OTHERWISE SHOWN.
5. DROP BOTTOM OF WALLS AND PIERS TO TOP OF FOOTINGS TO OBTAIN FULL EXTENT OF CONTACT, UNLESS OTHERWISE SHOWN.
6. CENTERLINE OF FOOTINGS SHALL BE CENTERLINE OF WALLS, PIERS AND COLUMNS, UNLESS OTHERWISE SHOWN.
7. NO BACKFILLING SHALL BE DONE AGAINST FOUNDATION AND RETAINING WALLS UNTIL CONCRETE HAS ATTAINED AT LEAST 75% OF ITS DESIGN STRENGTH. BEFORE BACKFILLING, PROVIDE BRACING FOR WALLS SUSTAINING MORE THAN 3 FEET OF EARTH PRESSURE. THIS BRACING SHALL REMAIN IN PLACE UNTIL ALL SLABS AND BEAMS FRAMING INTO WALL HAVE BEEN PLACED AND SET.
8. IN NO CASE SHALL BULLDOZERS OR OTHER HEAVY EQUIPMENT BE PERMITTED CLOSER THAN 5 FEET FROM ANY FOUNDATION WALL. IF IT IS NECESSARY TO OPERATE SUCH EQUIPMENT CLOSER THAN 8 FEET TO THE WALL, THE CONTRACTOR SHALL BE THE SOLE RESPONSIBLE PARTY AND AT THEIR OWN EXPENSE SHALL PROVIDE ADEQUATE SUPPORTS OR BRACE THE WALL TO WITHSTAND THE ADDITIONAL LOADS SUPERIMPOSED FROM SUCH EQUIPMENT.
9. CONTRACTOR SHALL BE RESPONSIBLE TO ADEQUATELY PROTECT ALL EXCAVATION SLOPES, WHERE NECESSARY, SHEETING AND SHORING OF EXCAVATION SHALL BE PROVIDED WITH ALL REQUIRED TIEBACKS AND BRACING.
10. METHODS EMPLOYED IN ALL SHEETING AND SHORING SHALL BE DESIGNED BY A PROFESSIONAL ENGINEER LICENSED IN THE STATE OF CONNECTICUT.
11. MATERIAL FOR CONTROLLED FILL SHALL MEET THE FOLLOWING CRITERIA: SELECT EXCAVATED GRAVEL OR STONE MATERIALS FREE OF ORGANIC MATERIAL, LOAM, TRASH, SNOW, ICE, FROZEN SOIL, AND OTHER OBJECTIONABLE MATERIAL, CONFORMING TO THE GRADATION REQUIREMENTS AS FOLLOWS:
SIEVE SIZE %PASSING (BY WEIGHT)
3-1/2" 100 % NOTE:
3/4" 50-100 % THE FRACTION PASSING THE NO. 200 SIEVE SHALL BE LESS
#4 25-75 % THAN 15% OF THE FRACTION PASSING THE NO. 4 SIEVE
12. ON-SITE EXCAVATED MATERIAL MAY ONLY BE SUITABLE FOR USE AS GRANULAR FILL IF IT CONFORMS TO THE SPECIFICATIONS NOTED AND IS APPROVED FOR USE BY THE GEOTECHNICAL ENGINEER. REFER TO GEOTECHNICAL REPORT FOR MORE INFORMATION.
13. STRUCTURAL FILL MATERIAL SHOULD BE PLACED IN UNIFORM 12" THICK LOOSE LIFTS AND COMPACTED TO 95% OF ITS MAXIMUM DRY DENSITY, AT OPTIMUM MOISTURE CONTENT, IN ACCORDANCE WITH ASTM D1557-00. IN RESTRICTED AREAS WHERE ONLY HAND-OPERATED EQUIPMENT IS PERMITTED, THE MAXIMUM LOOSE LIFT SHALL BE 8".
14. SOIL COMPACTION SHALL BE CONTROLLED BY A QUALIFIED TESTING LABORATORY OR GEOTECHNICAL ENGINEER AS PART OF SPECIAL INSPECTIONS. TAKE A MINIMUM OF ONE FIELD DENSITY TEST FOR EACH LAYER. LOCATION OF TEST SHALL BE DETERMINED BY THE TESTING AGENCY.

REINFORCED CONCRETE NOTES

- 1. STRUCTURAL CONCRETE AND CONCRETING PRACTICES SHALL CONFORM WITH ACI-318, "AMERICAN CONCRETE INSTITUTE, BUILDING CODE REQUIREMENTS FOR STRUCTURAL CONCRETE" LATEST EDITION. DETAILS SHALL BE IN ACCORDANCE WITH ACI-315, "DETAILS AND DETILING OF CONCRETE REINFORCEMENT" UNLESS OTHERWISE NOTED ON THE DRAWINGS. ALL ACI REQUIREMENTS FOR HOT AND COLD WEATHERING CONCRETING MUST BE ADHERED TO.
2. ALL CAST-IN-PLACE CONCRETE MIXES SHALL HAVE A MINIMUM 28 DAYS COMPRESSIVE STRENGTH AS FOLLOWS UNLESS OTHERWISE NOTED ON DRAWINGS:
fc (PSI) (28 DAY)
A. SLABS, AREA PAVING, AND ROADS 4,000
B. WATER TIGHT CONCRETE 4,000
C. MACHINERY FOUNDATIONS 4,000
D. STATIONARY EQUIPMENT FOUNDATIONS 4,000
E. STRUCTURES AND THEIR FOUNDATIONS 4,000
F. MISC CONCRETE FILL AND UNDERGROUND DUCT BANKS 2,000
3. ALL CONCRETE EXPOSED TO WEATHER SHALL HAVE AN AIR-ENTRAINING AGENT.
4. REINFORCING BARS SHALL CONFORM TO ASTM A615, GRADE 60 UNLESS REQUIRED TO BE WELDED AS SHOWN ON PLANS. ALL REINFORCING BARS REQUIRED TO BE WELDED SHALL CONFORM TO ASTM A706, GRADE 50.
5. WELDED WIRE FABRIC (W.W.F.) SHALL CONFORM TO ASTM A185. SUPPORT FABRIC WITH CHAIRS OR LIFTS DURING CONCRETE PLACEMENT TO ENSURE PROPER POSITION IN SLAB.
6. ALL REINFORCEMENT SHALL BE SECURELY HELD IN PLACE WHILE PLACING CONCRETE. IF REQUIRED, ADDITIONAL BARS OR STRIRRUPS SHALL BE PROVIDED BY THE CONTRACTOR TO FURNISH SUPPORT FOR ALL BARS.
7. ALL REINFORCING BARS SHALL BE LAPPED AS SPECIFICALLY DETAILED ON THE DRAWINGS. SPLICING & EMBEDMENTS SHALL BE IN ACCORDANCE WITH ACI 318 WHERE NOT SPECIFICALLY DETAILED. INDICATED ON THE DRAWINGS, ALL REINFORCING BARS SHALL BE LAPPED USING THE TENSION SPLICE (LTS) AND COMPRESSION SPLICE (LCS) LENGTHS NOTED IN THE LAP SPLICE SCHEDULE.
-LAP GRADE BEAM AND WALL TOP HORIZONTAL REINFORCEMENT AT CENTER OF SPAN
-LAP GRADE BEAM AND WALL BOTTOM HORIZONTAL REINFORCEMENT AT SUPPORT
-LAP INSIDE FACE WALL VERTICAL REINFORCEMENT AT SUPPORT
-LAP OUTSIDE FACE VERTICAL WALL REINFORCEMENT AT MID-HEIGHT OF WALL
-UNLESS NOTED OTHERWISE, TERMINATE BARS AT DISCONTINUOUS ENDS WITH STANDARD HOOKS
-ALL HOOKED BARS NOT DIMENSIONED SHALL BE STANDARD HOOKS
8. MINIMUM CONCRETE COVER SHALL BE AS FOLLOWS, UNLESS NOTED OTHERWISE ON THE DRAWINGS:
SLABS 3/4 IN.
WALLS 1 IN.
COLUMNS ... 1-1/2 IN.
ALL CONCRETE EXPOSED TO EARTH/ WEATHER..... 2 IN.
ALL CONCRETE CAST AGAINST EARTH (NO FORMWORK).... 3 IN.
9. PROVIDE CONSTRUCTION JOINTS IN ACCORDANCE WITH ACI-318, CHAPTER 6.4 SUBMIT SHOP DRAWINGS SHOWING CONSTRUCTION JOINT DETAILS, LOCATIONS AND THE SEQUENCE OF POURS FOR THE STRUCTURAL ENGINEER'S REVIEW PRIOR TO BEGINNING WORK.
10. WALL AND GRADE BEAM CONSTRUCTION JOINTS SHALL BE LOCATED TO PROVIDE A 60-FOOT MAXIMUM LENGTH OF CONCRETE PLACEMENT.
11. VERTICAL CONSTRUCTION JOINTS IN GRADE BEAMS AND WALLS SHALL BE USED ONLY WITH PRIOR APPROVAL OF THE ENGINEER (SEE NOTE 9 ABOVE) AND SHALL BE LOCATED AS FOLLOWS:
FOUNDATION WALLS: MINIMUM 6'-0" FROM ANY COLUMN LINE OR WALL OPENING
GRADE BEAMS: AT CENTERLINES BETWEEN SUPPORTS
12. NO HORIZONTAL CONSTRUCTION JOINTS WILL BE PERMITTED IN BEAMS, WALLS AND SLABS UNLESS SPECIFICALLY SHOWN ON THE DRAWINGS OR APPROVED IN WRITING PRIOR TO CONSTRUCTION BY THE ENGINEER.
13. NO CONCRETE TEST WILL BE ACCEPTED IF CONCRETE IS TAMPERED WITH IN ANY WAY AFTER SAID TEST IS PERFORMED. REPEAT TEST IF WATER IS ADDED AFTER INITIAL SAMPLING.
14. THE CONTRACTOR SHALL PROVIDE REINFORCING STEEL ERECTOR WITH A SET OF APPROVED SHOP DRAWINGS FOR FIELD USE.
15. ALL ADJOINING SURFACES NOT CAST MONOLITHICALLY SHALL BE ROUGHENED TO 1/4 INCH AMPLITUDE FOR THE ENTIRE INTERSECTING SURFACE ACCORDING TO ACI RECOMMENDATIONS AND APPLY A BONDING AGENT AS REQUIRED.
16. CONTRACTOR SHALL FIELD VERIFY DIMENSIONS AND LOCATIONS OF ALL OPENINGS, PIPE SLEEVES, CURBS, ETC., AS REQUIRED BY OTHER TRADES BEFORE CONCRETE IS PLACED.
17. CONTRACTOR SHALL COORDINATE LOCATION OF INSERTS, WELDED PLATES AND OTHER ITEMS TO BE EMBEDDED IN CONCRETE WITH ARCHITECTURAL, MECHANICAL AND STRUCTURAL DRAWINGS.
18. CONTRACTOR SHALL COORDINATE LOCATION OF FLOOR DRAINS, CURBS, CONCRETE PADS, FLOOR DEPRESSIONS, ETC. WITH ARCHITECTURAL AND MECHANICAL DRAWINGS.
19. HORIZONTAL PIPES OR CONDUITS PLACED IN SLABS SHALL NOT BE SPACED CLOSER THAN 3 x THE DIAMETER OF CENTER. PIPE AND CONDUITS PLACED IN SLABS SHALL NOT HAVE AN OUTSIDE DIAMETER LARGER THAN 1/3 OF SLAB THICKNESS. ALUMINUM CONDUITS SHALL NOT BE PLACED IN CONCRETE. NO CONDUITS SHALL BE PLACED IN THE SLAB WITHIN 12 INCHES OF ANY COLUMN FACE.
20. CONTRACTOR SHALL USE RIGID STEEL TEMPLATES (SUPPLIED BY THE STEEL FABRICATOR) TO INSTALL ANCHOR RODS.
21. ALL CONCRETE WORK, REINFORCING, PLACEMENT, AND FORMWORK SHALL BE INSPECTED BY AN INDEPENDENT TESTING AGENCY RETAINED BY THE OWNER FOR THE FOLLOWING ITEMS:
A. INSPECT BOTTOM OF FOOTING SOIL CONDITIONS
B. INSPECT FORMWORK AND PLACEMENT OF CONCRETE
C. TESTING FRESH CONCRETE IN THE FIELD PER ASTM C-172, MODIFIED FOR SLUMP BY ASTM C-94
D. SLUMP TEST PER ASTM C-143, ONE TEST AT POINT OF DISCHARGE FOR EACH DAYS POUR FOR EACH TYPE OF CONCRETE.
E. TEST AIR CONTENT PER ASTM C-173 (VOLUMETRIC METHOD) OR ASTM C-231 (PRESSURE METHOD), ONE TEST FOR EACH DAYS POUR FOR EACH TYPE OF CONCRETE.
F. COMPRESSION TEST CYLINDERS PER ASTM C-311 (4-CYLINDERS)
G. TEST CONCRETE TEMPERATURE EACH TIME A SET OF CYLINDERS IS CAST
H. COMPRESSION STRENGTH TEST PER ASTM C-39:
ONE SET FOR EACH DAYS POUR + ADDITIONAL SETS FOR EACH 50-CUBIC YARDS OVER AND ABOVE THE IRST 25-CUBIC YARDS USING THE FOLLOWING ORDER:
a. ONE CYLINDER TESTED AT 7 DAYS
b. TWO CYLINDERS TESTED AT 28 DAYS
c. ONE CYLINDER RETAINED FOR LATER TESTING, IF REQUIRED
22. ANCHOR BOLT STEEL SHALL CONFORM TO ASTM SPECIFICATION A36 OR A307.
23. EMBEDDED STEEL MATERIAL SHALL CONFORM TO ASTM A36 UNLESS OTHERWISE NOTED ON THE DRAWINGS.
24. EMBEDDED PIPE SLEEVES SHALL BE ASTM A53 GRADE B UNLESS OTHERWISE NOTED ON THE DRAWINGS.
25. ALL EXPOSED CORNERS SHALL HAVE 3/4" CHAMFER UNLESS NOTED ON PLAN.
26. ALL EXTERIOR CONCRETE SHALL HAVE AIR-ENTRAINING ADMIXTURE PROVIDING 4% TO 6% TOTAL AIR CONTENT.
27. ALL EXPOSED CONCRETE SURFACES SHALL BE CURED IMMEDIATELY AFTER FINISHING. CONCRETE SHALL BE KEPT CONTINUOUSLY MOIST FOR A MINIMUM OF 7 DAYS OR APPLY TWO COATS OF CURING COMPOUND WITH A SECOND COAT APPLIED AT RIGHT ANGLE TO FIRST COAT. ALTERNATE METHODS MAY BE USED WITH PRIOR APPROVAL.
28. GROUT UNDER ALL STRUCTURAL COLUMNS, MISCELLANEOUS BASE PLATE SUPPORTS, EQUIPMENT BASES, AROUND ANCHOR BOLTS, AND INSIDE ANCHOR BOLT SLEEVES SHALL BE PREPACKAGED, CEMENTIOUS, NON-SHRINK, NON-METALIC TYPE.
29. WELDING OF REINFORCEMENT (INCLUDING TACK WELDS) SHALL NOT BE PERMITTED UNLESS NOTED ON PLAN.
30. DETAILING OF REINFORCEMENT SHALL BE PERFORMED USING STANDARD END HOOKS AND WITH LAP SPLICE & EMBEDMENT LENGTHS ONLY AS INDICATED ON DRAWINGS.
31. ALL EXTERIOR SLAB SURFACES SHALL HAVE A METAL FLOAT FINISH. EXTRA CARE IS REQUIRED UNDER THE FUEL CELLS. - REFER TO MANUFACTURER'S SPECIFICATIONS.

STRUCTURAL STEEL NOTES:

- 1. STRUCTURAL STEEL DESIGN, FABRICATION AND ERECTION SHALL BE IN ACCORDANCE WITH AISC "SPECIFICATION FOR STRUCTURAL STEEL BUILDINGS - ALLOWABLE STRESS DESIGN AND PLASTIC DESIGN" AND "CODE OF STANDARD PRACTICE FOR STEEL BUILDINGS AND BRIDGES" (LATEST EDITIONS).
2. HIGH STRENGTH BOLTING SHALL BE IN ACCORDANCE WITH AISC "SPECIFICATION FOR STRUCTURAL JOINTS USING ASTM A 325 OR A 490 BOLTS (LATEST EDITIONS)".
3. ALL WELDING SHALL BE IN ACCORDANCE WITH AMERICAN WELDING SOCIETY D1.1 "STRUCTURAL WELDING CODE-STEEL" (LATEST EDITION).
CONNECTIONS
1. UNLESS SPECIFICALLY NOTED ON THE DRAWINGS, SHOP CONNECTIONS MAY BE ASSEMBLED BY EITHER BOLTING OR WELDING.
2. BOLTED CONNECTIONS FOR PRIMARY STRUCTURAL MEMBERS SHALL BE BOLTED WITH HIGH STRENGTH BOLTS CONFORMING TO ASTM A 325 UNLESS NOTED OTHERWISE ON THE DRAWINGS.
3. BOLTED CONNECTIONS FOR SECONDARY STRUCTURAL MEMBERS (PURLINS, GIRTS, STAIR FRAMING, STAIR BRACING, TOE PLATE, HANDRAIL, LADDERS, ETC) USING GREATER THAN 5/8" DIA. BOLTS SHALL BE BOLTED WITH HIGH STRENGTH BOLTS CONFORMING TO ASTM A 325, UNLESS NOTED OTHERWISE ON THE DRAWINGS.
4. ALL HIGH STRENGTH BOLTED CONNECTIONS SHALL BE BEARING TYPE WITH THREADS INCLUDED IN SHEAR.
5. HIGH STRENGTH BOLT SIZES SHALL BE 3/4 INCH DIAMETER MINIMUM (UNO).
6. THICKNESS OF GUSSET AND STIFFENER PLATES, IF NOT CALLED FOR ON THE DRAWINGS, SHALL BE INCH MINIMUM.
7. WORKING POINTS FOR HORIZONTAL BRACING CONNECTIONS SHALL BE THE CENTERLINE OF THE INTERSECTING HORIZONTAL BEAMS UNLESS NOTED OTHERWISE ON THE DRAWINGS. HORIZONTAL BRACING SHALL BE CONNECTED TO TWO (2) BEAMS WHEREVER POSSIBLE.
8. WORKING POINTS FOR VERTICAL BRACING CONNECTIONS SHALL BE THE CENTERLINE OF BEAM AND CENTERLINE OF COLUMN, UNLESS NOTED OTHERWISE ON THE DRAWINGS. VERTICAL BRACING SHALL BE CONNECTED TO BOTH BEAM & COLUMN.
9. GRATING SHALL BE CONNECTED TO SUPPORT BEAMS WITH SADDLE CLIPS & SELF-TAPPING SCREWS. FRICTION CLIPS ARE NOT PERMITTED.
10. USE 4-BOLT MINIMUM FOR WT BRACE CONNECTIONS AND 2-BOLT MINIMUM FOR ANGLE BRACE CONNECTIONS
11. SURFACES OF STRUCTURAL STEEL SHALL NOT RECEIVE SHOP-APPLIED PAINT WITHIN 4" OF FIELD WELDS.
12. WHERE FIELD WELDS WILL BE DONE ON EXISTING STEEL ALL EXISTING COATINGS SHALL BE CONSIDERED TO BE LEAD BASED. AN APPROVED CONTRACTOR SHALL STRIP EXISTING SURFACE COATINGS AND THE REMOVAL PROCEDURE SHALL COMPLY WITH OSHA STANDARD 1926.354. EXISTING COATING SHALL BE REMOVED A MINIMUM OF 4" FROM THE AREA TO BE WELDED. ALL EXPOSED AREAS SHALL BE PAINTED AFTER THE COMPLETION OF WORK.
13. IF BEAM REACTIONS ARE NOT SHOWN ON THE DRAWINGS, CONNECTIONS SHALL BE DETAILED TO SUPPORT ONE-HALF THE TOTAL UNIFORM LOAD CAPACITY SHOWN IN TABLES OF 'UNIFORM LOAD', FOR THE GIVEN BEAM, SPAN & GRADE OF STEEL SPECIFIED. THESE TABLES SHALL BE AS LISTED IN AISC MANUAL OF STEEL CONSTRUCTION.
MATERIALS
1. STRUCTURAL STEEL "W" "WT" AND "S" SHAPES SHALL CONFORM TO ASTM A 992, GRADE 50, ALL CHANNELS, ANGLES AND PLATES SHALL CONFORM TO ASTM A 36 UNLESS NOTED OTHERWISE.
2. HIGH STRENGTH BOLTS, NUTS AND HARDENED WASHERS SHALL CONFORM TO ASTM A 325, ASTM A 563 DH, AND ASTM F 436 RESPECTIVELY. MACHINE BOLTS AND NUTS SHALL CONFORM TO ASTM A 307, AND PLAIN WASHERS SHALL CONFORM TO ANSI B18.22.1.
3. WELDING ELECTRODES USED FOR FIELD CONNECTIONS SHALL CONFORM TO AWS A5.1, CLASS E70XX UNLESS NOTED OTHERWISE ON THE DRAWINGS. WELDING ELECTRODES USED FOR SHOP CONNECTIONS SHALL CONFORM TO AWS A5.1 WITH A MINIMUM ELECTRODE TENSILE STRENGTH OF 70 KSI, UNLESS NOTED OTHERWISE ON THE DRAWINGS.
4. GRATING SHALL BE WELDED STEEL BAR TYPE WITH 1 INCH X 1/4 INCH BEARING BARS SPACED AT 1 CENTER TO 4 1/8 CENTER, UNLESS NOTED OTHERWISE ON THE DRAWINGS. CROSS BARS SHALL BE SPACED AT 4 INCHES CENTER TO CENTER. ALL BEARING BARS AND CROSS BARS SHALL BE WELDING QUALITY MILD CARBON STEEL AND SHALL CONFORM TO ASTM A 569. GRATING SHALL BE HOT-DIPPED GALVANIZED.
5. CHECKERED FLOOR PLATE SHALL BE FOUR WAY RAISED PATTERN STEEL PLATE OF THE THICKNESS CALLED FOR ON THE DRAWINGS. PLATE MATERIAL SHALL CONFORM TO ASTM A 36 OR ASTM A786. HOLLOW STRUCTURAL STEEL (HSS): ASTM A500 GRADE B, MIN. YIELD STRENGTH OF 42 KSI FOR PIPES, 46 KSI FOR TUBES
6. ALL STRUCTURAL STEEL, MISCELLANEOUS STEEL, HANDRAIL AND LADDERS SHALL BE HOT DIP GALVANIZED AFTER FABRICATION (UNLESS NOTED OTHERWISE) IN ACCORDANCE WITH SPECIFICATION (LATER)
7. ALL BOLTS SHALL CONFORM TO ASTM A325 OR A490, NUTS SHALL CONFORM TO ASTM A563 AND WASHERS SHALL CONFORM TO ASTM A-F436.
8. ALL ANCHOR BOLTS/RODS SHALL CONFORM TO ASTM F-1554 GRADE 36 WITH WELD ABILITY
9. SUPPLEMENT S1, UNLESS OTHERWISE NOTED. SUBMIT GRADE CERTIFICATIONS FOR RECORD. STEEL SUPPLIER SHALL SUPPLY RIGID STEEL TEMPLATES FOR ANCHOR ROD INSTALLATION.
10. OVERSIZED OR SLOTTED HOLES SHALL NOT BE USED FOR ANY CONNECTIONS UNLESS SPECIFICALLY INDICATED ON THE DRAWINGS OR APPROVED IN WRITING BY THE ENGINEER.
11. ALL BUTT AND FULL PENETRATION WELDS SHALL BE MADE USING RUN OFF TABS WHICH SHALL BE REMOVED AND GROUND SMOOTH AFTER WELD IS COMPLETED.
12. ALL WELD BACK UP BARS SHALL BE REMOVED AND GROUND SMOOTH AFTER WELD IS COMPLETED, UNLESS NOTED OTHERWISE.
13. ALL WELDS INDICATED SHALL MEET THE MINIMUM WELD SIDE SPECIFIED BY THE AISC MANUAL OF STEEL DESIGN. (SINGLE PASS AS REQUIRED)
14. ALL WELDS SHALL BE PERFORMED BY QUALIFIED WELDERS IN ACCORDANCE WITH A.W.S. SPECIFICATIONS, LATEST EDITIONS. ALL WELDING ELECTRODES SHALL CONFORM TO A.W.S. A5.1 GRADE E-70. BARE ELECTRODES AND GRANULAR FLUX SHALL CONFORM TO A.W.S. A5.17, F70 A.W.S. FLUX CLASSIFICATION.
15. ALTERNATE CONNECTIONS WILL BE ACCEPTED ONLY WITH THE WRITTEN APPROVAL OF THE ENGINEER. HOWEVER, THE ENGINEER SHALL BE THE SOLE JUDGE OF THE ACCEPTABILITY AND THE CONTRACTOR'S BID SHALL ANTICIPATE THE USE OF THOSE SPECIFIC DETAILS SHOWN ON THE DRAWINGS. IN ANY EVENT THE CONTRACTOR SHALL BE RESPONSIBLE FOR THE DESIGN OF SUCH ALTERNATE DETAILS WHICH THEY PROPOSE.
16. SHOP AND FIELD CONNECTIONS NOT SPECIFICALLY DETAILED ON THE DRAWINGS SHALL BE BOLTED OR WELDED.

STRUCTURAL STEEL NOTES (CONT.)

- 15. WHEN NOT SPECIFICALLY DETAILED ELSEWHERE ON THE DRAWINGS, ALL BEAM TO BEAM AND BEAM TO COLUMN CONNECTIONS SHALL BE DETAILED AS SHOWN IN THE TYPICAL BEAM CONNECTION DETAILS.
16. ALL BEAM AND GIRDERS SHALL BE CONNECTED FOR 115% OF THE REACTION DENOTED BY THE "GRAVITY SHEAR REACTION" SYMBOL ON THE PLANS. PROVIDE A MINIMUM 2 BOLT CONNECTION.
17. FILLER BEAMS SHOULD BE SPACED EQUALLY BETWEEN THE SUPPORTS UNLESS OTHERWISE NOTED ON THE DRAWINGS.
18. ALL HOLES AND CUTS SHALL BE SHOWN ON THE SHOP DRAWINGS AND MADE IN THE SHOP. CUTS OR BURNING OF HOLES IN STRUCTURAL STEEL MEMBERS IN THE FIELD WILL NOT BE PERMITTED.
19. STEEL MEMBERS INDICATED ON THE DRAWINGS TO BE ENCASED IN CONCRETE SHALL BE ENCASED ON THE CONTACT SURFACES AND SHALL BE WRAPPED WITH A MINIMUM 6X6-W2.9WX2.9 W.W.F. REINFORCING UNLESS OTHERWISE NOTED.
20. THE STRUCTURAL STEEL CONTRACTOR SHALL COORDINATE THE BOTTOM OF BASE PLATE ELEVATION WITH THE TOP OF CONCRETE ELEVATION.
21. THE MAXIMUM LOAD HUNG FROM ANY BEAM FOR MEP DUCTWORK, PIPING ETC SHALL BE DISTRIBUTED TO THE BEAM'S TRIBUTARY AREA IN A WAY THAT THE ALLOWABLE DESIGN LOADS LISTED IN THE GENERAL NOTES ARE NOT EXCEEDED. THE CONTRACTOR SHALL COORDINATE THE LOADS OF ALL TRADES AND PROVIDE ADDITIONAL SUPPORT OR DISTRIBUTION FRAMING AS REQUIRED TO ACHIEVE THESE LOADS.
22. STRUCTURAL DRAWINGS SHALL BE USED IN CONJUNCTION WITH ARCHITECTURAL DRAWINGS, MECHANICAL DRAWINGS AND DRAWINGS RELATED TO OTHER TRADES. THE GENERAL CONTRACTOR IS RESPONSIBLE TO CHECK AND COORDINATE DIMENSIONS, CLEARANCES, ETC., WITH THE WORK OF THE OTHER TRADES.
23. PROVIDE ANY TEMPORARY BRACING OR GUYS TO PROVIDE LATERAL SUPPORT OF THE STRUCTURES AND INDIVIDUAL ELEMENTS UNTIL PERMANENT FRAME IS COMPLETELY INSTALLED.
24. ALL STRUCTURAL STEEL EXPOSED TO WEATHER SHALL BE GALVANIZED.
25. ALL TUBE & PIPE SECTIONS EXPOSED TO WEATHER SHALL HAVE OPEN ENDS CAPPED WITH 1/4" PLATE.
26. ALL STRUCTURAL STEEL TO RECEIVE SPRAY APPLIED FIRE PROTECTION SHALL BE LEFT UNCOATED.
27. FOR EXPOSED INTERIOR STRUCTURAL STEEL, REFER TO ARCHITECTURAL DRAWINGS AND SPECIFICATIONS FOR SURFACE PREPARATION AND FINISH REQUIREMENTS.
28. STEEL FABRICATOR SHALL COORDINATE ALL HOLE LOCATIONS FOR SIMPSON TIE DOWN ANCHORS. ALL HOLES SHALL BE SHOP DRILLED THROUGH BEAM FLANGES.

CONSTRUCTION METHODS:

- 1. BOTTOM OF EXCAVATION FOR SPREAD FOUNDATIONS AND MATS SHALL BE INSPECTED BY A QUALIFIED GEOTECHNICAL ENGINEER. ADDITIONAL UNDERCUT DEPTHS, IF REQUIRED, SHALL THEN BE DETERMINED. LIMITS OF BACKFILL SHALL EXTEND BEYOND FOUNDATION PERIMETER 1.5 TIMES THE UNDERCUT DEPTH.
2. BACKFILL MATERIAL SHALL BE AS SPECIFIED AND PLACED IN 8" MAXIMUM LIFTS. ALL BACKFILL WILL BE COMPACTED TO THE FOLLOWING PERCENT OF THE MAXIMUM DENSITY OBTAINED ACCORDING TO ASTM DENSITY TEST D-1557C.
-95 PERCENT OF MAXIMUM DRY DENSITY BELOW THE BASE OF FOOTINGS.
-95 PERCENT OF MAXIMUM DRY DENSITY BELOW SLABS.
3. COORDINATE CONCRETE WORK WITH PLUMBING, PIPING, ELECTRICAL AND MECHANICAL WORK PRIOR TO PLACING CONCRETE.
4. CONSTRUCTION JOINTS SHALL BE MADE AT THE LOCATIONS AND IN ACCORDANCE WITH THE DETAILS SHOWN ON THE DRAWINGS. GRADE BEAM CONSTRUCTION JOINTS SHALL BE MADE NEAR THE MID-SPAN OF THE BEAM.
5. LOCATIONS AND DETAILS OF JOINTS FOR SLABS AT GRADE ARE SHOWN ON THE DRAWINGS. SAWED CONTROL JOINTS SHALL BE SAWED WITHIN 12 TO 24 HOURS AFTER PLACING CONCRETE.

EXCAVATION NOTES:

- 1. THE CONTRACTOR WILL DETERMINE THE LOCATION OF ALL EXISTING UNDERGROUND UTILITY LINES BEFORE EXCAVATION OPERATIONS. EXISTING UTILITY LINES KNOWN TO THE CONTRACTOR BEFORE EXCAVATION AND UTILITY LINES UNCOVERED DURING EXCAVATION OPERATIONS WILL BE PROTECTED FROM DAMAGE DURING EXCAVATION AND BACK FILLING AND, IF DAMAGED, WILL BE REPAIRED BY THE CONTRACTOR TO THE SATISFACTION OF THE C/M. AT NO ADDITIONAL COST TO THE OWNER. NOTIFY THE C/M OF UNEXPECTED SUBSURFACE CONDITIONS AND STOP AFFECTED WORK IN AREA UNTIL NOTIFIED TO RESUME WORK.
2. THE CONTRACTOR IS RESPONSIBLE FOR THE DESIGN AND INSTALLATION OF TEMPORARY SHORING TO SUPPORT THE EXCAVATION AS REQUIRED. CONTRACTOR SHALL EXCAVATE WITH CARE SO NOT TO UNDERMINE EXISTING FOUNDATIONS.

SPECIAL INSPECTIONS

THE FOLLOWING CONTROLLED INSPECTIONS ARE REQUIRED TO BE PERFORMED IN ACCORDANCE WITH THE BUILDING CODE OF THE STATE OF CONNECTICUT, LATEST EDITION.


ITEM: HELICAL PILES
CONCRETE CONSTRUCTION
STEEL CONSTRUCTION

CONTRACTORS DESIGN RESPONSIBILITY


- 1. THE LISTED BELOW PROJECT ITEMS ASSOCIATED WITH FABRICATION, ERECTION AND CONTRACTORS MEANS AND METHODS AND REQUIRING STRUCTURAL DESIGN ARE THE RESPONSIBILITY OF THE CONTRACTOR.
2. THE CONTRACTOR SHALL RETAIN THE SERVICES OF STRUCTURAL PROFESSIONAL ENGINEER REGISTERED IN THE STATE OF CONNECTICUT TO PERFORM THE DESIGN OF THESE ITEMS.
3. CALCULATIONS FOR ITEMS MARKED THUS (*) SHALL BE SUBMITTED FOR REVIEW AND APPROVAL TO THE ENGINEER OF RECORD. OTHERWISE THE ITEMS SHALL ONLY BE SUBMITTED FOR THE OWNERS RECORD.

- A. STEEL SHOP DRAWING
B. CONCRETE MIX DESIGN
C. REINFORCING STEEL PLACEMENT PLAN
D. HELICAL PILES (APPROVAL BY THE GEOTECHNICAL ENGINEER)
E. FENCING
F. LADDER

Table with 4 columns: Description, Date, Rev., Updated Per Flood Comm. Requests. Row 1: Description, 07/21/23, F, Updated Per Flood Comm. Requests.

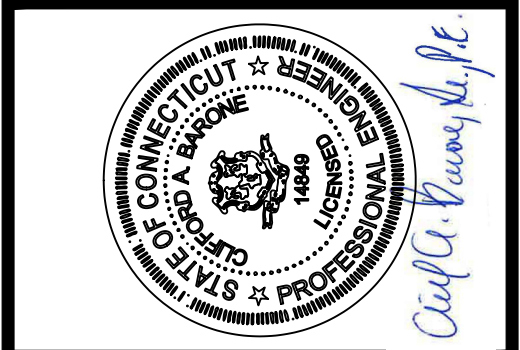

10 White Wood Lane
N. Branford, CT 06471
Phone: (203) 453-8596
Email: info@icdsllc.com

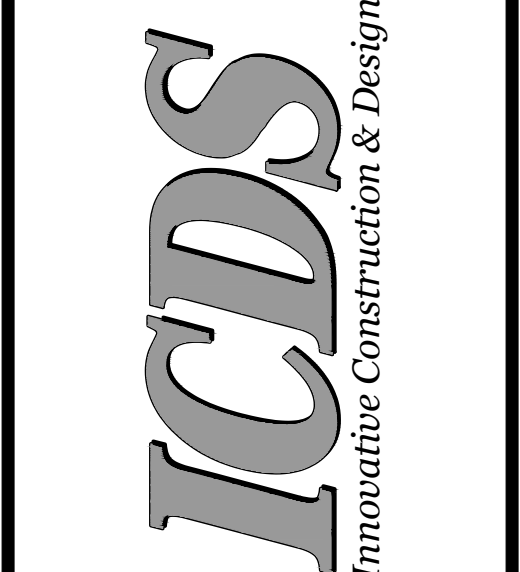


UNIVERSITY OF HARTFORD
200 BLOOMFIELD AVE, WEST HARTFORD CT
FUEL CELL INSTALLATION
STRUCTURAL NOTES

Table with 2 columns: Project No., Drawn By; Date, Design By; Scale, Check By. Project No.: , Drawn By: KFH; Date: 07/28/23, Design By: CAB; Scale: AS NOTED, Check By: DSF


Drawing No.:
SO.0




- NOTES:**
- FOR ALL NOTES REFER TO DRAWING S0.0
 - REFER TO DRAWING S3.0 & S3.1 FOR SECTIONS AND DETAILS.
 - REFER TO DRAWING S1.1 FOR PILE CAPS & WALLS.
 - PILE CAPACITY TO BE 32 KIPS.
 - REFER TO GENERAL ARRANGEMENT AND ELECTRICAL DRAWINGS FOR ALL UNDERGROUND UTILITY LOCATIONS & GRADE BEAM SLEEVE PENETRATIONS.

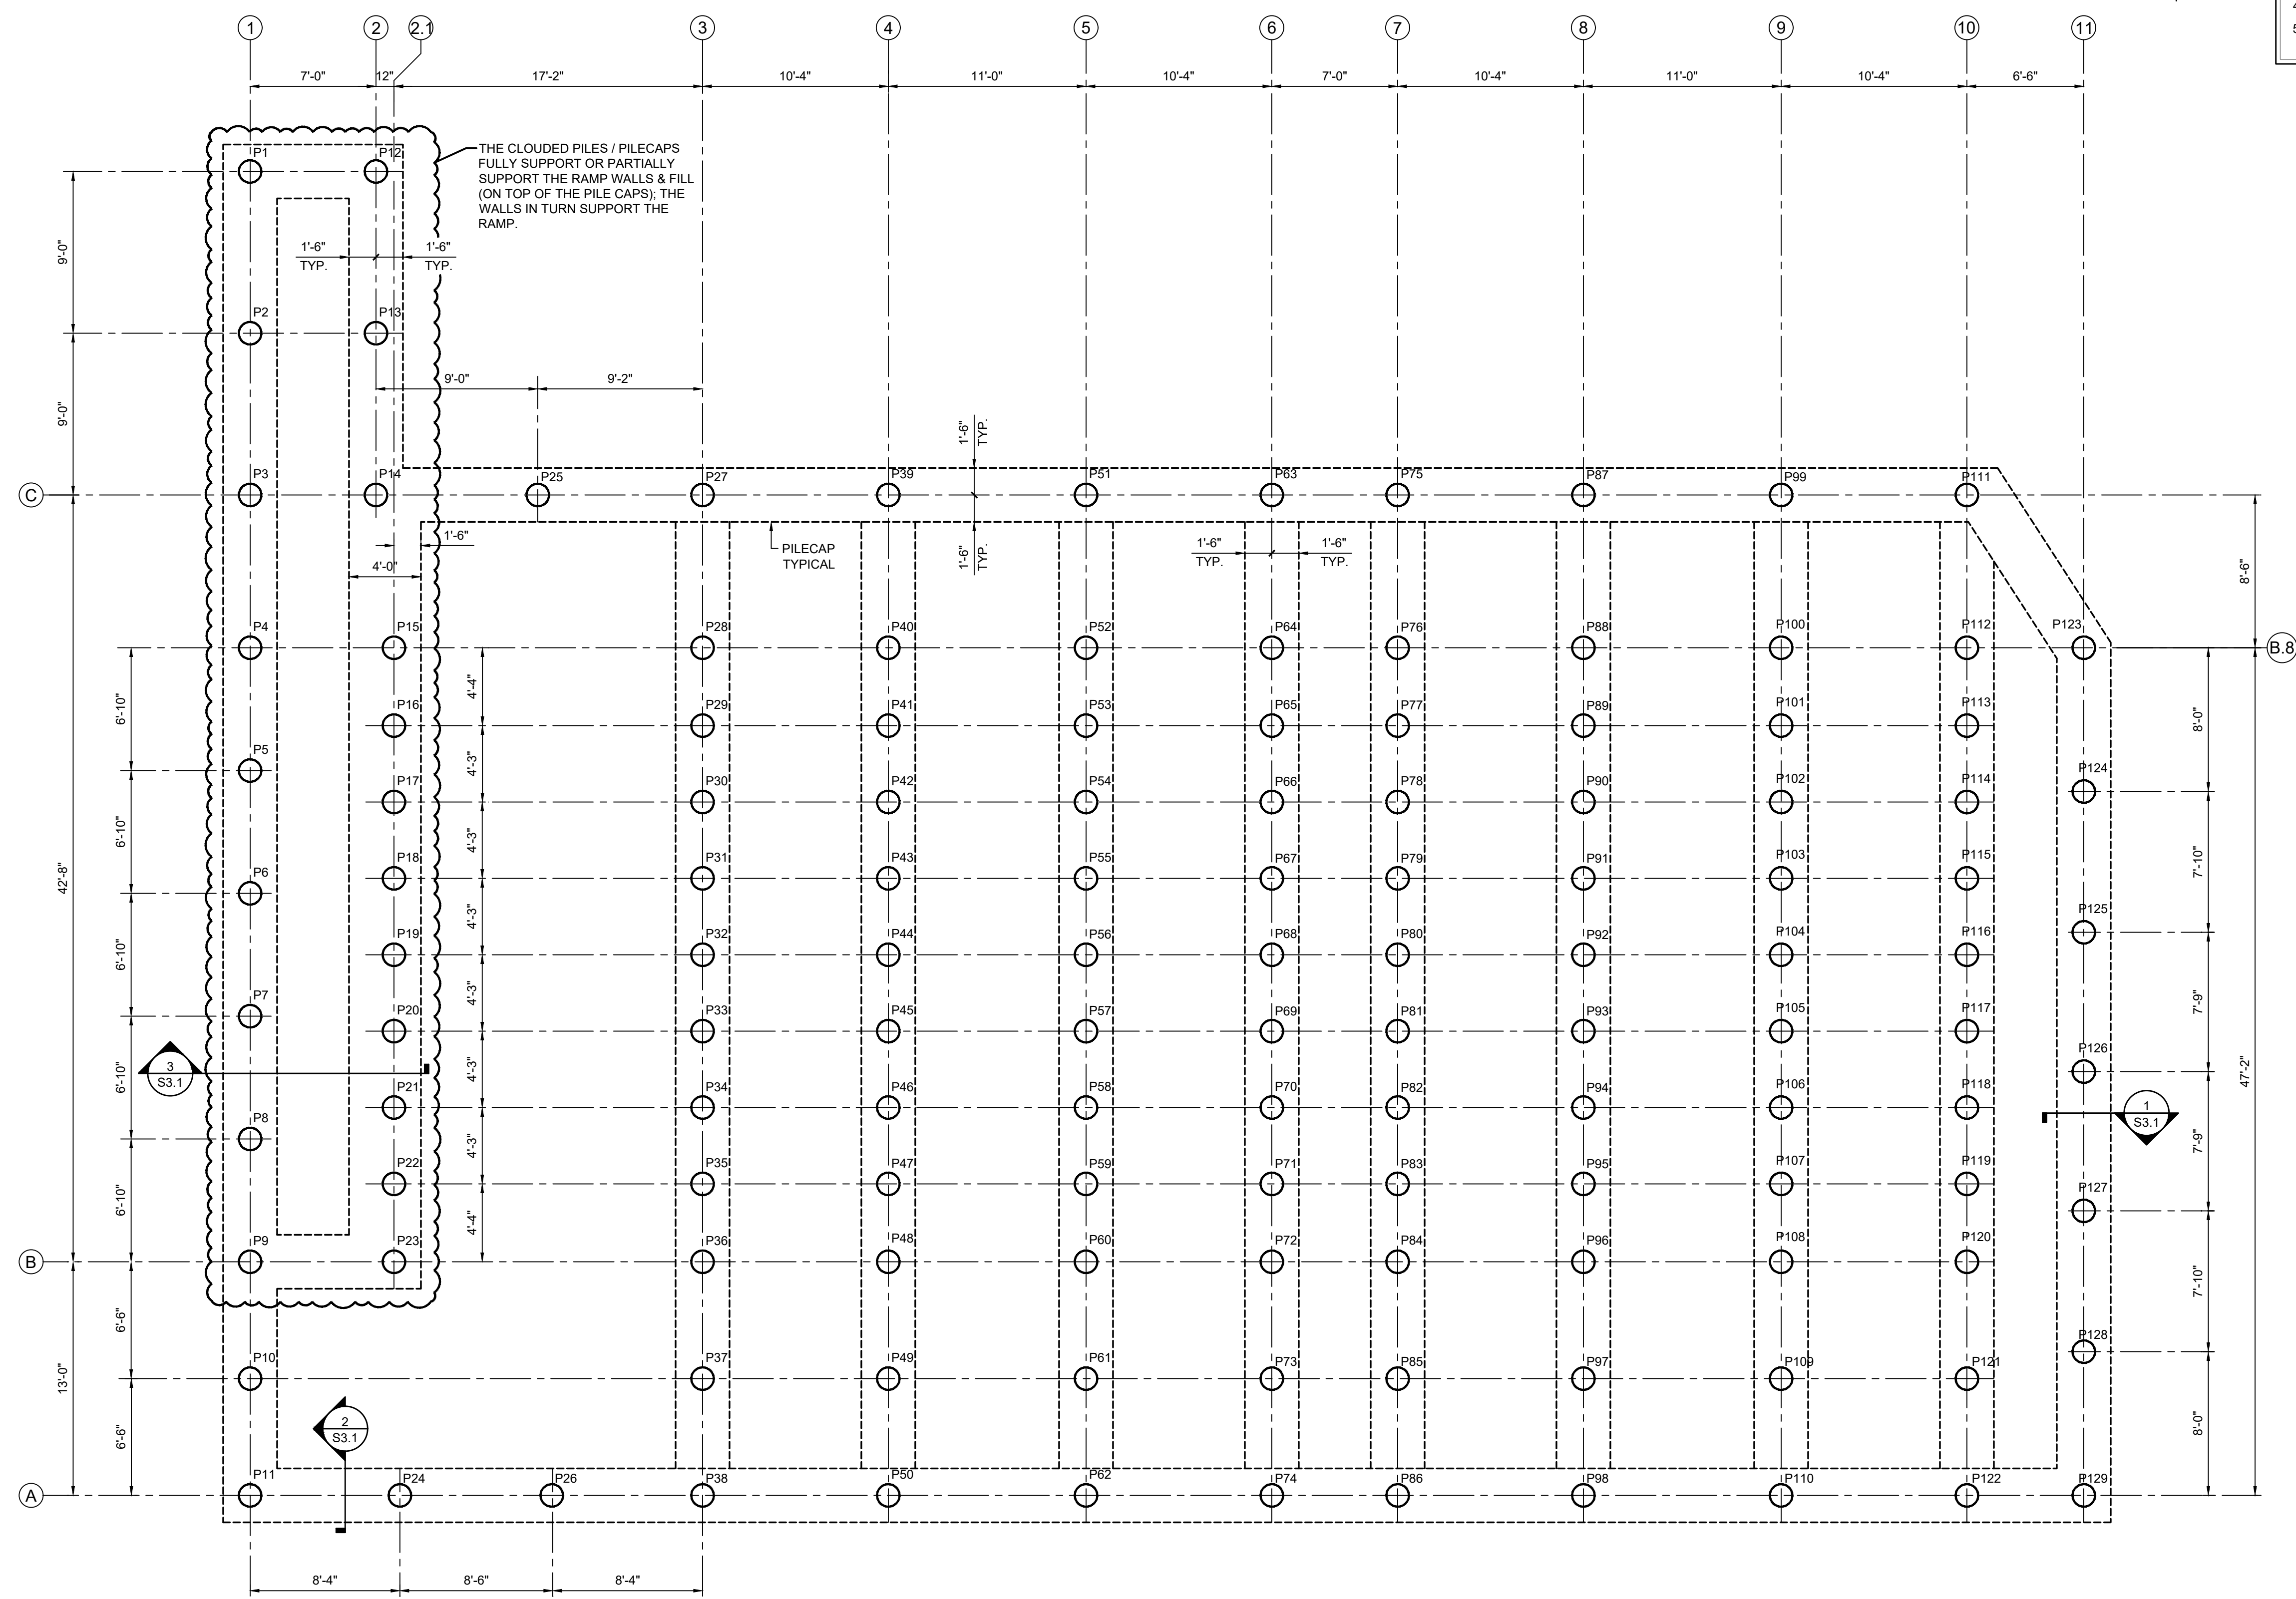

1 PILE LOCATION PLAN
Scale: 3/16" = 1'-0"

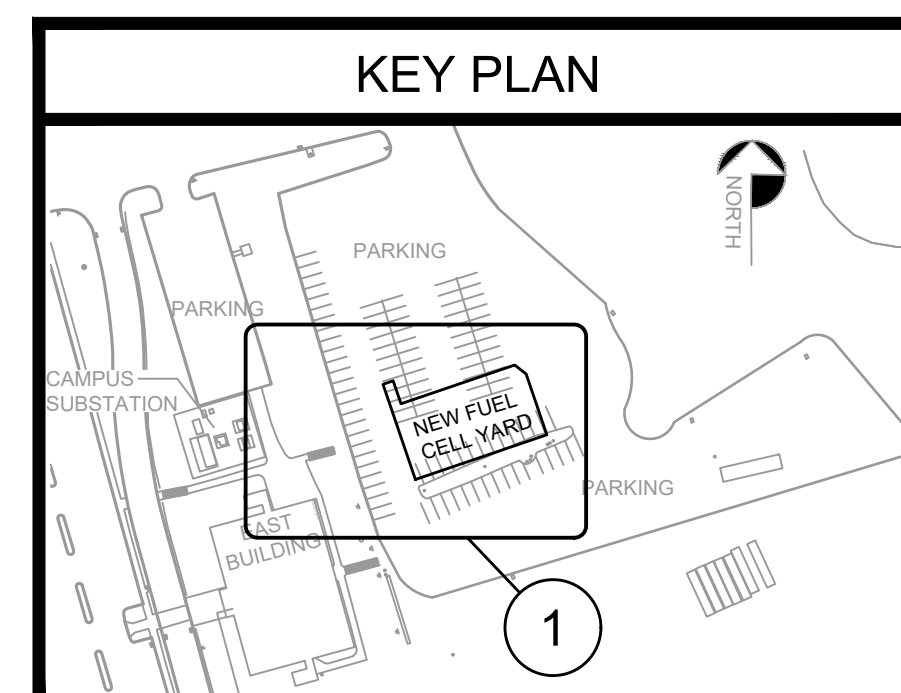

| Rev. | Date | Description |
|------|----------|----------------------------------|
| G | 08/03/23 | UPDATED AS NOTED |
| F | 07/31/23 | UPDATED PER FLOOD COMM. REQUESTS |

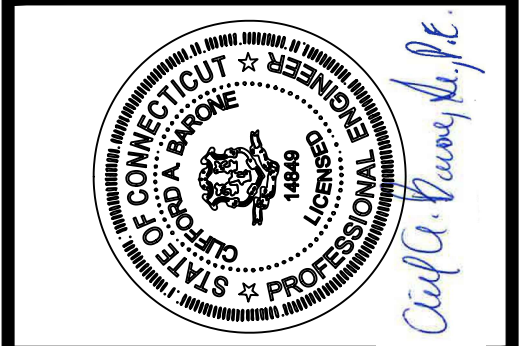



10 White Wood Lane
N. Branford, CT 06471
Phone: (203) 453-8596
Email: info@icdsllc.com

ICDS
Innovative Construction & Design Solutions, LLC

**UNIVERSITY OF HARTFORD
200 BLOOMFIELD AVE, WEST HARTFORD CT
FUEL CELL INSTALLATION
STRUCTURAL
PILE LOCATION PLAN**


| | |
|--------------------|-------------------|
| Project No.: | Drawn By: KFH |
| Date: 07/28 /23 | Design By: CAB |
| Scale: AS NOTED | Check By: DSF |

Drawing No.:
S1.0

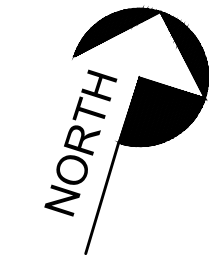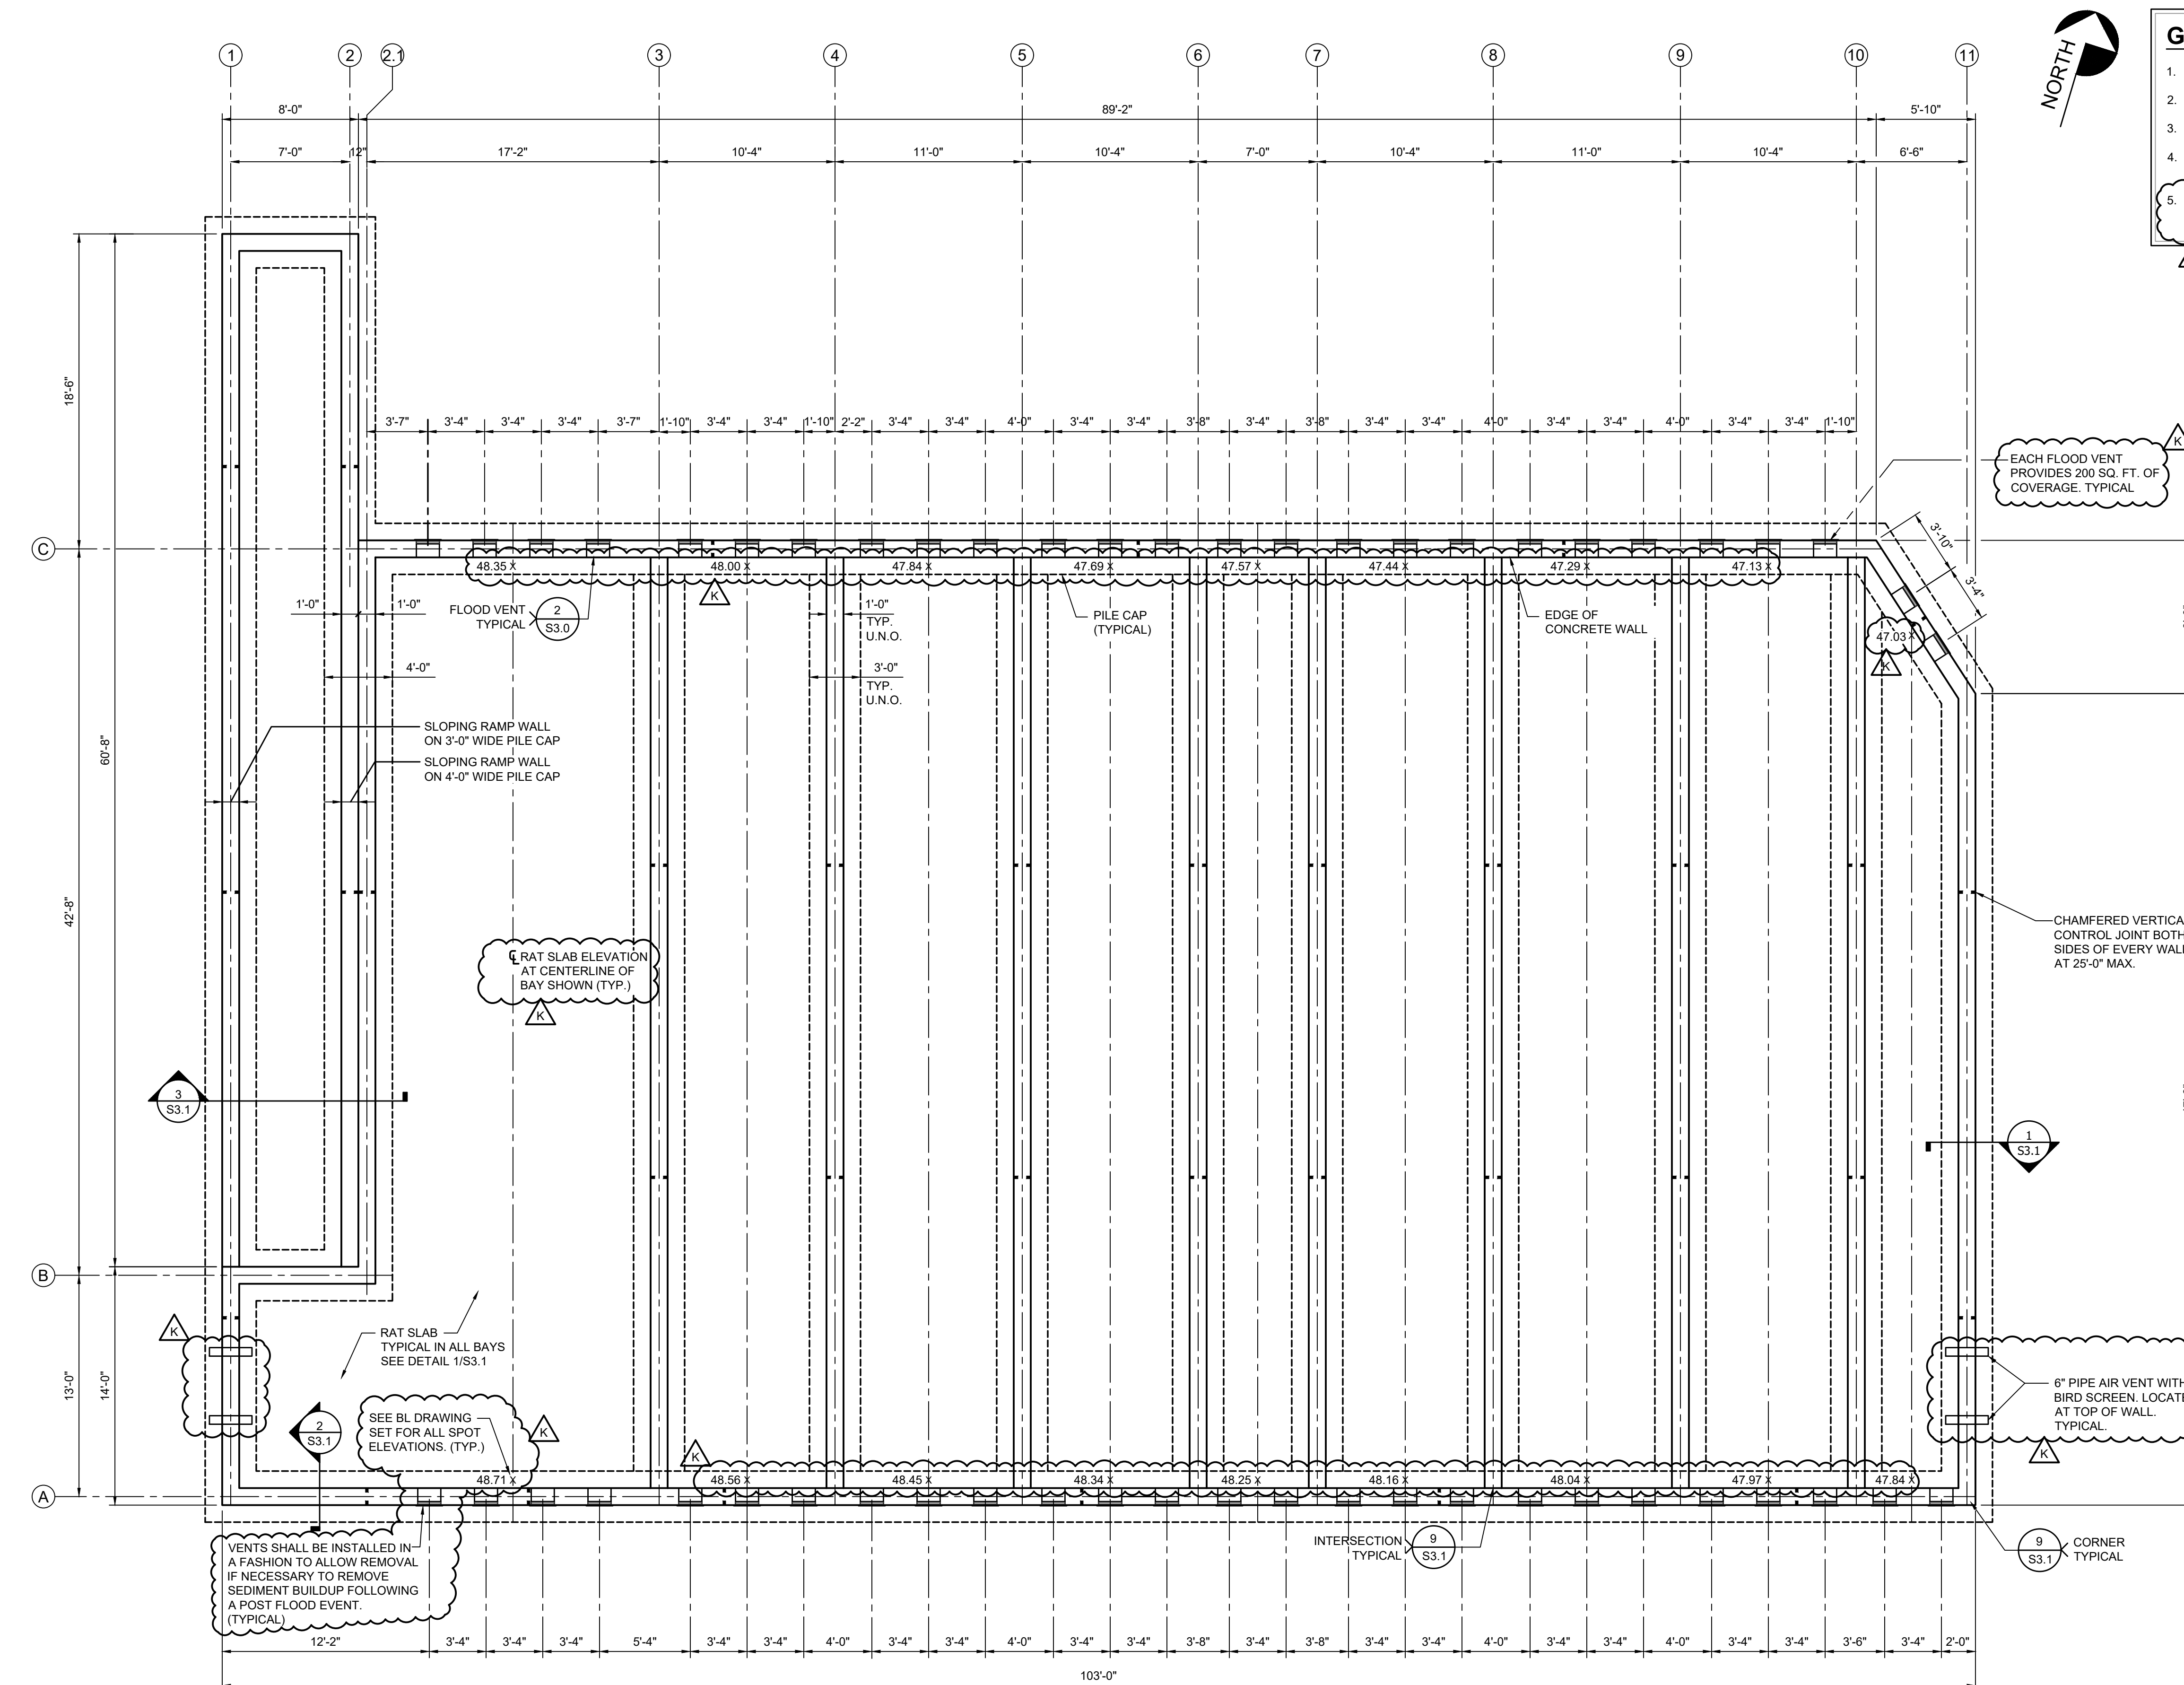


- GENERAL NOTES:**
- FOR ALL NOTES REFER TO DRAWING S0.0
 - REFER TO DRAWING S3.0 & S3.1 FOR SECTIONS AND DETAILS.
 - REFER TO DRAWING S1.2 & S2.0 FOR ELEVATED SLAB & STEEL.
 - REFER TO GENERAL ARRANGEMENT AND ELECTRICAL DRAWINGS FOR ALL UNDERGROUND UTILITY LOCATIONS & GRADE BEAM SLEEVE PENETRATIONS.
 - THE FOUNDATION AND STRUCTURE ARE DESIGNED TO WITHSTAND VELOCITIES AND / OR HYDROSTATIC PRESSURE ASSOCIATED WITH THE BASE FLOOD, INCLUDING THE EFFECT OF BUOYANCY.

1 PILECAP AND CONCRETE WALL PLAN
Scale: 3/16" = 1'-0"

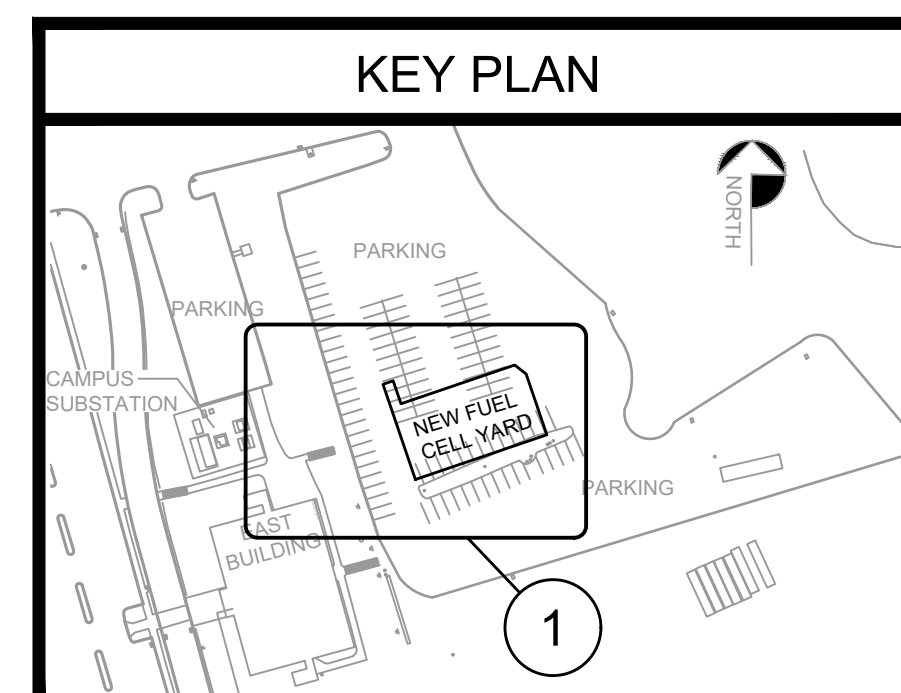

| Rev. | Date | Description |
|------|----------|----------------------------------|
| K | 11/21/23 | UPDATED AS NOTED |
| H | 08/22/23 | UPDATED PER HYAXIOM COMMENTS |
| G | 08/03/23 | UPDATED AS NOTED |
| F | 07/31/23 | UPDATED PER FLOOD COMM. REQUESTS |

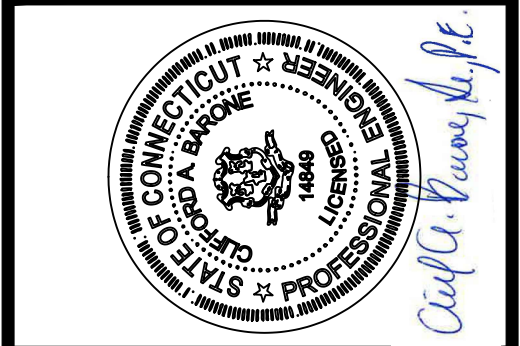

10 White Wood Lane
N. Branford, CT 06471
Phone: (203) 453-8896
Email: info@icdsllc.com


ICDS
Innovative Construction & Design Solutions, LLC

UNIVERSITY OF HARTFORD
200 BLOOMFIELD AVE, WEST HARTFORD CT
FUEL CELL INSTALLATION
STRUCTURAL
PILECAP AND CONCRETE WALL PLAN

| | |
|--------------|------------|
| Project No.: | Drawn By: |
| Date: | Design By: |
| Scale: | Check By: |

Drawing No.:
S1.1

THIS DRAWING MAY NOT BE REPRODUCED IN ANY FORM WITHOUT EXPRESS WRITTEN PERMISSION FROM INNOVATIVE CONSTRUCTION & DESIGN SOLUTIONS, LLC. THE DRAWING CONSTITUTES THE INTELLECTUAL PROPERTY OF INNOVATIVE CONSTRUCTION & DESIGN SOLUTIONS, LLC. © COPYRIGHT 2022, INNOVATIVE CONSTRUCTION & DESIGN SOLUTIONS, LLC.

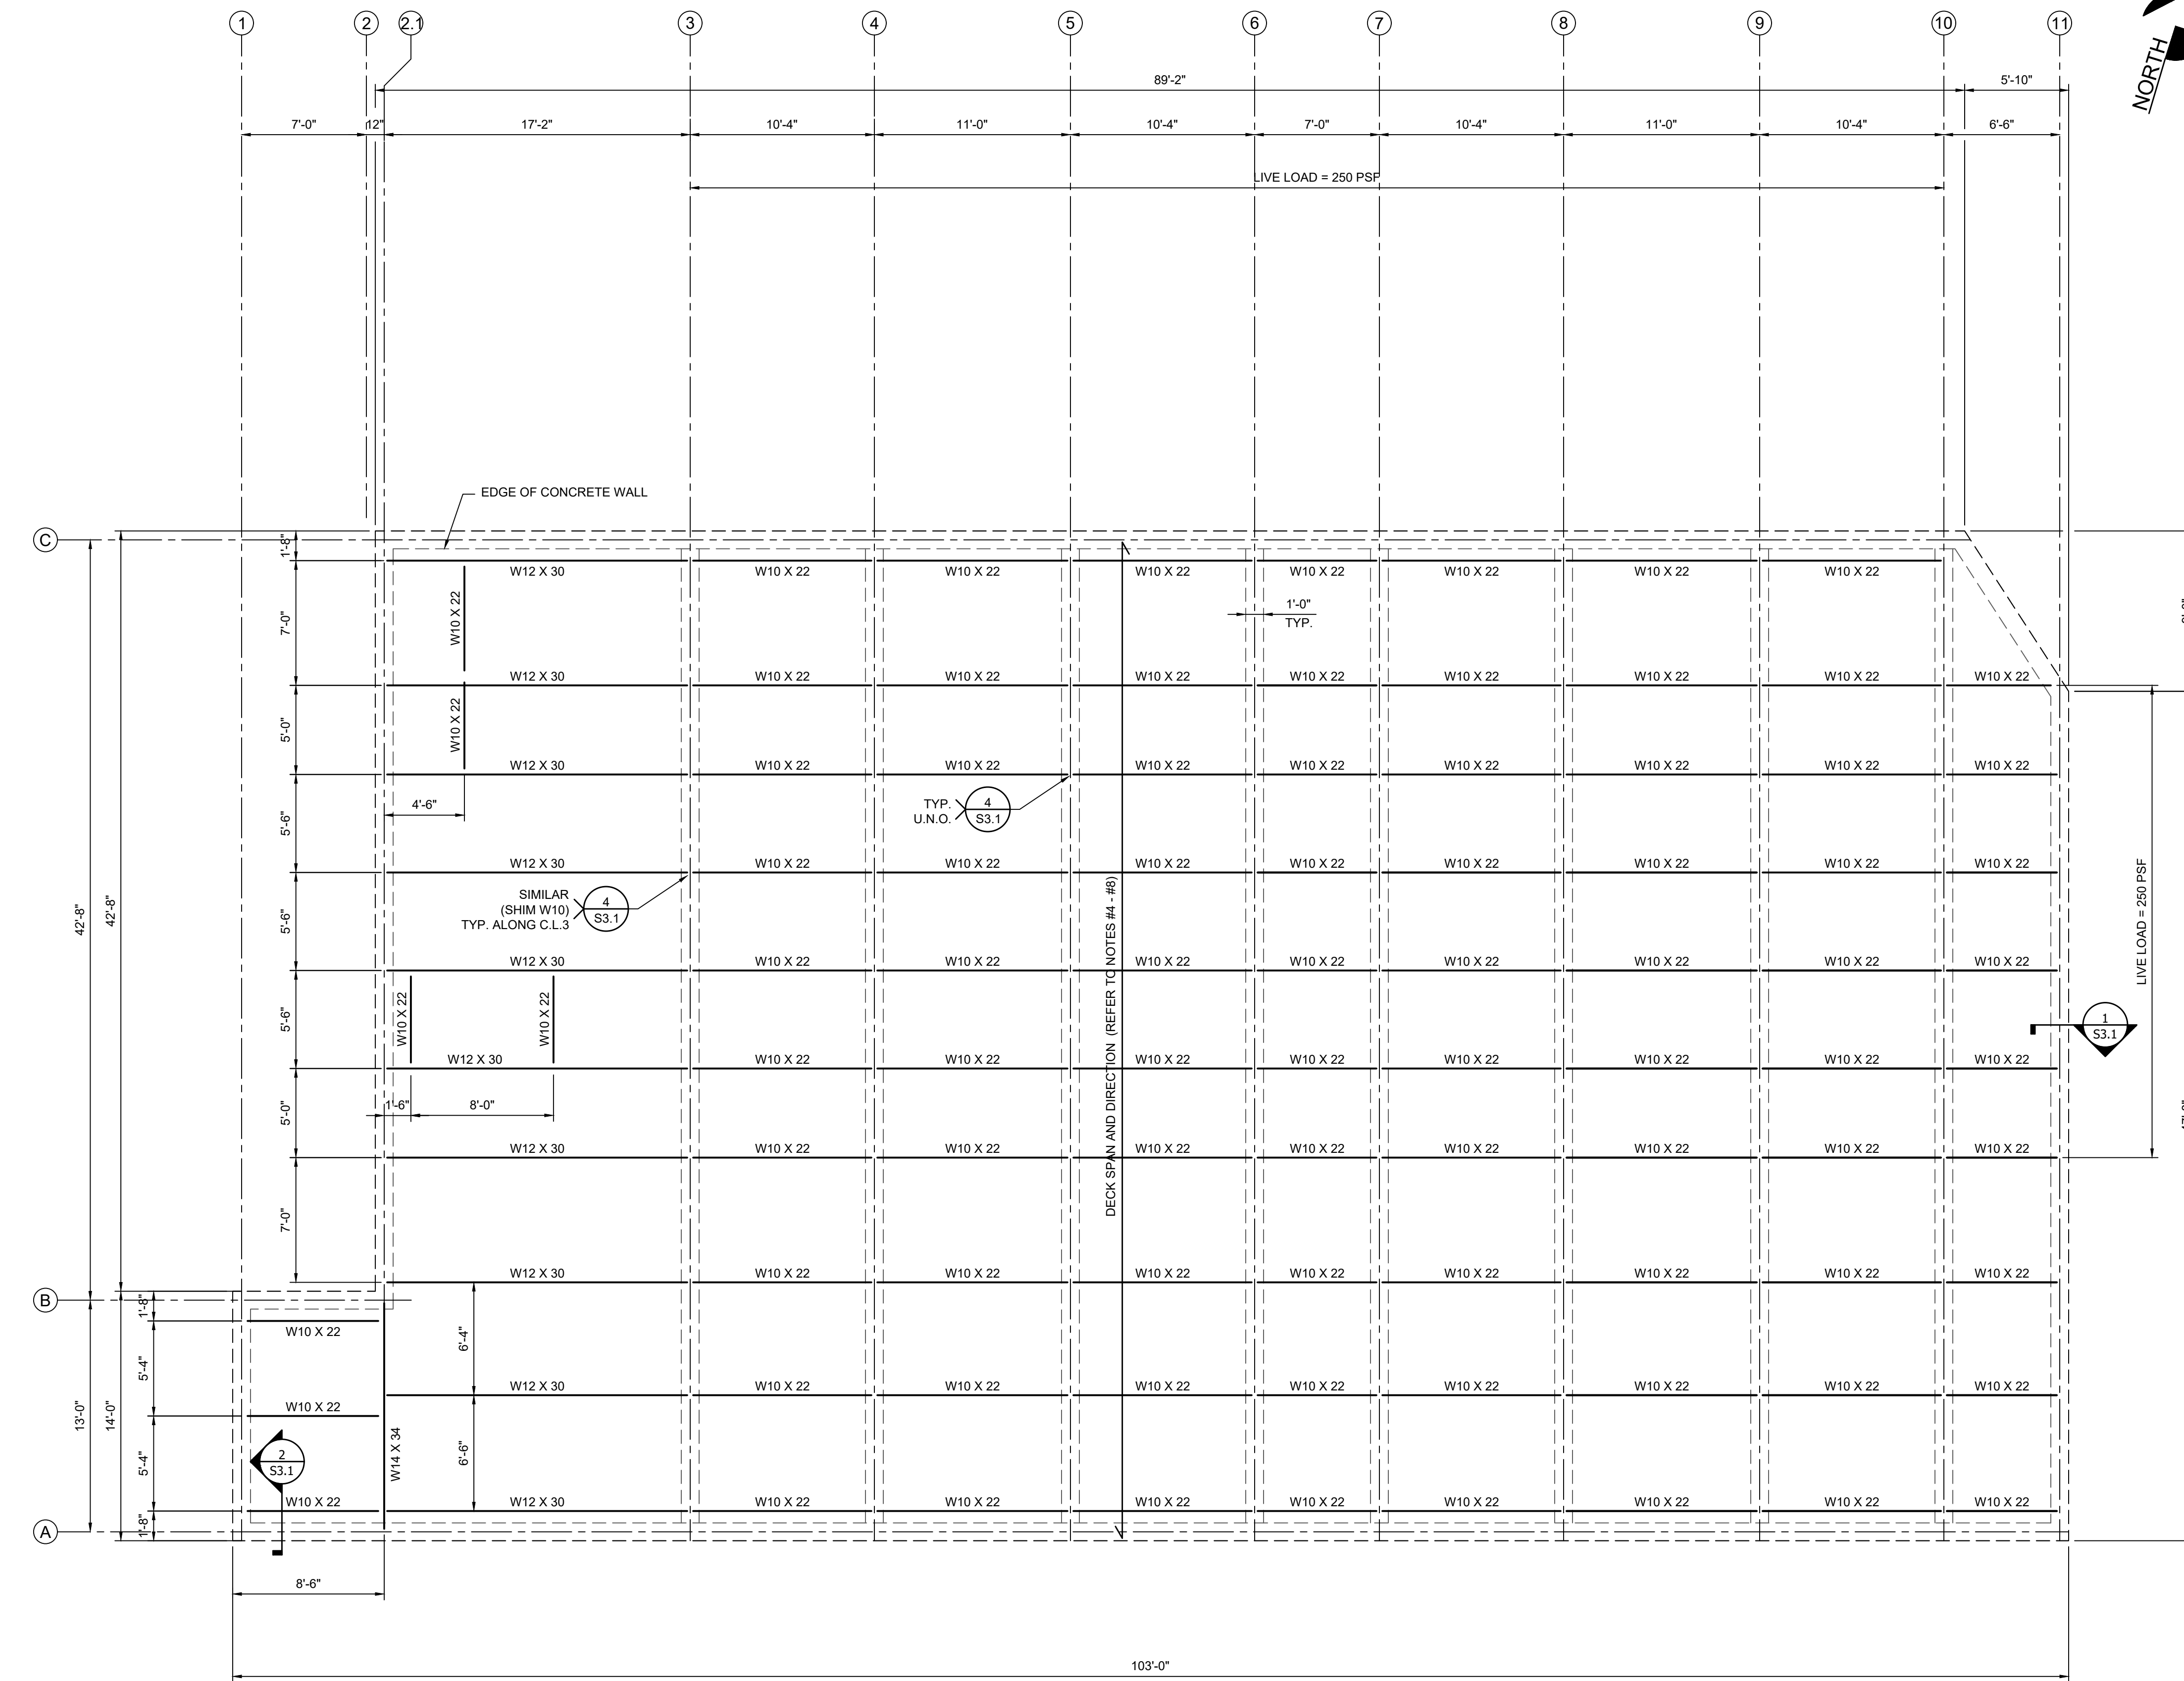

- GENERAL NOTES:**
- FOR GENERAL CONCRETE NOTES REFER TO DRAWING S0.0
 - REFER TO DRAWING S3.0 & S3.1 FOR SECTIONS AND DETAILS.
 - REFER TO GENERAL ARRANGEMENT AND ELECTRICAL DRAWINGS FOR ALL UNDERGROUND UTILITY LOCATIONS & GRADE BEAM SLEEVE PENETRATIONS.
 - METAL FLOOR DECK SHALL BE 1/2" DEEP X 18 GAGE (GALVANIZED), 1.5VLR18 AS MANUFACTURED BY VULCRAFT.
 - DECK SHALL BE WELDED AS PER SDI REQUIREMENTS.
 - ATTACHMENT OF DECK TO SUPPORTING STRUCTURAL MEMBERS SHALL BE AS FOLLOWS:
- 5/8" DIAMETER PUDDLE WELDS AT 12" AT ALL CROSS MEMBERS (MINIMUM 4 PER SHEET, USE WELD PATTERN 36/4).
 - #12 SELF-DRILLING SCREWS AT MID-SPAN OF SIDE JOINTS (3'-0" O/C MAX.), 5/8" DIAMETER PUDDLE WELDS AT 2'-0" AT PERIMETERS. SPLIT OF PARTIAL PANELS SHALL BE ATTACHED TO SUPPORTING MEMBERS AT EACH VALLEY.
 - WELD WASHERS SHALL NOT BE USED FOR DECK WITH THICKNESS GREATER THAN 22 GAGE.
 - DESIGN OF DECK IS BASED ON UNSHORED CONDITIONS.
 - STEEL SHALL BE GALVANIZED. STEEL TO BE PAINTED WHERE FIELD WELDED.
 - THE FOUNDATION AND STRUCTURE ARE DESIGNED TO WITHSTAND VELOCITIES AND / OR HYDROSTATIC PRESSURE ASSOCIATED WITH THE BASE FLOOD, INCLUDING THE EFFECT OF BUOYANCY.

| Rev. | Date | Description |
|------|----------|----------------------------------|
| K | 11/21/23 | UPDATED AS NOTED |
| I | 09/15/23 | REVISED AS NOTED |
| H | 08/22/23 | UPDATED PER HYAXIOM COMMENTS |
| F | 07/31/23 | UPDATED PER FLOOD COMM. REQUESTS |




10 White Wood Lane
N. Branford, CT 06471
Phone: (203) 453-8896
Email: info@icdsllc.com
Website: www.icdsllc.com

ICDS
Innovative Construction & Design Solutions, LLC


**UNIVERSITY OF HARTFORD
200 BLOOMFIELD AVE, WEST HARTFORD CT
FUEL CELL INSTALLATION
STRUCTURAL
STEEL FRAMING PLAN**

1 STEEL FRAMING PLAN (T.O.S. - 9" FR. H.P. T/CONC.)
DEAD LOAD = 130 PSF Scale: 3/16" = 1'-0"
LIVE LOAD = 150 PSF (U.N.O.)

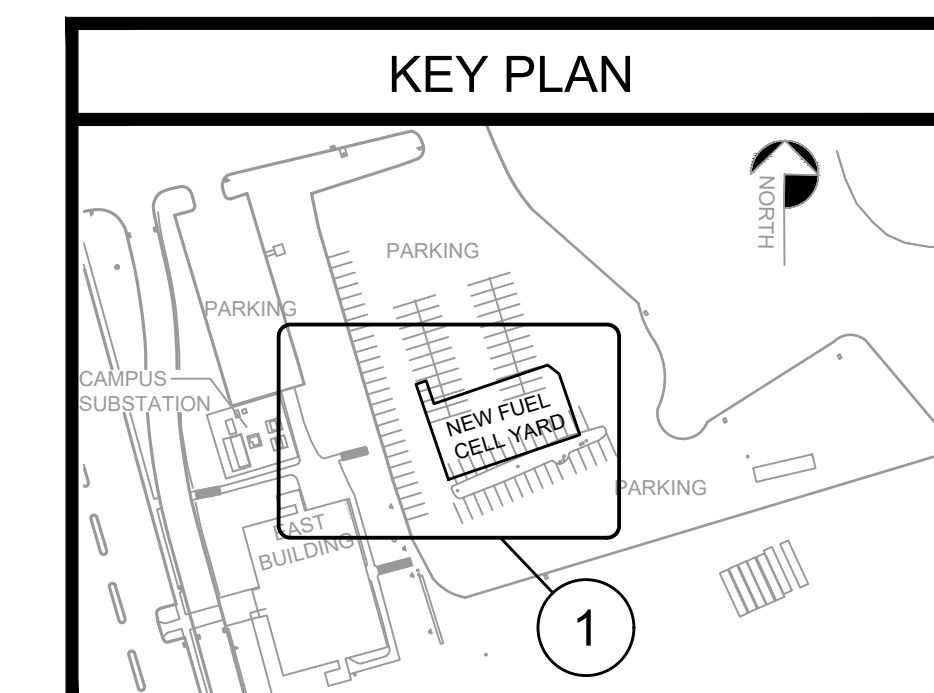


| | |
|--------------------|-------------------|
| Project No.: | Drawn By: KFH |
| Date: 07/28/23 | Design By: CAB |
| Scale: AS NOTED | Check By: DSF |


Drawing No.:
S2.0

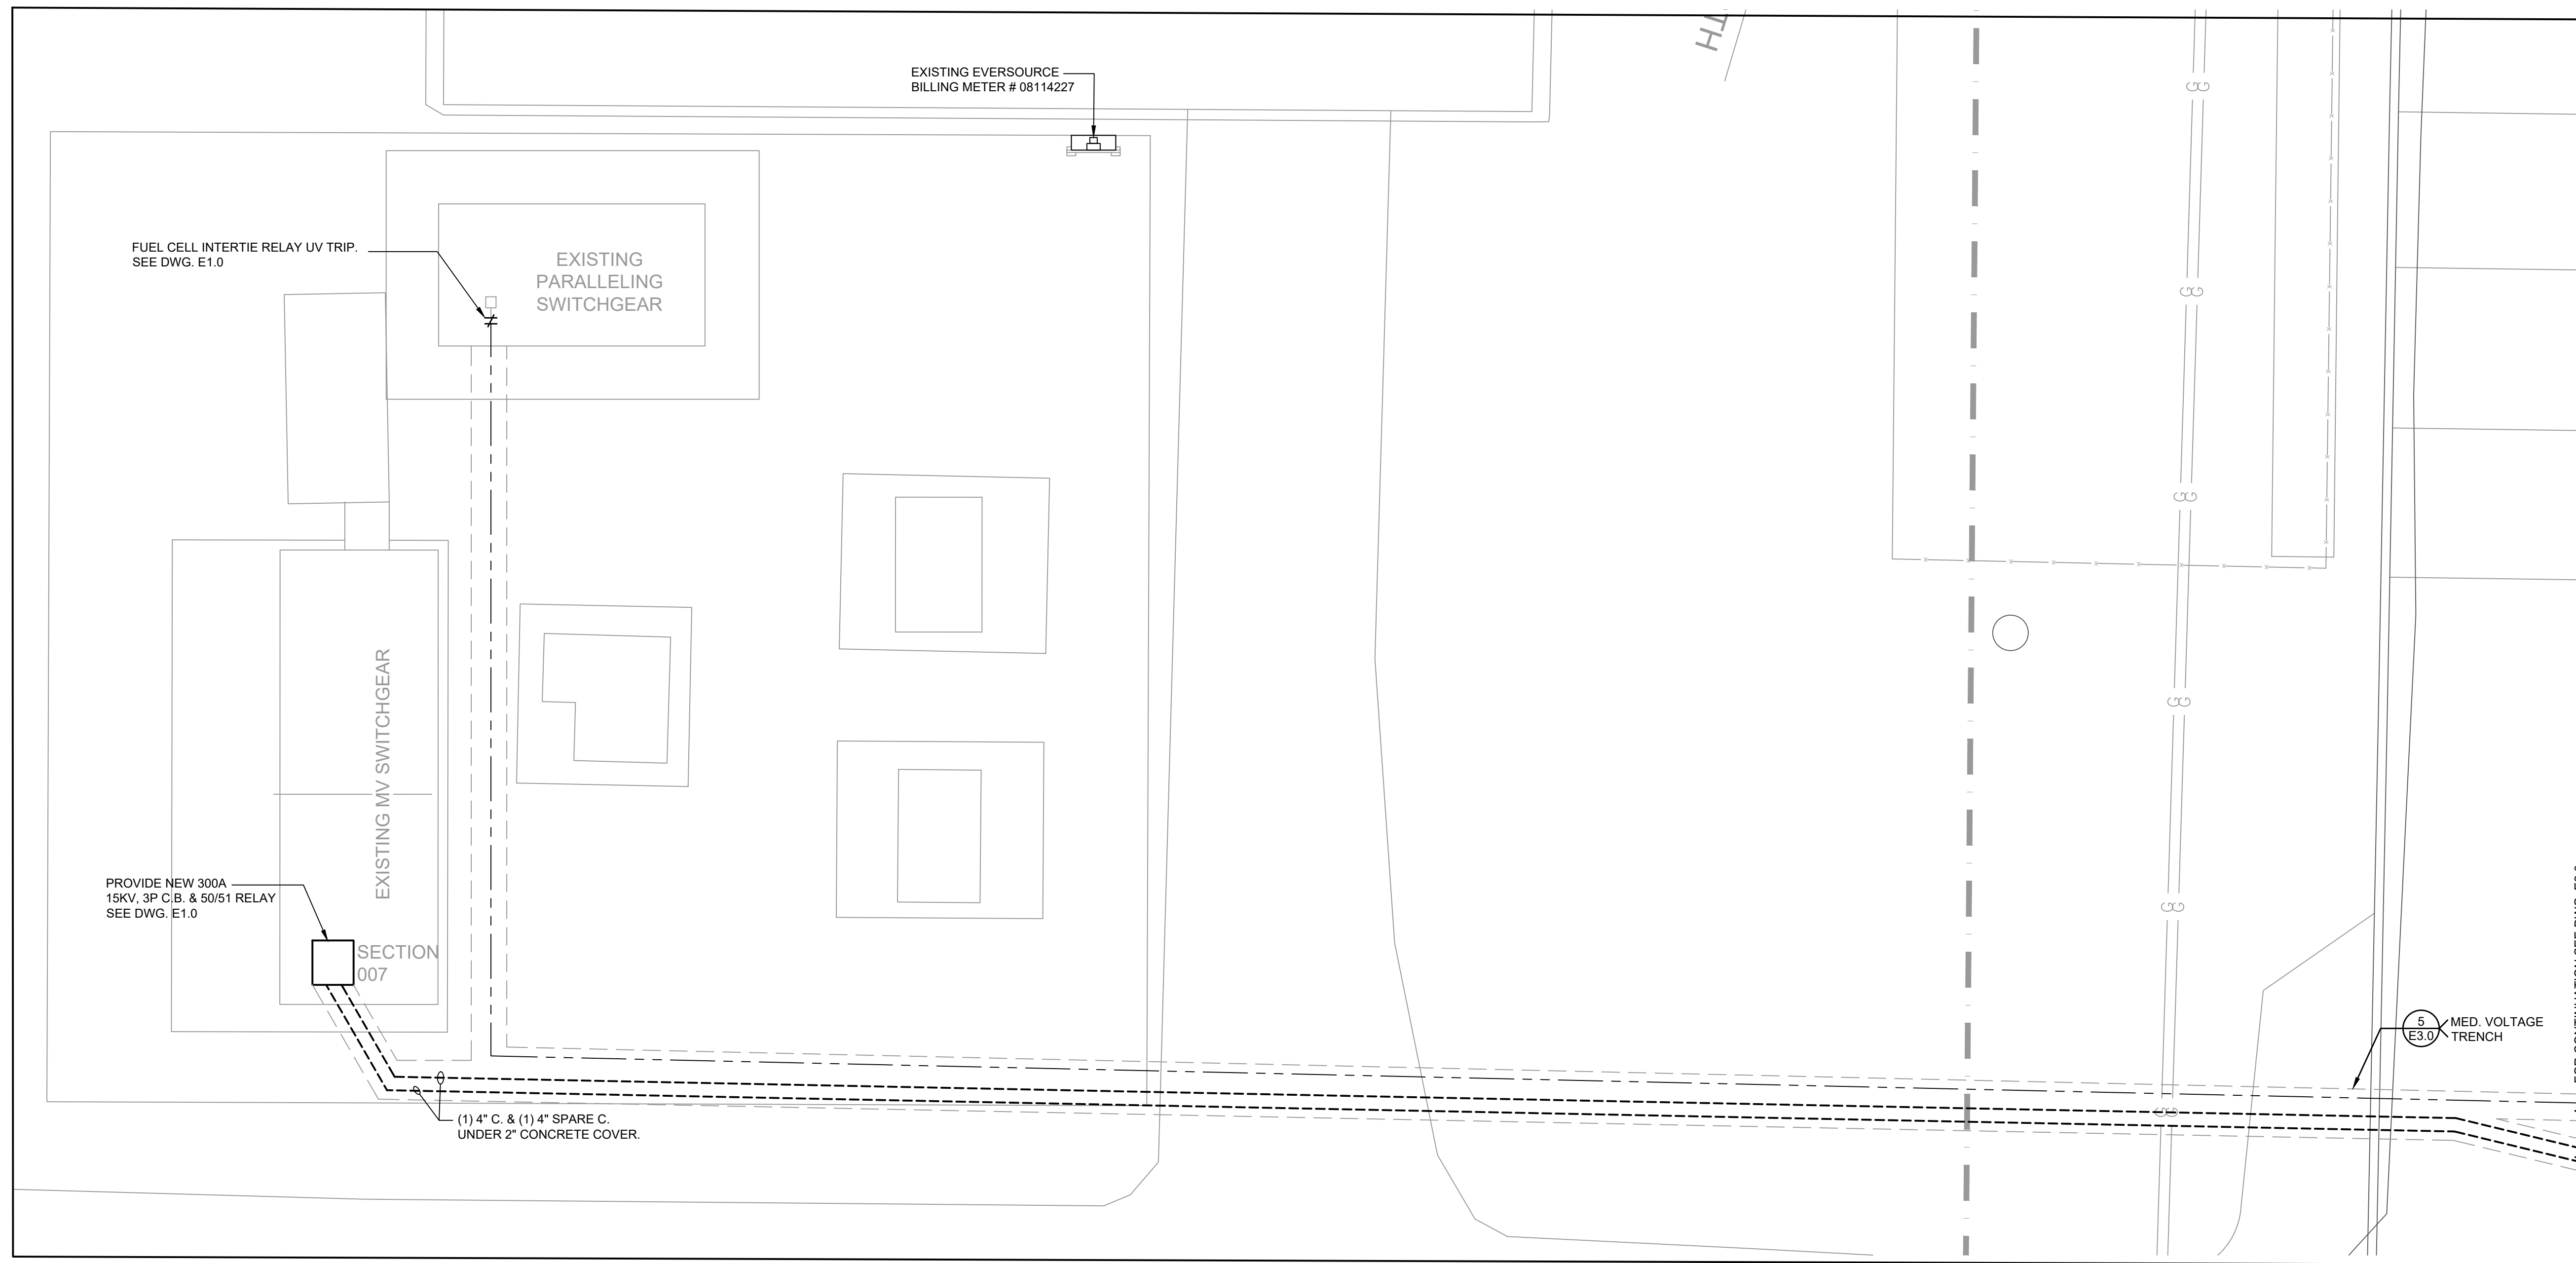


1 ELECTRICAL PARTIAL PLAN
Scale: 3/16" = 1'-0"

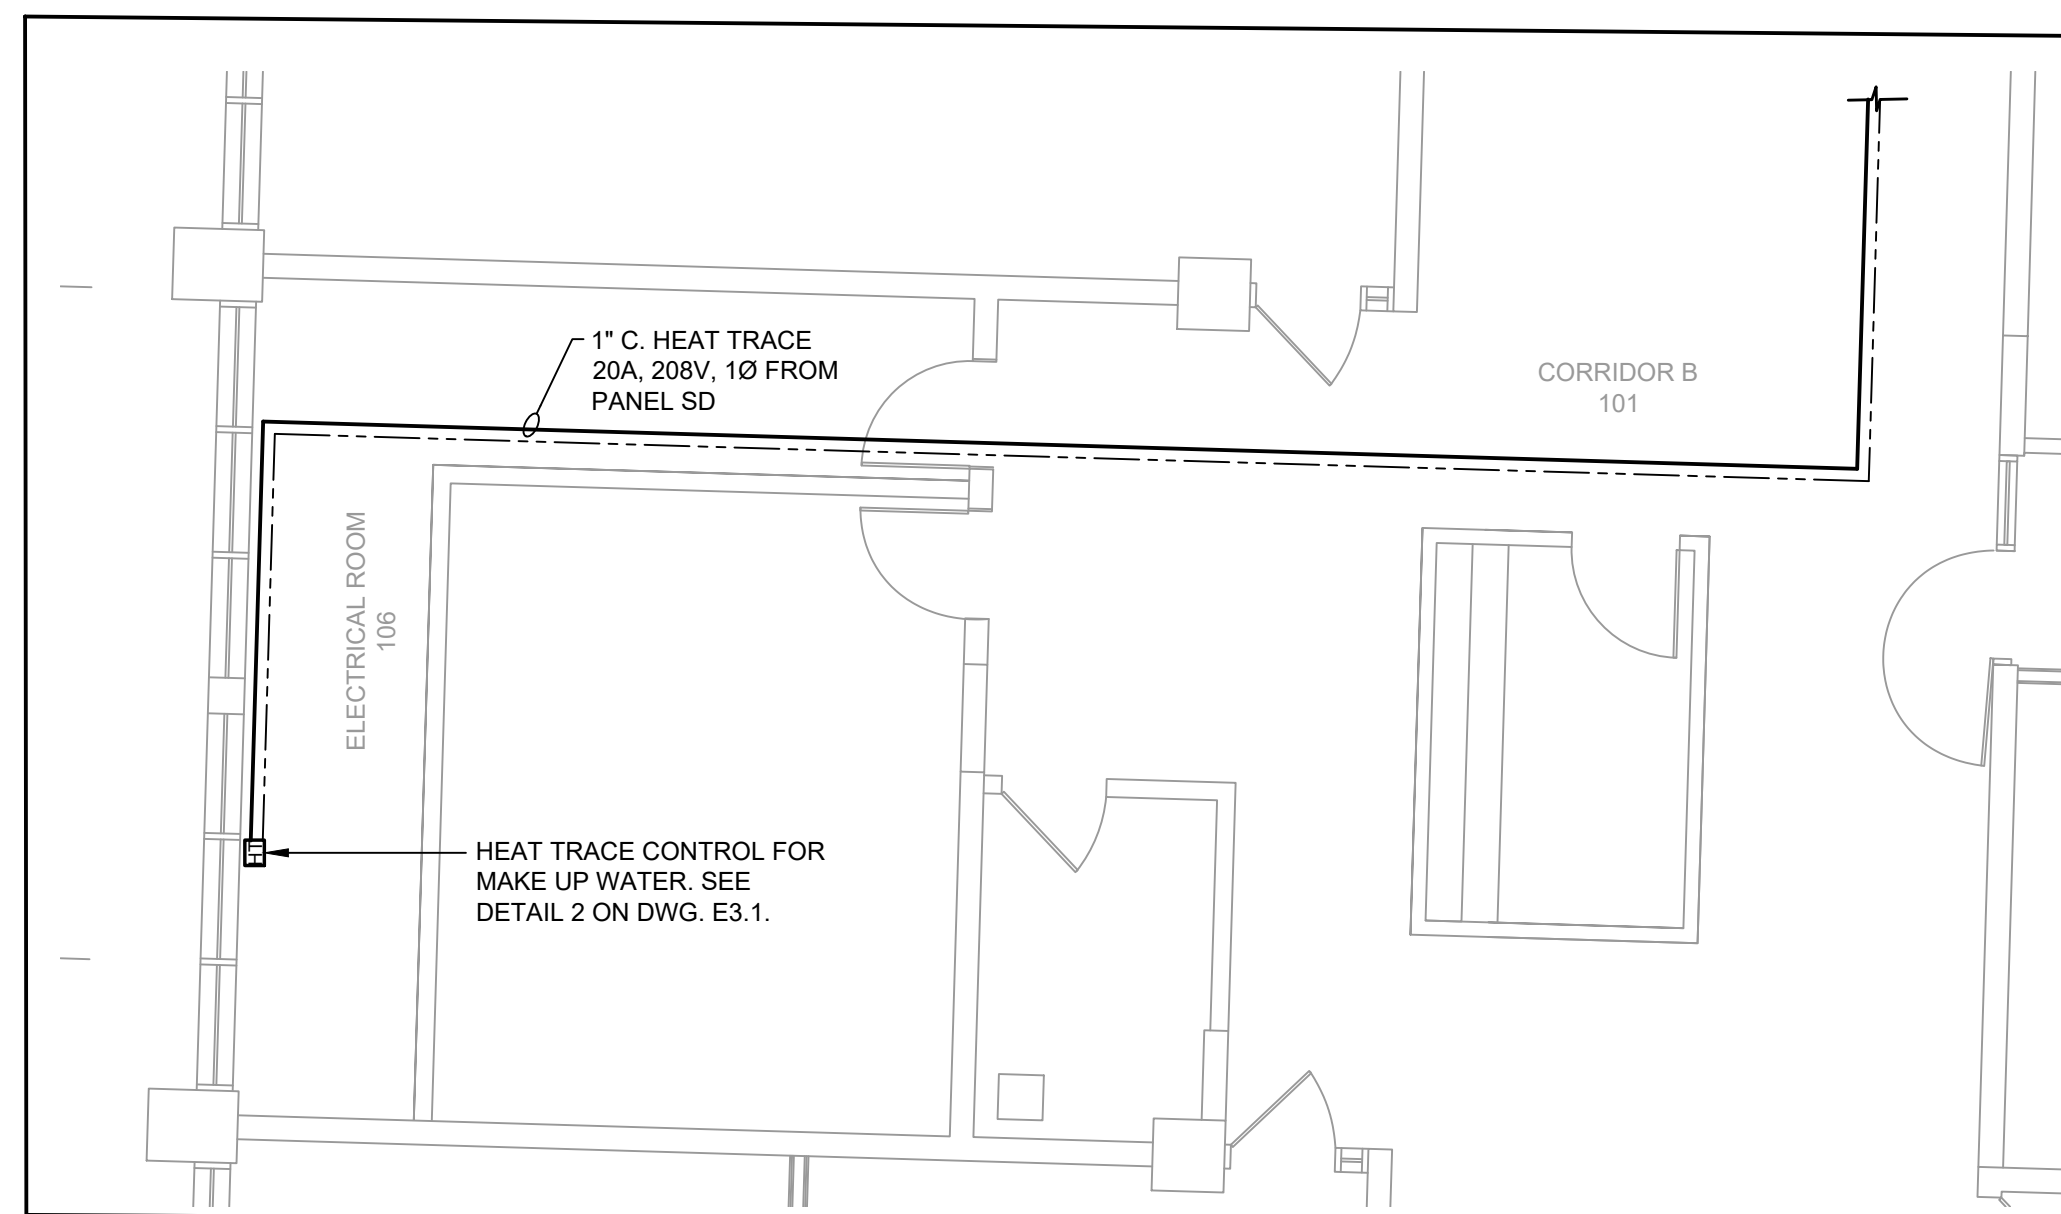


3 ELECTRICAL PARTIAL PLAN
Scale: 3/16" = 1'-0"

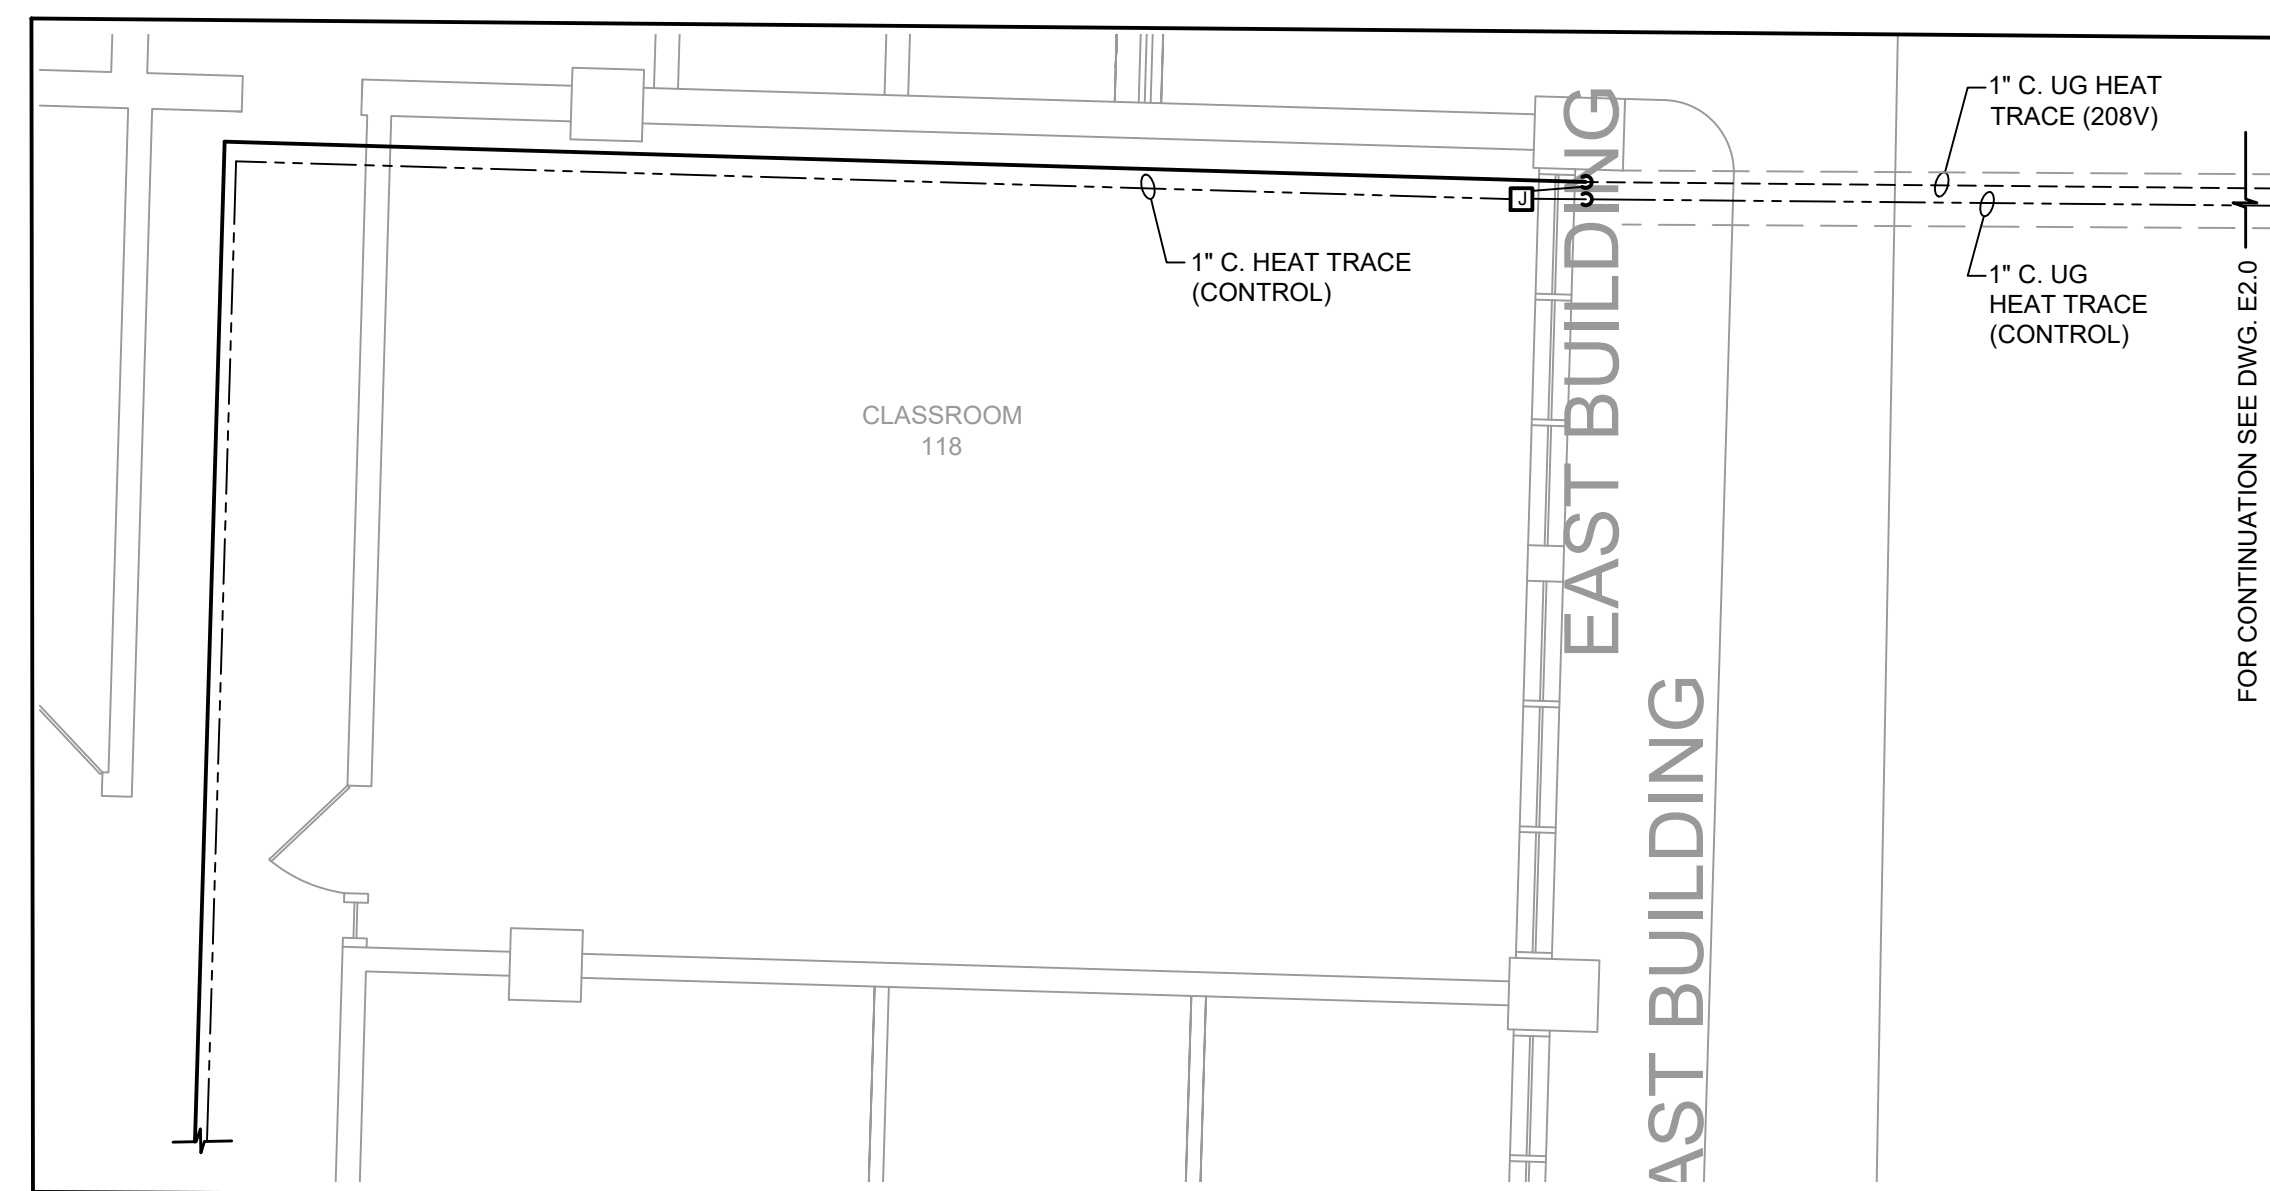

2 ELECTRICAL PARTIAL PLAN
Scale: 3/16" = 1'-0"

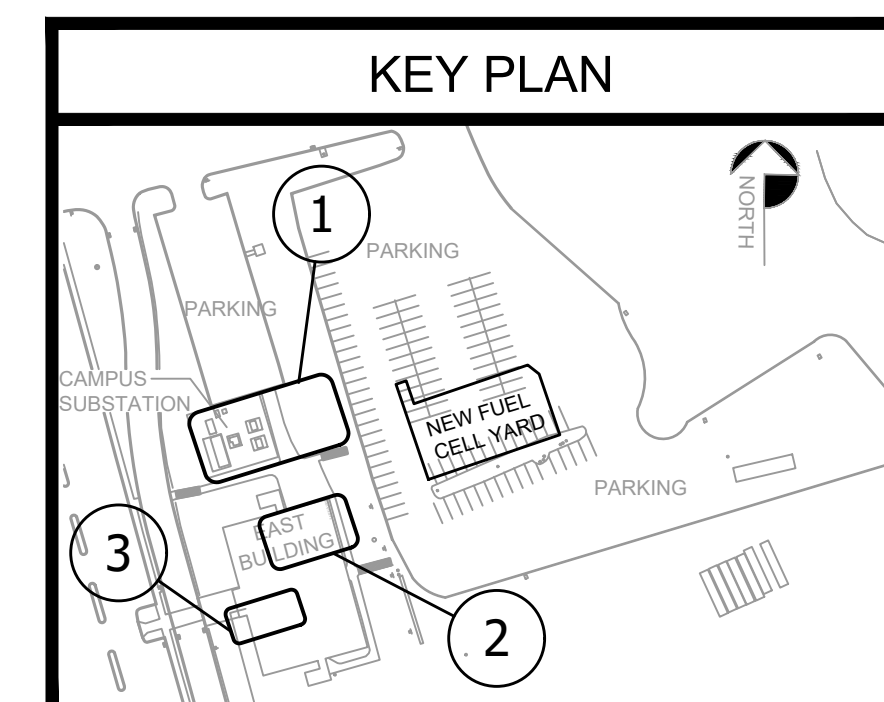

| Rev. | Date | Description |
|------|----------|----------------------------------|
| G | 08/03/23 | UPDATED AS NOTED |
| F | 07/31/23 | UPDATED PER FLOOD COMM. REQUESTS |
| D | 01/02/23 | UPDATED EVERSOURCE CKT. NAMES |
| C | 10/06/22 | REISSUED FOR CONSTRUCTION |
| B | 09/26/22 | ISSUED FOR CONSTRUCTION |
| A | 07/07/22 | PRELIMINARY ISSUE |

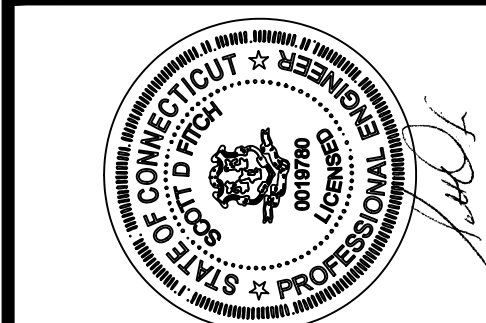

10 White Wood Lane
N. Branford, CT 06471
Phone: (203) 453-8596
Email: info@icdsllc.com

ICDS
Innovative Construction & Design Solutions, LLC

UNIVERSITY OF HARTFORD
200 BLOOMFIELD AVE, WEST HARTFORD CT
FUEL CELL INSTALLATION
ELECTRICAL PARTIAL PLAN

| | |
|-------------------|-------------------|
| Project No.: | Drawn By: KFH |
| Date: 07/08/22 | Design By: DSF |
| Scale: NTS | Check By: DSF |

Drawing No.:
E2.1

© COPYRIGHT 2022, INNOVATIVE CONSTRUCTION & DESIGN SOLUTIONS, LLC. THESE DRAWINGS MAY NOT BE REPRODUCED IN ANY FORM WITHOUT EXPRESS WRITTEN PERMISSION FROM INNOVATIVE CONSTRUCTION & DESIGN SOLUTIONS, LLC. THESE DRAWINGS CONSTITUTE THE INTELLECTUAL PROPERTY OF INNOVATIVE CONSTRUCTION & DESIGN SOLUTIONS, LLC. PLEASE OBTAIN THE NEAREST REPRODUCTION THROUGH OUR WEBSITE OR BY REQUEST.

BASIC ELECTRICAL REQUIREMENTS

A. NOTES

1. DRAWINGS AND GENERAL PROVISIONS OF CONTRACT, INCLUDING GENERAL AND SUPPLEMENTARY CONDITIONS AND ALL OTHER SPECIFICATION SECTIONS, APPLY TO THIS SECTION.

2. THE CONTRACTOR FOR THIS WORK IS REQUIRED TO READ THE SPECIFICATIONS AND REVIEW DRAWINGS FOR ALL DIVISIONS OF WORK AND IS RESPONSIBLE FOR THE COORDINATION OF THIS WORK AND THE WORK OF ALL DIVISIONS. IT IS THIS CONTRACTOR'S RESPONSIBILITY TO PROVIDE SUBCONTRACTORS WITH A COMPLETE SET OF BID DOCUMENTS.

3. THE CONTRACTOR IS RESPONSIBLE FOR SCHEDULING THE COMPLETION AND INSPECTION OF THIS WORK AND THE SUBCONTRACTORS WORK TO COMPLY WITH OWNER'S SCHEDULE AND THE PROJECT COMPLETION DATE.

4. THE CONTRACTOR SHALL VISIT THE SITE PRIOR TO SUBMITTAL OF BID TO DETERMINE CONDITIONS AFFECTING THE WORK. ANY ITEMS WHICH ARE NOT COVERED IN THE BID DOCUMENTS OR ANY PROPOSED SUBSTITUTIONS SHALL BE LISTED SEPARATELY AND QUALIFIED IN THE CONTRACTOR'S BID. SUBMITTAL OF BID SHALL SERVE AS EVIDENCE OF KNOWLEDGE OF EXISTING CONDITIONS AND ANY MODIFICATIONS WHICH ARE REQUIRED TO MEET THE INTENT OF THE DRAWINGS AND SPECIFICATIONS. FAILURE TO VISIT THE SITE DOES NOT RELIEVE THE CONTRACTOR OF RESPONSIBILITY IN PERFORMANCE OF WORK.

B. GENERAL REQUIREMENTS

1. THE CONTRACTOR SHALL PROVIDE ALL LABOR, MATERIALS, EQUIPMENT, SERVICES, TOOLS, TRANSPORTATION, INCIDENTALS AND DETAILS NECESSARY TO PROVIDE COMPLETE ELECTRICAL SYSTEMS AS SHOWN ON THE DRAWINGS, CALLED FOR IN THE SPECIFICATIONS, AND AS REQUIRED BY JOB CONDITIONS. ALL WORK NOT SPECIFICALLY NOTED AS BEING BY POWER COMPANY SHALL BE PROVIDED BY THE ELECTRICAL CONTRACTOR. CLOSELY COORDINATE THE ENTIRE INSTALLATION WITH THE POWER COMPANY AND WITH DOOSAN AS REQUIRED. FURNISH AND INSTALL EQUIPMENT THAT IS RATED FOR AVAILABLE FAULT CURRENT LEVELS. FURNISH AND INSTALL "CABLE LIMITERS" IF NECESSARY TO LIMIT FAULT CURRENT. FIELD VERIFY THE EXACT TYPE, SIZE, LOCATION, REQUIREMENTS, ETC. OF EXISTING POWER AND TELEPHONE FACILITIES PRIOR TO SUBMISSION OF BID.

2. ALL MATERIALS, PRODUCTS, AND EQUIPMENT, INCLUDING ALL COMPONENTS THEREOF, SHALL BE NEW, RECONDITIONED OR RE-CERTIFIED EQUIPMENT SHALL NOT BE USED UNLESS SPECIFICALLY APPROVED BY DOOSAN. EQUIPMENT SHALL BE UNDERWRITERS LABORATORIES LISTED FOR ITS APPLICATION, AND BEAR THE UL LABEL. EQUIPMENT SHALL BE SIZED IN CONFORMITY WITH REQUIREMENTS OF THE NATIONAL ELECTRICAL CODE, STATE AND LOCAL CODES, WHICHEVER IS MORE STRINGENT.

3. THE DRAWINGS AND SPECIFICATIONS ARE INTENDED TO SUPPLEMENT EACH OTHER AND ANY MATERIAL OR LABOR CALLED FOR IN ONE SHALL BE PROVIDED EVEN THOUGH NOT SPECIFICALLY MENTIONED IN BOTH. ANY MATERIAL OR LABOR WHICH IS NEITHER SHOWN ON THE DRAWINGS NOR CALLED FOR IN THE SPECIFICATIONS, BUT WHICH IS OBVIOUSLY NECESSARY TO COMPLETE THE WORK OR WHICH IS USUALLY INCLUDED IN WORK OF SIMILAR CHARACTER, SHALL BE PROVIDED AS PART OF CONTRACT.

4. WHERE THE DRAWINGS OR SPECIFICATIONS CALL FOR ITEMS WHICH EXCEED CODES, THE CONTRACTOR IS RESPONSIBLE FOR FURNISHING AND INSTALLING THE SYSTEM WITH THE MORE STRINGENT REQUIREMENTS AS DESIGNED AND DESCRIBED ON THESE DRAWINGS, UNLESS NOTED OTHERWISE.

5. ALL ELECTRICAL WORK SHALL BE INSTALLED SO AS TO BE READILY ACCESSIBLE FOR OPERATING, SERVICING AND REPAIRING. THIS CONTRACTOR IS RESPONSIBLE FOR PROVIDING SUFFICIENT SERVICE ACCESS TO ALL EQUIPMENT.

6. THE CONTRACTOR SHALL DO ALL CUTTING, CHASING, OR CHANNELING AND PATCHING REQUIRED FOR ANY WORK UNDER THIS DIVISION. ALL CUTTING SHALL HAVE PRIOR APPROVAL BY THE OWNER. ALL PATCHING IS TO MATCH SURROUNDING SURFACES.

7. EXISTING MANHOLE MAY HAVE STANDING WATER. PLAN ON PUMPING OUR THE WATER AS NECESSARY. COMPLY WITH APPLICABLE OSHA SAFETY REQUIREMENTS FOR WORKING IN A MANHOLE.

8. EXCAVATION: COORDINATE WITH EXISTING UNDERGROUND INSTALLATION. USE SERVICES OF CALL BEFORE YOU DIG OR SIMILAR. EXCAVATE WITH CARE AND BY HAND WHERE NECESSARY, ESPECIALLY EXCAVATING NEAR ELECTRICAL LINES AND GAS PIPING.

9. THE CONTRACTOR SHALL MAKE ALL FINAL ELECTRICAL CONNECTIONS AS REQUIRED FOR A COMPLETE AND OPERATING SYSTEM.

C. TEMPORARY LIGHT AND POWER

1. THE CONTRACTOR SHALL FURNISH AND INSTALL ALL TEMPORARY WIRING AND RELATED GROUND FAULT INTERRUPTION PROTECTION FOR LIGHT AND FOR ALL CONTRACTORS POWER REQUIREMENTS AND IS RESPONSIBLE FOR ITS REMOVAL.

D. CODES

1. ALL WORK SHALL BE PERFORMED IN A NEAT AND PROFESSIONAL MANNER AND CONFORM TO THE LATEST ADOPTED EDITION OF THE NATIONAL ELECTRICAL CODE, THE STATE'S, COUNTY'S, CITY'S AND LOCAL CODES AND ORDINANCES, SAFETY AND HEALTH CODES, NFPA CODES, ENERGY CODES, AND ALL OTHER APPLICABLE CODES AND REQUIREMENTS. THE CONTRACTOR SHALL INQUIRE INTO AND COMPLY WITH ALL APPLICABLE CODES, ORDINANCES, AND REGULATIONS. THE CONTRACTOR SHALL INCLUDE ANY CHANGES REQUIRED BY CODES IN THE BID AND IF THESE CHANGES ARE NOT INCLUDED IN THE BID, THEY MUST BE QUALIFIED AS A SEPARATE LINE ITEM IN THE BID. AFTER CONTRACT IS ISSUED, NO ADDITIONAL COST DUE TO CODE ISSUES SHALL BE REIMBURSED TO THE CONTRACTOR.

2. COMPLY WITH 2022 STATE OF CONNECTICUT BUILDING CODE AND NEC 2020 AND APPLICABLE AMENDMENTS.

E. LICENSES, PERMITS, INSPECTIONS AND FEES

1. THE CONTRACTOR SHALL OBTAIN AND PAY FOR ALL LICENSES, PERMITS, INSPECTIONS, AND FEES REQUIRED OR RELATED TO HIS WORK.

2. FURNISH TO OWNER ALL CERTIFICATES OF INSPECTION AND FINAL INSPECTION APPROVAL AT COMPLETION OF PROJECT.

F. TRADE NAMES, MANUFACTURERS AND SHOP DRAWINGS

1. WHERE TRADE NAMES AND MANUFACTURERS ARE USED ON THE DRAWINGS OR IN THE SPECIFICATIONS, THE EXACT EQUIPMENT SHALL BE USED AS A MINIMUM FOR THE BASE BID. MANUFACTURERS CONSIDERED AS AN EQUAL OR BETTER IN ALL ASPECTS TO THAT SPECIFIED WILL BE SUBJECT TO APPROVAL IN WRITING, THROUGH SHOP DRAWING SUBMITTAL PROCESS, BY THE CONSTRUCTION MANAGER PRIOR TO ACCEPTANCE. THE USE OF ANY UNAUTHORIZED EQUIPMENT SHALL BE SUBJECT TO REMOVAL AND REPLACEMENT AT THE CONTRACTOR'S EXPENSE.

2. THE CONTRACTOR SHALL PROVIDE SUBMITTALS FOR ALL EQUIPMENT TO DOOSAN/OWNER FOR APPROVAL. SUBMISSIONS SHALL BE MADE EARLY ENOUGH IN PROJECT TO ALLOW FOR (7) WORKING DAYS FOR DOOSAN AND ENGINEER REVIEW WITHOUT CAUSING DELAYS OR CONFLICTS TO THE JOB'S PROGRESS. SUBMITTALS SHALL BEAR THE STAMP OF THE ARCHITECT/ENGINEER OFFICE AND SUB-CONTRACTOR SHOWING THAT HE HAS REVIEWED AND CONFIRMED THAT THE SUBMITTALS ARE IN CONFORMANCE WITH THE CONTRACT DRAWINGS AND SPECIFICATIONS OR INDICATE WHERE EXCEPTIONS HAVE BEEN TAKEN.

G. GUARANTEE

1. THE CONTRACTOR SHALL GUARANTEE ALL MATERIALS AND WORK PROVIDED UNDER HIS CONTRACT AND SHALL MAKE GOOD, REPAIR OR REPLACE AT HIS OWN EXPENSE, ANY DEFECTIVE WORK, MATERIAL, REQUIREMENT WHICH MAY BE DISCOVERED WITHIN A PERIOD OF 12 MONTHS FROM THE DATE OF ACCEPTANCE (IN WRITING) OF THE INSTALLATION BY THE OWNER. EXTENDED WARRANTIES ARE SPECIFIED WITH INDIVIDUAL EQUIPMENT.

H. RECORD DRAWINGS

1. THE CONTRACTOR SHALL MAINTAIN ONE COPY OF DRAWINGS ON THE JOB SITE TO RECORD DEVIATIONS FROM CONTRACT DRAWINGS, SUCH AS:

a. LOCATION OF JUNCTION BOXES AND RECEPTACLES.

b. LOCATION OF ALL HOMERUNS SHOWING WIRE/CONDUIT SIZES.

c. REVISIONS, ADDENDUMS, AND CHANGE ORDERS.

d. SIGNIFICANT DEVIATIONS MADE NECESSARY BY FIELD CONDITIONS, APPROVED EQUIPMENT

SUBSTITUTIONS, AND CONTRACTOR'S COORDINATION WITH OTHER TRADES.

2. AT COMPLETION OF PROJECT AND BEFORE FINAL APPROVAL, THE CONTRACTOR SHALL MAKE ANY FINAL CORRECTIONS TO DRAWINGS AND CERTIFY THE ACCURACY OF EACH PRINT BY SIGNATURE THEREON.

3. A COPY OF THESE ASBUILT DRAWINGS WILL BE GIVEN TO DOOSAN / OWNER.

I. DISCREPANCIES IN DOCUMENTS

1. DRAWINGS (PLANS, SPECIFICATIONS, AND DETAILS) ARE DIAGRAMMATICAL AND INDICATE THE GENERAL LOCATION AND INTENT OF THE ELECTRICAL SYSTEMS. WHERE DRAWINGS, EXISTING SITE CONDITIONS, SPECIFICATIONS OR OTHER TRADES CONFLICT OR ARE UNCLEAR, ADVISE THE CONSTRUCTION MANAGER IN WRITING PRIOR TO SUBMITTAL OF BID. OTHERWISE, OWNER'S INTERPRETATION OF CONTRACT DOCUMENTS OR COMMENTS SHALL BE FINAL WITH NO ADDITIONAL COMPENSATION PERMITTED.

2. THE LOCATION OF OUTLETS AND EQUIPMENT SHOWN ON THE DRAWINGS ARE APPROXIMATE AND SCHEMATIC IN NATURE. OWNER SHALL HAVE THE RIGHT TO RELOCATE ANY OUTLETS OR FIXTURES BEFORE THEY ARE INSTALLED WITHOUT ADDITIONAL COST.

3. HOMERUNS SHOWN ARE SCHEMATIC. ELECTRICAL CONTRACTOR MAY ORIGINATE HOMERUNS FROM DIFFERENT LOCATIONS.

J. DEMOLITION

1. THE CONTRACTOR SHALL BE RESPONSIBLE FOR THE COORDINATION OF EQUIPMENT REMOVAL AND EXISTING WORK. COORDINATE WITH OWNER, EXISTING EQUIPMENT REQUIRED TO BE LEFT INTACT.

K. SLEEVES

1. THE CONTRACTOR SHALL PROVIDE SLEEVES TO PROTECT EQUIPMENT OR FACILITIES IN THE INSTALLATION. EACH SLEEVE SHALL EXTEND THROUGH ITS RESPECTIVE FLOOR, WALL OR PARTITION AND SHALL BE CUT FLUSH WITH EACH SURFACE EXCEPT SLEEVES THAT PENETRATE THE FLOOR, WHICH SHALL EXTEND 4" ABOVE THE FLOOR.

2. ALL SLEEVES AND OPENINGS THROUGH FIRE RATED WALLS AND/OR FLOORS SHALL BE FIRE SEALED WITH CALCIUM SILICATE, SILICONE PUTTY FOAM, 3"IM FIRE RATED SEALANTS OR EQUAL, SO AS TO RETAIN THEIR FIRE RATING.

3. SLEEVES IN BEARING AND MASONRY WALLS, FLOORS AND PARTITIONS SHALL BE STANDARD WEIGHT STEEL PIPE FINISHED WITH SMOOTH EDGES. FOR OTHER THAN MASONRY PARTITIONS, THROUGH SUSPENDED CEILINGS, OR FOR CONCEALED VERTICAL CONDUIT, SLEEVES SHALL BE NO. 22 U.S.G. GALVANIZED STEEL MINIMUM.

L. HANGERS

1. HANGERS SHALL INCLUDE ALL MISCELLANEOUS STEEL SUCH AS IRON, WIRE, UNISTRUT, C-CLAMPS WITH RETAINING CLIPS, CHANNELS, HANGER RODS, ETC., NECESSARY FOR THE INSTALLATION OF WORK.

2. HANGERS SHALL BE FASTENED TO BUILDING STEEL, CONCRETE, OR MASONRY, BUT NOT TO OTHER CONDUIT OR PIPING. HANGERS UPPER ATTACHMENT MUST BE SUPPORTED FROM THE TOP OF THE BAR JOIST. HANGING FROM METAL DECK IS NOT PERMITTED. WHERE INTERFERENCE OCCUR, IN ORDER TO SUPPORT CONDUIT, THE CONTRACTOR MUST INSTALL TRAPEZOID TYPE HANGERS OR SUPPORTS WHICH SHALL BE LOCATED WHERE THEY DO NOT INTERFERE WITH ACCESS TO FIRE DAMPERS, VALVES, JUNCTION BOXES, ACCESS DOORS, OTHER EQUIPMENT SERVICE REQUIREMENTS AND/OR OTHER TRADES.

M. SCOPE OF WORK

1. THE CONTRACTOR SHALL FURNISH ALL LABOR, MATERIALS, EQUIPMENT, SERVICES, TOOLS, TRANSPORTATION NECESSARY FOR EQUIPMENT, SERVICES, TOOLS, TRANSPORTATION, AND FACILITIES NECESSARY FOR, REASONABLY IMPLIED AND INCIDENTAL TO, THE FURNISHING, INSTALLATION, COMPLETION AND TESTING OF ALL THE WORK FOR THE ELECTRICAL SYSTEMS AS SHOWN ON THE DRAWINGS, CALLED FOR IN THE SPECIFICATIONS, AND AS REQUIRED BY JOB CONDITIONS, TO INCLUDE, BUT NOT BE LIMITED TO THE FOLLOWING:

a. A COMPLETE ELECTRICAL DISTRIBUTION SYSTEM INCLUDING THE INSTALLATION OF PANELBOARDS, SAFETY AN DISCONNECT SWITCHES, LIGHTING AND RECEPTACLES. IT IS THE ELECTRICAL CONTRACTOR'S RESPONSIBILITY TO INCLUDE IN HIS BID FOR PROVIDING SERVICE EQUIPMENT NECESSARY TO OBTAIN SERVICE FROM LOCAL UTILITY COMPANY. REFER TO ELECTRICAL ONE-LINE DIAGRAM FOR ADDITIONAL INFORMATION.

b. THE CONTRACTOR MUST ALSO INCLUDE IN BID ALL NECESSARY MATERIALS REQUIRED TO COMPLETE THE SYSTEM INCLUDING, BUT NOT LIMITED TO, FEEDERS, BRANCH CIRCUITS, JUNCTION BOXES, OUTLET BOXES, WIRING DEVICES, COVERPLATES, CONDUITS, ETC.

c. METERING AND CURRENT TRANSFORMERS AS REQUIRED BY DRAWINGS, UTILITY COMPANY.

d. THE WIRING OF MECHANICAL EQUIPMENT AS OUTLINED ON THE DRAWINGS AND IN THE SPECIFICATIONS. ALL SHALL INCLUDE WIRING OF ALL STARTERS, DISCONNECTS, AND POWER WIRING OF MECHANICAL EQUIPMENT EXCEPT AS SPECIFICALLY NOTED OTHERWISE. ALL LOW VOLTAGE (24 VOLT) TEMPERATURE CONTROL WIRING SHALL BE THE RESPONSIBILITY OF THE MECHANICAL CONTRACTOR UNLESS NOTED SPECIFICALLY ON DRAWING.

e. INSTALLATION OF LIGHT FIXTURES AND LAMPS AS SHOWN ON THE DRAWINGS INCLUDING ALL DEVICES, EQUIPMENT, ETC. REQUIRED FOR MOUNTING.

f. TEMPORARY SERVICE AS INDICATED IN THE SPECIFICATIONS, INCLUDING ITS REMOVAL.

g. SMOKE/FIRE ALARM WIRING, DEVICES AND CONDUIT, AS SHOWN OR DESCRIBED ON DRAWINGS OR AS NECESSARY TO MEET STATE, LOCAL, INSURANCE AND FIRE DEPARTMENT REQUIREMENTS.

h. INSTALLATION OF CONDUITS AND WIRING TO CONTROL PANEL, CABLES ARE NOT PERMITTED. SEE SERVICE FOR LOW VOLTAGE CONTROL'S REQUIREMENTS.

i. VERIFY FUEL CELL PHASE ROTATION MATCHES THE BUILDING ELECTRICAL SERVICE. MEASURE VOLTAGE ACROSS EACH PHASE OF MCB010 AND VERIFY THAT EACH PHASE IS SIMILAR IN MAGNITUDE.

j. CONDUCTOR MARKING SHALL BE IN ACCORDANCE TO NEC 408.3(E) REGARDING PHASE ROTATION.

2. THE FOLLOWING ITEMS OF ELECTRICAL CONSTRUCTION ARE NOT INCLUDED IN THIS CONTRACT:

a. 24 VOLT TEMPERATURE CONTROL WIRING UNLESS NOTED OTHERWISE

b. TELEPHONE INSTRUMENTS AND WIRING UNLESS NOTED OTHERWISE

3. BEFORE STARTING WORK, THE CONTRACTOR SHALL EXAMINE THE STRUCTURAL AND MECHANICAL PLANS, SHOP DRAWINGS, AND SPECIFICATIONS, COORDINATE, AND INTEGRATE THE VARIOUS ELEMENTS OF THE ELECTRICAL SYSTEM, MATERIALS AND EQUIPMENT WITH OTHER CONTRACTORS TO AVOID INTERFERENCES AND CONFRONTATIONS.

B. CONDUIT

1. THE CONTRACTOR SHALL FURNISH AND INSTALL ALL CONDUITS SERVING ALL EQUIPMENT, INCLUDING BUT NOT LIMITED TO, LIGHTING, RECEPTACLES, HEATING AIR CONDITIONING, MECHANICAL EQUIPMENT, TELEPHONE, DATA AND ELECTRICAL EQUIPMENT.

2. ALL CONDUITS SHALL BE GALVANIZED RMC OR EMT UNLESS OTHERWISE SPECIFIED. ALL CONDUIT IS TO BE UL LABELED. ALL CONDUIT SHALL RECEIVE A SUPPLEMENTARY CORROSION PROTECTION COATING OF ZINC-RICH PAINT, ACRYLIC OR WEATHER-STABLE EPOXY-BASED RESIN, APPROVED FOR THIS PURPOSE. THE CONDUIT SHOULD BE PREPARED FOR COATING PER ASTM D3686. ALL FIELD CUT THREADS SHALL BE PROTECTED AGAINST CORROSION WITH CONDUCTIVE RUST-RESISTANT ZINC-RICH PAINT.

EMT SHALL BE FOR INDOOR USE ONLY. EMT CONNECTORS SHALL BE STEEL COMPRESSION TYPE CONDUIT UNDER SLAB ON GRADE SHALL BE GALVANIZED RIGID STEEL, OR SCHEDULE 40 PVC WITH RIGID STEEL ELLS WHERE PERMITTED BY CODE.

UNDERGROUND CONDUITS SHALL BE PVC SCH. 40. EXPOSED OUTDOOR CONDUITS SHALL BE RGS. PROVIDE METAL SWEEPS WHERE PVC CONDUIT EMERGES FROM GRADE.

ALL CONDUIT INSTALLATIONS SHALL BE COMPLIANT WITH OWNERS BUILDING STANDARD. MINIMUM SIZE OF CONDUIT SHALL BE 3/4 INCH.

SPARE CONDUITS SHALL HAVE NYLON PULL WIRES INSTALLED IN THEM.

3. SUPPORT ALL CONDUIT, INCLUDING SEISMIC AND SWAY BRACING, IN ACCORDANCE WITH THE NEC AND LOCAL CODES.

4. GENERALLY, ALL CONDUIT SHALL BE CONCEALED EXCEPT FOR UNFINISHED AREAS, SUCH AS EQUIPMENT ROOMS. EXPOSED CONDUIT SHALL BE ALLOWED ONLY AS NOTED ON PLAN AND AS APPROVED BY DOOSAN.

5. LIQUID TIGHT FLEXIBLE CONDUIT (LTFC)

a. LIQUID TIGHT FLEXIBLE CONDUIT AND ASSOCIATED FITTINGS SHALL BE INSTALLED PER MANUFACTURER'S GUIDELINES WITH SPECIAL ATTENTION TO FITTING TORQUES.

b. LIQUID TIGHT FLEXIBLE CONDUIT SHALL BE USED FOR THE FOLLOWING APPLICATIONS: FINAL CONNECTIONS TO MOTORS.

c. LIQUID TIGHT FLEXIBLE CONDUIT MUST BE THE SAME SIZE AS THE RMC OR EMT CONDUIT TO WHICH IT IS CONNECTED. BOTH THE FLEXIBLE METAL CONDUIT AND ITS FITTINGS ARE TO BE LISTED FOR GROUNDING. A GREEN GROUNDING CONDUCTOR SHALL BE INSTALLED. ALL CONNECTORS ARE TO BE OF A NEMA APPROVED TYPE.

d. THE USE OF MC CABLE OR GREENFIELD IS NOT PERMITTED. CONNECTION TO OUTDOOR EQUIPMENT MUST BE WEATHERPROOF (LIQUID TIGHT OR SEALTIGHT).

7. PROVIDE PULL-WIRE IN ALL EMPTY CONDUITS EXCEPT AS NOTED OTHERWISE ON DRAWINGS.

8. HOME RUNS AND MAIN CONDUIT RUNS ARE TO BE HELD TIGHT TO STRUCTURE ABOVE OR AS REQUIRED TO ALLOW PROPER SERVICE ACCESS AND OTHER TRADES WORK.

9. ALL CONDUITS MUST BE SIZED PER NEC AND LOCAL CODES.

10. ALL CONDUIT SUPPORTS, BOLTS, STRAPS, SCREWS ETC. SHALL BE GALVANIZED / CORROSION RESISTANT.

C. OUTLET BOXES

1. ALL OUTLET BOXES SHALL BE GALVANIZED PRESSED STEEL OF THE STANDARD KNOCKOUT TYPE. NO ROUND OUTLET BOXES SHALL BE PERMITTED, EXCEPT AS SPECIFICALLY NOTED ON DRAWINGS BOXES SHALL NOT BE LESS THAN 4" SQUARE AND 1 1/2" DEEP.

2. ALL KNOCKOUT BOXES, UPON WHICH LIGHTING FIXTURES ARE TO BE INSTALLED, SHALL BE EQUIPPED WITH 3/8" FIXTURE STUDS.

3. EXTERIOR BOXES SHALL BE CAST RUST-RESISTING METAL WITH GASKETED COVERS.

4. INSTALL BOXES RIGIDLY FROM BUILDING STRUCTURE AND SUPPORT INDEPENDENTLY OF THE CONDUIT SYSTEM. ALSO PROVIDE SUITABLE BOX EXTENSIONS TO EXTEND BOXES TO FINISHED FACE OF CEILINGS. ALL OUTLET BOXES TO BE PROVIDED WITH CADDY "QUICK-MOUNT BOX SUPPORT" TO MINIMIZE THE DEFLECTION THAT OCCURS WHEN PLUGGING/UNPLUGGING INTO THESE DEVICES.

5. UNLESS OTHERWISE NOTED ON DRAWINGS OR OTHERWISE REQUIRED BY THE NATIONAL ELECTRICAL CODE, HANDICAP CODES OR LOCAL CODES, OUTLET HEIGHTS SHALL BE AS FOLLOWS:

a. SWITCH HEIGHT 48" FROM FINISHED FLOOR TO CENTERLINE OF OUTLET.

b. CONVENIENCE OUTLETS: 24" FROM FINISHED FLOOR TO CENTERLINE OF OUTLET.

D. JUNCTION AND PULL BOXES

1. THE DRAWINGS INDICATE SCHEMATIC ROUTINGS FOR CONDUIT RUNS. CONTRACTOR SHALL FURNISH AND INSTALL ADDITIONAL BOXES WHERE REQUIRED BY FIELD CONDITIONS OR BY CODE.

2. BOXES AND COVERS SHALL BE GALVANIZED/PAINTED STEEL OF CODE GAUGE SIZE.

3. INSTALL BOXES RIGIDLY SUPPORTED FROM THE BUILDING STRUCTURE AND SUPPORTED INDEPENDENT OF THE CONDUIT SYSTEM.

4. ARRANGE CIRCUITS TO AVOID THE USE OF JUNCTION BOXES IN INACCESSIBLE LOCATIONS.

5. JUNCTION AND PULL BOXES MUST BE LABELED WITH CIRCUIT NUMBER IDENTIFICATION AND SYSTEM TYPE ON COVER.

E. WIRING (600V AND LESS)

1. CONDUCTORS FOR FEEDERS AND BRANCH CIRCUITS SHALL BE COPPER AND THE AWG SIZE AND TYPE AS SHOWN ON DRAWINGS. MINIMUM WIRE SIZE #12. THE CONDUCTORS SHALL BE 60VOLT INSULATION TYPE THW, THWN OR THHN.

2. FUEL CELL FEEDER CONDUCTORS FROM THE FUEL CELL TO FC-MD2 SHALL BE ALUMINUM AND THE WIRE SIZE SHOWN ON DRAWINGS. THE CONDUCTORS SHALL BE 60V INSULATION TYPE XHHW.

3. ON ALL 20 AMP BRANCH CIRCUITS, CONDUCTORS LARGER THAN #10 AWG SHALL BE REDUCED TO #10 AWG WITHIN 10 FEET OF PANEL BOARD AND DEVICE IN JUNCTION BOXES ON RATED TERMINAL STRIPS.

4. CONDUCTORS SHALL BE STRANDED.

5. ALL WIRING SHALL BE IN CONDUIT, UNLESS SPECIFICALLY NOTED OTHERWISE (IE. LOW VOLTAGE PLENUM RATED WIRE)

6. EACH CIRCUIT SHALL HAVE A DEDICATED NEUTRAL CONDUCTOR WHEN REQUIRED AND SHALL BE INSTALLED IN ACCORDANCE WITH THE NATIONAL ELECTRICAL CODE AND LOCAL CODES.

7. THE USE OF MC CABLE, ETC. IS NOT PERMITTED.

8. WIRE CONNECTORS SHALL BE EQUAL TO "SCOTCH LOCK" FOR #8 AWG WIRE AND SMALLER AND EQUAL TO T & B "LOCKTIGHT" FOR #6 AWG AND LARGER.

9. ALL WIRING TO BE COLOR-CODED AS FOLLOWS:

| | |
|---------------------|---------------------|
| 120/208 VOLT SYSTEM | 277/480 VOLT SYSTEM |
| NEUTRAL - WHITE | NEUTRAL - GREY |
| PHASE A - BLACK | PHASE A - BROWN |
| PHASE B - RED | PHASE B - ORANGE |
| PHASE C - BLUE | PHASE C - YELLOW |
| GROUND - GREEN | GROUND - GREEN |

F. WIRING DEVICES

1. CONTRACTOR SHALL FURNISH AND INSTALL SWITCHES AND RECEPTACLES, UNLESS NOTED OTHERWISE, AS NECESSARY FOR A COMPLETE INSTALLATION. COLOR OF DEVICES AND PLATES SHALL BE WHITE UNLESS OTHERWISE NOTED. THE DEVICES SHALL BE OF THE TYPES AND RATINGS LISTED, OR EQUALS BY HUBBELL, BRYANT OR PASS & SEYMOUR. WEATHERPROOF GF RECEPTACLES SHALL BE INSTALLED WHERE SHOWN ON DRAWINGS OR AS REQUIRED BY CODE.

2. ALL WIRING DEVICES SHALL BE HEAVY DUTY GRADE, CONFIGURATION TO SUIT SERVICE.

G. HEATING, VENTILATION, PROCESS AND CONTROLS WIRING

1. THE ELECTRICAL CONTRACTOR SHALL REFER TO MECHANICAL AND CONTROL DETAILS ON MECHANICAL DRAWINGS FOR ADDITIONAL ELECTRICAL WORK TO BE INCLUDED IN HIS BID.

2. ELECTRICAL CONTRACTOR SHALL DO ALL POWER WIRING, LINE VOLTAGE WIRING, AND LINE VOLTAGE CONTROL WIRING INDICATED UNDER THE HEATING AND VENTILATION SPECIFICATIONS AND DRAWINGS. THIS CONTRACTOR SHALL ALSO DO ALL INTERCONNECTING LINE VOLTAGE WIRING BETWEEN RELAYS AND DEVICES AS REQUIRED.

3. ELECTRICAL CONTRACTOR IS RESPONSIBLE FOR FURNISHING AN INSTALLING CONDUIT FOR HVAC CONTROL WIRING. ELECTRICAL CONTRACTOR SHALL GROUP DEVICES TOGETHER AS NEEDED TO MINIMIZE THE QUANTITY OF CONTROL CONDUITS. SIZE CONDUITS IN ACCORDANCE WITH NEC.

H. SAFETY AND DISCONNECT SWITCHES

1. SAFETY AND DISCONNECT SWITCHES SHALL BE HEAVY DUTY TYPE, QUICK-MAKE, QUICK-BREAK FUSED OR NON-FUSIBLE WITH RATINGS AND SIZES AS NOTED ON PLANS AND

REQUIRED BY CODES.

2. AT SERVICE ENTRANCE, DISCONNECT SHALL BEAR THE MANUFACTURER'S LABEL INDICATING THE EQUIPMENT IS UL RATED FOR APPLICATION IN ACCORDANCE WITH ALL CODES.

3. MANUFACTURER SHALL BE GENERAL ELECTRIC, SQUARE D, EATON OR APPROVED EQUAL.

I. GROUNDING

1. FURNISH AND INSTALL COMPLETE WIRED GROUNDING CONDUCTOR SYSTEM, #12 AWG MINIMUM, SIZED AND INSTALLED IN ACCORDANCE WITH THE LATEST ADOPTED EDITION OF THE NATIONAL ELECTRICAL CODE, STATE AND LOCAL CODES, AND AS NOTED IN THE SPECIFICATIONS AND AS INDICATED ON THE DRAWINGS.

2. ALL CONDUIT, INCLUDING FLEXIBLE CONDUIT, SHALL BE GROUND WITH A GREEN GROUNDING CONDUCTOR.

3. GROUNDING CONNECTIONS MADE TO THE WATER PIPING SYSTEM SHALL BE COORDINATED WITH THE PLUMBING CONTRACTOR AND A BONDING JUMPERS INSTALLED AROUND WATER METER PER CODES AND AS INDICATED ON DRAWINGS.

4. ALL DEVICES SHALL BE BONDED TO THE CONDUIT SYSTEM. USE A BONDING JUMPER BETWEEN THE OUTLET BOX AND THE DEVICE GROUNDING TERMINAL. METAL-TO-METAL CONTACT BETWEEN THE DEVICE YOKE AND THE OUTLET BOX IS NOT ACCEPTABLE AS A BOND FOR EITHER SURFACE MOUNTED BOXES OR FLUSH TYPE BOXES. ALL JUNCTION BOXES, OUTLET BOXES, AND PULL BOXES SHALL BE BONDED TO THE CONDUIT SYSTEM.

5. FOR PANEL FEEDERS, BOND THE GROUNDING CONDUCTOR TO THE CONDUIT, WHERE ENTERING AND LEAVING THE CONDUIT. THE GROUNDING CONDUCTOR SHALL BE COPPER WITH GREEN IDENTIFICATION AND SIZED PER N.E.C.

6. ALL ENCLOSURES AND NON-CURRENT CARRYING METAL PARTS ARE TO BE GROUNDED. CONDUIT SYSTEM IS TO BE ELECTRICALLY CONTINUOUS. ALL LOCKNUTS MUST CUT THROUGH ENAMELED OR PAINTED SURFACES ON ENCLOSURES, WHERE ENCLOSURES AND NON-CURRENT CARRYING METAL PARTS ARE ISOLATED FROM THE CONDUIT SYSTEM, USE BONDING JUMPERS WITH APPROVED CLAMPS. ALL GROUND CLAMPS SHALL BE "PENN-UNION" OR EQUAL, SIMILAR TO "GPL" TYPE.

J. LIGHTING FIXTURES

1. THE CONTRACTOR SHALL INSTALL ALL LIGHTING FIXTURES AND LAMPS AS SHOWN ON THE DRAWINGS. CONTRACTOR IS TO REPLACE ALL NON-WORKING LAMPS PRIOR TO ACCEPTANCE BY DOOSAN/OWNER.

K. SUBMITTALS

1. THE CONTRACTOR SHALL PROVIDE 5 COPIES OF (AS WELL AS ELECTRONIC) SUBMITTALS OF ALL INSTALLATION METHODS, MATERIALS AND ACCESSORIES FOR REVIEW AND APPROVAL. SUBMITTALS FOR EQUIPMENT SHALL SPECIFICALLY STATE "NEW" OR "RECONDITIONED" FOR EACH ITEM. RECONDITIONED EQUIPMENT SHALL REQUIRE SPECIFIC APPROVAL BY DOOSAN. SUBMITTALS SHALL BE ASSEMBLED AND SUBMITTED PRIOR TO ANY INSTALLATION WORK, AND SHOULD INCLUDE:

- WIRE
- CONDUIT
- DISCONNECT SWITCH
- SWITCHBOARD AND SWITCHGEAR - NEW AND MODIFICATIONS AND ACCESSORIES
- ENCLOSURES
- CURRENT TRANSFORMERS, POTENTIAL TRANSFORMERS AND TEST BLOCKS
- HEAT TRACE
- UTILITY METER
- WIREWAY, PULL BOX

L. TESTS AND ADJUSTMENTS

1. ACCEPTANCE TESTS:

TEST THE FOLLOWING IN ACCORDANCE WITH APPLICABLE SECTIONS OF THE LATEST NETA-ACCEPTANCE TESTING STANDARD. PROVIDE SERVICES OF A QUALIFIED ELECTRICAL TESTING COMPANY AS REQUIRED.

- TRANSFORMER
- SWITCHBOARD
- BREAKERS, RATED 250 A AND LARGER - BREAKERS SHALL BE TESTED USING PRIMARY INJECTION METHOD, WITH FINAL SETTINGS ADVISED BY THE ENGINEER IN A COORDINATION STUDY.
- PROTECTIVE RELAYS - BENCH TEST WITH FINAL SETTINGS. ALSO PROVIDE WITNESS TESTING AS REQUIRED BY THE UTILITY COMPANY AND AHJ. ALSO INCLUDE THE SEL RELAYS PROVIDED IN THE FUEL CELLS.
- CONDUCTORS - MV CONDUCTORS SHALL BE HI-POT TESTED.
- PANELBOARDS
- DISCONNECT SWITCHES
- CT AND PTS
- GROUNDING - USE FALL OF POTENTIAL METHOD AND CONTINUITY CHECKS.

2. ALL CONNECTIONS AT PANELS AND SWITCHES ARE TO BE MADE, ALL SPLICES COMPLETE, ALL FUSES IN PLACE, AND ALL CIRCUITS CONTINUOUS FROM POINT OF SERVICE CONNECTION TO ITS FINAL DESTINATION, AND ALL COVERS AND PLATES INSTALLED PRIOR TO THE TIME OF FINAL INSPECTION BY OWNERS ENGINEER.

3. UPON COMPLETION OF THE WORK, ALL PARTS OF THE ELECTRICAL INSTALLATION SHALL BE TESTED AND PROVED FREE OF UNWANTED GROUNDS AND OTHER DEFECTS.

4. ALL OVERLOAD DEVICES, INCLUDING EQUIPMENT FURNISHED UNDER OTHER CONTRACTS, SHALL BE SET AND ADJUSTED TO SUIT THE LOAD CONDITIONS.


5. TEST AND MAKE CORRECTIONS/ADJUSTMENTS FOR PHASE BALANCING.

6. PROVIDE FINAL REPORT TO DOOSAN AT TIME OF PUNCH-OUT.

M. CLEANING

1. AT THE END OF THE PROJECT, THE CONTRACTOR SHALL CLEAN ALL EQUIPMENT, TO THE SATISFACTION OF OWNER. ALL DUST, DIRT, DEBRIS, AND FOREIGN MATTER SHALL BE REMOVED FROM ALL EQUIPMENT.

| Rev. | Date | Description |
|------|----------|----------------------------------|
| F | 07/31/23 | UPDATED PER FLOOR COMM. REQUESTS |
| D | 01/02/23 | UPDATED EVERSOURCE CKT. NAMES |
| C | 10/06/22 | REISSUED FOR CONSTRUCTION |
| B | 09/26/22 | ISSUED FOR CONSTRUCTION |
| A | 07/07/22 | PRELIMINARY ISSUE |

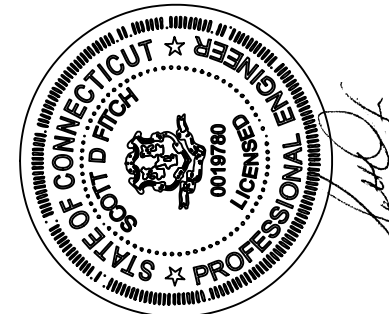

10 White Wood Lane
N. Branford, CT 06471
Phone: (203) 453-8996
Email: info@icdsllc.com



UNIVERSITY OF HARTFORD
200 BLOOMFIELD AVE, WEST HARTFORD CT
FUEL CELL INSTALLATION
ELECTRICAL ONE-LINE DIAGRAM

| | |
|--------------|------------|
| Project No.: | Drawn By: |
| Date: | Design By: |
| Scale: | Check By: |

Drawing No.:
E4.0