
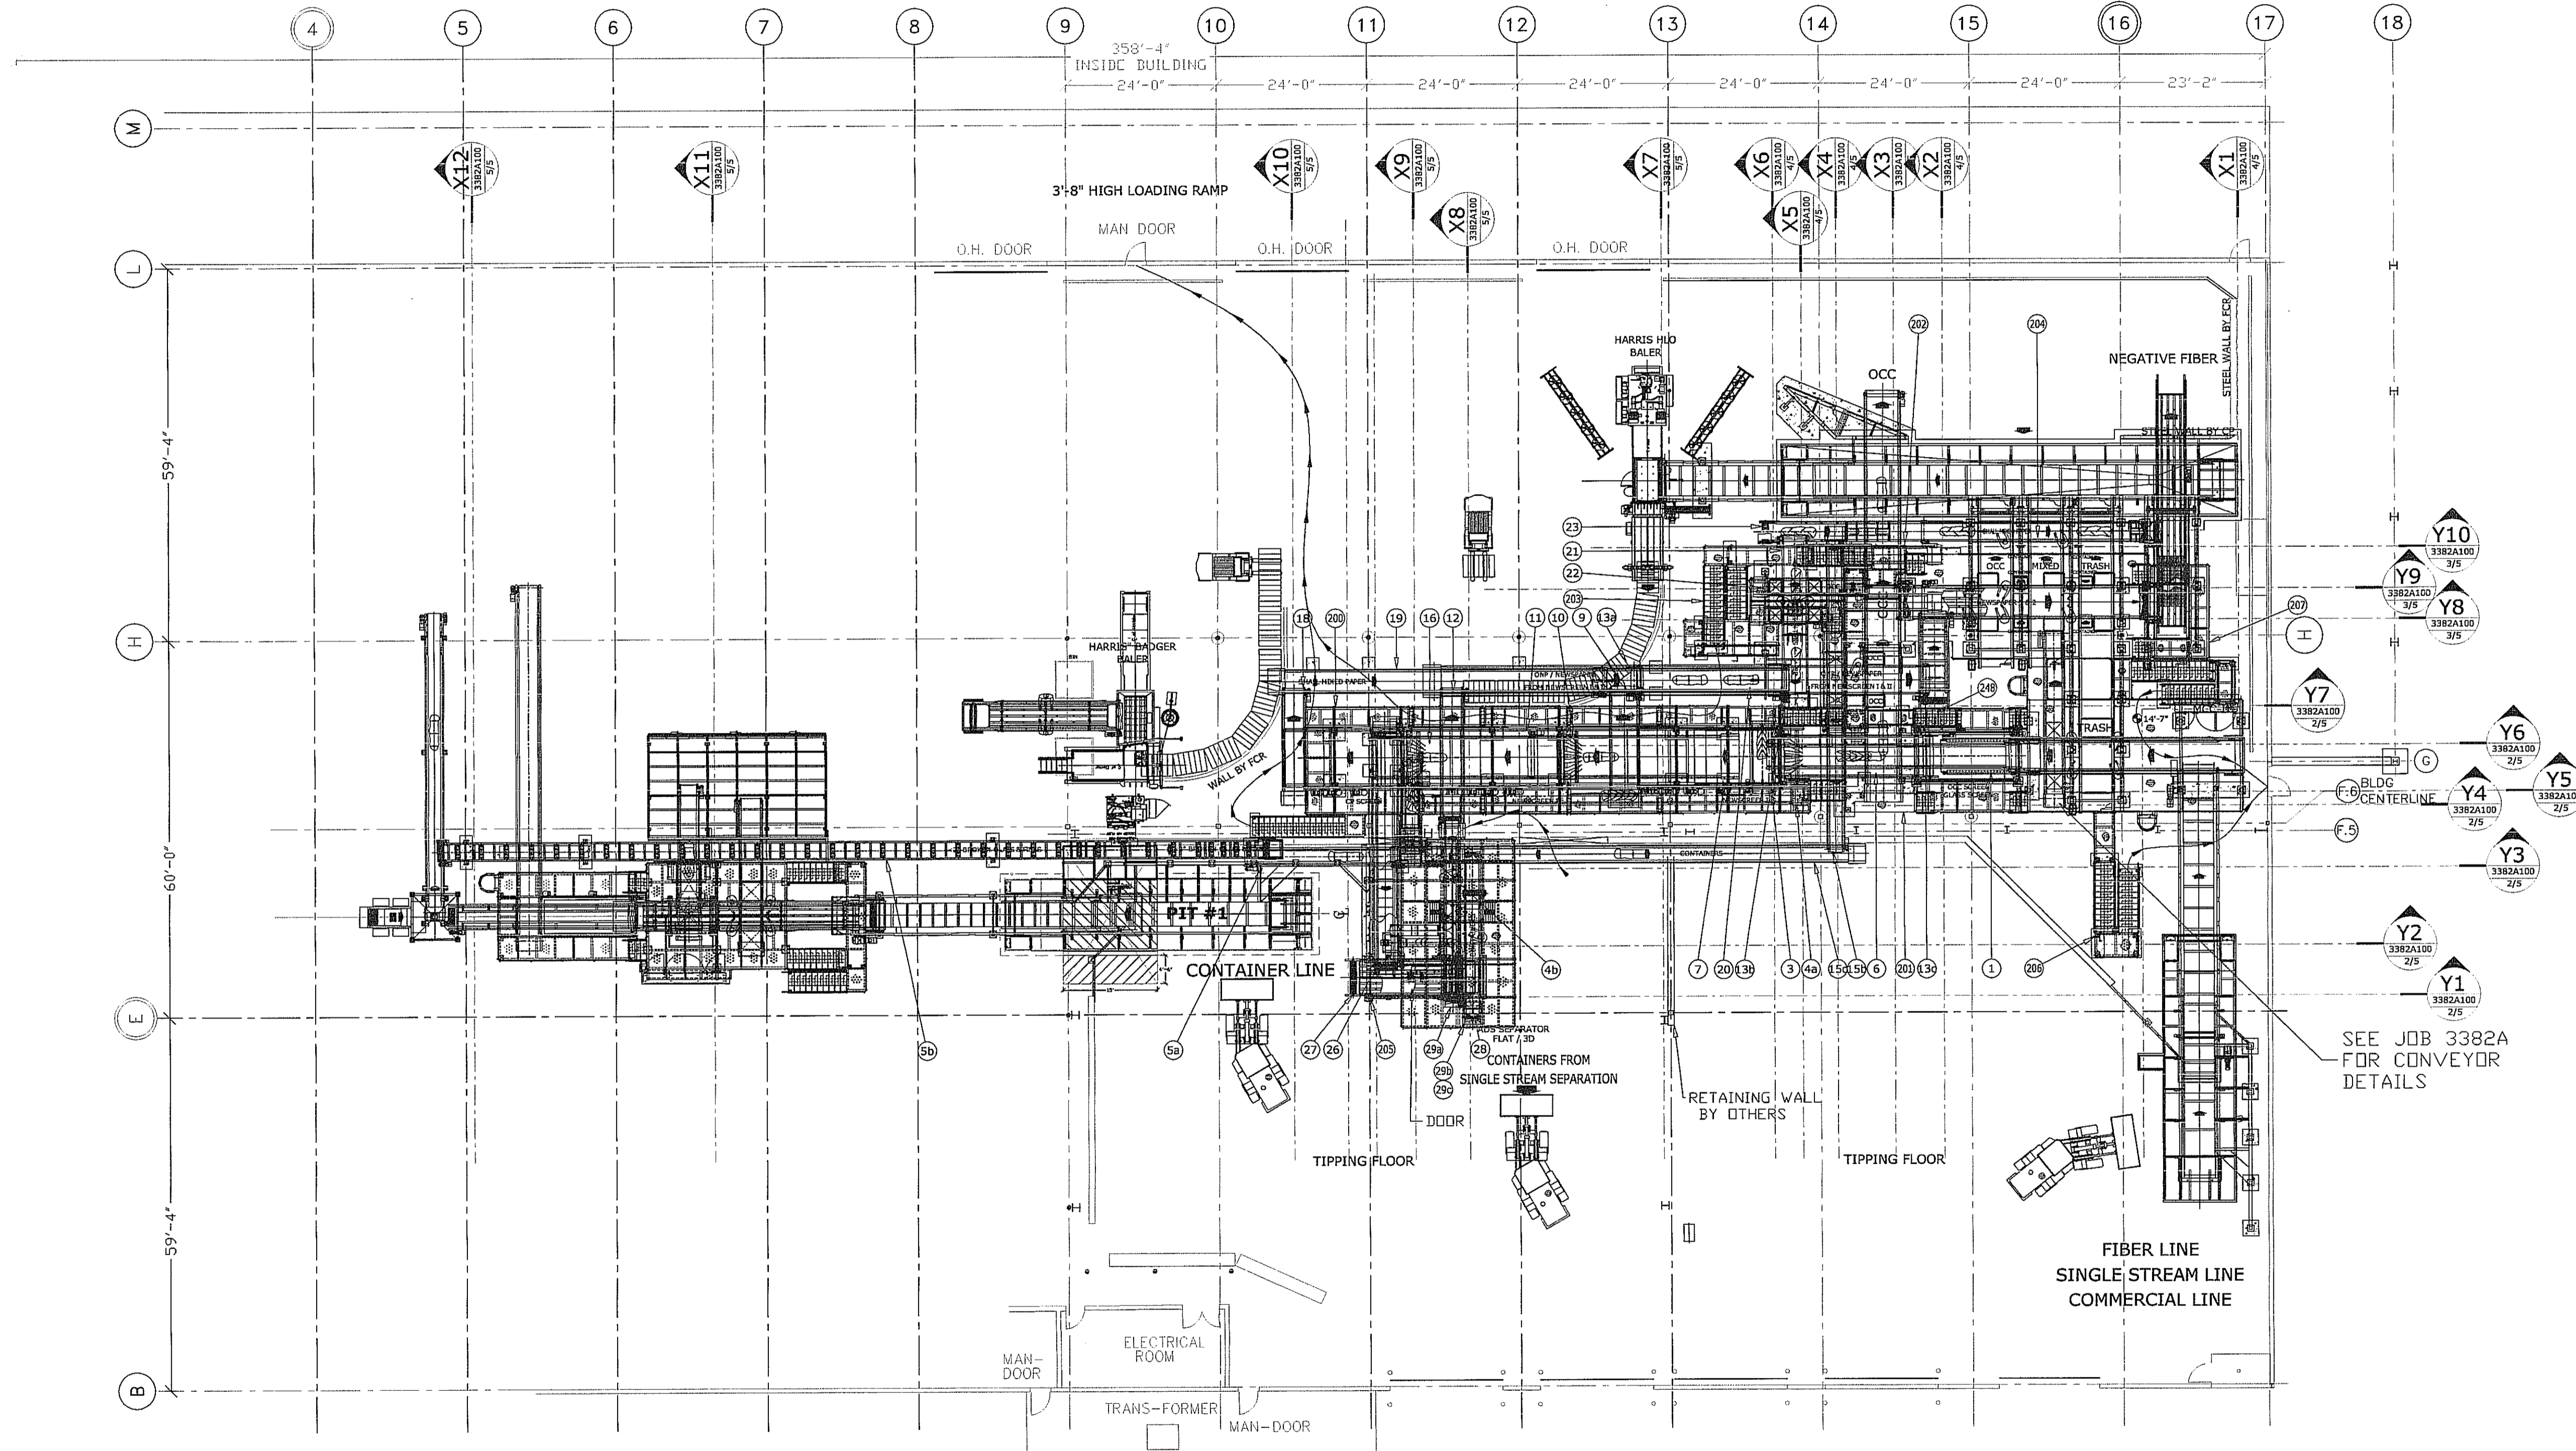


CONFIDENTIAL

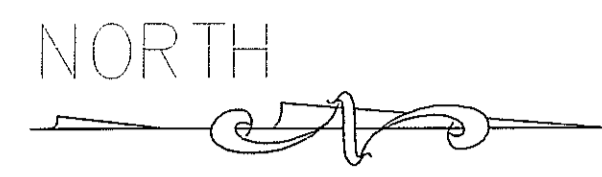


SYSTEM AS BUILT

IMPORTANT NOTES:

- ▲ BUILDING PERMITS AND ALL OTHER PERMITS (IF REQUIRED) SUPPLIED BY OTHERS.
- ▲ ALL SLAB, FOUNDATION AND EMBEDMENT DETAILS SHOWN ARE SUGGESTION ONLY AND THEY MUST BE VERIFIED PRIOR CONSTRUCTION. ACTUAL REQUIREMENTS MAY VARY DO TO LOCAL SOIL AND/OR CONCRETE CONDITIONS. PURCHASER IS RESPONSIBLE FOR ADEQUATE STRUCTURAL DESIGN AND PROPER CONSTRUCTION OF PITS, SLABS, FOUNDATIONS AND EMBEDMENTS.
- ▲ CP-MFG. EQUIPMENT AND SUPPORT STRUCTURE DESIGN/MANUFACTURE TO BE IN COMPLIANCE WITH SEISMIC CODES AND REGULATIONS. REFER TO ENG. CALCULATIONS FOR STRUCTURE STEEL SUPPORT FRAME AND CONCRETE FOUNDATIONS BY "CURTIS ENGINEERING CORPORATION".
- ▲ ALL CONCRETE SURFACES TO BE FLAT AND LEVEL WITHIN 1" IN 40' (25.4 mm IN 122m).
- ▲ ALL DISCHARGE CONTAINERS SUPPLIED BY OTHERS.
- ▲ DIMENSIONS DENOTED AS (---) ARE REFERENCE DIMENSIONS ONLY.
- ▲ SUGGESTED FOUNDATION: MIN. 8" (203 mm) STEEL REINFORCED 4000 PSI (280kg/sq) CONCRETE SLAB.
- ▲ CP MANUFACTURING IS NOT RESPONSIBLE FOR FIELD WORK PERFORMED BY OTHERS.

NOTICE OF CONFIDENTIALITY: THIS DRAWING IS THE PROPERTY OF CP MANUFACTURING AND IS LOANED SUBJECT TO THE CONDITION THAT IT SHALL NOT BE REPRODUCED, COPIED, LOANED OR OTHERWISE USED AS A MEANS OF REFERENCE TO WORK FURNISHED BY THIS COMPANY ONLY AND IS NOT TO BE SUBMITTED TO OUTSIDE PARTIES FOR EXAMINATION WITHOUT OUR WRITTEN CONSENT.

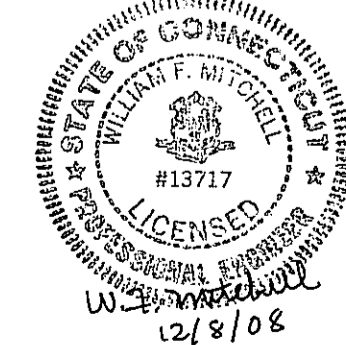

FIBER & CONTAINER SORT SYSTEM
 FCR / CASELLA WASTE INC.
 HARTFORD - CONNECTICUT - USA
 JOB #3382

REV	DESCRIPTION	DATE	BY
1	INITIAL RELEASE FOR CONTAINER REVIEW AND APPROVAL	///	///
2	ASSED STAGE ACCESS ITEM FROM PROJECT COMPLETE.	///	///
3		///	///
4		///	///
5		///	///
6		///	///

CP MANUFACTURING INC.
 1,300 WILSON AVENUE - NATIONAL CITY, CA 91950
 PHONE: 619-477-3175 FAX: 619-477-3426

PROJECT NAME AND LOCATION
MATERIAL RECOVERY FACILITY
FCR / CASELLA WASTE INC.
 211 MURPHY ROAD
 HARTFORD, CT 06114-2105

DATE: 04/07/08
 SHEET NO. 1 OF 5
 DRAWING NO. 3382A100