
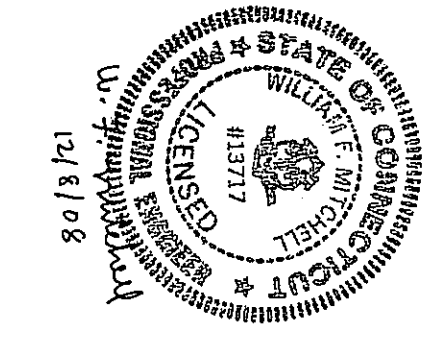


CONFIDENTIAL

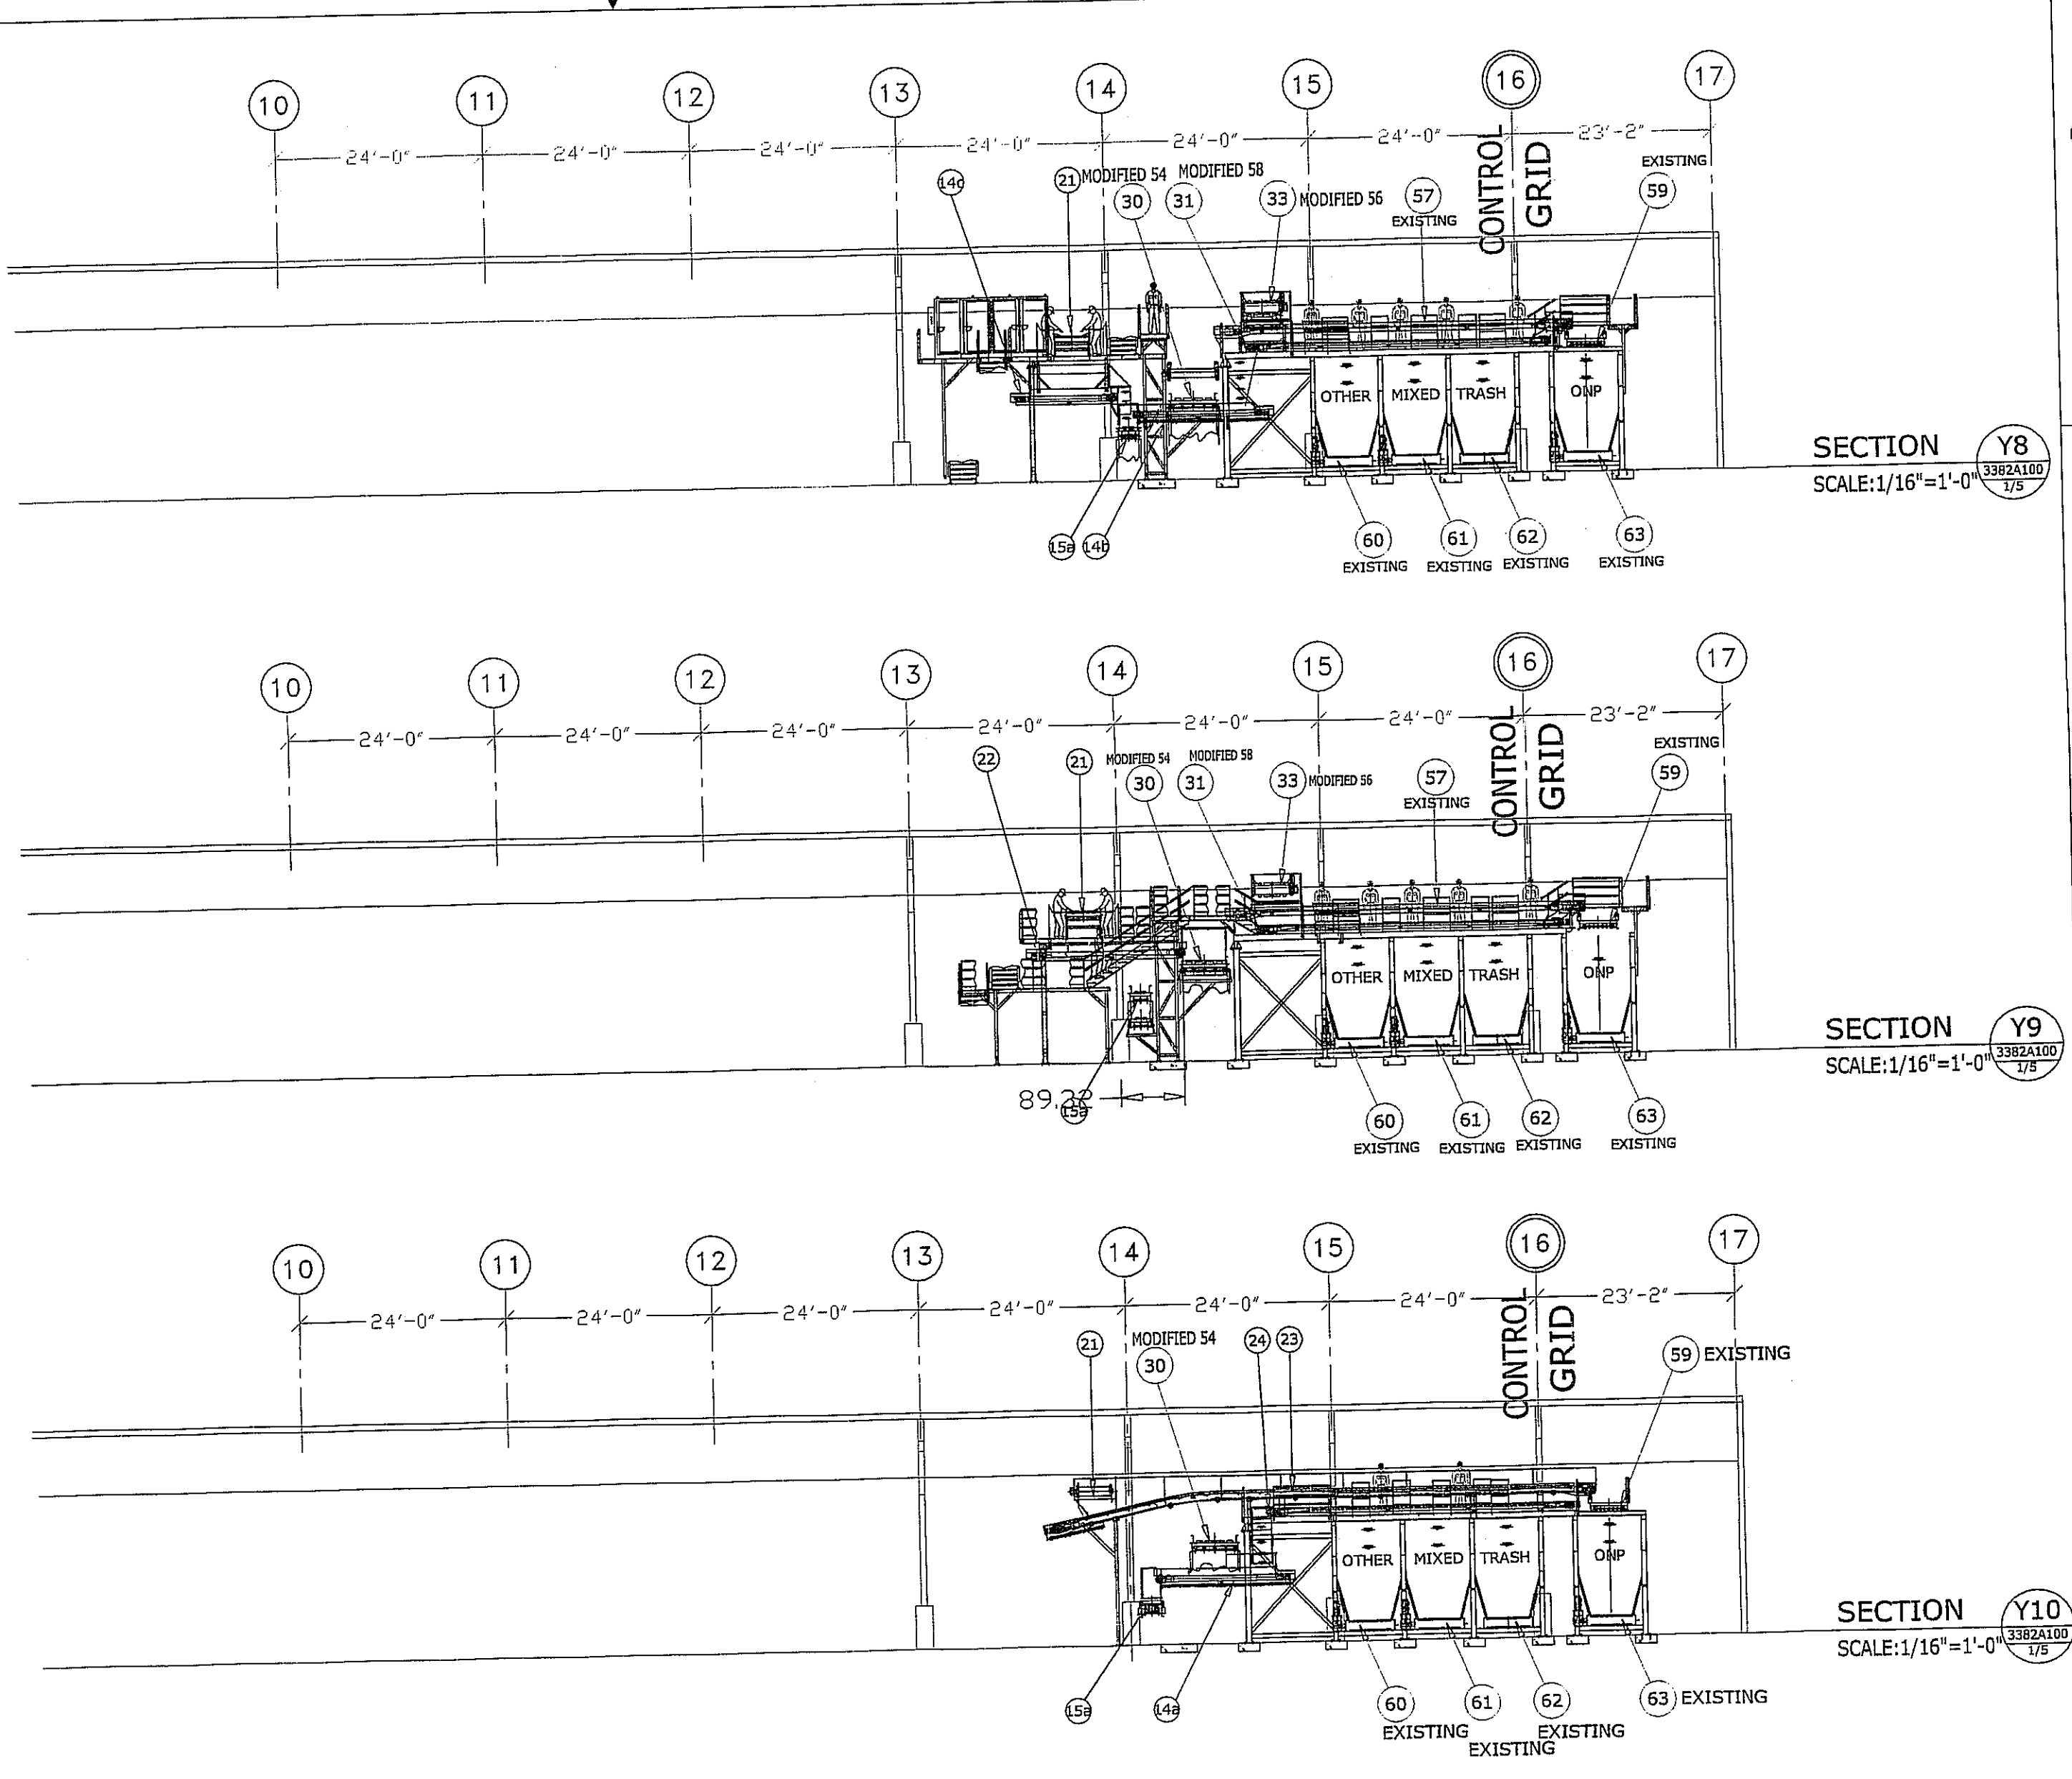


FIBER & CONTAINER SORT SYSTEM
FCR / CASELLA WASTE INC.
HARTFORD - CONNECTICUT - USA
JOB #3382

SYSTEM AS BUILT

NOTICE OF CONFIDENTIALITY: THIS DRAWING IS THE PROPERTY OF CP MANUFACTURING AND IS LOANED SUBJECT TO THE CONDITION THAT IT SHALL NOT BE REPRODUCED, COPIED, LOANED OR OTHERWISE DISPOSED OF DIRECTLY OR INDIRECTLY, IT SHALL BE USED AS A MEANS OF REFERENCE TO WORK FURNISHED BY THIS COMPANY ONLY AND IS NOT TO BE SUBMITTED TO OUTSIDE PARTIES FOR EXAMINATION WITHOUT OUR WRITTEN CONSENT.

SYSTEM LAYOUT-SECTIONS Y8-Y10 AS BUILT		PROJECT NAME AND LOCATION MATERIAL RECOVERY FACILITY FCR / CASELLA WASTE INC. 211 MURPHY ROAD HARTFORD, CT 06114-2105	
CUSTOMER: FCR / CASELLA WASTE INC.	ENGINEER: H.D./B.B./G.A.	DATE: 04/07/08	SHEET NO: 3 OF 5
CUSTOMER APPROVAL:	APPROVED BY:	SCALE: 1/16"=1'0"	DRAWING NO: 3382A100


CP MANUFACTURING INC.
 1300 WILSON AVENUE - NATIONAL CITY, CA 91950
 PHONE: 619-477-3175 FAX: 619-477-3426

REV	DESCRIPTION	DATE	BY
1	INITIAL RELEASE FOR CUSTOMER REVIEW AND APPROVAL	SEE SWG DATE	DR/GA
2	ADDED STAIR ACCESS ITEM REAR PROJECT COMPLETE.	11/06/08	DM
3	-	///	-
4	-	///	-
5	-	///	-
6	-	///	-