

# What Powers You

March 29, 2024

Melanie Bachman, Esq.  
Executive Director  
Connecticut Siting Council  
10 Franklin Square  
New Britain, CT 06051

RE: Bloom Energy Corporation, **Notice of Exempt Modification Pursuant to RCSA 16-50j-57(a)** to Existing Fuel Cell Energy Facility Site at The Home Depot, 75 Frontage Road, East Haven, CT 06512 (“Notice of Exempt Modification”)

Dear Ms. Bachman:

This letter is to hereby notify the Connecticut Siting Council of Bloom Energy Corp.’s intent to undertake an exempt modification, in accordance with Section 16-50f-57(a) of the Regulations of Connecticut State Agencies (“RCSA”), for the necessary upgrade to Bloom’s fuel cell energy server system at **The Home Depot, located at 75 Frontage Road, East Haven, CT 06512**

## Proposed Modification

The existing facility consists of one (1) 200kw Bloom Energy ES-5700 Energy Server, now reaching the end of its service life. Specifications for the existing equipment and new equipment to be installed are provided in Attachment 1. As-builts showing the existing facility layout is shown in Attachment 2. There will be no changes to the site footprints, layouts, or utility routing as Bloom plans to replace all components in kind.

Bloom Energy proposes the following modifications to the facility:

1. Disconnect existing servers from the natural gas source, water source, supervisory control and data acquisition, and electricity systems.
2. Remove the existing fuel cell servers.
3. Install one (1) current generation fuel cell server (Model No. ES5-1650US0301S-NASY4N-0) on existing concrete pad or skid at the site (direct replacement in kind).
4. Install new server repower components.

The proposed modification would not have a substantial adverse environmental effect or cause a significant adverse change or alteration in the physical or environmental characteristics of the facility because:



Bloom Energy Corporation  
4353 North First Street, San Jose, CA 95134  
**408 543 1500**  
[www.bloomenergy.com](http://www.bloomenergy.com)

# What Powers You


- a. The modification does not extend the boundaries of the site beyond the existing compound and will not impair the structural integrity of the facility.
- b. The modification does not increase the height of the existing associated equipment.
- c. The modification will not increase noise levels at the site boundary or to levels that exceed state and local criteria.
- d. Electric and magnetic field levels at the site will not be affected by the modifications due to low or no change in export of power from site.
- e. No endangered, threatened, or sensitive species are within the vicinity of the facility per NDDB.
- f. The modifications would not affect any waterways or wetlands and the facility is not located in a flood zone.

Construction start is expected to begin on June 27<sup>th</sup>, 2024 and will be completed within 4-6 weeks.

Bloom will provide the Council with an original and two copies of this notice, including the required \$625 filing fee. A copy of this notice will also be provided to the Town of East Haven Mayor and the property owners representative, Colin Holloway via electronic mail.

Please let us know if you have any questions or require additional information regarding this notification. Thank you.

Respectfully,

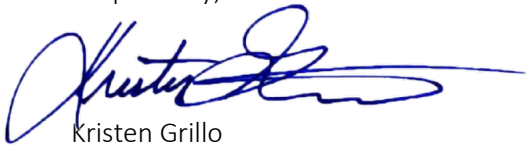

Kristen Grillo

**Senior Permitting Specialist | East Coast Field Office**

Customer Installations Group | North America

(917) 803-4511

[Kristen.Grillo@bloomenergy.com](mailto:Kristen.Grillo@bloomenergy.com)

CC: Joseph Carfora, Town of East Haven Mayor  
Colin Holloway, The Home Depot



Bloom Energy Corporation  
4353 North First Street, San Jose, CA 95134  
**408 543 1500**  
[www.bloomenergy.com](http://www.bloomenergy.com)

**Attachment 1: Bloom Energy Model Datasheets**



## ES-5700

*Clean, Reliable, Affordable Energy*



### **CLEAN, RELIABLE POWER ON DEMAND**

Bloom Energy's ES-5700 delivers clean power that reduces emissions and energy costs. The modular architecture enables the installation to be tailored to the actual electricity demand, with a flexibility to add servers as the load increases. The ES-5700 actively communicates with Bloom Energy's network operations centers so system performance can be monitored and maintained 24 hours per day, 365 days per year.

### **INNOVATIVE TECHNOLOGY**

Utilizing patented solid oxide fuel cell (SOFC) technology, the ES-5700 produces combustion-free power at unprecedented efficiencies, meaning it consumes less fuel and produces less CO<sub>2</sub> than competing technologies. Additionally, no water is needed under normal operating conditions.

### **ALL-ELECTRIC POWER**

The ES-5700, which operates at a very high electrical efficiency, eliminates the need for complicated and costly CHP systems. Combining the standard electrical and fuel connections along with compact footprint and sleek design, the ES-5700 is the most deployable fuel cell on the market.

### **CONTROLLED AND PREDICTABLE COST**

By providing efficient on-site power generation, the economic and environmental benefits are central to the ES-5700 value proposition. Bloom Energy customers can lock in their long term energy costs and mitigate the risk of electricity rate increases. The ES-5700 has been designed in compliance with a variety of safety standards and is backed by a comprehensive warranty.

### **About Bloom Energy**

Bloom Energy is making clean, reliable energy affordable. Our unique on-site power generation systems utilize an innovative fuel cell technology with roots in NASA's Mars program. By leveraging breakthrough advances in materials science, Bloom Energy systems are among the most efficient energy generators, providing for significantly reduced operating costs and dramatically lower greenhouse gas emissions. Bloom Energy Servers are currently producing power for many Fortune 500 companies including Apple, Google, Walmart, AT&T, eBay, Staples, as well as notable non-profit organizations such as Caltech and Kaiser Permanente.

### **Headquarters:**

Sunnyvale, California

### **For More Information:**

[www.bloomenergy.com](http://www.bloomenergy.com)

# ES-5700

## Technical Highlights

### Outputs

Nameplate power output (net AC)	210 kW
Base load output (net AC)	200 kW
Electrical connection	480 V, 3-phase, 60 Hz

### Inputs

Fuels	Natural gas, directed biogas
Input fuel pressure	15 psig
Water	None during normal operation

### Efficiency

Cumulative electrical efficiency (LHV net AC)	52-60%
Heat rate (HHV)	6,295-7,264 Btu/kWh

### Emissions

NO <sub>x</sub>	< 0.01 lbs/MWh
SO <sub>x</sub>	Negligible
CO	< 0.10 lbs/MWh
VOCs	< 0.02 lbs/MWh
CO <sub>2</sub> @ stated efficiency	735-849 lbs/MWh on natural gas; carbon neutral on directed biogas

### Physical Attributes and Environment

Weight	19.4 tons
Dimensions	26' 5" x 8' 7" x 6' 9"
Temperature range	-20° to 45° C
Humidity	0% - 100%
Seismic vibration	IBC site class D
Location	Outdoor
Noise	< 70 dBA @ 6 feet

### Codes and Standards

Complies with Rule 21 interconnection and IEEE1547 standards
Exempt from CA Air District permitting; meets stringent CARB 2007 emissions standards
Product listed by Underwriters Laboratories Inc. (UL) to ANSI/CSA America FC 1-2004

### Additional Notes

Access to a secure website to monitor system performance & environmental benefits
Remotely managed and monitored by Bloom Energy
Capable of emergency stop based on input from the site



Bloom Energy Corporation  
1299 Orleans Drive  
Sunnyvale CA 94089  
T 408 543 1500  
www.bloomenergy.com

## Energy Server 5.5

Always On, Clean Energy  
Using Patented Solid Oxide  
Fuel Cell Technology



The Energy Server 5 provides combustion-free electric power with these benefits



### Clean

Our systems produce near zero criteria pollutants (NOx, SOx, and particulate matter) and far fewer carbon emissions than legacy technologies.



### Reliable

Bloom Energy Servers are designed around a modular architecture of simple repeating elements. This enables us to generate power 24 x 7 x 365 and can be configured to eliminate the need for traditional backup power equipment.



### Resilient

Our system operates at very high availability due to its fault-tolerant design and use of the robust natural gas pipeline system. Bloom Energy Servers have survived extreme weather events and other incidences and have continued providing power to our customers.



### Simple Installation and Maintenance

Our Energy Servers are 'plug and play' and have been designed in compliance with a variety of safety standards. Bloom Energy manages all aspects of installation, operation and maintenance of the systems.

## Energy Server 5.5

## Technical Highlights (E55-1650US0301S-NASY14-0)

### Outputs

Nameplate power output (net AC)	165kW
Load output (net AC)	165kW
Electrical connection	480V, 3-phase, 60Hz

### Inputs

Fuels	Natural gas
Input fuel pressure	12-18 psig (15 psig nominal)12-18 psig (15 psig nominal)Natural gas
Water	None during normal operation

### Efficiency

Cumulative electrical efficiency (LHV net AC) <sup>1</sup>	65-53%
Heat rate (HHV)	5,811-7,127 Btu/kWh

### Emissions<sup>2</sup>

NOx	0.0017 lbs/MWh
SOx	Negligible
CO	0.034 lbs/MWh
VOCs	0.0159 lbs/MWh
CO <sub>2</sub> @ stated efficiency	679-833 lbs/MWh on natural gas; carbon neutral on directed biogas

### Physical Attributes and Environment

Weight	9.9 tons
Dimensions (variable layouts)	10'9" x 8'8" x 7'0" or 21'6" x 4'4" x 6'9"
Temperature range	-20° to 45° C
Humidity	0%-100%
Seismic vibration	IBC site class D
Location	Outdoor
Noise	<70 dBA @ 6 feet

### Codes and Standards

Complies with Rule 21 interconnection and IEEE1547 standards

Exempt from CA Air District permitting; meets stringent CARB 2007 emissions standards

An Energy Server is a Stationary Fuel Cell Power System. It is Listed by Underwriters Laboratories, Inc. (UL) as a 'Stationary Fuel Cell Power System' to ANSI/CSA FC1-2014 under UL Category IRGZ and UL File Number MH45102.

### Additional Notes

Access to a secure website to monitor system performance & environmental benefits

Remotely managed and monitored by Bloom Energy

Capable of emergency stop based on input from the site

<sup>1</sup> 65% LHV efficiency verified by ASME PTC 50 Fuel Cell Power Systems Performance Test

<sup>2</sup> NOx and CO measured per CARB Method 100, VOCs measured as hexane by SCAQMD Method 25.3

### About Bloom Energy

Bloom Energy's mission is to make reliable, clean energy affordable for everyone in the world. The company's product, the Bloom Energy Server, delivers highly reliable and resilient, Always On electric power that is clean and sustainable. Bloom's customers include twenty-five of the Fortune 100 companies and leaders in cloud services and data centers, healthcare, retail, financial services, utilities and many other industries.

Bloom Energy

4353 North First Street  
San Jose, CA 95134

T 408 543 1500  
F 408 543 1501


info@bloomenergy.com  
www.bloomenergy.com

Be

© Bloom Energy Corporation 2019. All Rights Reserved  
DOC-1015936 Rev B

**Attachment 2: As-Built Site Plan**





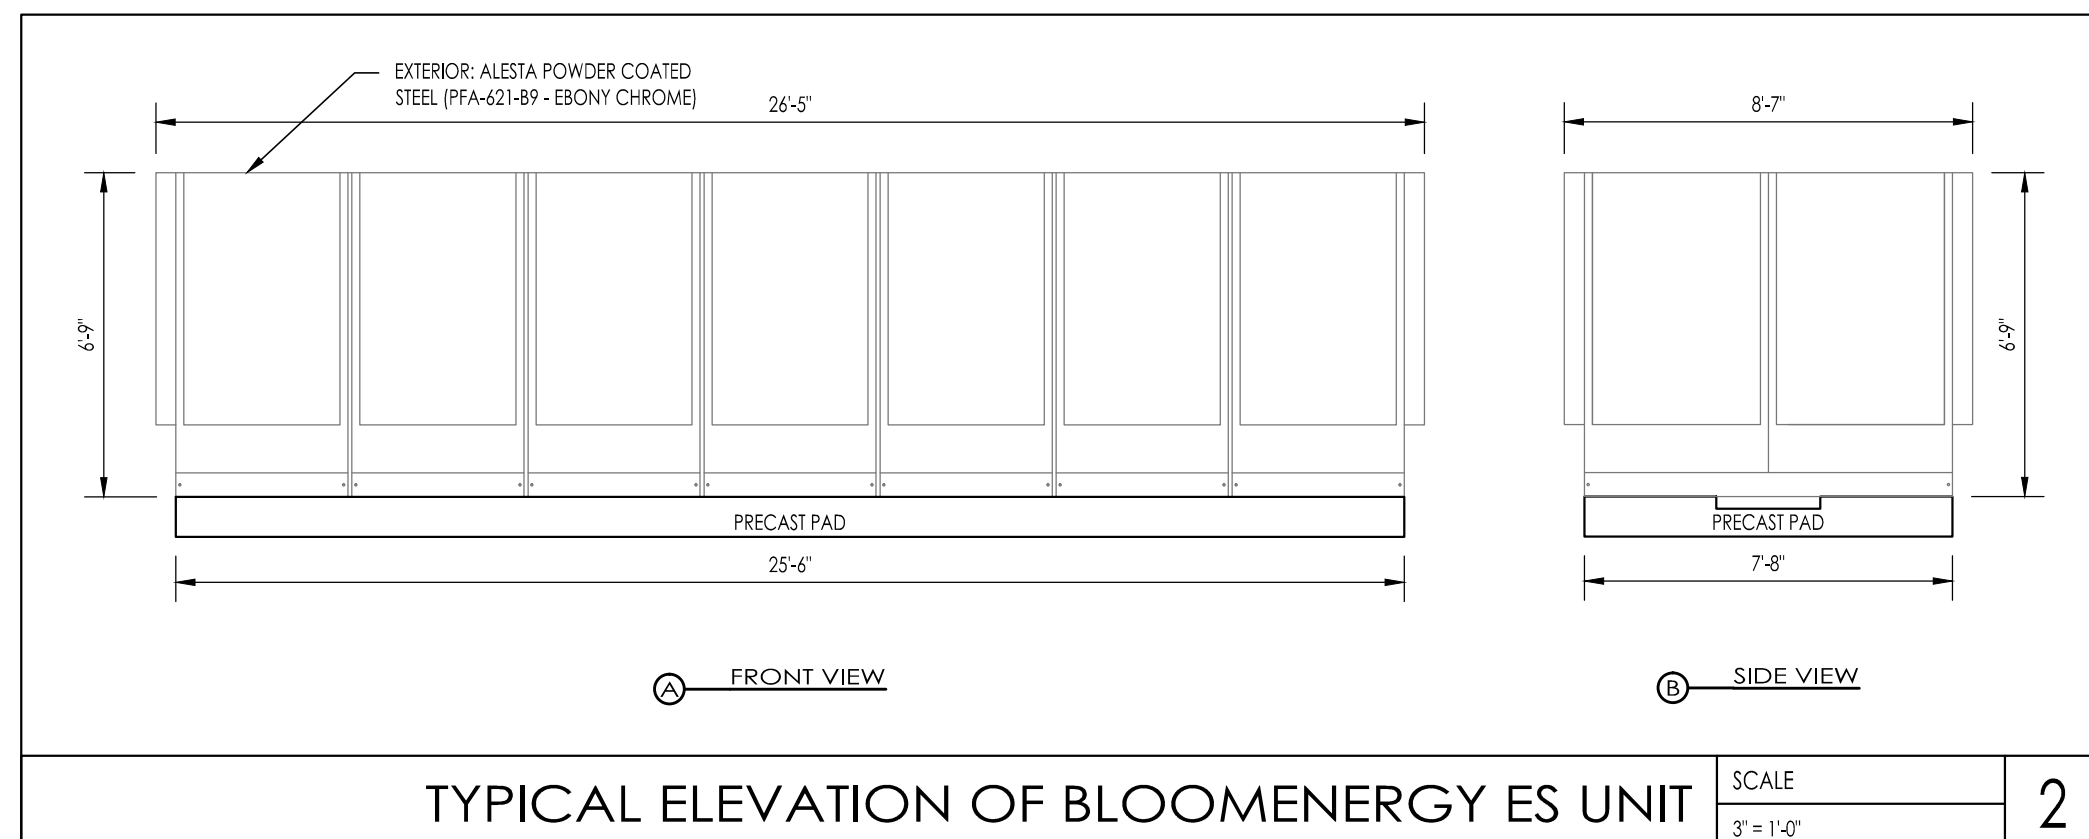


**BLOOMENERGY ES-5700 SPECIFICATION**

SCALE: NTS

3

SYSTEM		
Output Power	210 kW	Total System Weight
Voltage	480 VAC	Weight - Fuel Cell Power Module x 6
Maximum Output Current	252 A rms	Weight - Input Output Module x 1
Frequency	60 Hz	
FUEL REQUIREMENTS		
Connection	1" FNPT	Pressure
Fuel Type	Natural Gas	Max Consumption Rate @60° Fahr:
		2MMBtu/hr
WATER REQUIREMENTS		
Connection	1.2" MNPT	Flow - Startup
Quality	Municipal Grade	Flow - Continuous
Minimum Pressure	30 PSI	Water D Storage
		0 gpm/hr
ELECTRICAL REQUIREMENTS		
Connection - 50kV DATA	4-1/2 Female	Connection - Power
Cable Type	CAT-5e	Cable Type
Speed	70 Kbps/each	Cable Size - Power
Conduit Size	1"	Cable Size - Ground
		Cond at 5.25"
Connection - Heater Tape	120VAC	
Cable Type	12/2 AWG	
Conduit Size		

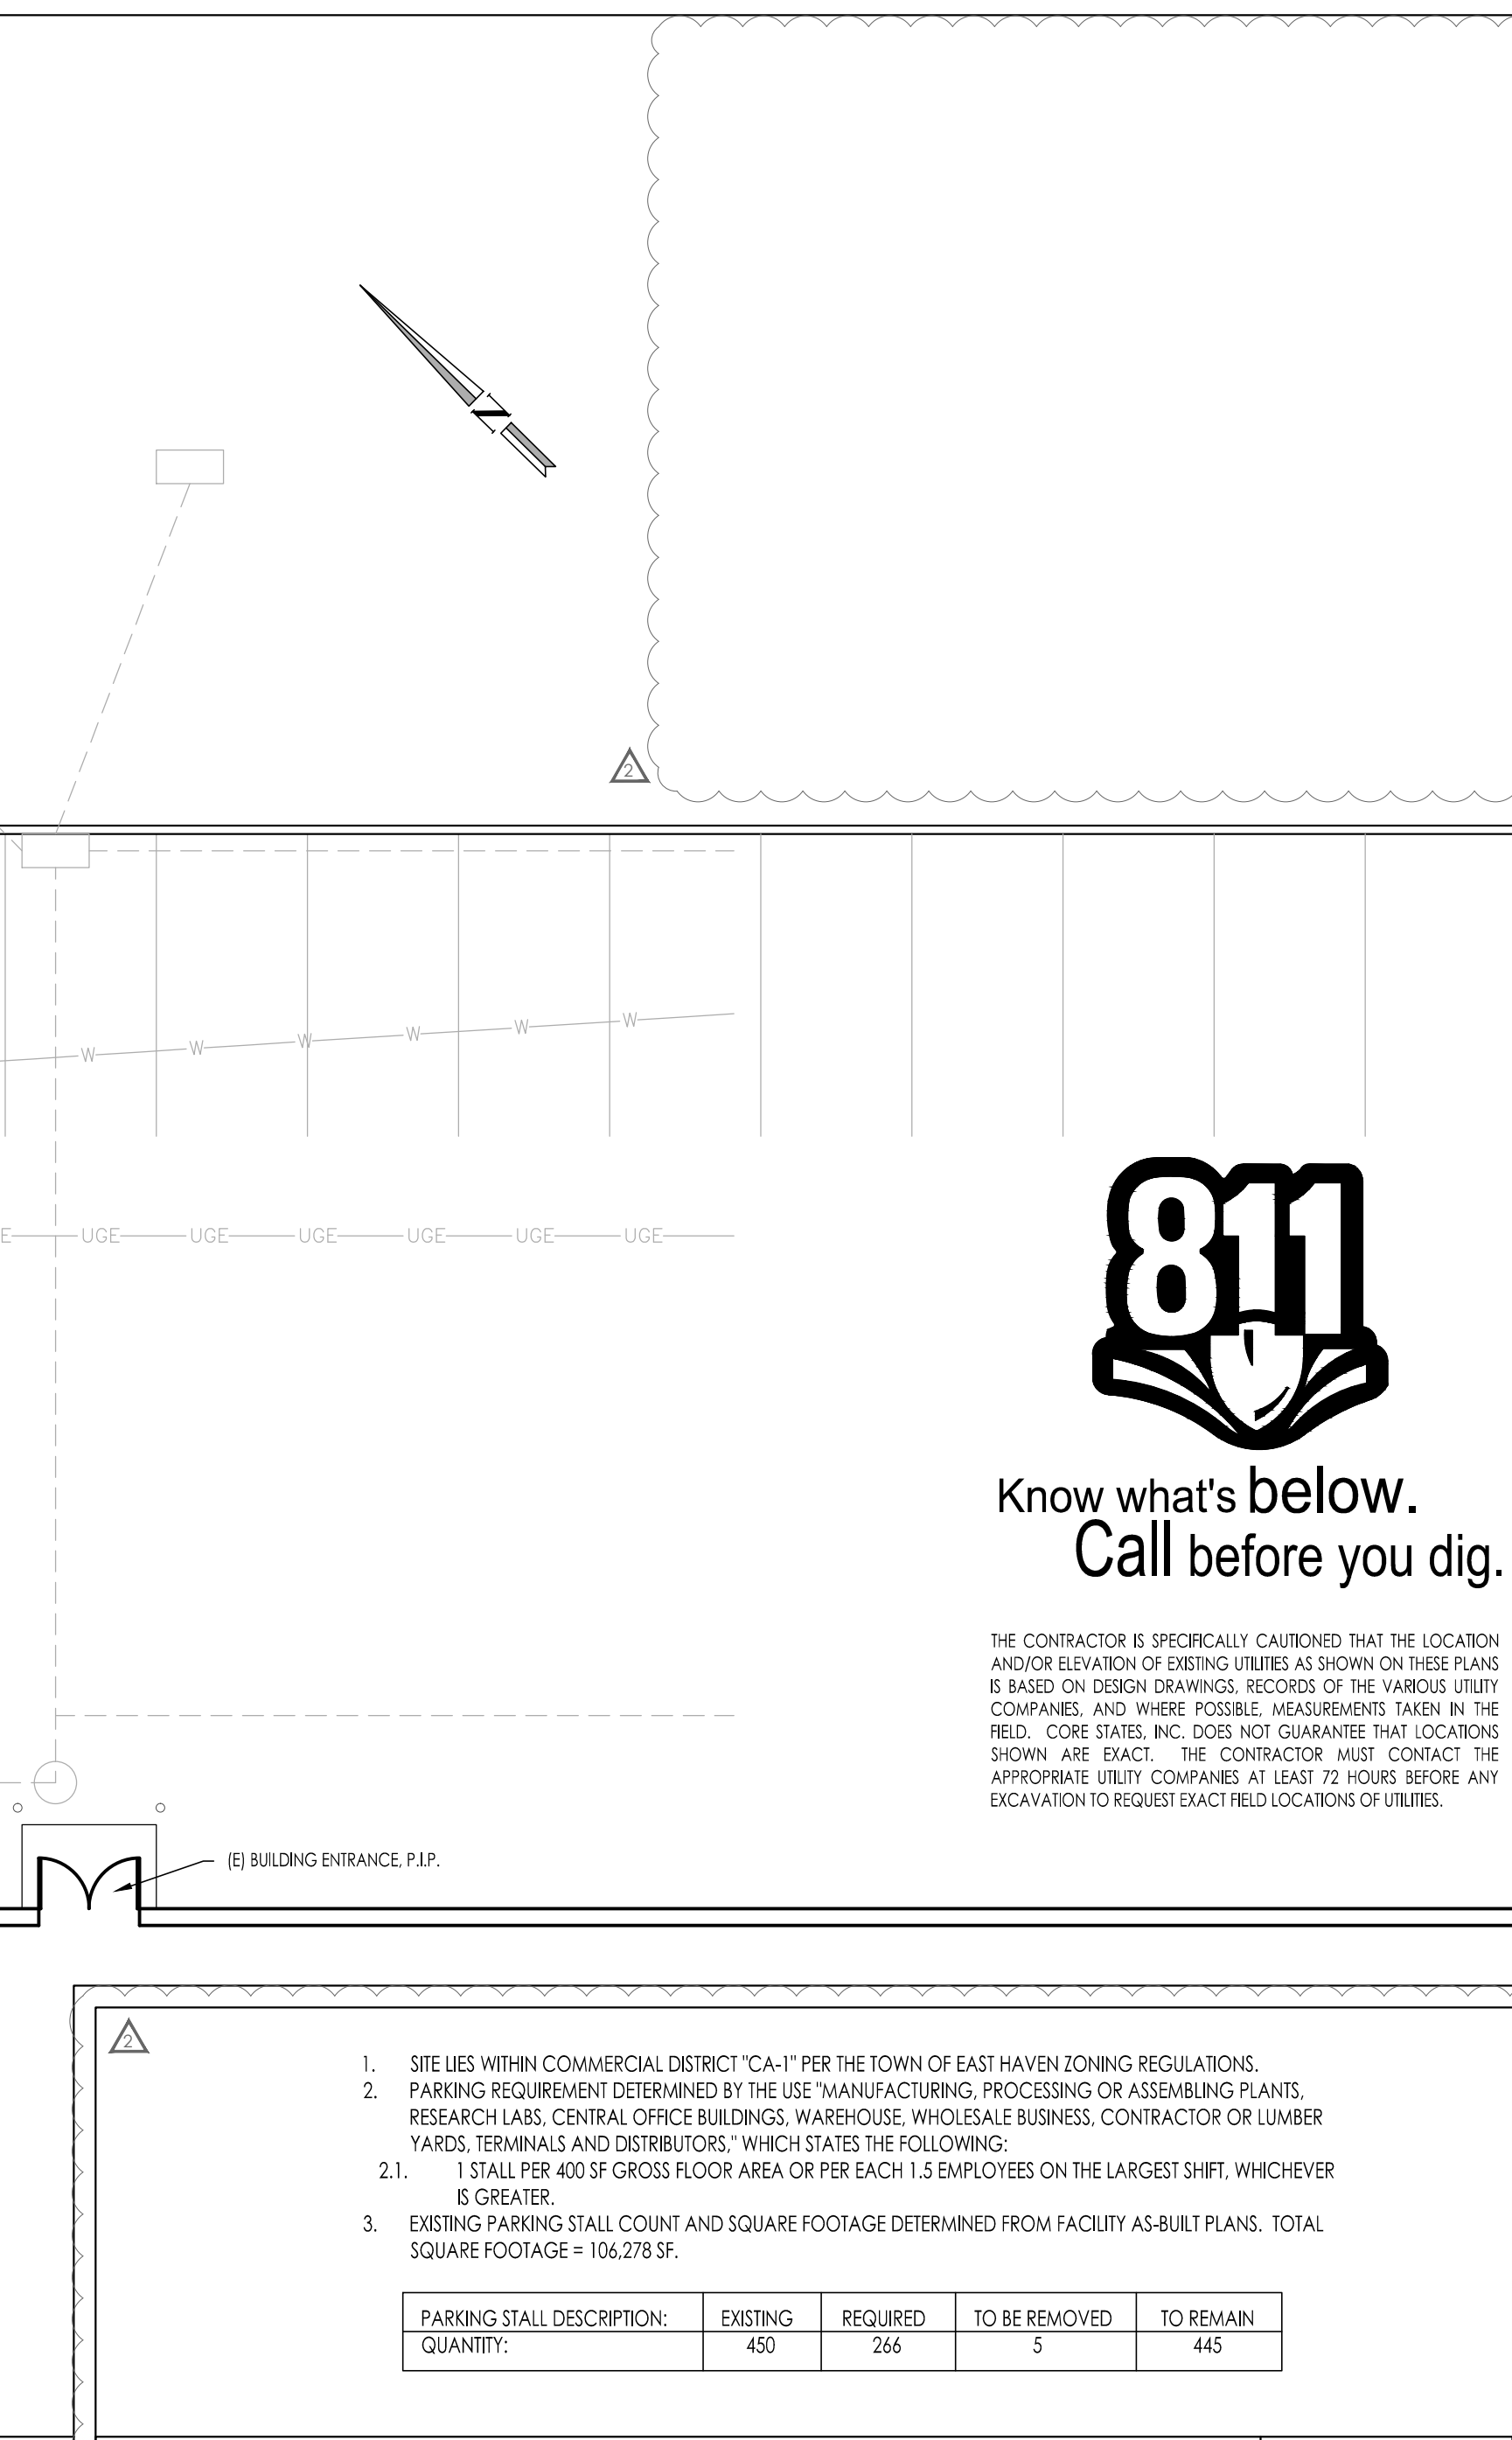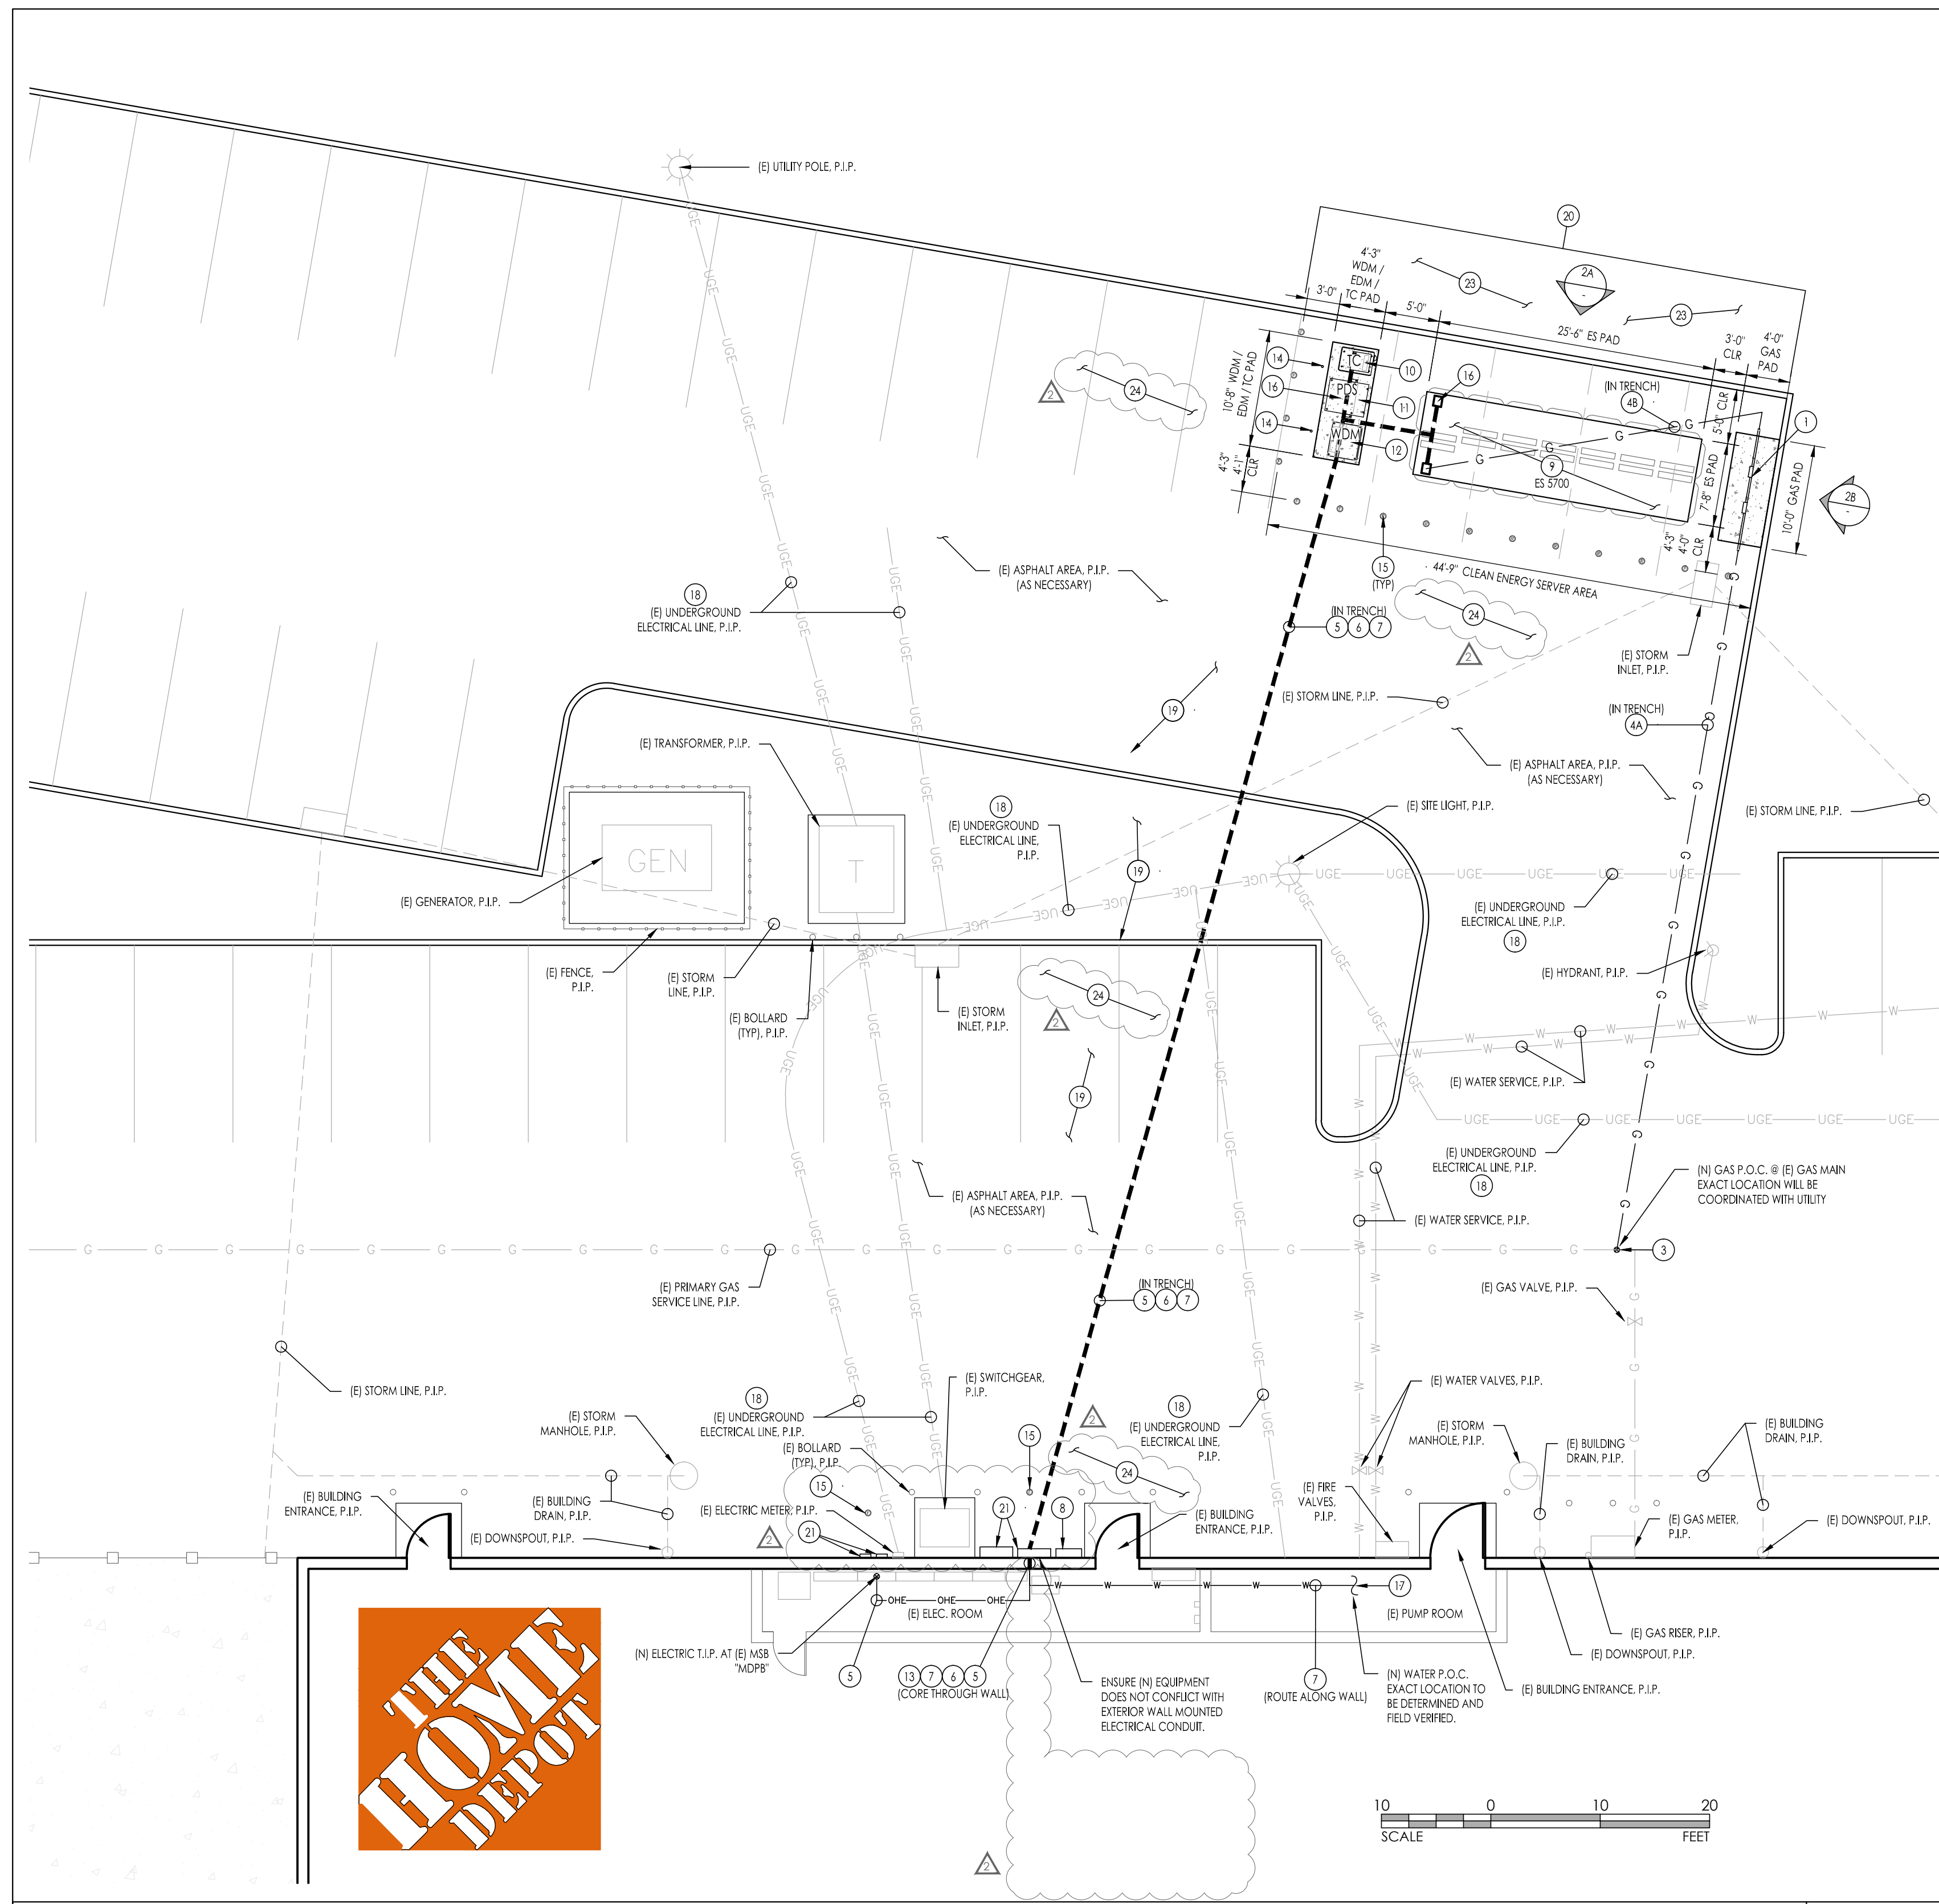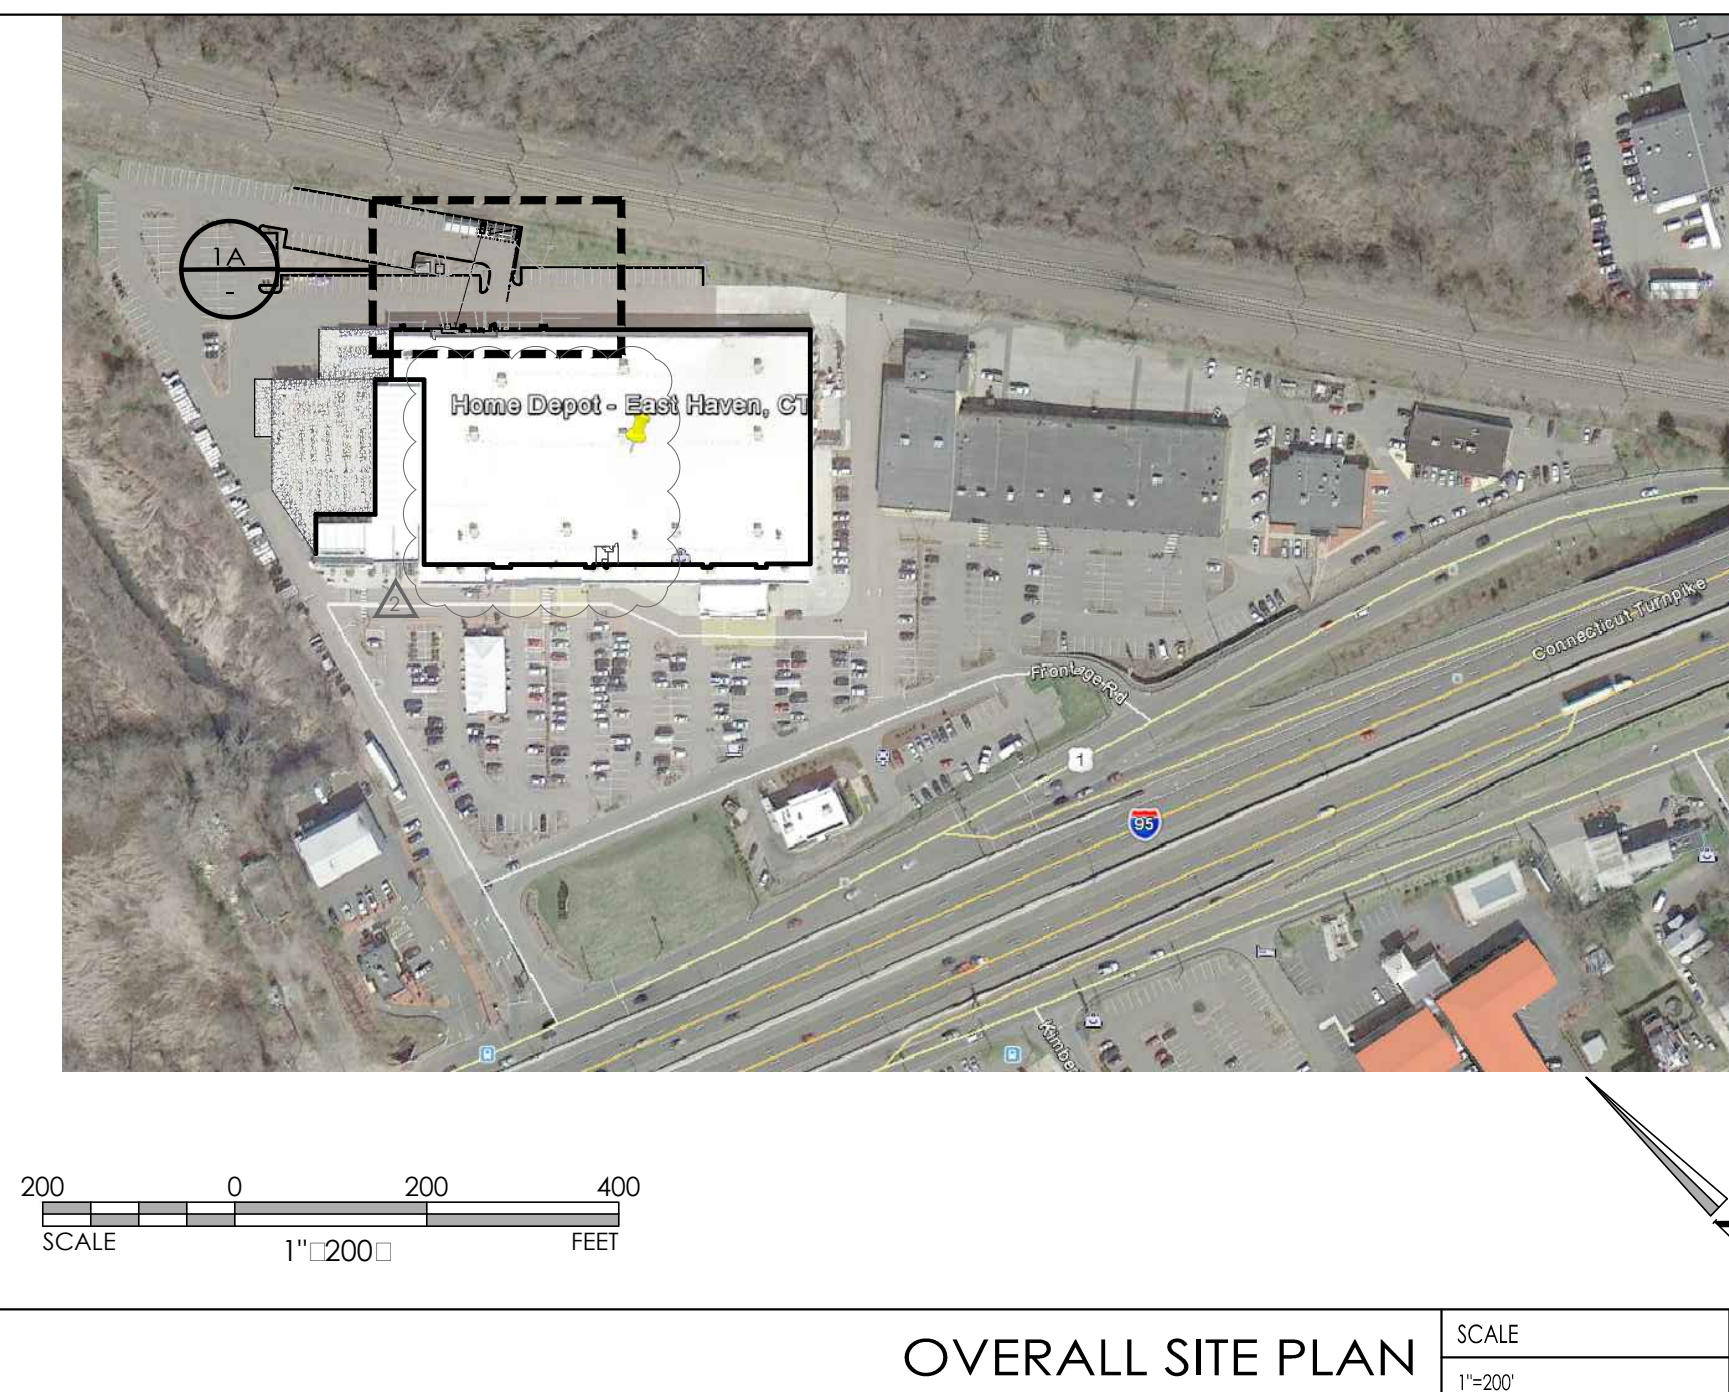

**RESPONSIBILITY NOTES**

- THE FOLLOWING EQUIPMENT SHOWN ON THESE PLANS WILL BE PROVIDED AND DELIVERED BY BLOOM ENERGY. APPLICABLE TRADES TO MOUNT AND MAKE FINAL CONNECTIONS:
  - WATER DEIONIZATION MODULE (WDM)
  - POWER DISTRIBUTION SECTION (PDS)
  - TELEMETRY CABINET (TC)
  - SIGNAGE (SEE SAFETY SIGNAGE)
  - SITE KIT (SEE SITE KIT NOTES)
- THE FOLLOWING EQUIPMENT SHOWN ON THESE PLANS WILL BE PROVIDED, DELIVERED AND MOUNTED BY BLOOM ENERGY. APPLICABLE TRADES TO MAKE FINAL CONNECTIONS:
  - CLEAN ENERGY SERVER
  - PRECAST SUPPORT PADS (SEE SHEET 1 OF 1)

**SITE KIT NOTES**

- BLOOMENERGY TO PROVIDE AND DELIVER THE SITE KIT.
- ELECTRICAL AND PLUMBING CONTRACTOR TO INSTALL SITE KITS, CONSISTING OF PAD PLUMBING AND BUS BARS, ON THE PRECAST CONCRETE PAD PER MANUFACTURER SPECIFICATIONS.
- PWM DEFLECTORS ARE NOT REQUIRED FOR THIS SITE.

**UTILITIES**

GAS: SOUTHERN CONNECTICUT GAS (SCG)  
ELECTRIC: UNITED ILLUMINATING COMPANY (UIC)

**CONDUIT & PIPE LENGTHS**

TYPE	TOTAL DISTANCE FROM TRIN TO ES UNIT (LINEAR)
GAS PIPE	±110'
ELECTRICAL CONDUIT	±140'
DATA CONDUIT	±125'
WATER PIPE	±155'

**LEGEND OF UTILITY LINES**

DATA	DATA LINE	SA	SANITARY LINE
FENCE	FENCE LINE	ST	STORM LINE
OPTICS & PHONE	FIBER OPTICS & PHONE	TV	TELEVISION LINE
G	GAS LINE	UG	UNDERGROUND ELECT.
JT	JOINT TRENCH	UG	UNDERGROUND WATER LINE
OE	OVERHEAD ELECTRICAL		

- KEYNOTES**
- (N) UTILITY GAS METER SET ASSEMBLY (MSA) FOR CLEAN ENERGY SERVER. COORDINATE LOCATION AND INSTALLATION REQUIREMENTS WITH UTILITY COMPANY PRIOR TO INSTALLATION. MAINTAIN MINIMUM 3'-0" CLEARANCE FROM ALL IGNITION SOURCES. CONTRACTOR TO PROVIDE CAST-IN-PLACE PAD PER GAS ASSEMBLY PAD (DETAIL 3/3.0), MSA & INTERCONNECTION PER NATURAL GAS DIAGRAM (DETAIL 1/5.0). ADD IMPACT PROTECTION AS INDICATED BY UTILITY COMPANY.
  - NOT USED
  - (N) GAS SERVICE TAP BY UTILITY COMPANY. EXACT LOCATION TO BE COORDINATED WITH UTILITY COMPANY. REQUIREMENTS PER UTILITY COMPANY.
  - (N) GAS PIPE FROM (N) GAS SERVICE TAP TO TERMINATE AT (N) UTILITY GAS MSA INSTALLED BY UTILITY COMPANY. SIZE AND TRENCHING REQUIREMENTS PER UTILITY COMPANY.
  - (N) GAS PIPE FROM (N) MSA TO (N) ES UNIT INSTALLED BY CONTRACTOR. DETAILS PER GRADING PLAN (SHEET 3.0), SIZES PER INTERCONNECTION DIAGRAM (SHEET 5.0).
  - (N) ELECTRICAL CONDUIT & WIRES FROM (N) PDS TO (N) DISCONNECT WITH FINAL TERMINATION AT (E) SWITCHBOARD. DETAILS PER GRADING PLAN (SHEET 3.0), SIZES PER ONE LINE DIAGRAM (SHEET 6.1).
  - (N) DATA CONDUIT & PULL STRING FROM (N) TC TO TERMINATE INSIDE BUILDING. DETAILS PER GRADING PLAN (SHEET 3.0), SIZES PER ELECTRICAL DATA DETAILS (SHEET 6.2).
  - (N) WATER PIPE FROM BUILDING DOMESTIC WATER SYSTEM TO (N) WDM. CONNECT TO NEAREST AVAILABLE LOCATION. DETAILS PER GRADING PLAN (SHEET 3.0), SIZES PER INTERCONNECTION DIAGRAM (SHEET 5.0).
  - (N) DISCONNECT SWITCH & NEMA 3R ENCLOSURE. DISCONNECT SPECIFICATIONS PER ONE LINE DIAGRAM (SHEET 6.1). MOUNT TO BUILDING WALL AND PER MANUFACTURER SPECIFICATIONS. ENSURE LOCATION MEETS ALL REQUIRED N.E.C. CLEARANCES. PROVIDE MODEL NUMBER ON THE OUTSIDE OF THE FRONT PANEL. COMPLETE SPECIFICATION PER ELECTRICAL SPECIFICATIONS (SHEET 8.0) SECTION 16A.2-6.
  - (N) BLOOMENERGY ES-5700 ENERGY SERVER. PRECAST PAD AND MOUNTING SPECIFICATIONS PER PRECAST SUPPORT PADS. PAD PLACEMENT PER GRADING PLAN (SHEET 3.0). PIPE & CONDUIT STUB-UP LOCATIONS PER PIPE PLAN & DETAILS (SHEET 4.0) AND ELECTRICAL CONDUIT DETAILS (SHEET 6.3), RESPECTIVELY.
  - (N) BLOOMENERGY TELEMETRY CABINET (TC) WITH FACTORY WIRED CLEAN ENERGY SERVER EMERGENCY POWER-OFF SWITCH (EPO). CAST-IN-PLACE PAD & MOUNTING SPECIFICATIONS PER GRADING PLAN (SHEET 3.0). CONDUIT STUB UP LOCATIONS PER ELECTRICAL CONDUIT DETAILS (SHEET 6.3).
  - (N) POWER DISTRIBUTION SECTION (PDS). CAST-IN-PLACE PAD AND MOUNTING SPECIFICATIONS PER GRADING PLAN (SHEET 3.0). CONDUIT STUB-UP LOCATIONS PER ELECTRICAL CONDUIT DETAILS (SHEET 6.3).
  - (N) WATER DEIONIZATION MODULE (WDM). CAST-IN-PLACE PAD AND MOUNTING SPECIFICATIONS PER GRADING PLAN (SHEET 3.0). PIPE & CONDUIT STUB-UP LOCATIONS PER PIPE DETAILS (SHEET 4.0) & ELECTRICAL CONDUIT DETAILS (SHEET 6.3), RESPECTIVELY.
  - CORE CONDUIT AND/OR PIPE THROUGH WALL. SCAN WALL PRIOR TO CORING. REFER TO DETAIL 6/3.1.
  - (N) 10'-0" COPPER GROUNDING RODS 6'-0" APART. SPECIFICATIONS PER ONE LINE DIAGRAM (SHEET 6.1).
  - (N) GUARD POST (GP). TYPE, SIZE AND LOCATION PER IMPACT PROTECTION PLAN (SHEET 3.2). ENSURE SEVERE IS FLUSH WITH GRADE AND NO ANGLES OR HOOKS EXIST THAT IMPEDE FORKlift ACCESS.
  - PROVIDE SECURITY BOXES OF CONDUIT & WIRE AT ALL ELECTRICAL STUB-UP LOCATIONS.
  - (N) WATER TAP. IF PRESSURE EXCEEDS 150 PSI. COORDINATE WITH BLOOMENERGY. PURCHASE AND INSTALL PRESSURE REGULATOR PRIOR TO WDM.
  - THE FUNCTION, LOCATION AND ACTIVITY STATUS (LIVE / ABANDONED) OF ALL ELECTRICAL LINES IS UNCERTAIN. PLAN SHOWS APPROXIMATE LOCATIONS / BEST GUESSES. EXTRA PRECAUTION SHOULD BE TAKEN DURING EXCAVATION AND TRENCHING.
  - WITHIN THE AREA TO BE TRENCHED / EXCAVATED, (E) ASPHALT, CURB, LANDSCAPING, ETC. TO BE REPAIRED, RECONSTRUCTED, REPLANTED, ETC. TO MATCH EXISTING.
  - (E) PARKING STALLS TO BE REMOVED (3 TOTAL).
  - (N) UTILITY APPROVED METERS AND TC CABINET IN RESPECTIVE NEMA 3R ENCLOSURES. SPECIFICATIONS PER ONE LINE DIAGRAM (SHEET 6.1). MOUNT TO BUILDING WALL AND PER MANUFACTURER SPECIFICATIONS. ENSURE LOCATION MEETS ALL REQUIRED N.E.C. CLEARANCES. COMPLETE SPECIFICATION PER ELECTRICAL SPECIFICATIONS (SHEET 8.0) SECTION 16A.2-6.
  - NOT USED
  - (E) BRUSH TO BE TRIMMED AS NECESSARY. 10'-0" CLEARANCE TO BE MAINTAINED FROM ANY BRANCH TO ES UNIT VENT AND 6'-0" CLEARANCE TO BE MAINTAINED FROM ANY BRANCH TO ES UNIT.
  - HOME DEPOT FACILITY UTILITIES. THESE AREAS FOR PRODUCT STORAGE. COORDINATE WITH TERRI BROPHY TO HAVE AREA CLEARED AS REQUIRED. REFER TO ALL HOME DEPOT GENERAL NOTES ON SHEET 3.0.

Drawing: Bloom Energy/MEC-16032-Home Depot, East Haven, CT | Drawing/MEC-16032-Home Depot, East Haven, CT | 2:30 PM Planning Site Plan  
 User: WJES/ECM  
 Date: 08/28/14 15:45:00  
 Plot Date/Time: 08/28/14 15:45:00



**Know what's below.  
Call before you dig.**

THE CONTRACTOR IS SPECIFICALLY CAUTIONED THAT THE LOCATION AND/OR ELEVATION OF EXISTING UTILITIES AS SHOWN ON THESE PLANS IS BASED ON DESIGN DRAWINGS, RECORDS OF THE VARIOUS UTILITY COMPANIES, AND WHERE POSSIBLE, MEASUREMENTS TAKEN IN THE FIELD. CORE STATES, INC. DOES NOT GUARANTEE THAT LOCATIONS SHOWN ARE EXACT. THE CONTRACTOR MUST CONTACT THE APPROPRIATE UTILITY COMPANIES AT LEAST 72 HOURS BEFORE ANY EXCAVATION TO REQUEST EXACT FIELD LOCATIONS OF UTILITIES.

- SITE LIES WITHIN COMMERCIAL DISTRICT "CA-1" PER THE TOWN OF EAST HAVEN ZONING REGULATIONS.
- PARKING REQUIREMENT DETERMINED BY THE USE "MANUFACTURING, PROCESSING OR ASSEMBLING PLANTS, RESEARCH LABS, CENTRAL OFFICE BUILDINGS, WAREHOUSE, WHOLESALE BUSINESS, CONTRACTOR OR LUMBER YARDS, TERMINALS AND DISTRIBUTORS," WHICH STATES THE FOLLOWING:
  - 1 STALL PER 400 SF GROSS FLOOR AREA OR PER EACH 1.5 EMPLOYEES ON THE LARGEST SHIFT, WHICHEVER IS GREATER
- EXISTING PARKING STALL COUNT AND SQUARE FOOTAGE DETERMINED FROM FACILITY AS-BUILT PLANS. TOTAL SQUARE FOOTAGE = 106,278 SF.

**Bloomenergy**  
 1350 Colchester Drive, Sunnyvale, CA, 94089  
 Tel: 408.543.1501  
 www.bloomenergy.com  
**PROPRIETARY & CONFIDENTIAL**

**GORE STATES GROUP**  
 28 ROBERT BETHLEWOOD  
 WARREN, NJ 07058  
 www.gorestates.com

DOCUMENTS PREPARED BY THIS GROUP, INCLUDING THIS STATE, ARE THE PROPERTY OF CORE STATES GROUP. THESE DOCUMENTS ARE TO BE USED ONLY FOR THE SPECIFIC PROJECT AND FOR THE SPECIFIC USE FOR WHICH THEY WERE PREPARED. NO OTHER PROJECTS, BY OWNER OR BY ANY OTHER PARTY, WITHOUT THE WRITTEN PERMISSION OF CORE STATES GROUP IS TO BE MADE. CORE STATES GROUP IS NOT RESPONSIBLE FOR ANY DAMAGE, INJURY, LOSS, OR HARMFUL CONSEQUENCES THAT SPECIFICALLY INTENDED, USER OR OTHERWISE, FROM ANY OF THESE DOCUMENTS.

**PROJECT INFORMATION**

ISSUE	DATE	DESCRIPTION
02	02/28/14	REVISED PER IFC

JOB # BEC-16032  
 DATE: 01/22/14  
 DRAWN BY: MVM  
 CHECKED BY: TM

MODEL: (1) ES-5700

SHEET TITLE: SITE PLAN

SHEET NUMBER: 2.0

2014.02.28 - ISSUE FOR CONSTRUCTION