



August 7, 2023

Attorney Melanie Bachman
Acting Executive Director
Connecticut Siting Council
Ten Franklin Square
New Britain, CT 06501

EM-T-MOBILE-064-200921

T-Mobile Site ID CT11461B
305 West Service Road, Hartford CT
Notice of Compliance with Conditions and Construction Completion

Dear Attorney Bachman:

The T-Mobile site referenced above was approved by The Connecticut Siting Council (Council) on October 13, 2020 as an Exempt Modification. T-Mobile is now requesting the close out of the approval and hereby acknowledges the following conditions were met:

1. Prior to T-Mobile's antenna installation, the antenna mount modifications shall be installed in accordance with the Mount Analysis prepared by American Tower Corporation, dated August 24, 2020 and stamped and signed by Esha Kaushal Modi;
2. Within 45 days following completion of equipment installation, T-Mobile shall provide documentation certified by a Professional Engineer that its installation complied with the recommendations of the Mount Analysis;
3. Any deviation from the proposed modification as specified in this notice and supporting materials with the Council shall render this acknowledgement invalid;
4. Any material changes to this modification as proposed shall require the filing of a new notice with the Council;
5. Within 45 days after completion of construction, the Council shall be notified in writing that construction has been completed;



6. Any nonfunctioning antenna and associated antenna mounting equipment on this facility owned and operated by T-Mobile shall be removed within 60 days of the date the antenna ceased to function;
7. The validity of this action shall expire one year from the date of this letter; and
8. The applicant may file a request for an extension of time beyond the one year deadline provided that such request is submitted to the Council not less than 60 days prior to the expiration.

The attached PE Closeout Letter dated June 16, 2023 provides evidence of compliance with the conditions outlined by the Council. In addition, T-Mobile hereby notifies the Council that construction of the acknowledged modifications was completed as of January 15, 2021.

Sincerely,

Victoria Massee

Victoria Massee
Zoning and Permitting
Northeast Site Solutions




June 16, 2023

To: Hartford, CT – Department of Developmental Services
260 CONSTITUTION PLAZA
HARTFORD, CONNECTICUT 06103

Re: ATC Site Name: West Service Road
ATC Site Number: 302466
T-Mobile Site Number: CT11491B
ATC Site Address: 305 W. Service Road
Hartford, CT 06120

Reviewed by:

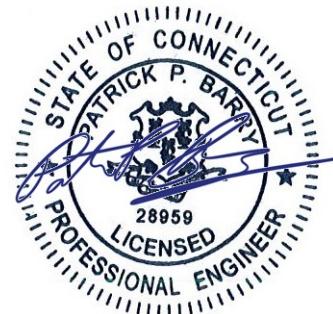

To whom it may concern,

T-Mobile installed at the telecommunications facility at the above location. We have reviewed the provided construction photos and As-Built Drawings and have provided comments on the installation in the following summary. The installation was found to be in compliance with the issued construction drawings and applicable building codes.

Equipment Removed:

- CABINET, (3) ANTENNA(s) AND (3) RRH(s)

Equipment Installed:

- MOUNT MODIFICATIONS, (3) MOUNTING PIPES, (6) ANTENNA(s), (6) RRH(s), (2) 1-1/4" HYBRID CABLES, (1) 6160 AC CABINET AND (1) ENCLOSURE B160 BATTERY CABINET

Discrepancy Note:

- None

Please contact the engineer of record at AE@americantower.com with any questions regarding this matter.

Thank you,

American Tower Corporation

Photo	Description
	<p>Description: Antenna Tape Drop:</p> <ul style="list-style-type: none"> • Installation at RAD 125' <p>Note: Construction drawings depict a RAD of 125'</p> <p>Recommendation: No Action Required</p>
	<p>Description: Installation of Equipment:</p> <ul style="list-style-type: none"> • 6160 AC Cabinet <p>Recommendation: No Action Required</p>
	<p>Description: Installation of Equipment:</p> <ul style="list-style-type: none"> • Cabinet Install <p>Recommendation: No Action Required</p>

	<p>Description: Installation of Equipment:</p> <ul style="list-style-type: none"> • Battery Cabinet <p>Recommendation: No Action Required</p>
 <p>Capture Time: Friday, January 15, 2021 12:25 PM Upload Time: Friday, January 15, 2021 12:26 PM (UTC -5:00) Lat: 41.7994472 Long: -72.6568306</p>	<p>Description: Installation of Equipment:</p> <ul style="list-style-type: none"> • Alpha Sector 1 Antenna + 2 RRH units <p>Recommendation: No Action Required</p>
 <p>Capture Time: Friday, Jan 15, 2021 12:24:16 PM Upload Time: Friday, January 15, 2021 12:24:17 PM (UTC -5:00) Lat: 41.7995518 Long: -72.656699</p>	<p>Description: Installation of Equipment:</p> <ul style="list-style-type: none"> • Alpha Sector additional Antenna <p>Recommendation: No Action Required</p>



AMERICAN TOWER®
CORPORATION

	<p>Description: Installation of Equipment: • Hybrid Cable</p> <p>Recommendation: No Action Required</p>
	<p>Description: Installation of Equipment: • Beta 1 Antenna + 2 RRH units • Bracing Pipe 1ft from CL • 5ft Bracing Pipe</p> <p>Recommendation: No Action Required</p>
	<p>Description: Installation of Equipment: • Beta Sector – Additional antenna • Bracing Pipe 4ft from CL</p> <p>Recommendation: No Action Required</p>



AMERICAN TOWER®
CORPORATION

 <p>Capture Time: Friday, January 15, 2021 12:55 PM Upload Time: Friday, January 15, 2021 12:56 PM (UTC -5:00) Lat: 41.7012 Long: -72.655861</p>	<p>Description: Installation of Equipment:</p> <ul style="list-style-type: none">• Gamma Sector 2 Antennas and 2 RDU units <p>Recommendation: No Action Required</p>
 <p>Capture Time: Friday, January 15, 2021 12:45 PM Upload Time: Friday, January 15, 2021 12:46 PM (UTC -5:00) Lat: 41.700528 Long: -72.659077</p>	<p>Description: Installation of Equipment:</p> <ul style="list-style-type: none">• Mount alteration, additional detail <p>Recommendation: No Action Required</p>



AMERICAN TOWER®
A.T. ENGINEERING SERVICE, PLLC

3500 REGENCY PARKWAY
SUITE 5100

COVINGTON, GA 30014

PHONE: (678) 482-4112


FAX: (678) 482-5553

These drawings under the accompanying specification instruments or service, are the exclusive property of American Tower, their use and reproduction, in whole or in part, is prohibited without the written consent of American Tower. For engineering services, a copy of the contract or agreement shall be furnished to American Tower. Any other document, drawing, or other material which relates to American Tower or the specified carrier, strictly prohibited. Title to American Tower is held by American Tower whether or not the project is executed. Neither the architect nor the engineer is entitled to receive payment for services rendered on this project. Contractors must verify all dimensions and advise American Tower of any discrepancies, any changes in the drawings or any omissions. Any changes in the drawings or any omissions must be made by the engineer and filed with American Tower.

Copyright © 2020 ATC IP LLC. All Rights Reserved.

ATC SITE NAME: WEST SERVICE ROAD
ATC SITE NUMBER: 302466
T-MOBILE SITE NAME: CT491/SSITE HARTFORD_MP1
T-MOBILE SITE NUMBER: CT11491B
SITE ADDRESS: 305 W. SERVICE RD.
HARTFORD, CT 06120

VICINITY MAP

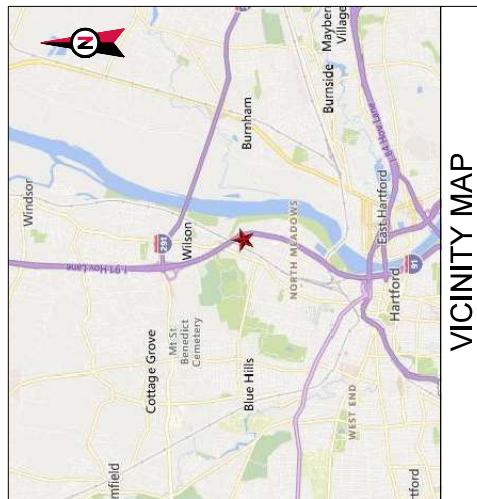

T-MOBILE ANCHOR ANTENNA AMENDMENT PLAN 67D5A992DB OUTDOOR CONFIGURATION


COMPLIANCE CODE	PROJECT SUMMARY	PROJECT DESCRIPTION	SHEET INDEX
	<u>SITE ADDRESS:</u> 305 W. SERVICE RD. HARTFORD, CT 06120 <u>COUNTY:</u> HARTFORD <u>GEOGRAPHIC COORDINATES:</u> LATITUDE: 41.79953889 LONGITUDE: -72.65686972 GROUND ELEVATION: 20 AMSL	THE PROPOSED PROJECT INCLUDES MODIFYING GROUND BASED TOWER WORK. REMOVE (3) ANTENNA(S) AND (3) RRH(S) INSTALL MOUNTING (3) MOUNTING PIPES (6) ANTENNA(S), (6) RRH(S), AND (2) 1-1/4" HYBRID CABLES EXISTING (6) ANTENNA(S), (3) TTA(S), (12) 1-1/4" COAX CABLE(S), (1) 1-5/8" HYBRID CABLE(S) AND (1) 1-1/4" HYBRID CABLE(S) TO REMAIN GROUND WORK. REMOVE (1) CABINET INSTALL (1) 6160 AC CABINET AND (1) ENCLOSURE 6160 BATTERY CABINET	SHEET NO.: G-001 REV: 1 DATE: 09/03/20 BY: CMB
		PROJECT NOTES	SHEET NO.: G-002 REV: 0 DATE: 09/03/20 BY: CMB
			SHEET NO.: G-003 REV: 0 DATE: 09/03/20 BY: CMB
			SHEET NO.: G-004 REV: 0 DATE: 09/03/20 BY: CMB
			SHEET NO.: G-005 REV: 0 DATE: 09/03/20 BY: CMB
			SHEET NO.: G-006 REV: 0 DATE: 09/03/20 BY: CMB
			SHEET NO.: G-007 REV: 0 DATE: 09/03/20 BY: CMB
			SHEET NO.: G-008 REV: 0 DATE: 09/03/20 BY: CMB
			SHEET NO.: G-009 REV: 0 DATE: 09/03/20 BY: CMB
UTILITY COMPANIES	POWER COMPANY: C.L.& P. PHONE: (600) 286-2020 TELEPHONE COMPANY: AT&T PHONE: (800) 286-2020	PROJECT LOCATION DIRECTIONS	DIRECTIONS FROM NEXT/WHITE PLAINS OAK OFC: 5 BROADWAY (HWY 119) NORTH TO WESTCHESTER AVE, TO 1-287 EAST (CROSS WESTCHESTER EXPWY) TAKE 1-84 EAST 63.3 MILES TO HIGH ST/HARTFORD EXIT BEAR LEFT ONTO MAIN ST. FOR 1.8 MILES THEN TURN RIGHT ONTO BEEHIVE ST., FOR 2 MILES TURN LEFT ON WING ST. 5 MILES AND THEN LEFT ONTO WEST SERVICE RD. SITE IS SOUTHWEST CORNER OF LARGER VACANT LOT AT CURVE OF RD ADJACENT TO KOHLER EQUIP. DISTRIBUTOR.
PROPERTY OWNER:	ATC TOWER SERVICES, LLC 3500 REGENCY PKWY STE 00 CARY, NC 27518		
ENGINEER:	RD ASSOC LLC 305 WEST SERVICES BROAD BROOK, CT 06016		



Know what's below.
Call before you dig.

TITLE SHEET

SHEET NUMBER: G-001
REVISION: 1

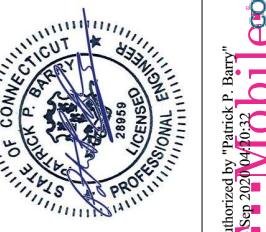

Authorized by "Patrick P. Barty"
14 Sep 2020 04:32:32
Mobile design

DATE DRAWN:	09/03/20
ATC JOB NO.:	13251344_D1
CUSTOMER ID:	C1491/SSITE HARTFORD_MP1
CUSTOMER #:	C11491B




AMERICAN TOWER®
A.T. ENGINEERING SERVICE, PLLC
3500 REGENCY PARKWAY
SUITE 100
PHONE: (919) 484-8112
COA: PEC-0001553

© 2020 ATC IP LLC. All Rights Reserved.
These drawings under the accompanying specification are the exclusive property of American Tower, their use and reproduction, in whole or in part, is prohibited without written permission of American Tower. Any other use, including the use of any portion of these drawings in any other document, is strictly prohibited. Title to the specified tower, strictly prohibited, title to American tower, whether or not the project is executed, remains with the architect, not the engineer. The engineer is retained to refine the design, not to execute it. Project contractors must verify all dimensions and advise American Tower of any discrepancies, any changes in plans or drawings must be submitted by the latent engineer or the architect to American Tower.



REV.	DESCRIPTION	BY	DATE
△	FOR CONSTRUCTION	CWB	08/18/20
△			
△			
△			

ATC SITE NUMBER: 302466
ATC SITE NAME: T-491/SSITE
WEST SERVICE ROAD
HARTFORD, CT
SITE ADDRESS: 305 W. SERVICE RD.
HARTFORD, CT 06120
SEAL:

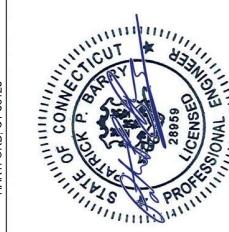

② PROPOSED RRU MOUNTING DETAIL - TYPICAL

SCALE: N/A

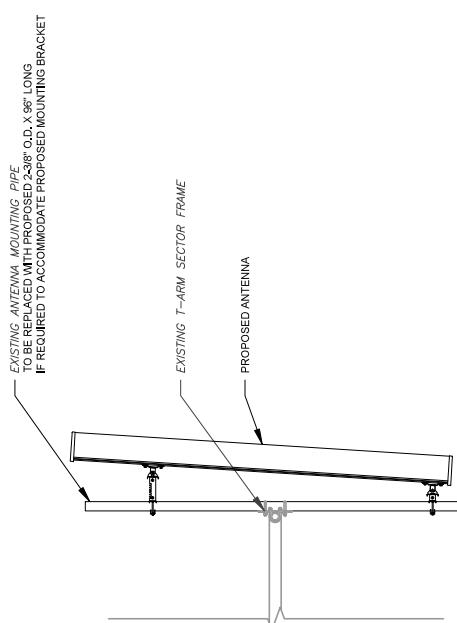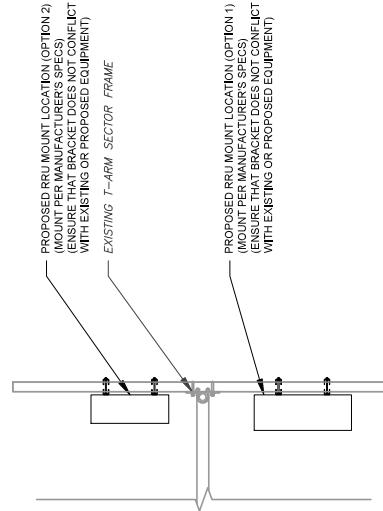

① PROPOSED ANTENNA MOUNTING DETAIL - TYPICAL


SCALE: N/A

DATE DRAWN:	08/18/20
ATC JOB NO.:	13251344_D1
CUSTOMER ID:	C1491/SSITE HARTFORD_MP1
CUSTOMER #:	CT11491B

CONSTRUCTION DETAILS

SHEET NUMBER:	C-501
REVISION:	0


67D58920B 3xAIR+10P.JPG

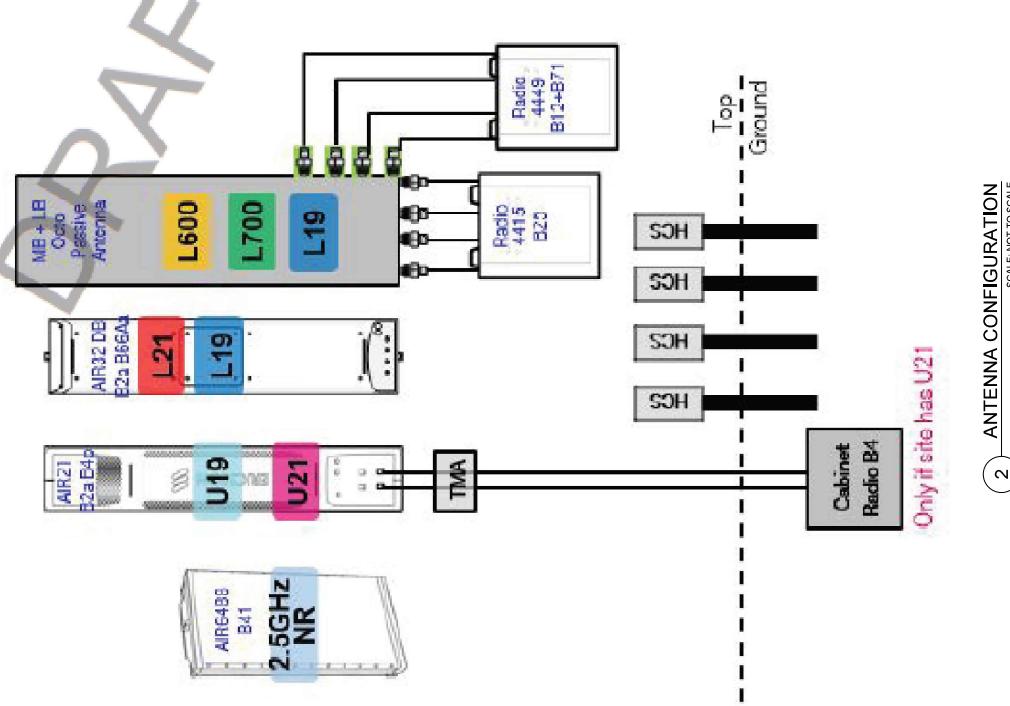

Existing RAN Equipment					
Enclosure	1	2	3	4	
Enclosure Type	BB 6.5 (3)	BB 6.5 (3)	BB 6.5 (3)	BB 6.5 (3)	BB 6.5 (3)
Baseband	DuWAVE (X 2)	DuG20	L700	L700	L700
Hybrid Cable System					
Radio	RU22 (X 6)				

Proposed RAN Equipment					
Enclosure	1	2	3	4	
Enclosure Type	BB 6.5 (3)				
Baseband	DuWAVE	DuWAVE	L700	L700	L700
Hybrid Cable System					
Radio	RU22 (X 6)				

1 CABINET CONFIGURATION
SCALE: NOT TO SCALE

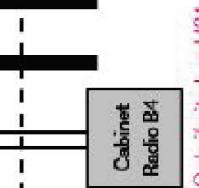

2 ANTENNA CONFIGURATION
SCALE: NOT TO SCALE



SUPPLEMENTAL

SHEET NUMBER: R-601 REVISION: 0

NOTE: THIS SHEET CREATED BY OTHERS AND PROVIDED
BY REQUEST OF CUSTOMER WITHOUT EDIT.


AIR6449 B41

Frequency Range	LTE TDD B41: 2496 – 2690 MHz
Instantaneous BW	DL 194 MHz
Antenna Ports	64/164R
Technology	NR, LTE and NR+LTE M5MM
Antenna Elements	192
Output RF Power	300 W (=64 TRX x 4.6875W)
Data Ports	4 x 25Gb/s CPRI
5G NR Support	YES
DC Feed	-48V DC power connector
Cooling	Passive cooling (vs. active cooling On AIR32 DB)
Dimensions (H x W x D)	33.1" x 20.6" x 8.6" inches (=841 x 524 x 217 mm)
Weight	104 lbs (=47 kg)
Electrical downtilt	-3 to 11 degrees
Horizontal beamwidth	+/- 65 degrees
HW/SW Availability	July 2020
Material SAP #	34105 – AIR 6449 B41



RRUS 4415 B25


- 1) B25
 - TX = 1930 – 1995 MHz
 - RX = 1650 – 1915 MHz
 -) CPRI 2 port x 2.5/4.0/8.0/10.1 Gbps. Install 2 SFPs and connect 2 fiber pair to the RRUS 4415 during initial install.
 -) Only use Ericsson supplied and approved SFPs RDH10265/25
 - Ericsson: SFP7740, 10GBase LR4, 1550 nm to 1310 nm
 -) 2 external alarm inputs
 -) Max wind load @ 50m/sec = 260N
 -) Breaker size = 25A, DC Power Consumption = 670 W (for dimensioning)
 -) 200mm horizontal separation required for side by side mounting
 -) 200mm separation required from antenna backplane to radio
 -) 400mm vertical separation required between 2 radios
 -) 500mm vertical separation below antenna
 -) Min. Max DC-cable size from squid to radio = 10-18 AWG
 - Adapter is required for 2-wire connection
 - Shielded DC cable is required
 -) Ground cable size = 2AWG
 -) Dimensions (incl. handles, feet and sunshield, w/o fan unit)
 - Height: 16.5" (420 mm)
 - Width: 13.4" (342 mm)
 - Depth: 5.3" (139 mm)
 - Weight, excl. mounting hardware = 46 lbs (21 kg)

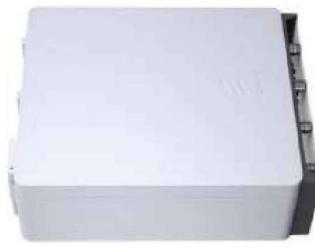

SUPPLEMENTAL

SHEET NUMBER: R-602	REVISION: 0
-------------------------------	-----------------------


Enclosure B160

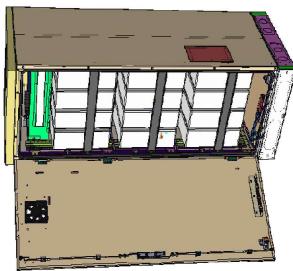


Enclosure B160
AirCon + VR LA

P41 | 2015-02-05 | Enclosure Confidential | Page 1

Enclosure B160

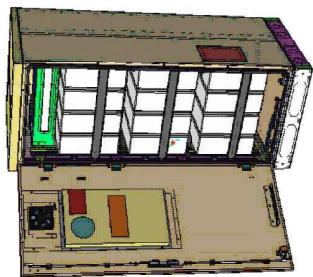

Enclosure B160
AirCon + Li-Ion

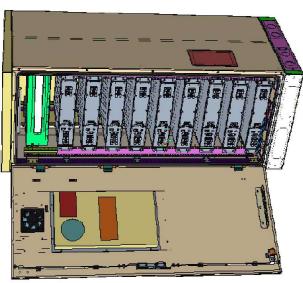

Enclosure B160
Convection Cooling
+ VR LA

- Capacity: 100Ah / 150Ah / 170Ah / 190Ah / 210Ah
- VR A 12V:
- Li-Ion: 24U 19° / 23°
- Sodium-Nickel: 3xFLAMM
- Electrical specification
- DC Output: -48VDC/200A
- Battery breakers: 2x125/2p
- Alarms: Door open, Climate failure, NCB Connection
- Mechanical specification
- Weight: 134kg
- Dimensions: 65 x 26 x 26 in. (Ind. Base frame)
- Base frame height: 6 in.
- Material: Galvanized steel (1.80g/m²)
- Color: Powder paint NCS 2002-B
- Door: Front access
- Locking type: Pad lock / cylinder

- Environmental specification
- Ingress protection: IP44
- Relative humidity: 15-100%
- Climate system
- Air Conditioner
 - Fan type: DC
 - Cooling capacity: 500W @ -35/135
 - Convection cooling
 - Emergency fan

P41 | 2015-02-05 | Enclosure Confidential | Page 2

SUPPLEMENTAL

SHEET NUMBER: R-603 | REVISION: 0

NOTE: THIS SHEET WAS CREATED BY OTHERS AND PROVIDED
AT THE REQUEST OF THE CUSTOMER WITHOUT EDIT.

Enclosure 6160 AC

Preliminary technical specification for Enclosure 6160 AC



CAPACITY

Rack space User equipment	19U (19" rack)
Hardware capabilities	Power and CPRU support for multi-standard remote radios (RRU or AIR) ERS Baseband and Transport units Li-Ion batteries 3PP equipment
	Additional power feed available as option
MECHANICAL SPECIFICATION	
Weight	145 kg (excluding active equipment) 320 lbs (excluding active equipment)
Dimension (H x W x D)	1600 x 650 x 650 mm (incl. Base frame) 63 x 26 x 26 in. (incl. Base frame)
Base frame height	150 mm 6 in.
Mounting position	Ground
Enclosure material	Aluminum
Color	Power paint NCS 2002-B
Door	Front access
Rack type	19" (IEC 60297-3-100)
Locking type	Pad lock or Cylinder
POWER SYSTEM	
Input voltage	3E+N+PE: 346/200-415/240 VAC 2E+N+PE: 230/120-220/110 VAC 1E+N+PE: 230-250 VAC <3kW 24kW
Input power	Output load (-48VDC)
Total capacity (-48VDC)	31.5kW
AC SPD	Class 2/Type 2
DC SPD	Class 2/Type 2
PSU Slots	9x
Service outlet	Optional
Priority load	2x Circuit Breaker
LLVD 1	6x Circuit Breaker
LLVD 2	6x Circuit Breaker
CB ratings	3A / 5A / 10A / 15A / 20A / 25A / 30A / 40A / 50A / 60A / 80A / 100A
Battery Interface	2x Circuit Breaker
Battery Circuit Breaker rating	125A - 2pol (200A)
PSU capacity	3600W



The Enclosure 6160 is a multi-purpose site cabinet designed to support a multitude of equipment such as ERNs, Baseband, Transport, Li-Ion battery and 3PP vendor equipment. It also provides a highly reliable power system and battery back-up, all in a streamlined design and minimized footprint to support cost-efficient expansion of mobile broadband.

Being an all-in-one enclosure, the Enclosure 6160 is a very fitting choice for all types of sites where the capacity need is large or room for future expansion is needed. It is ideally used for modernizing existing sites or in greenfield scenarios to match both current and future needs.

With a robust design, IP65 compliance and a sealed Heat Exchanger (HEX) climate system the Enclosure 6160 ensures optimal environmental protection of the active equipment, enabling them for a long lasting service. The complete system is also integrated and verified for the entire Ericsson Radio System and ensures best-in-class service.

The power system offers 31.5kW of power in total and provides 24kW of -48V DC power for both internal and external consumers.

The equipment space allows 19U of rack space ensuring well enough capacity for existing need and future expansion.

One of the main advantages of the Enclosure 6160 is its de-fault integration with EMN - allowing for advanced remote monitoring and control such as fault management, alarms, inventory measurements. The cabinet also provides an open OAM interface for integration to 3PP O&M systems.

SUPPLEMENTAL

SHEET NUMBER:	R-604
REVISION:	0

NOTE: THIS SHEET WAS CREATED BY OTHERS AND PROVIDED AT THE REQUEST OF THE CUSTOMER WITHOUT EDIT.



CLSI
ENGINEERING
PLLC

Mount Analysis for American Tower on behalf of T-Mobile
302466 - West Service Road, CT
Project #: 12605178
T-Mobile Site ID: CT11491B
Program: L700

CLS Engineering PLLC Project #41124-12605178-01-MA
September 19, 2018

Mount Analysis of Existing T-Arms for American Tower on behalf of T-Mobile

302466 - West Service Road, CT
Project #: 12605178
T-Mobile Site ID: CT11491B

Program: L700

LOADING CRITERIA	125 mph, $V_{du} / 97 \text{ mph}$, $V_{ss} / (3\text{-Second Gust})$ w/ 1" ice
ANALYSIS STANDARD	2012 IBC / 2016 Connecticut State Building Code / TIA-222-G
GPS COORDINATES	41.79953889, -72.6569722
SITE ADDRESS	305 W. Service Rd., Hartford, CT 06120-0001, Hartford County
ANTENNA ELEVATION	147.9 ft. Monopole
MOUNT DESCRIPTION	Existing T-Arms at 125 ft AGL
PROGRAM	L700


■ ANALYSIS RESULT: Pass (Conditional)

MEMBER USAGE	97%	Pass
--------------	-----	------

Modifications are proposed to bring mounts into compliance; see conclusion for details.

Prepared by:
Briitshan Poudel, E.I.

Reviewed and Approved by:
Tyler M. Barker, P.E.

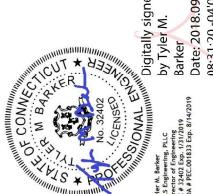

Mount Analysis for American Tower on behalf of T-Mobile
302466 - West Service Road, CT
Project #: 12605178-01-MA

■ RESULTS SUMMARY

Existing Mount Usages:

COMPONENT	PEAK USAGE	RESULT
Collar Reactions	14%	Fail
Mount Pipes	118%	Fail
Stand-Off Horizontals	106%	Fail
Face Horizontals	74%	Pass

Mount Usage after Modifications:

COMPONENT	PEAK USAGE	RESULT
Mount Pipes	97%	Pass
Collar Reactions	70%	Pass
Face Horizontals	51%	Pass
Stand-Off Horizontals	41%	Pass
Bracing Members	206%	Pass

■ CONCLUSION AND RECOMMENDATIONS

According to our structural analysis, the mounts have been found to **CONDITIONALLY PASS**. The mounting configuration considered in this analysis will be capable of supporting the referenced loading pursuant to referenced standards once the following scope is executed:

- Remove existing pipe and kicker angles assembly connected to outermost mount pipes at each sector.
- Install (1) Site Pro 1 PRK-SFS-L, Handrail Reinforcement Kit (Long), at existing face horizontal member as shown in the following sketches. Collar to be installed flush with existing monopole at a height of 3.3 ft. below the centerline of existing T-Arm mount collar.
- Install (3) 5 ft. long Pipe 2 STD, A53 Gr. B, bracing pipes at existing T-Arm mount. Connect to outermost mount pipe at Position 1 and existing face horizontal pipe of adjacent sector with Site Pro 1 PLCK or equal, as shown in the following sketches.


See following sketches and Site Pro 1 assembly drawings for additional details.

SUPPLEMENTAL

R-606 0
SHEET NUMBER: REVISION:


SHEET NUMBER: **R-607** | REVISION: **0**

SUPPLEMENTAL

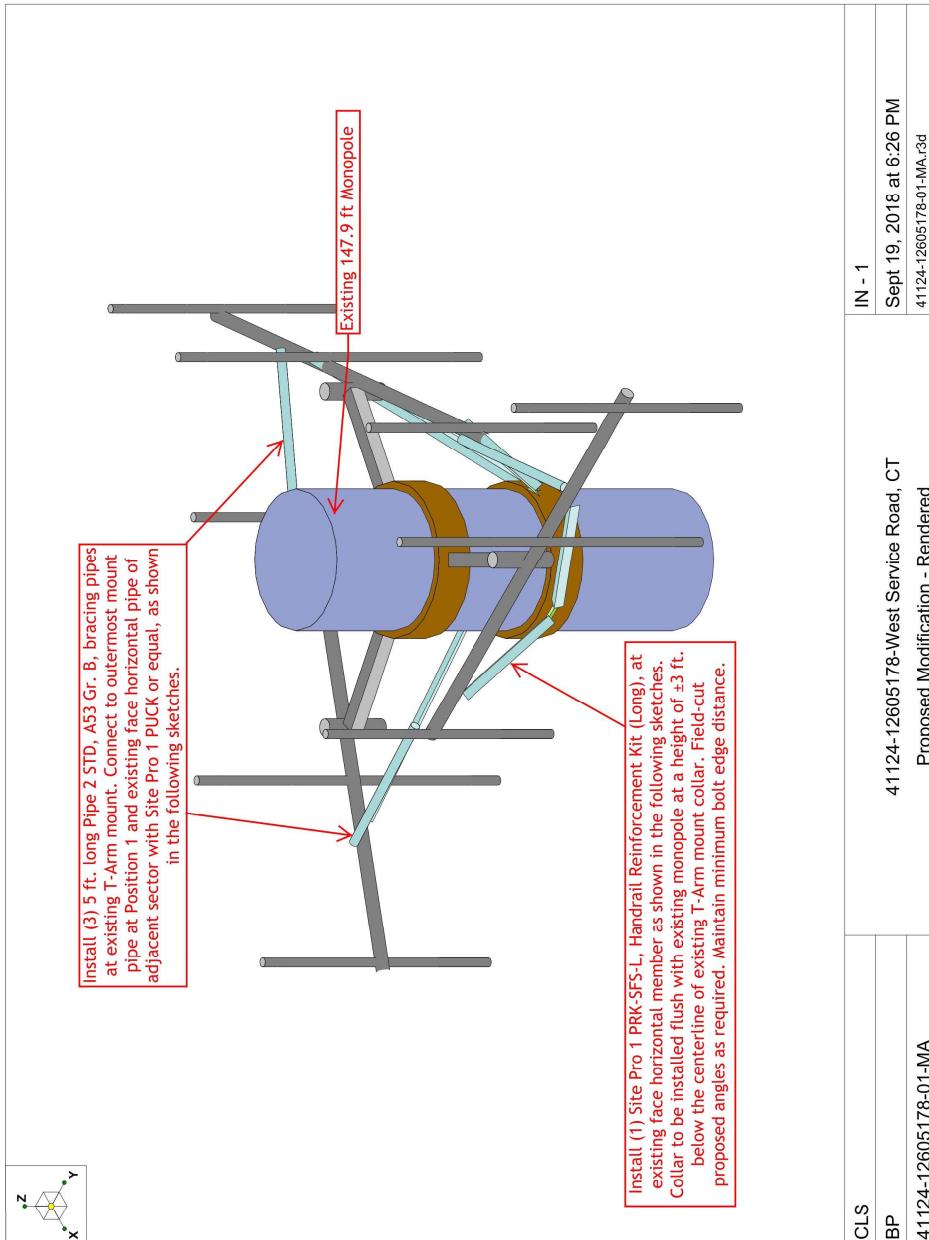

SHEET NUMBER: R-608	REVISION: 0
-------------------------------	-----------------------

SUPPLEMENTAL

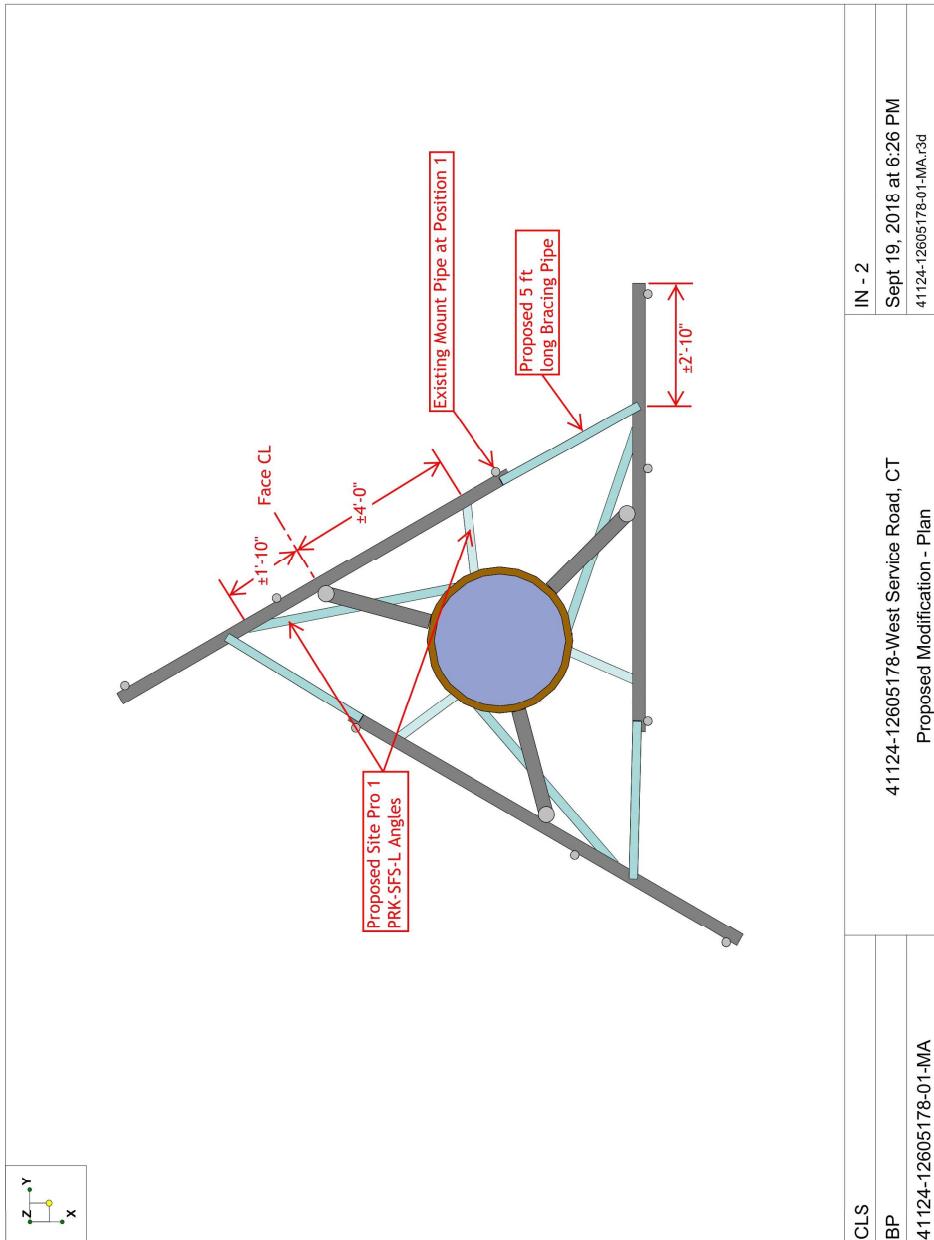

SHEET NUMBER:	R-609
REVISION:	0

SUPPLEMENTAL

