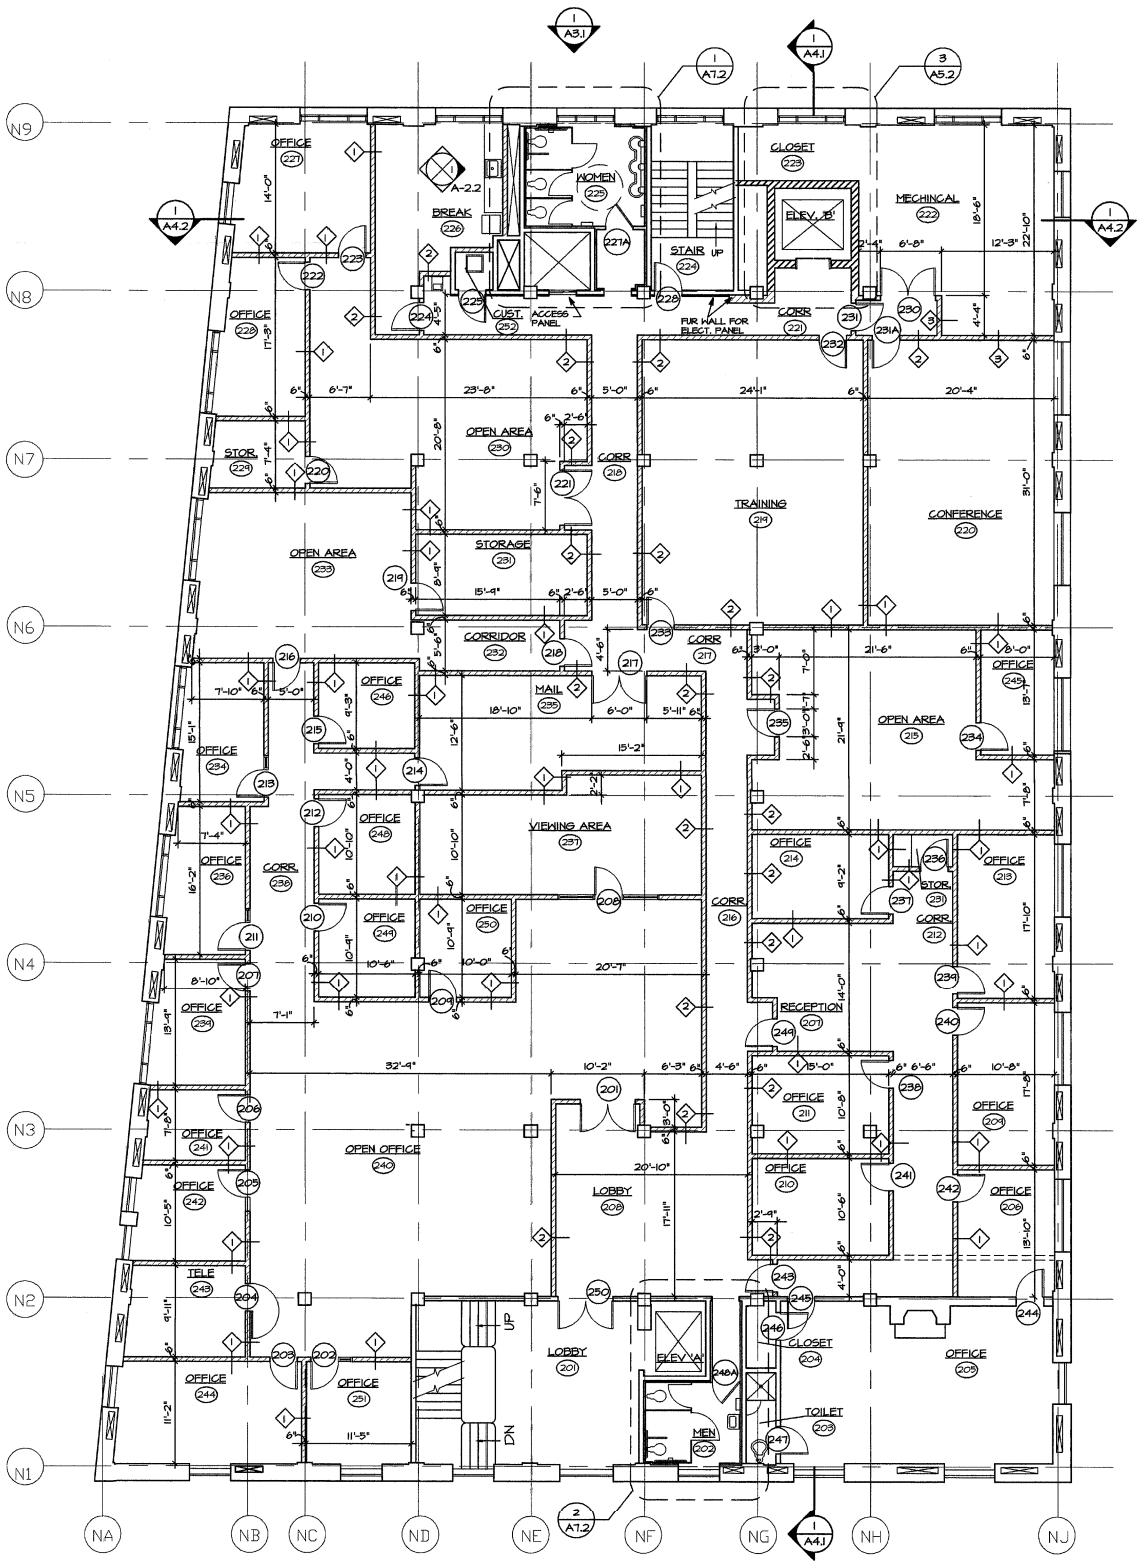

SECOND FLOOR - CONSTRUCTION PLAN

SCALE: 1/8"=1'-0"

LEGEN

G:\ACAD\STOFCT\30TRIN\ASBUILT\2ndfloor Fri Mar 05 14:52:38 1999